

CITY OF LAS VEGAS, NEVADA

PERMIT NO

92-150601

DEPARTMENT OF BUILDING AND SAFETY
PHONE 229 6251

BUILDING PERMIT

FOR Single Family Dwelling Remodel
Additions Misc Residential ConstructionPLAN CHECK NO M-4307 92DATE 6/25/92CONST VAL \$ 402 00ADDRESS OF CONSTRUCTION 3001 REEF VIEWOWNER MIKE AND BRIGITTE MURRAYPHONE 256-2013LOT(s) 129 BLOCK C SUBDIVISION Lakeside 12 L/H

ZONE

PROPOSED CONSTRUCTION PATIO SLAB FOR FUTURE COVER

USE

THIS PERMIT FOR ☒ BLDG ☐ A/C ☐ ELEC ☐ PLBG ☐OTHER PERMITS REQD FENCE ☐ OFF SITE ☐ SWIM POOL ☐FLOOR AREA BSMT 1ST 2ND GARAGE PORCH TOTALCONTRACTOR SALOMONE + SON CONSTRUCTION CO STATE LICENSE NO 29717CITY LICENSE NO 43420

ARCHITECT _____ ENGINEER _____

MASTER PLUMBER/CONTRACTOR _____ MASTER ELECTRICIAN/CONTRACTOR _____


OTHER INSPECTIONS AND FEES

1 I p t t d f m l b h r s \$3000 p h (m m m h g t h h)
 2 R p t f d g m l b h h d d p f T A B L E 3 A f t h U f m B l d g C d
 3 I p t h g m l b h r s f w h h f p f l y d t d \$3000 p h (m m m h g
 4 Add t l p l w q d b y h g d d t t p p d p l \$3000 p h (m m m h g

CONDITIONS OF THE PERMIT

- I agree to call the City Building Department for inspections before construction begins and before rough work is completed. Also for air conditioning drywall and sheathing inspection.
- I agree that when the job is completed I will call for final inspection and occupancy.
- I agree to perform all construction according to the City Ordinance and Building Codes.
- The Contractor's signature below denotes authority from the owner to sign his behalf and that the owner is aware of all requirements of this application and permit. Separate permits must be taken out for work outlined above this agreement.
- I have read and understand the contents of this application and permit. I hereby state that the information I have supplied on this application is true and correct.
- Approval for the work under this permit will be given only after a fee has been received from job site and public right of way.
- 24 HOUR MINIMUM NOTICE REQUIRED FOR INSPECTIONS

SPECIAL CONDITIONS

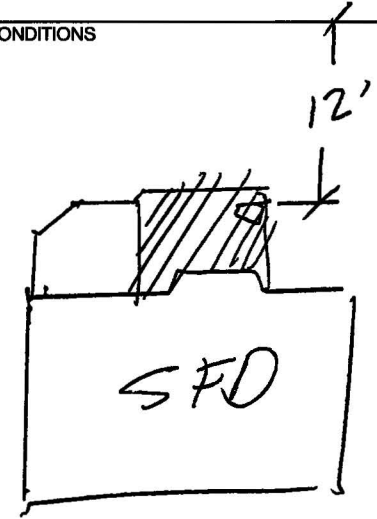

BY _____ I HEREBY DECLARE THAT I AM THE LEGAL OWNER OF THE ABOVE PROPERTY OWNER

BY VINCENT SALOMONE AGENT

I hereby certify that I have reviewed this application and the proposed plans and have found that the proposed development meets the requirements of the City of Las Vegas Flood Hazard Reduction Ordinance for the issuance of this Development Permit

LAND DEVELOPMENT AND FLOOD CONTROL ENGINEER		DATE	ELECTRICAL		FEE
<u>[Signature]</u>		<u>6/25/92</u>	RECEPTACLE _____ SWITCH _____		45
PLANNING DEPT		<u>6/25/92</u>	EACH LIGHT FIXTURE OR SOCKET _____		35
<u>[Signature]</u>			SPECIAL OUTLET APPLIANCE ETC _____		75
BUILDING DEPT			SERVICE/PANEL SUB/3 25 200A/6 45 400A/13 40		
			A/C UNIT OR MOTORS _____	3 25	
PLUMBING			2310 2432	TOTAL	06/25/92
WATER DISTRIBUTION	6 00		MISC		
SEWER SYSTEM NEW OR MODIFICATION	10 00				
FIXTURES WATER SOFTENER H/W HEATER	2 00				
GARBAGE DISPOSAL WASHER	2 00		2310 2431 PLAN REVIEW		
FUEL PIPING	6 00		2310 2401 BLDG PERMIT		13 00
IRRIGATION SYSTEM	8 00		7143 2973 SEWER CONNECTION		
MISC			6122 3352 TORTOISE		
2310 2433 TOTAL			2897 PIF		
AIR CONDITIONING		FEE	88100 1232 TRANSPORT		13 00
NEW UNIT 3 TON = 9 00 OVER = 16 50					
FURNACE TO 100 000/9 00 OVER/11 00					
VAPORATIVE COOLER	6 95				
VENTILATION FAN	2 55				
2310 2435 TOTAL					

TOTAL FEES

RECEIPT
MUST BE MACHINE VALIDATED
 SFD 13 00
 CHEV 13 00
 8369A000 15 51

PERMIT NO

Permit Expires 180 Days After Abandonment of Work





**PLANS APPROVED
CONSTRUCTION**

Building & Safety Dept.
City of Las Vegas, Nevada

JUN 2 5 1992

Does Not Include Electrical, Plumbing
or Site Improvements
Use Without Approval
This Plan is not a
City Ordinance

A# 89067
P# 92150601

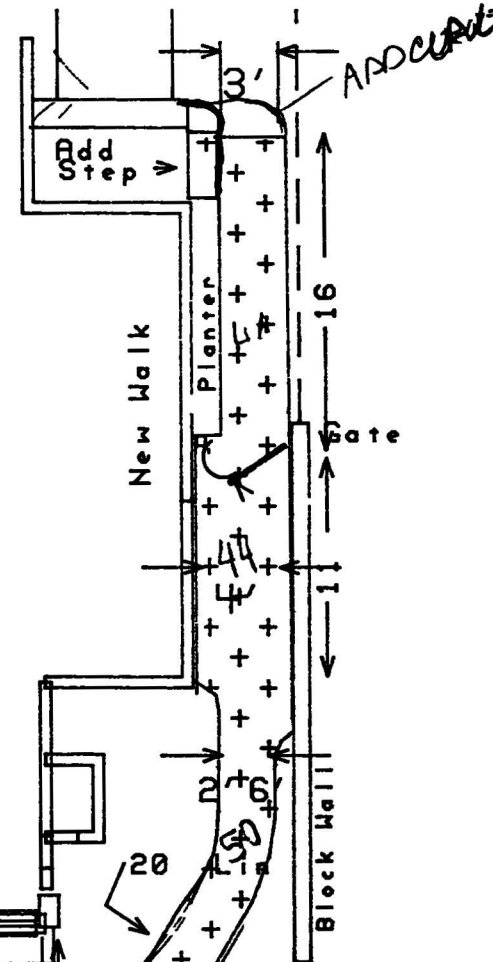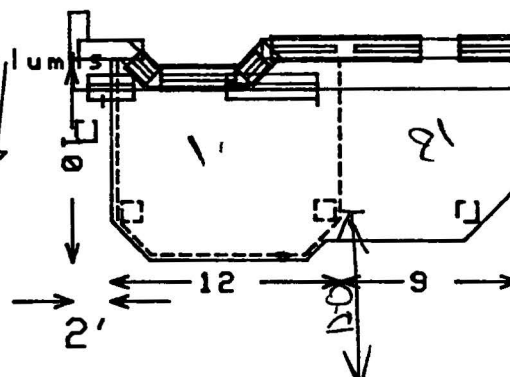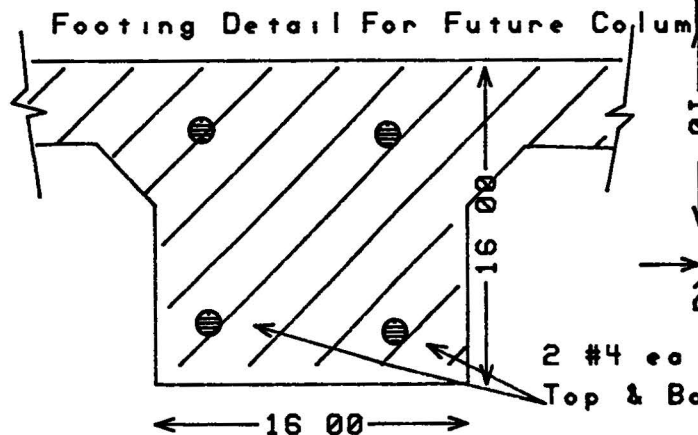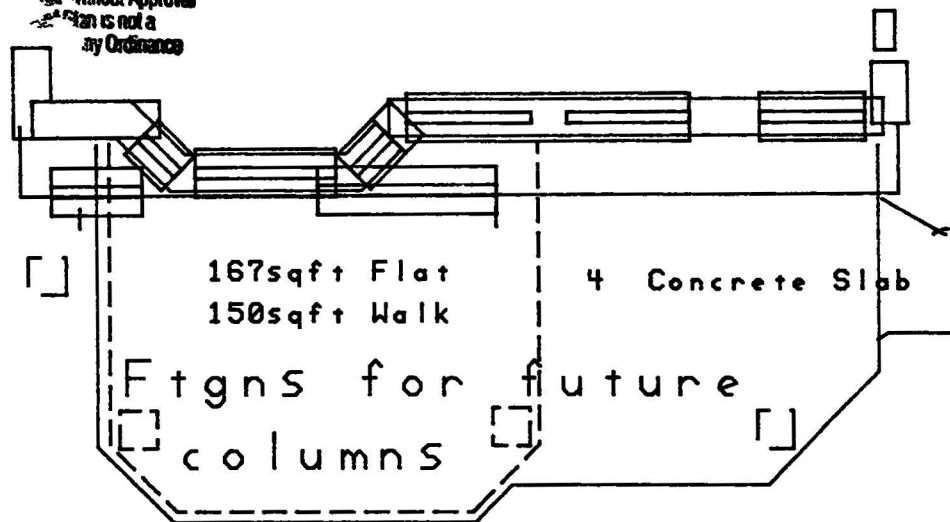

Salomone & Son Const. Co.

Murrel

Mur3
©1992

Vincent H Salomone 645-0932

DEPARTMENT OF BUILDING & SAFETY CITY OF LAS VEGAS



**PERMIT
NUMBER**

92-150601

**INSPECTION
NUMBER**

10

JOB ADDRESS

3001 REEF VIEW ST

A# 89067

LOT NO

129

BLOCK NO

C

SUBDIVISION NAME

LAKES WEST 2

FIRE DEPT MAP NO

2615-53

JOB PHONE

645-0932

CALL IN DATE

06/26/92

CALL IN TIME

14 34

SCHEDULE DATE

06/29/92

INSPECTOR NO

57

INSPECTOR NAME

HOWARD STUART

**INSPECTION
REQUESTED**

PRE-SLAB (105)

per permit slab for future patio cover. Pre Slab and footings OK for a future cover. 3 footings total 12'x12". No deck on these footings. Please call for a final after slab is poured. Unable to locate inspection record card.

☐ **PARTIAL
INSPECTION**

☐ **PARTIAL
APPROVAL (P)**

PARTIAL DESCRIPTION

☒ **APPROVED
(A)**

☐ **STOP
WORK (S)**

☐ **COMMENTS
(C)**

☐ **TEMPORARY
APPROVAL (T) - UNTIL**

☐ **HOLD
(H)**

☐ **REJECTED (R)**

REINSPECTION REQUIRED CALL *229 2071

☐ **REFEE (F)**

**REINSPECTION FEE REQUIRED PAY AT CITY HALL
3RD FLOOR 400 E STEWART STREET**

☐ **PERMIT
REQUIRED**

**INSPECTOR
SIGNATURE**

H Stuart

INSPECTION DATE

6-29-92

☐ **PROJECT
COMPLETE**

**BRING HARD CARD WITH FIRE QUALITY CONTROL & PLANNING APPROVALS
SIGNED OFF TO BLDG & SAFETY FOR C OF O ISSUANCE (Commercial Only)**

**IF YOU HAVE ANY QUESTIONS ON THIS INSPECTION YOU MAY
CALL THE INSPECTOR FROM 7 00 AM 7 15 AM OR 2 45 PM 3 00 PM AT**

229-6769

For Additional Assistance Call 229 6251 See Reverse Side For Inspection Types