

CITY OF LAS VEGAS, NEVADA

PERMIT NO 91 - 105875

DEPARTMENT OF BUILDING AND SAFETY
PHONE 386 6251

**DEVELOPMENT PERMIT
FOR SIGNS**



LOG NO & AREA 020-270-003
M-3700'91 DATE 05-15-91 CONST VAL \$ 120 00

ADDRESS OF CONSTRUCTION 601 N EASTERN
2431 Bonanza Rd OWNER 7-ELEVEN PHONE _____

CONTRACTOR YESCO STATE LICENSE NO 780 CITY LICENSE NO 11 993 2 03535

LOT(S) A POR. S 1/2 SE 1/4 OF SEC 26 T20S R61E MDBM BLOCK _____ SUBDIVISION _____ ZONE C-1

PROPOSED CONSTRUCTION To install a wall sign

MATERIAL FOR SIGN: Metal Wood Plastic Other TYPE OF PROJECT: New Sign Replacement Relocation

TYPE	SIZE	HEIGHT ZONE			VALUATION	PERMIT FEE
		A	B	C		
NON ELECTRIFIED						
		Up to 30	Over 30 up to 50	Over 50		
Single faced	sq ft @	\$5 00	\$7 00	\$9 00	\$	\$
Double faced	sq ft @	\$10 00	\$12 00	\$14 00	\$	\$
NEON OR OTHER ELECTRIFIED						
Single faced	10 sq ft @	\$12 00	\$14 00	\$16 00	\$ 120 00	\$ 12 00
Double faced	sq ft @	\$16 00	\$18 00	\$20 00	\$	\$
FOR COMPUTER SIGNS OR SIGNS NOT INCLUDED ABOVE USE CONST VAL					\$	\$

finished 6-6-91

**FOR INSPECTIONS
CALL 799 2071**

I hereby certify that I have examined and read the above application that the same is true and correct and that the work herein described is to be done in accordance with all the provisions of the applicable Ordinances of the City of Las Vegas Nevada and the State Laws whether herein specified or not

YESCO/B MESKEL

SIGNED B Meskel MASTER NEON ELECTRIC BILLBOARD CONTRACTOR

**WALL
SIGN
ONLY**

SEE PHAN


RECEIPT

PLANNING DEPT [Signature] DATE 5/16/91
BUILDING DEPT [Signature] DATE 5/16/91
W O # 431585

PLAN REVIEW FEE _____
PERMIT FEE 12 00
2310 2401
TOTAL FEES 12.00

USE 1/4" TOGGLE BOLTS AS REQ'D

USE 2 AMPS / 20 A CIRCUIT AT 120V
DISCONNECT 20 AMP S/P SWITCH AT SIGN

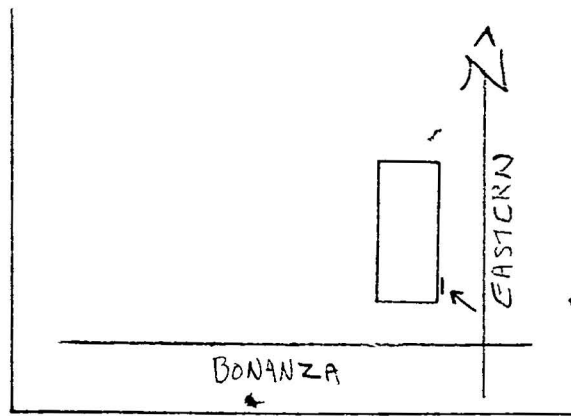

PROPOSED 7/11 STORE ELEVATION PLAN w/ EXISTING SIGNAGE

Proposed Signage 10 Sqft

Existing Signage = 48 Sqft

Total Signage = 58 Sqft

7/11 # 29662
2431 Bonanza Rd

APPROVED


WALL SIGN ONLY

By: [Signature] 5/16/91
COMMUNITY PLANNING & DEVELOPMENT
City of Las Vegas

PLANS APPROVED
CONSTRUCTION
Building & Safety Dept
City of Las Vegas Nevada

TS MAY 16 1991

Does not include Electrical Plumbing
Or Off Site Improvements
Make No Change Without Approval
Approval Of Plan Is Not A
Permit To Violate Any Ordinance

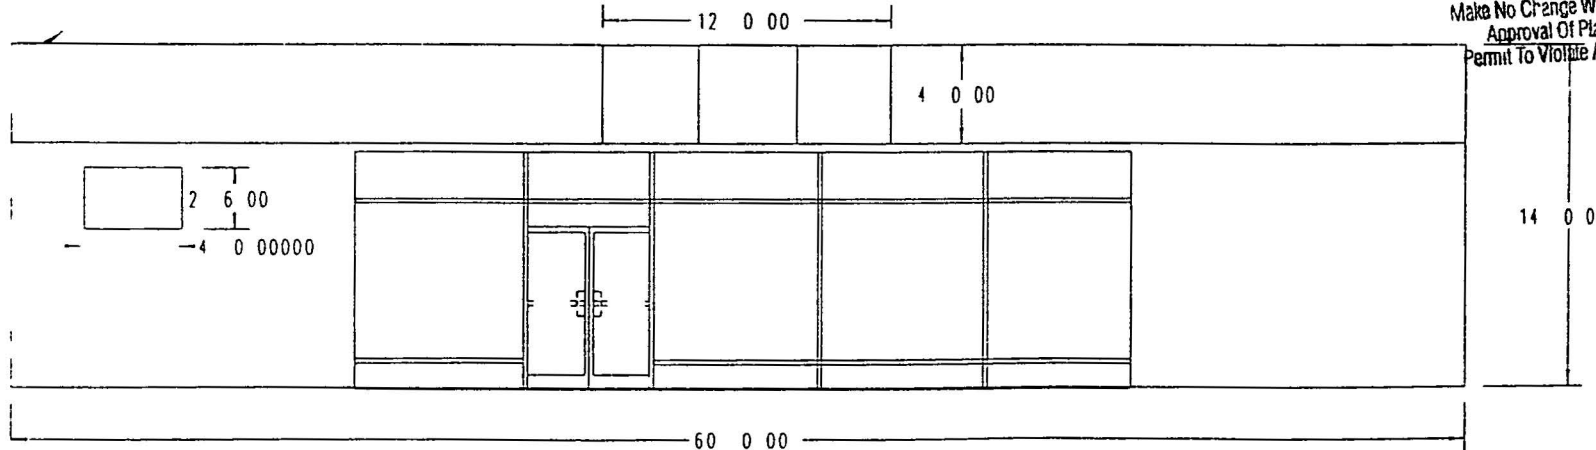

Scale 1/8" = 1'

40044-9
601 No Eastern
81-106875

DEPARTMENT OF BUILDING & SAFETY CITY OF LAS VEGAS

<input type="checkbox"/>	PERMIT NUMBER → 106875	INSPECTION NUMBER →
--------------------------	-------------------------------	----------------------------

JOB ADDRESS 601 N Eastern

LOT NO	BLOCK NO	SUBDIVISION NAME
		7-11 Yesco

FIRE DEPT MAP NO	JOB PHONE	CALL IN DATE	CALL IN TIME	SCHEDULE DATE
		6 5 91	4 8 31A	

INSPECTOR NO	INSPECTOR NAME
74	

INSPECTION REQUESTED → F/Elect + Bldg

140-240

<input type="checkbox"/> PARTIAL INSPECTION	<input type="checkbox"/> PARTIAL APPROVAL (P)	PARTIAL DESCRIPTION
---	---	---------------------

<input checked="" type="checkbox"/> APPROVED (A)	<input type="checkbox"/> STOP WORK (S)	<input type="checkbox"/> COMMENTS (C)	<input type="checkbox"/> TEMPORARY APPROVAL (T) - UNTIL	<input type="checkbox"/> HOLD (H)
--	--	---------------------------------------	---	-----------------------------------

<input type="checkbox"/> REJECTED (R)	REINSPECTION REQUIRED CALL *799 2071	<input type="checkbox"/> PERMIT REQUIRED
<input type="checkbox"/> REFEE (F)	REINSPECTION FEE REQUIRED PAY AT CITY HALL 3RD FLOOR 400 E STEWART STREET	

INSPECTOR SIGNATURE	<i>Lee RB</i>	INSPECTION DATE	6-6-91
----------------------------	---------------	------------------------	--------

<input type="checkbox"/> PROJECT COMPLETE	BRING HARD CARD WITH FIRE QUALITY CONTROL & PLANNING APPROVALS SIGNED OFF TO BLDG & SAFETY FOR C of O ISSUANCE (Commercial Only)
--	--

IF YOU HAVE ANY QUESTIONS ON THIS INSPECTION YOU MAY CALL THE INSPECTOR FROM 7 00 AM 7 15 AM OR 2 45 PM 3 00 PM AT