

5104 : CHARLESTON .

Donna Hooley

11-16-84

CITY OF LAS VEGAS, NEVADA

LOG NO. & AREA ATTACHED DATE _____ CONST. VAL. \$ 500.00

DEPARTMENT OF BUILDING AND SAFETY
PHONE 386-6251

DEVELOPMENT PERMIT AND BUILDING PERMIT
FOR: Commercial and Public Structures

ADDRESS OF CONSTRUCTION 5104 W. CHARLESTON OWNER BULLET & BLADE

CONTRACTOR R.W. BUGBEE & ASSOC. STATE LICENSE NO. 14400 CITY LICENSE NO. 21970

LOT(S) PT L352 SE1/4 367725 K60E ZONE C-1

PROPOSED CONSTRUCTION: PROVIDE NEW DOORWAY TO NEW SHOP USE

BUILDING PERMIT NO. 3087 ELECTRIC PERMIT NO. _____ PLUMBING PERMIT NO. _____ AIR COND. PERMIT NO. _____

ADD'L. PERMITS REQ'D.: Air Cond. ☒ Elec. ☐ Plumbing ☐ Signs ☐ Paving ☐ Fence ☐ Fire S.S. ☐ Off-Site P. ☐

OCCUPANCY GROUP B-2 CONSTRUCTION TYPE V-N

MATERIALS OF CONSTRUCTION: Wood Frame ☐ Concrete Block ☐ Reinforced Concrete ☐ Steel Frame ☐

SQUARE FEET OF FLOOR AREAS: 1st _____ 2nd _____ 3rd _____ Other _____ TOTAL SQ. FT. _____

ARCHITECT: _____ ENGINEER: _____ NO. of UNITS _____ NO. of STORIES 1


OTHER INSPECTIONS AND FEES

- Inspections outside of normal business hours = \$25.00 per hour (minimum charge three hours).
- Re-inspection fee during normal business hours assessed under provisions of TABLE 3-A of the Uniform Building Code = \$15.00 each.
- Inspections during normal business hours for which no fee is specifically indicated = \$15.00 per hour (minimum charge one half hour).
- Additional plan review required by changes, additions or revisions to approved plans = \$25.00 per hour (minimum charge two hours).

CONDITIONS OF THE PERMIT:

- I agree to call the City Building Department for inspections before concrete is poured, before rough wiring, electrical, plumbing, framing is covered. Also for air conditioning, drywall and sheathing inspection.
- I agree that when the job is completed that I will call for final inspection before occupancy.
- I agree to perform all construction in accordance with City Ordinances and Building Codes.
- The Contractor's signature below denotes authority from the owner to sign in his behalf and that the owner is aware of all requirements of this application and permit. Separate permits must be taken out for work outlined above this agreement.
- I have read and understand the contents of this application and permit. I hereby state that the information I have supplied on this application is true and correct.

Approval for the work under this permit will be given only after refuse and debris have been removed from site and public right of way.

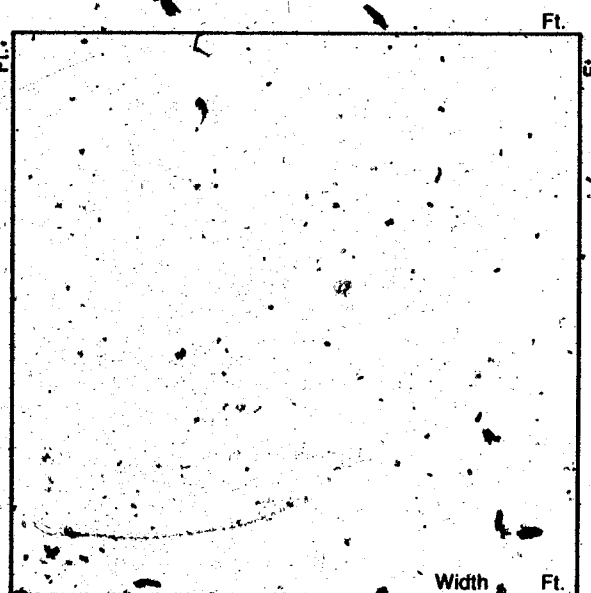

SIGNED _____ CONTRACTOR

BY _____ AGENT/OWNER

LICENSE DEPT. _____ DATE _____

PLANNING DEPT. _____ DATE _____

BUILDING DEPT. _____ DATE _____

I hereby certify that I have reviewed this application and the proposed plans and have found that the proposed development meets the requirements of the City of Las Vegas Flood Hazard Reduction Ordinance for the issuance of this Development Permit.

_____ DATE 11-9-84

SEWER CONNECTION
7114-3654

FIXTURES X 11/09/84

FEE _____

PLAN REVIEW FEE _____


PERMIT FEE 10.00

TOTAL FEES 10.00

RECEIPT
0004
COMM 10.00
CHEK 10.00
3087A000 14:25

MUST BE MACHINE VALIDATED

CHARLESTON BLVD

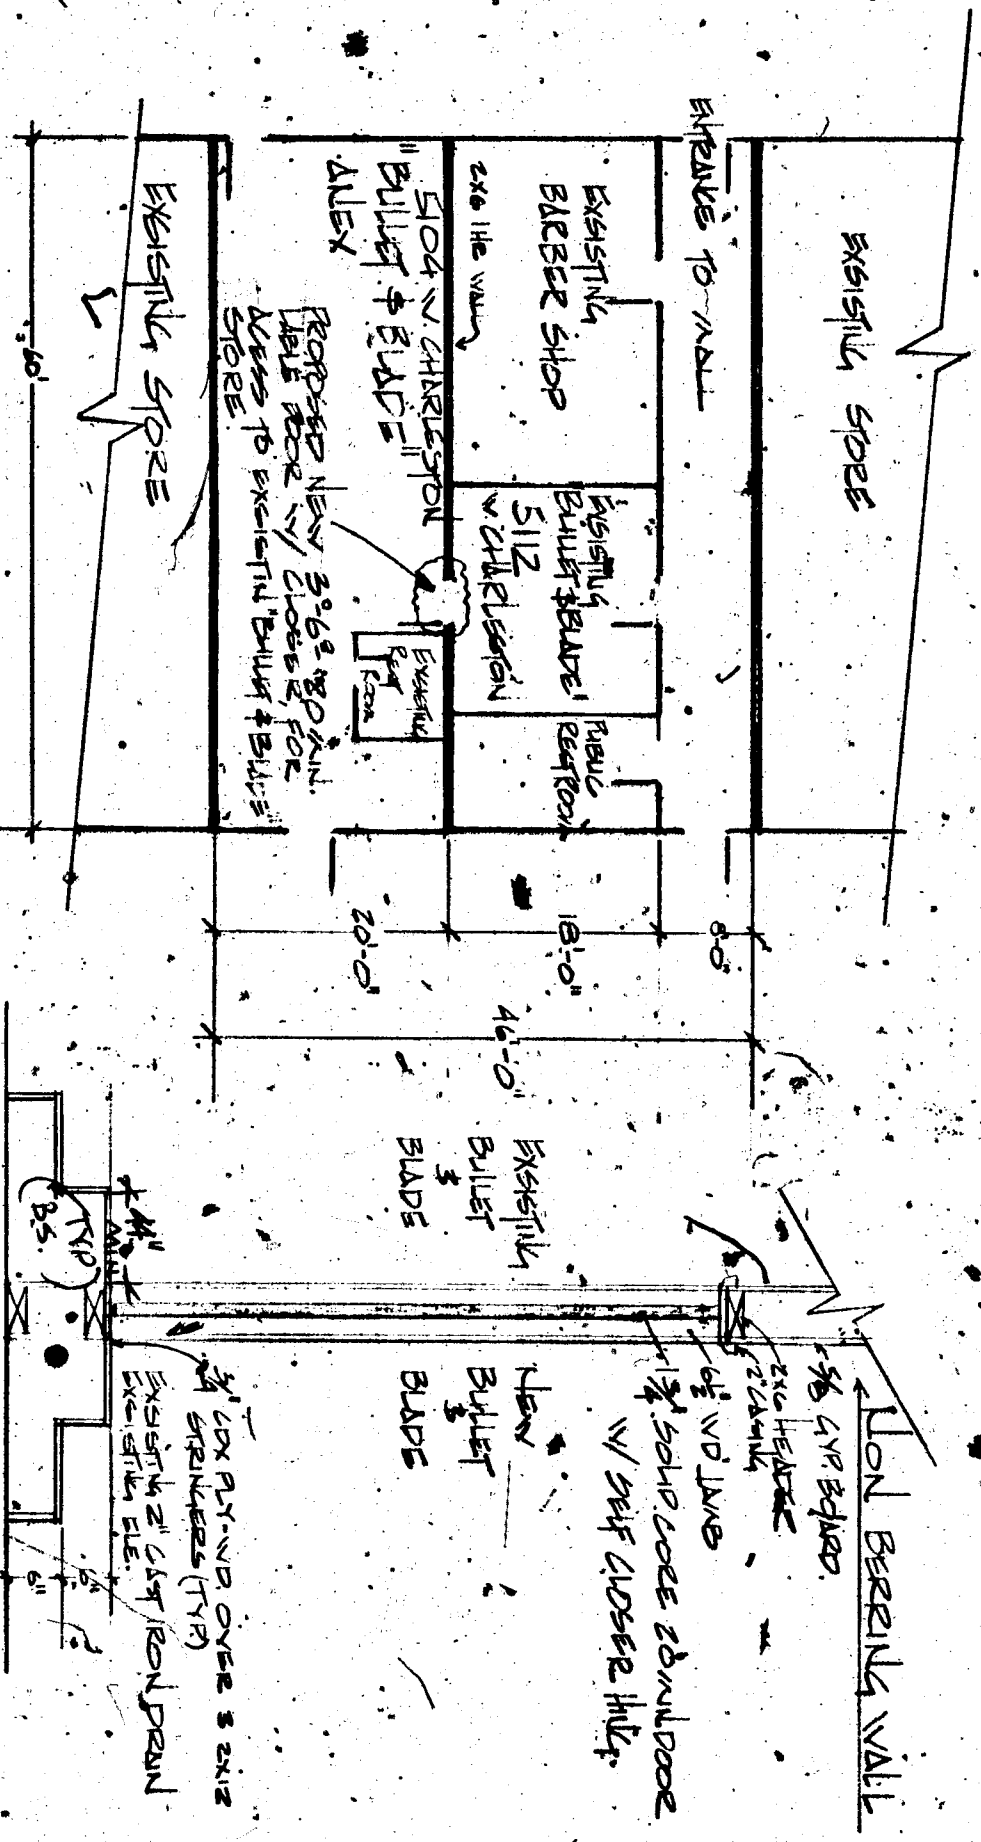

Scale 1/2" = 1'-0"

PROVIDE EMERGENCY LIGHTING
WITH SEPERATE SOURCE OF POWER
PER CITY ORD. #2227 SEC. 26(C)(1)
BY: R.V. BUCKEE & ASSOC.
4271 THIRIOT ST
LV. NV. 89103
N.S.C. # 014400
871-9800

APPROVED CONSTRUCTION
DATE: 11/9/84
BY: SCOT C. BUCKEE

PROPOSED DOOR SECTION
Scale 1/2" = 1'-0"

BULLET & BLADE 5104 N. CHARLESTON.
DOOR DETAIL FOR ACCESS FROM
EXISTING BULLET & BLADE TO NEW
BY: SCOT C. BUCKEE, 11/9/84

Debbie Inghram 4-23-85

OWNER	Bullet & Blade	ADDRESS	5104 W. Chas.
DATE	11-13-84	GEN. CONT.	R.W. Bugbee
TYPE OF STRUCTURE	provide new doorway	PERMIT No.	3087
LEGAL DESCRIPTION	SEE APPLICATION	LOG No.	attached
APPROVED FOR OCCUPANCY & METER			
BUILDING		MECHANICAL	
Location & Footing		Plumbing Cont.	
Concrete Slab Floor		Permit No.	Date
Fireplace Footing		Htg./Vt./A.C. Cont.	
Chimney Steel		Permit No.	Date
Vert. Steel Reinf.		Sewer Cont.	
Horiz. Steel Reinf.		Permit No.	Date
Framing		Rough Sill	
Ext. Lath		Rough Water	
Roof Sheathing		Top-Out	
Ext. Brown		Rough Gas	
Insulation		A/C Rough Duct	
Drywall	complete 11-18-85	Final Plumbing	
Final Building		Final Gas	
Appr. for Occu.		Final Air Cond.	
ELECTRICAL		Final Sewer	
Temp. Pole cont.		REMARKS	
Permit No.	Date		
Inspection	Date		
Electrical Cont.			
Permit No.	Date		
Rough		PLEASE NOTE ADDITIONAL REMARKS ON REVERSE SIDE	
Final Electrical		DEPT. OF BLDG. & SAFETY CITY OF LAS VEGAS REV. 82-3-29	
Temporary Service			