

3805 E1 Cederal

L11 B2 Las Verdes #4 Zone R-1

H. Gatenwood 3-27-79

CITY OF LAS VEGAS, NEVADA
DEPARTMENT OF BUILDING AND SAFETY
APPLICATION FOR FENCE, WALL OR
RETAINING WALL

LOG NO. _____

AREA: 4 1

KARDEX CARD: ✓

TELEPHONE: 878-20490

CONSTRUCTION

VALUATION: 103

INSPECTION

VALUATION: 82

PERMIT FEE: 3.00

PERMIT NUMBER: 20323

DATE: May 12 1965

ADDRESS OF

CONSTRUCTION: 3805 El Cedral

OWNER'S

NAME: Glendon H. Jones

Lot (s) 11 Block 2 Subdivision Ros. Verdes #4 Zone: R-1

Materials of Concrete

Construction: Block ☒ Concrete ☐ Wire ☐ Wood ☐ Other ☐

Total Square Feet: _____ Total Linear Feet: 41


CONTRACTOR'S NAME: Owner STATE LICENSE #: _____ CITY LICENSE #: _____

Architect's Name: _____ PLANS SUBMITTED: Yes ☐ No ☐

Engineer's Name: _____ CALCULATIONS: Yes ☐ No ☐

Street Name: El Cedral

Front Yard: _____ Feet _____

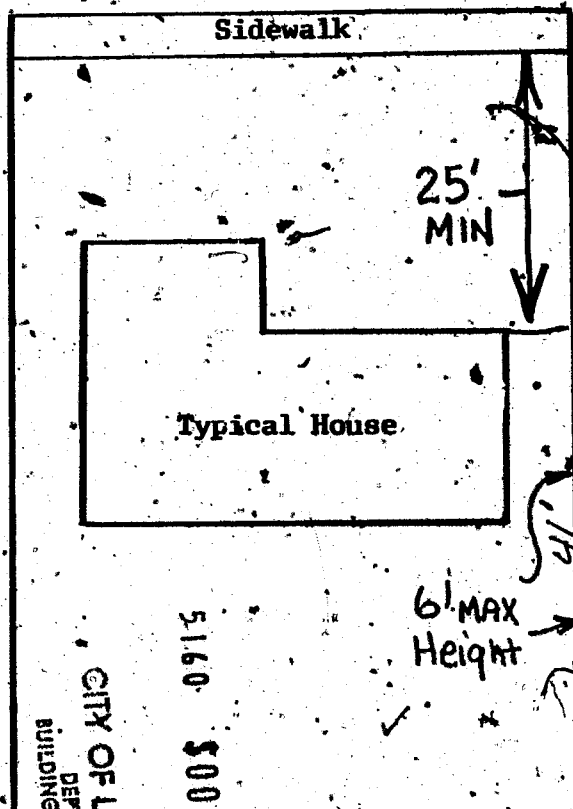

Side Yard Length _____ Feet

Side Yard Length _____ Feet

Rear Yard _____ Feet

CITY OF LAS VEGAS
DEPT. OF BUILDING & SAFETY

5.160

\$005.00

TOTL.

I understand that any portion of this (fence), (wall), constructed or erected, on City property or right-of-way will be removed from said location at my expense upon request received from the City of Las Vegas, Nevada. I understand that the (fence) (wall) shall not enclose water meter, light standard, fire alarm box and shall not come closer than two (2') feet in any direction from any fire hydrant. I further state that I am familiar with effective Ordinances of the City of Las Vegas, Nev. and effective Statutes of the State of Nevada covering construction and use of above type; I agree to perform said construction in conformity therewith. I further agree that issuance of a permit on above application will not excuse me from conforming with said Ordinances and Statutes, despite any errors on the part of the Building Inspector or Engineer in checking plans and applications herewith submitted.

I have read and understand the contents of above application; I hereby state that same are true and correct.

SIGN HERE: Glendon H. Jones

By: _____

APPROVED BY: 5-12-65

PLANNING DEPT. & CODE ASSISTANCE DATE: _____

FIRE DEPARTMENT DATE: _____

ENGINEERING DEPT. DATE: _____

BUILDING & SAFETY DEPT. 5/12/65 DATE: _____

Note: Owner or Contractor must call for all inspections required.

Note: Owner or Contractor must call for all inspections required.

H. Gatewood 3-27-79

CITY OF LAS VEGAS, NEVADA
DEPARTMENT OF BUILDING AND SAFETY
APPLICATION FOR FENCE, WALL OR
RETAINING WALL

LOG NO. _____

AREA: _____

KARDEX CARD: _____

TELEPHONE: ~~878~~ 878-0490

CONSTRUCTION

VALUATION: 121.00

INSPECTION

VALUATION: 9.60

PERMIT FEE: 3.00

PERMIT NUMBER: 30476

DATE: 5-26-65 1965

ADDRESS OF
CONSTRUCTION: 3805 El. Cedral

OWNER'S
NAME: Glendon H. Jones

Lot (s) 11 Block 2 Subdivision Las Verdades Hts #41 Zone: R1

Materials of Concrete

Construction: Block ☒ Concrete ☐ Wire ☐ Wood ☐ Other ☐

Total Square Feet: 165 sq ft Total Lineal Feet: 148

CONTRACTOR'S NAME: Glendon H. Jones STATE LICENSE # _____ CITY LICENSE # _____

Architect's Name: _____

Engineer's Name: _____

PLANS SUBMITTED: Yes _____ No _____

CALCULATIONS: Yes _____ No _____

Street Name: EL CEDRAL

Front Yard: 20.10' Feet

I understand that any portion of this (fence) (wall) constructed or erected on City property or right-of-way will be removed from said location at my expense upon request received from the City of Las Vegas, Nevada. I understand that the (fence) (wall) shall not enclose water meter, light standard, fire alarm box and shall not come closer than two (2') feet in any direction from any fire hydrant. I further state that I am familiar with effective Ordinances of the City of Las Vegas, Nev. and effective Statutes of the State of Nevada covering construction and use of above type; I agree to perform said construction in conformity therewith. I further agree that issuance of a permit on above application will not excuse me from conforming with said Ordinances and Statutes, despite any errors on the part of the Building Inspector or Engineer in checking plans and applications herewith submitted.


I have read and understand the contents of above application; I hereby state that same are true and correct.

SIGN HERE: Glendon H. Jones
By: _____

APPROVED BY: 5/26/65
PLANNING DEPT. & CODE ASSISTANCE DATE:

FIRE DEPARTMENT DATE:

ENGINEERING DEPT. DATE: 5-26/65
BUILDING & SAFETY DEPT. DATE:

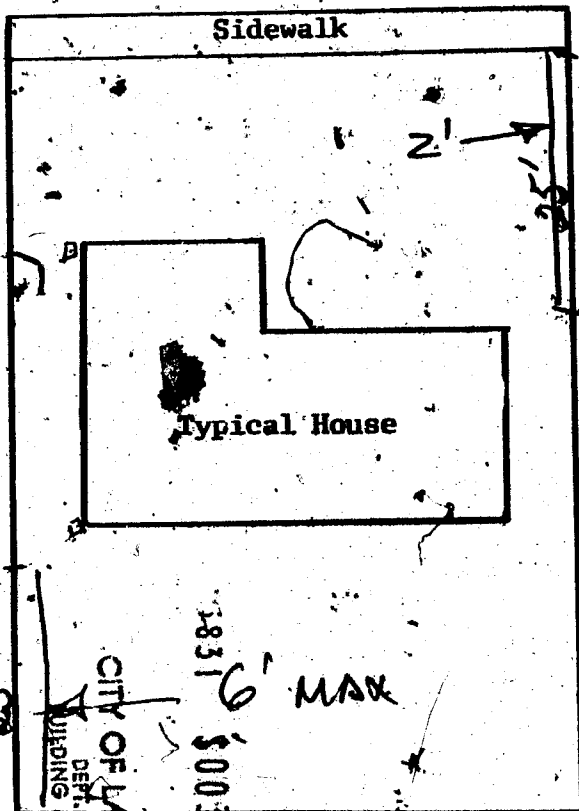

CITY OF LAS VEGAS
DEPT. OF BUILDING & SAFETY
MAY 27 1965
\$00.00 TOTAL
\$00.00

Note: Owner or Contractor must call for all inspections required.

DEPARTMENT OF BUILDING & SAFETY
CITY OF LAS VEGAS, NEVADA

KARDEX CARD
FENCE & RETAINING
WALLS

OWNER Glendon H. Jones

ADDRESS 3805 El Cederal

DATE 5-13-65

CONTRACTOR Same

PERMIT NO. 30323

LOT 11

BLOCK 2

SUBDIVISION Las Verdes #4

blk wall

Fence (wire, wood, etc.)

Walls (masonry, rock, etc.)

Location

Final Inspection

Location

Footings

Wall Steel 1st

2d

3d

Final Inspection

413 7-22-65

Retaining Wall (masonry)

Retaining Wall (concrete)

Location

Footings

Wall Steel 1st

2d

3d

Bond Beam 1st

2d

3d

Final Inspection

Location

Footings

Wall Steel 1st

2d

3d

Final Inspection

23.14 B

ADDRESS 3805 El Cederal

LOT NO.

AREA

DEPARTMENT OF BUILDING & SAFETY
CITY OF LAS VEGAS, NEVADA

KARDEX CARD
FENCE & RETAINING
WALLS

OWNER Glendon H. Jones

ADDRESS 3805 El Cederal

DATE 5-27-65

CONTRACTOR Same

PERMIT NO. 30476

LOT 11

BLOCK 2

SUBDIVISION Las Verdes Hts #4

blk wall

Fence (wire, wood, etc.)

Walls (masonry, rock, etc.)

Location

Final Inspection

Location

Footings

Wall Steel 1st

2d

3d

Final Inspection

WED 5-27-65
WED 5-27-65
2088 6-76-65

Retaining Wall (masonry)

Retaining Wall (concrete)

Location

Footings

Wall Steel 1st

2d

3d

Bond Beam 1st

2d

3d

Final Inspection

Location

Footings

Wall Steel 1st

2d

3d

Final Inspection

23.14 B

ADDRESS 3805 El Cederal

AREA

PRINCESS HOMES INC. DEPT. of BLDG & SAFETY CITY of LAS VEGAS, NEVADA
OWNER JBJ Invest Co ADDRESS 3805 El Cedral DATE 1-2-63
GEN. CONT. PERMIT NO. 14868 LEGAL DESCRIPTION Lot 11, Blk 2, Las Vegas Hts 4 TYPE OF STRUCTURE SFD

BUILDING	MECHANICAL	ELECTRICAL
LOCATION 27-63	PLUMBING CONT. 27-63	TEMP. FINE CONT. 27-63
FIREPLACE FTS 27-63	PERMIT NO. 27-63 DATE 27-63	PERMIT NO. 27-63 DATE 27-63
FOOTINGS 27-63	HEAT & VENT. AC. CONT. 27-63	INSPECTION 27-63
FOUNDATION WALLS 27-63	PERMIT NO. 27-63 DATE 27-63	ELECTRICAL CONT. 27-63
FLOOR FRAMING 27-63	SEWER CONT. 27-63	PERMIT NO. 27-63 DATE 27-63
SLAB 27-63	PERMIT NO. 27-63 DATE 27-63	FIXTURES CONT. 27-63
CHIMNEY STEEL (FIREPLACE) 27-63	ROUGH SOIL 27-63	PERMIT NO. 27-63 DATE 27-63
WALL STEEL 27-63	ROUGH WATER 27-63	SLAB 27-63
COLUMN STEEL 27-63	TOP-OUT 27-63	ROUGH 27-63
BEAM STEEL 27-63	ROUGH GAS 27-63	FINAL ROUGH 27-63
FRAMING 27-63	AC. ROUGH DUCT 27-63	FINAL FIXTURE 27-63
ROOF SWEATHING 27-63	REAR ROUGH PIPING 27-63	FINAL ELECTRICAL 27-63
DRYWALL 27-63	FINAL PLUMBING 27-63	TEMPORARY SERVICE 27-63
LATHING 27-63	FINAL GAS 27-63	MISCELLANEOUS 27-63
BACKING (SIDING) 27-63	FINAL AM COND. 27-63	GRADING & DRAINAGE 27-63
PLASTER 27-63	FINAL REFRIG. 27-63	ON-SITE PARKING SPACES 27-63
SCRATCH 27-63	FINAL SEWER 27-63	END APPROVAL OF 27-63
BROWN 27-63	FINAL SEPTIC TANK 27-63	OFF-SITE IMPROVEMENTS 27-63
URBAN REDEVELOPMENT APPROVAL 27-63		
FINAL BLDG. 27-63		

APPROVED FOR OCCUPANCY & METER INSPECTOR DATE
PLEASE NOTE REMARKS ON REVERSE SIDE
1-17-64 Cancelled by 3805 El Cedral
LOG # AREA # 2304
T79 4