

2104 Bonneville

LOT 19 BLOCK 2 GLEN HEATHER #1 ZONED R-1


CITY OF LAS VEGAS, NEVADA
DEPARTMENT OF BUILDING AND SAFETY
APPLICATION FOR FENCE, WALL OR
RETAINING WALL

LOG NO.:
AREA: 4
KARDEX CARD: ☒
TELEPHONE: _____

CONSTRUCTION VALUATION: \$357.00
INSPECTION VALUATION: \$284.00
PERMIT FEE: \$4.00
PERMIT NUMBER: 30371
DATE: 5/17 1965

ADDRESS OF CONSTRUCTION: 2104 Bonnie Lane OWNER'S NAME: L. STOVER
Lot (s) 19 Block 2 Subdivision GLEN HEATHER #1 Zone: R1
Materials of Concrete Construction: Block (X) Concrete () Wire () Wood () Other ()
Total Square Feet: 610 Total Lineal Feet: 142
CONTRACTOR'S NAME: JOHN E. YOSEN CO. STATE LICENSE # 2776 CITY LICENSE # 276
Architect's Name: _____ PLANS SUBMITTED: Yes _____ No X
Engineer's Name: _____ CALCULATIONS: Yes _____ No X

Street Name: BONNIE LANE
Front Yard: 80 Feet

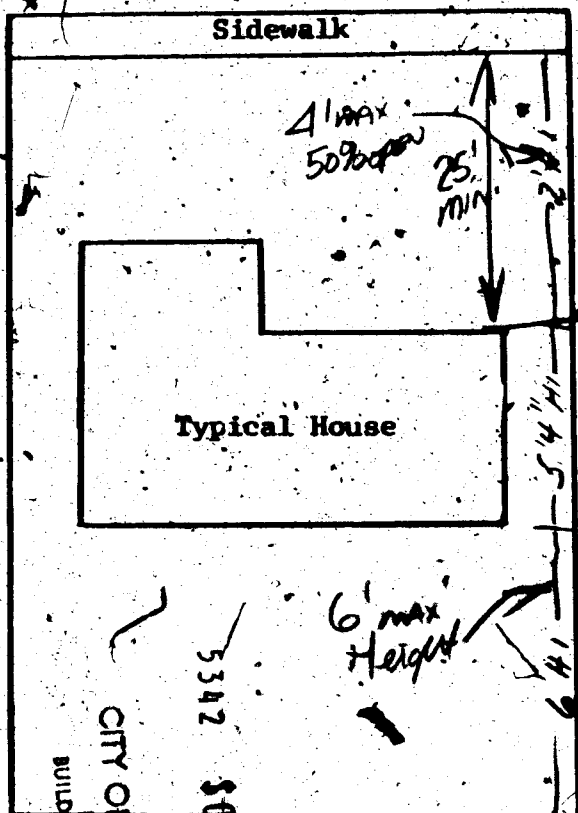

I understand that any portion of this (fence) (wall) constructed or erected on City property or right-of-way will be removed from said location at my expense upon request received from the City of Las Vegas, Nevada. I understand that the (fence) (wall) shall not enclose water meter, light standard, fire alarm box and shall not come closer than two (2') feet in any direction from any fire hydrant. I further state that I am familiar with effective Ordinances of the City of Las Vegas, Nev. and effective Statutes of the State of Nevada covering construction and use of above type; I agree to perform said construction in conformity therewith. I further agree that issuance of a permit on above application will not excuse me from conforming with said Ordinances and Statutes, despite any errors on the part of the Building Inspector or Engineer in checking plans and applications herewith submitted.

I have read and understand the contents of above application; I hereby state that same are true and correct.

SIGN HERE: JOHN E. YOSEN CO.
By: John E. Yosen, PRES.

APPROVED BY: 5/17/65
PLANNING DEPT. & CODE ASSISTANCE DATE: _____
FIRE DEPARTMENT DATE: _____
ENGINEERING DEPT. DATE: _____
BUILDING & SAFETY DEPT. 5/17/65 DATE: _____

Note: Owner or Contractor must call for all inspections required.