

2605 Castlewood Dr

L20 B-1 Sub Ench. Vill. # 1 Zone R-1

L. Gatewood 2-16-79

CITY OF LAS VEGAS, NEVADA
DEPARTMENT OF BUILDING AND SAFETY
APPLICATION FOR FENCE, WALL OR
RETAINING WALL

LOG NO. _____

AREA: _____

KARDEX CARD: _____

TELEPHONE: 737-1246

CONSTRUCTION

VALUATION: 81.50

INSPECTION

VALUATION: 65.00

PERMIT FEE: 3.00

PERMIT NUMBER: 32613

DATE: 2-16-1966

ADDRESS OF

CONSTRUCTION: 9605

OWNER'S

NAME

NEW SUPER 4

OWNER'S

ADDRESS

LAS VEGAS

Lot (s) 20

Block 1

Subdivision

ENCLOSURE

Zone: R-1

Materials of Concrete

Construction: Block ()

Concrete ()

Wire ()

Wood ()

Other ()

Total Square Feet: _____

Total Linear Feet 65

CONTRACTOR'S NAME: American Fence

STATE

LICENSE # 8581

CITY

LICENSE#

Architect's Name: _____

Engineer's Name: _____

PLANS SUBMITTED: Yes No

CALCULATIONS: Yes No

Street Name: _____

Front Yard: _____

Feet 65

I understand that any portion of this (fence) (wall) constructed or erected on City property or right-of-way will be removed from said location at my expense upon request received from the City of Las Vegas, Nevada. I understand that the (fence) (wall) shall not enclose water meter, light standard, fire alarm box and shall not come closer than two (2') feet in any direction from any fire hydrant. I further state that I am familiar with effective Ordinances of the City of Las Vegas, Nevada, and effective Statutes of the State of Nevada covering construction and use of above type; I agree to perform said construction in conformity therewith. I further agree that issuance of a permit on above application will not excuse me from conforming with said Ordinances and Statutes, despite any errors on the part of the Building Inspector or Engineer in checking plans and applications herewith submitted.

I have read and understand the contents of above application; I hereby state that same are true and correct.

SIGN HERE: American Fence

By: Stan Thomas

APPROVED BY: 2/16/66

PLANNING DEPT. & CODE ASSISTANCE

DATE:

FIRE DEPARTMENT


DATE:

ENGINEERING DEPT.

DATE:

BUILDING & SAFETY DEPT.

DATE: 2-16-66

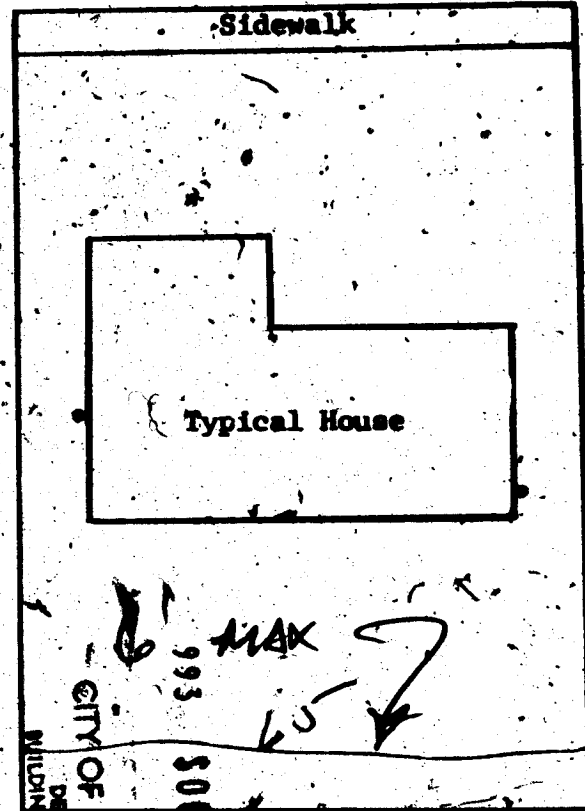

23.14

Note: Owner or Contractor must call for all inspections required.

Charles S. Jackson

DEPT. of BLDG. & SAFETY—CITY of LAS VEGAS, NEVADA

OWNER H. B. MORGAN ADDRESS 2605 CASTLEWOOD DRIVE DATE 2-13-63

GEN. CONTRACTOR W. RUST TYPE OF STRUCTURES F. DWLG.

PERMIT NO. 15922 LEGAL DESCRIPTION Lot 20, Blk. 1, Enchanted Village

BUILDING		MECHANICAL		ELECTRICAL	
LOCATION <u>WS 1-13-63</u>		PLUMBING CONT. <u>Forman</u>		TEMP. POLE CONT.	
FIREPLACE FTS.		PERMIT NO. <u>16062</u>	DATE <u>2-13-63</u>	PERMIT NO.	DATE
FOOTINGS <u>WS 2-25-63</u>		HEAT & VENT. AC CONT. <u>Prepared</u>		INSPECTION	DATE
FOUNDATION WALLS <u>WS 2-25-63</u>		PERMIT NO. <u>6628</u>	DATE <u>3-11-63</u>	ELECTRICAL CONT.	<u>DKM</u>
FLOOR FRAMING		SEWER CONT. <u>Forman</u>		PERMIT NO. <u>11124</u>	DATE <u>3-12-63</u>
SLAB <u>WS 2-25-63</u>		PERMIT NO. <u>10062</u>	DATE <u>2-13-63</u>	FIXTURES CONT.	<u>DKM</u>
CHIMNEY STEEL (FIREPLACE)		ROUGH SOL. <u>SW 2-21-63</u>		PERMIT NO. <u>11241</u>	DATE <u>3-12-63</u>
WALL STEEL		ROUGH WATER <u>SW 2-21-63</u>		SLAB	
COLUMN STEEL		TOP-OUT <u>SW 3-27-63</u>		ROUGH <u>Miller 3-21-63</u>	
BEAM STEEL		ROUGH GAS <u>SW 3-27-63</u>		FINAL ROUGH	
FRAMING <u>2-25-63</u>		AC ROUGH DUCT <u>SW 3-27-63</u>		FINAL FIXTURE	
ROOF SHEATHING <u>2-25-63</u>		RER ROUGH PIPING		FINAL ELECTRICAL	
INTERIOR	EXTERIOR	FINAL PLUMBING <u>SW 6-27-63</u>		TEMPORARY SERVICE	
DRYWALL <u>2-25-63</u>	<u>2-29-63</u>	FINAL GAS <u>SW 6-28-63</u>			
LATHING	<u>2-25-63</u>	FINAL AIR COND. <u>SW 6-28-63</u>			
BACKING (SIDING)	<u>2-25-63</u>	FINAL REFRIG. <u>SW 6-11-63</u>			
PLASTER SCRATCH	<u>2-25-63</u>	FINAL SEWER			
PLASTER BROWN	<u>2-25-63</u>	FINAL SEPTIC TANK			
URBAN REDEVELOPMENT APPROVAL					
FINAL BLDG. <u>2-26-63</u>	DATE <u>2-26-63</u>				

APPROVED FOR OCCUPANCY & METER Inspector 2-29-63 DATE

PLEASE NOTE REMARKS ON REVERSE SIDE

LOG: # AREA: # 23.04

2605 CASTLEWOOD DRIVE T-3 4

DEPARTMENT OF BUILDING & SAFETY
CITY OF LAS VEGAS, NEVADA

OWNER Nevada Savings & Loan ADDRESS 2605 Castlewood DATE 2-17-66

CONTRACTOR American Fence Co. PERMIT NO. 32613

LOT 20 BLOCK 1 SUBDIVISION Enchanted Village #1 WOOD FENCE

Fence (wire, wood, etc.)	Walls (masonry, rock, etc.)
Location	Location
Final Inspection <u>Myman 2-22-66</u>	Footings
	Wall Steel 1st <u>2d</u> <u>3d</u>
	Final Inspection

Retaining Wall (masonry)	Retaining Wall (concrete)
Location	Location
Footings	Footings
Wall Steel 1st <u>2d</u> <u>3d</u>	Wall Steel 1st <u>2d</u> <u>3d</u>
Bond Beam 1st <u>2d</u> <u>3d</u>	Final Inspection
Final Inspection	

23.14 B ADDRESS 2605 CASTLEWOOD DRIVE LOT NO. 20 AREA 23.04