

517 FREMONT

Lula Collins 2-1-82

DEPT. of BLDG. & SAFETY - CITY of LAS VEGAS, NEVADA
OWNER: HERB & MARV'S MENS STORE ADDRESS: 517 E. Fremont St. DATE: 4/3/59
GEN. CONT. PAUL WAGNER CONTR TYPE OF STRUCTURE: REMODEL STORE FRONT & TEMP. BARRICADE
PERMIT NO. 33188 LEGAL DESCRIPTION:

LOCATION & FLOOR ELEVATION	PLUMBING CONT.	TEMP. POLE CONT.
FOOTINGS	PERMIT NO. DATE	PERMIT NO. DATE
FOUND. & PIERS	HEAT & VENT. CONT.	INSPECTION DATE
WALL STEEL	PERMIT NO. DATE	ELECTRICAL CONT.
BOND BEAM STEEL	SEWER CONT.	PERMIT NO. DATE
FRAMING & ROOF SHEATHING	ROUGH SOIL	OUTLETS
STEEL FABRICATION	ROUGH WATER	MOTORS H.P.
CONNECTIONS & PAINTING	SEWER OR SEPTIC TANK	SLAB
INTERIOR EXTERIOR	TOP-OUT	ROUGH
LATHING	ROUGH GAS	FINAL ROUGH
PLASTER	ROUGH DUCT	FIXTURE CONT.
SCRATCH	FINAL PLUMBING	PERMIT NO. DATE
BROWN	FINAL HEATING	FIXTURES
FINAL BLDG. <u>4-29-59</u>	FINAL GAS	FINAL FIXTURE
GRADING & DRAINAGE		APPROVED FOR METER
ON-SITE PARKING SPACES		
ENG. APPROVAL OF OFF-SITE IMPROVEMENTS		

APPROVED FOR OCCUPANCY:

INSPECTOR

DATE

* PLEASE NOTE REMARKS ON REVERSE SIDE

517 E. Fremont St.

REMODEL STORE FRONT & TEMP. BARRICADE

4/3/59

28.04

DEPT. of BLDG. & SAFETY - CITY of LAS VEGAS, NEVADA
OWNER: Leva Beckley ADDRESS: 517 East Fremont DATE: 9/15/65
GEN. CONT. Roberts Roof & Floor TYPE OF STRUCTURE: Reroof
PERMIT NO. 31413 LEGAL DESCRIPTION: Lot 9 Blk 3 Hawkins Add

BUILDING	MECHANICAL	ELECTRICAL
LOCATION	PLUMBING CONT.	TEMP. POLE CONT.
FIREPLACE FTS.	PERMIT NO. DATE	PERMIT NO. DATE
FOOTINGS	HEAT & VENT. AC CONT.	INSPECTION DATE
FOUNDATION WALL	PERMIT NO. DATE	ELECTRICAL CONT.
FLOOR FRAMING	SEWER CONT.	PERMIT NO. DATE
SLAB	PERMIT NO. DATE	FIXTURES CONT.
CHIMNEY STEEL (FIREPLACE)	ROUGH SOIL	PERMIT NO. DATE
WALL STEEL	ROUGH WATER	SLAB
COLUMN STEEL	TOP-OUT	ROUGH
BEAM STEEL	ROUGH GAS	FINAL ROUGH
FRAMING	AC ROUGH DUCT	FINAL FIXTURE
ROOF SHEATHING	REF. ROUGH PIPING	FINAL ELECTRICAL
INTERIOR EXTERIOR	FINAL PLUMBING	TEMPORARY SERVICE
DRYWALL	FINAL GAS	MISCELLANEOUS
LATHING	FINAL AIR COND.	GRADING & DRAINAGE
BACKING (SIDS)	FINAL REFRIG.	ON-SITE PARKING SPACES APP.
PLASTER	FINAL SEWER	ENG. APPROVAL OF
SCRATCH	FINAL SEPTIC TANK	OFF-SITE IMPROVEMENTS
BROWN		
URBAN REDEVELOPMENT, APPROVAL		
FINAL BLDG. <u>11-23</u> DATE <u>9-24-65</u>		

APPROVED FOR OCCUPANCY & METER

INSPECTOR

DATE

PLEASE NOTE REMARKS ON REVERSE SIDE 517 East Fremont

LOG: #

AREA: #

23.04

Albini Inspection 4-26-88

DEPARTMENT OF BUILDING AND SAFETY
City of Las Vegas, Nevada

SPECIAL INSPECTOR'S REPORT

Date: 4-27-88

Job: 517 FREMONT ST

WEATHER CONDITIONS: Clear Day Intermittent Clouds Overcast

Temperature: 8 A.M. 12:00 Noon 4 P.M.

Wind Velocity (estimated) ground level upper level ()
Specify Elevation

TESTS MADE TODAY:

WORK PERFORMED TODAY: SPECIAL INSPECTION AS REQUIRED BY THE
STRUCTURAL ENGR. FOR THE CORRECTION OF THE DEFICIENCY IN THE
EMBEDMENT OF THE WEDGE ANCHORS OF THE SEATS FOR THE TROUSERS
ON THE ~~NORTH~~ EAST & WEST WALLS AS PER ATTACHED DETAILS.

0 14 SEATS O.K. AS IS
8 " CORRECTED AS PER DET. "1"
5 " " " " "2"
13 " " " " "3"
40 SEATS TOTAL

ALL WORK WAS COMPLETED IN ACCORDANCE WITH THE
ATTACHED DETAILS.

REMARKS: TIME REQ'D. 4.0 HOURS

OF

[Signature]

Abbi Ingram 4-26-88

SENT BY: A

: 3-25-88 2:32PM :

33-12-

702 382 0001:W :

FACSIMILE TRANSMISSION COVER SHEET

DATE:

3-25-88

PLEASE DELIVER THE FOLLOWING PAGES TO:

NAME: Warron Johnson

FIRM: J. A. TIBERTI CONST.

FACSIMILE NO.: (702) 382-5341

FROM:

NAME: BILL ALSMEYER

FACSIMILE NO.: (415) 243-0901

LAD JOB NO.: 518286

PROJECT NAME: FREMONT ST. STATION

TOTAL NUMBER OF PAGES INCLUDING COVER SHEET 5

SAN FRANCISCO OFFICE PHONE NO. (415) 243-0900

COMMENTS:

Alphi Ingram 4-26-88

SENT BY: A

3-25-88 2:22PM

30412

702 352 5361

LEO A DALY

PLANNING/ARCHITECTURE/ENGINEERING
Suite 845/221 Main Street/San Francisco, California 94105-1022, USA
Telephone: 415-243-0800

TRANSMITTAL NO.

TO: J. A. TIGERTI CONVT.

JOB NO: 31-1006 DATE: 3/19/88

NAME: FREEMONT ST. STORE

REMOVAL

LKS VIEWS, H.V.

ATTN: WARREN JOHNSON

WE ARE SENDING YOU: ☒ HEREWITH ☐ UNDER SEPARATE COVER

☒ PRINTS

☐ SPECIFICATIONS

☐ SUBMITTAL DATA

☐ TRACINGS

☐ SHOP DRAWINGS

☐ FOR YOUR RECORDS

☐ FOR YOUR SIGNATURE

☐ AS REQUESTED

☐ FOR YOUR REVIEW

☐ FOR DISTRIBUTION

AS FOLLOWS:

COPIES	TITLE	DATED
1 EA	8/11 SHEET PAGE 1 AND 2 OF 2	3/20/88

REMARKS: THESE ARE FIXES REQ'D TO CORRECT THE
EXPERIENCED DEFICIENCIES IN THE EMBODIMENT
OF AN APPROXIMATE NUMBER OF THE WEDGE
ANCHORS.

IF ITEMS LISTED ARE NOT RECEIVED, PLEASE NOTIFY SENDER AT ONCE

COPIES TO: FILE

LEO A DALY

BY: W. E. ALBY

Albini Inghram 4-26-88

JUN 23 1988 2:01PM

30412

702 382 5361:R

31



SUBJECT

MOUNT FREMONT ST. STORE

LAS VEGAS, NEVADA

COMPUTED

CHECKED

DATE


PAGE

OF

FREMONT ST. STORE

STRUCTURAL CALCULATIONS

312286

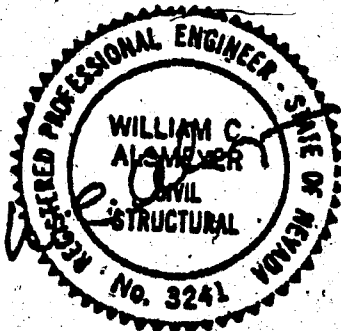

LEO A. DALY FORM NO. 6

LEO A. DALY & ASSOCIATE
221 MAIN ST.
SUITE 845
SAN FRANCISCO, CA
NOVEMBER 1987

REV. 2/7/87

Albion Ingram 4-26-88

SENT BY: A

3-25-88 2:31PM

30413

702 352 5351



SUBJECT

PROJECT EL CORTEZ

FREMONT STORE REMODEL


COMPUTED V. AHUJA CHECKED

DATE 3/24/88


PAGE 1

OF 2

PAGE

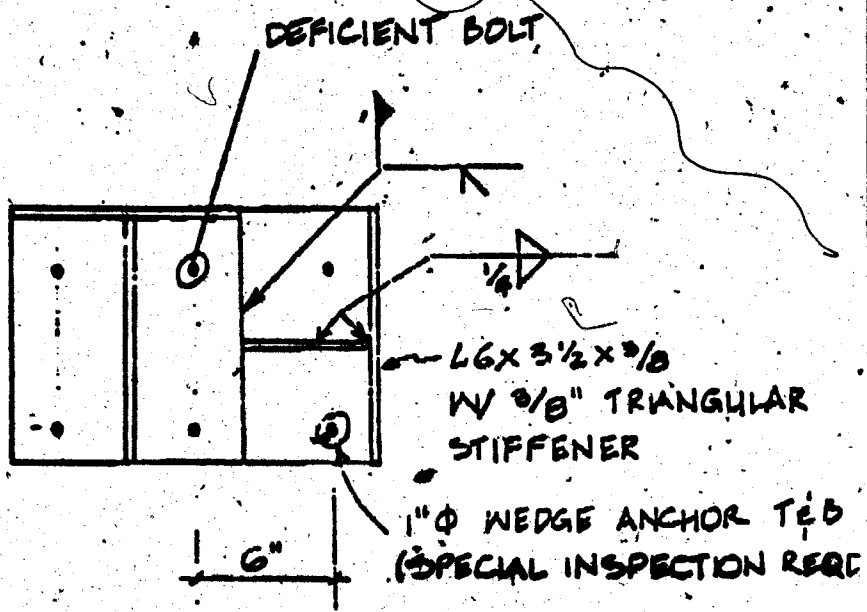

1 TOP OR VERTICAL ROW BOLTS
< 4 1/2" EMBEDMENT
1 1/2" = 1'-0" (8)

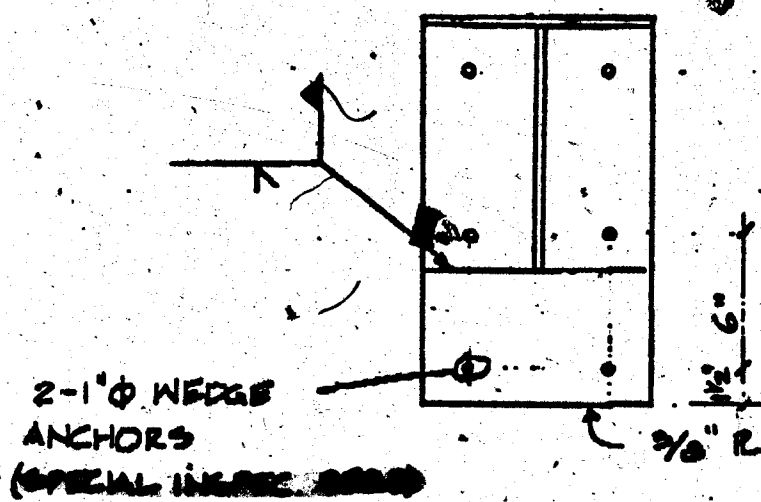

2 ANY ONE BOTTOM ROW
BOLT < 4 1/2" EMBEDMENT
1 1/2" = 1'-0" (5)

Abdi Ingaram 4-26-88

SENT BYNA

3-25-88 2:02PM

30412

702 382 5361:R 5



SUBJECT

POINT EL CORTEZ

FREMONT STORE REMODEL

COMPUTED

V. AHUJA



CHECKED

DATE 3/24/88

PAGE 2

OF 2

PAGES

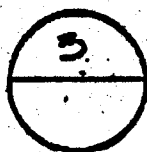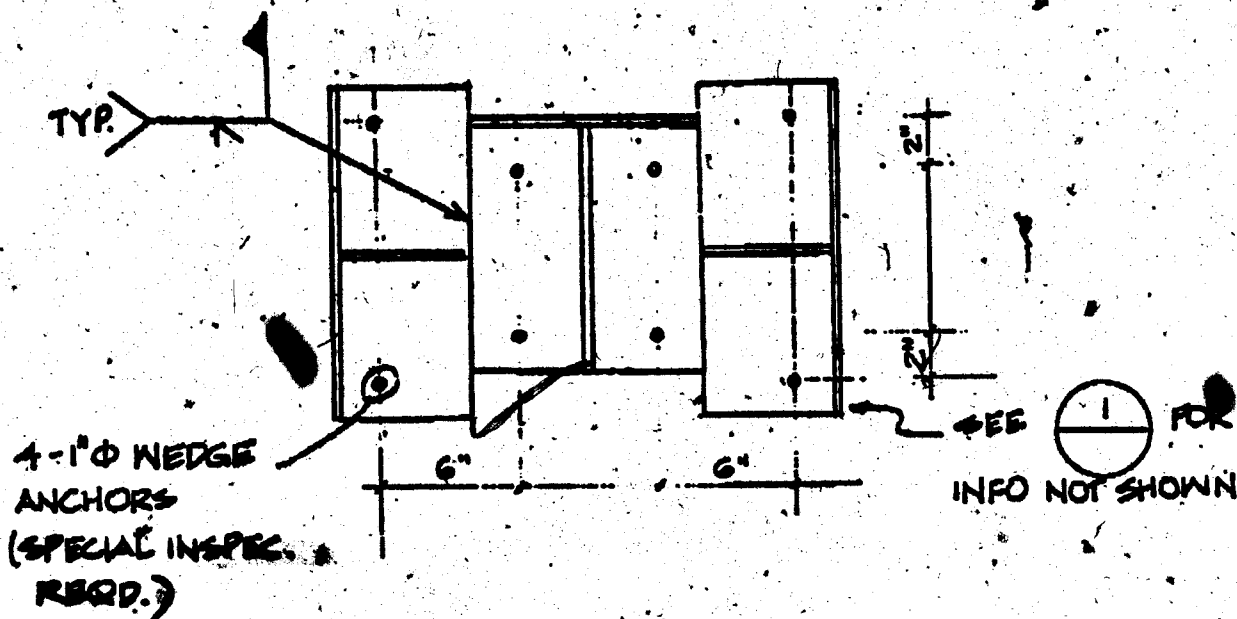

2 TOP ROW OR ANY 3 TOTAL
BOLTS < 4 1/2" EMBEDMENT

1 1/2" = 1'-0" (13)

Debbie Ingram 2-7-89

ELEC. ONLY PLBG. ONLY, A.C. ONLY

OWNER	Western Union		DATE	9/16/88
ADDRESS	577 E. Diamond			
CONTRACTOR	PERMIT NO.	FINAL INSPECTION		
LOT	BLOCK	SUBDIVISION		
LOG NO.	AREA			
ELECTRIC ONLY		PLUMBING ONLY		
Contractor	Digital	Contractor		
Permit No.	5328-1	Permit No.		
Rough Elec.		Rough Soil		
Final Rough		Rough Water		
Final Elec.	10/11/88	Top Out		
Temp. Service		Rough Gas		
HEAT & VENT. A/C ONLY		Final Plbg.		
Contractor		Final Gas		
Permit No.		Sewer Final		
A/C Rough Duct				
Rough Gas				
Final A/C				
Final Gas				

79-3-13 (R11-81) DEPT. OF BLDG. & SAFETY
CITY OF LAS VEGAS

ELEC. ONLY PLBG. ONLY, A.C. ONLY

OWNER	Telegraph Office		DATE	8/24/88
ADDRESS	577 E. Diamond			
CONTRACTOR	PERMIT NO.	FINAL INSPECTION		
LOT	BLOCK	SUBDIVISION		
LOG NO.	AREA			
ELECTRIC ONLY		PLUMBING ONLY		
Contractor	Alarm Inc.	Contractor		
Permit No.	4284	Permit No.		
Rough Elec.		Rough Soil		
Final Rough		Rough Water		
Final Elec.	10/17/88	Top Out		
Temp. Service		Rough Gas		
HEAT & VENT. A/C ONLY		Final Plbg.		
Contractor		Final Gas		
Permit No.		Sewer Final		
A/C Rough Duct				
Rough Gas				
Final A/C				
Final Gas				

79-3-13 (R11-81) DEPT. OF BLDG. & SAFETY
CITY OF LAS VEGAS

Debbie Ingraham 6-10-89

OWNER	Exber, Inc.	ADDRESS	517 E. Fremont
DATE	5-27-88	GEN. CONT.	Tiberti
TYPE OF STRUCTURE	Plan review & bldg.	PERMIT No.	0891
LEGAL DESCRIPTION		LOG No.	M-816-C
APPROVED FOR OCCUPANCY & METER			
BUILDING		MECHANICAL	
Location & Footing		Plumbing Cont.	
Concrete Slab-Floor		Permit No.	Date
Fireplace Footing		Htg./Vt./A.C. Cont.	Permit No. 2858 Date 7/1/88
Chimney Steel		Permit No.	Date
Vert. Steel Reinf.		Sewer Cont.	
Horiz. Steel Reinf.		Permit No.	Date
Framing		Rough Soil	
Ext. Lath		Rough Water	
Roof Sheathing		Top Out	
Ext. Brown		Rough Gas	
Insulation		A/C Rough Duct	
Drywall		Final Plumbing	
Final Building	exp 3/1/85	Final Gas	
Appr. for Occu.		Final Air Cond.	76823188
ELECTRICAL		Final Sewer	
Temp. Pole cont.		REMARKS	
Permit No.	Date		
Inspection	Date		
Electrical Cont.			
Permit No.	Date		
Rough		PLEASE NOTE ADDITIONAL REMARKS ON REVERSE SIDE	
Final Electrical		DEPT. OF BLDG. & SAFETY CITY OF LAS VEGAS REV 782.3.29	
Temporary Service			

OWNER	Exber Inc.	ADDRESS	517 E. Fremont
DATE	3-15-88	GEN. CONT.	J A Tiberti
TYPE OF STRUCTURE	fire repair	PERMIT No.	7877
LEGAL DESCRIPTION		LOG No.	C-30
APPROVED FOR OCCUPANCY & METER			
BUILDING		MECHANICAL	
Location & Footing		Plumbing Cont.	Desert 216
Concrete Slab Floor	1.1m76312318	Permit No.	2970 Date 10/1/88
Fireplace Footing		Htg./Vt./A.C. Cont.	Permit No. 9713 Date 4/24/88
Chimney Steel		Permit No.	Date
Vert. Steel Reinf.		Sewer Cont.	
Horiz. Steel Reinf.	76311788	Permit No.	Date
Framing	100444176312318	Rough Soil	76311788
Ext. Lath & Brown	76423188	Rough Water	
Roof Sheathing		Top Out	76511618
Ext. Brown		Rough Gas	
Insulation		A/C Rough Duct	
Drywall		Final Plumbing	76823188
Final Building	exp 3/1/85	Final Gas	
Appr. for Occu.		Final Air Cond.	
ELECTRICAL		Final Sewer	76311788
Temp. Pole cont.		REMARKS	
Permit No.	Date		
Inspection	Date		
Electrical Cont.			
Permit No.	Date		
Rough		PLEASE NOTE ADDITIONAL REMARKS ON REVERSE SIDE	
Final Electrical		DEPT. OF BLDG. & SAFETY CITY OF LAS VEGAS REV 782.3.29	
Temporary Service			