




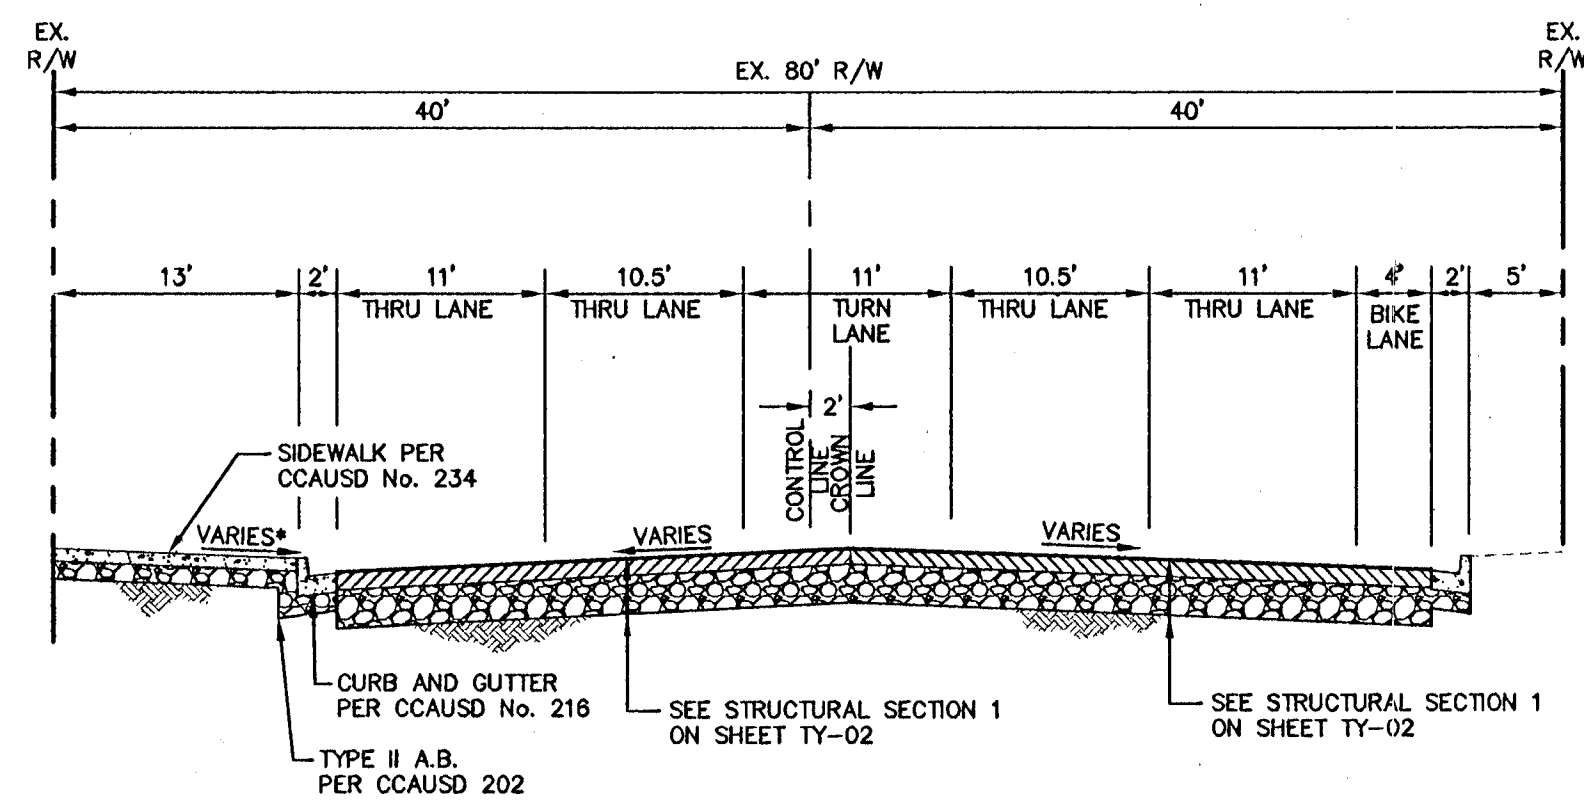


1 BONNEVILLE AVENUE
- MAIN ST TO 1ST STREET NTS

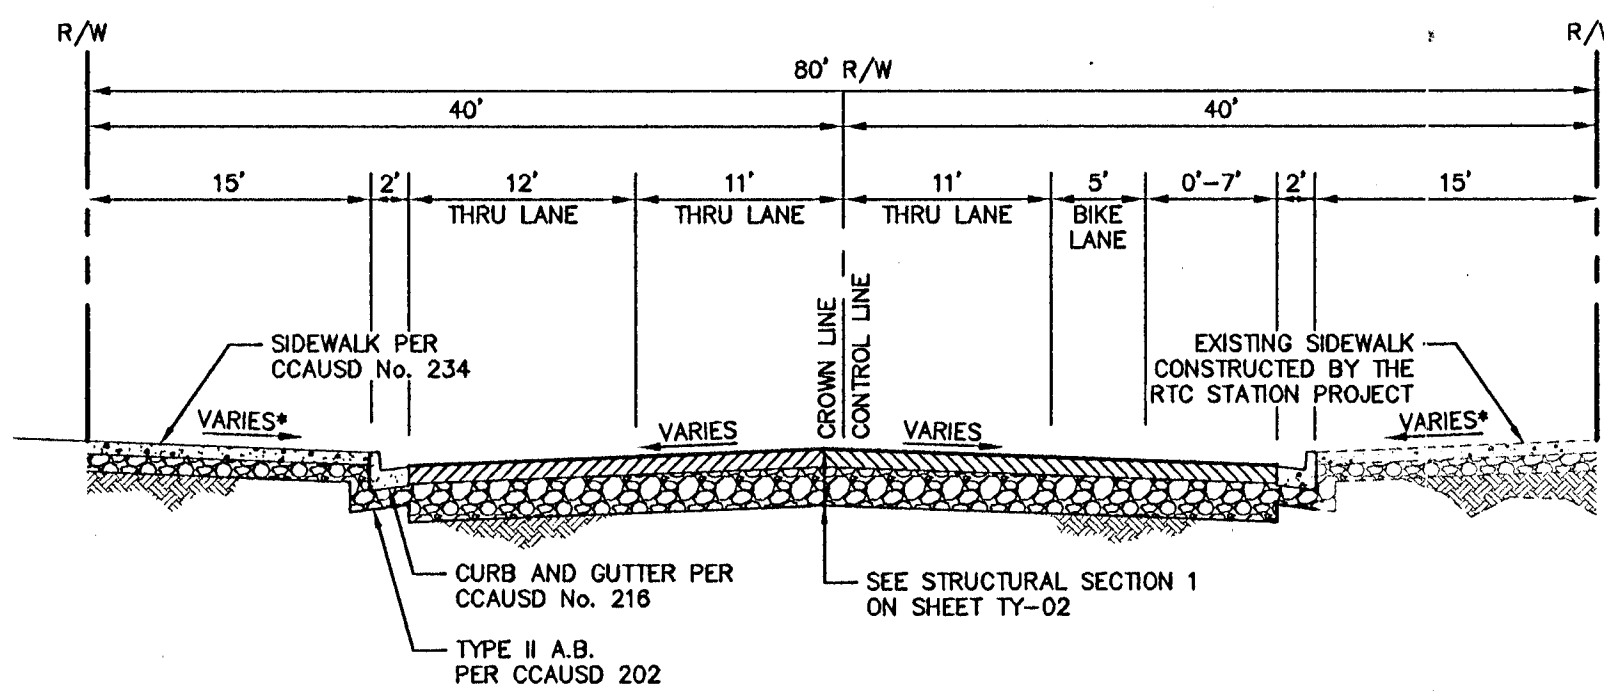


3
- BONNEVILLE AVENUE
CONNECTOR TO CASINO CENTER NTS

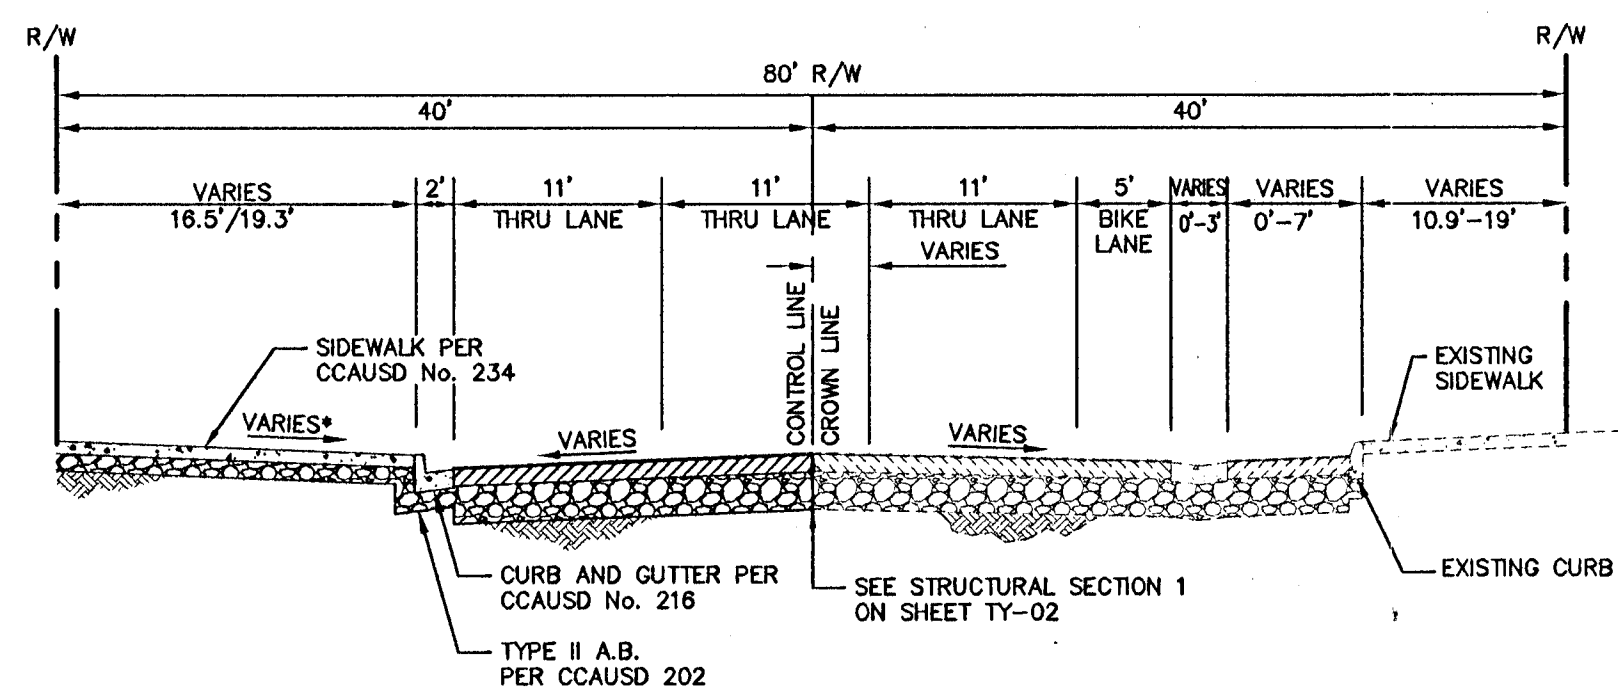


5 BONNEVILLE AVENUE
STA: 113+34.34 TO STA: 114+84.46 NTS

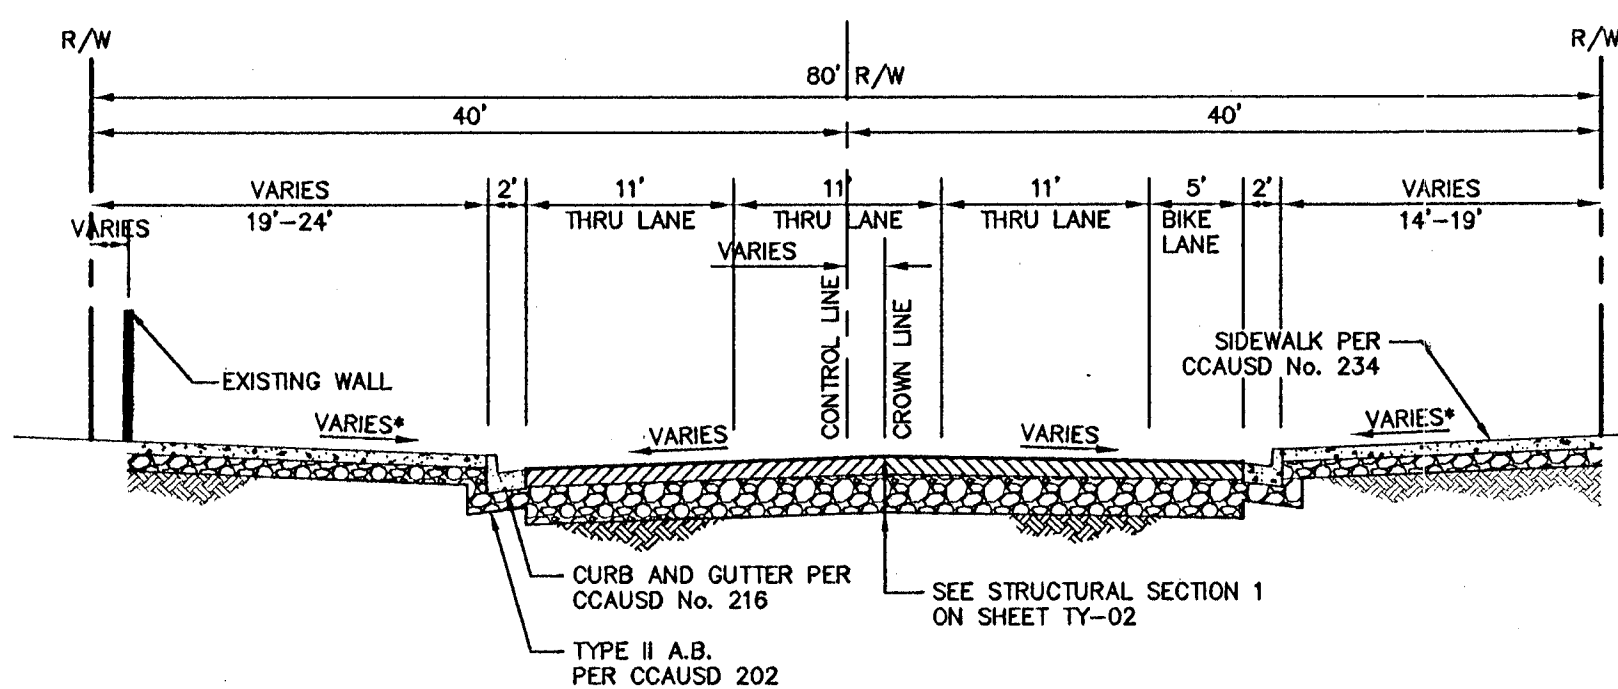


7 BONNEVILLE AVENUE
- 4TH STREET TO LAS VEGAS BLVD NTS

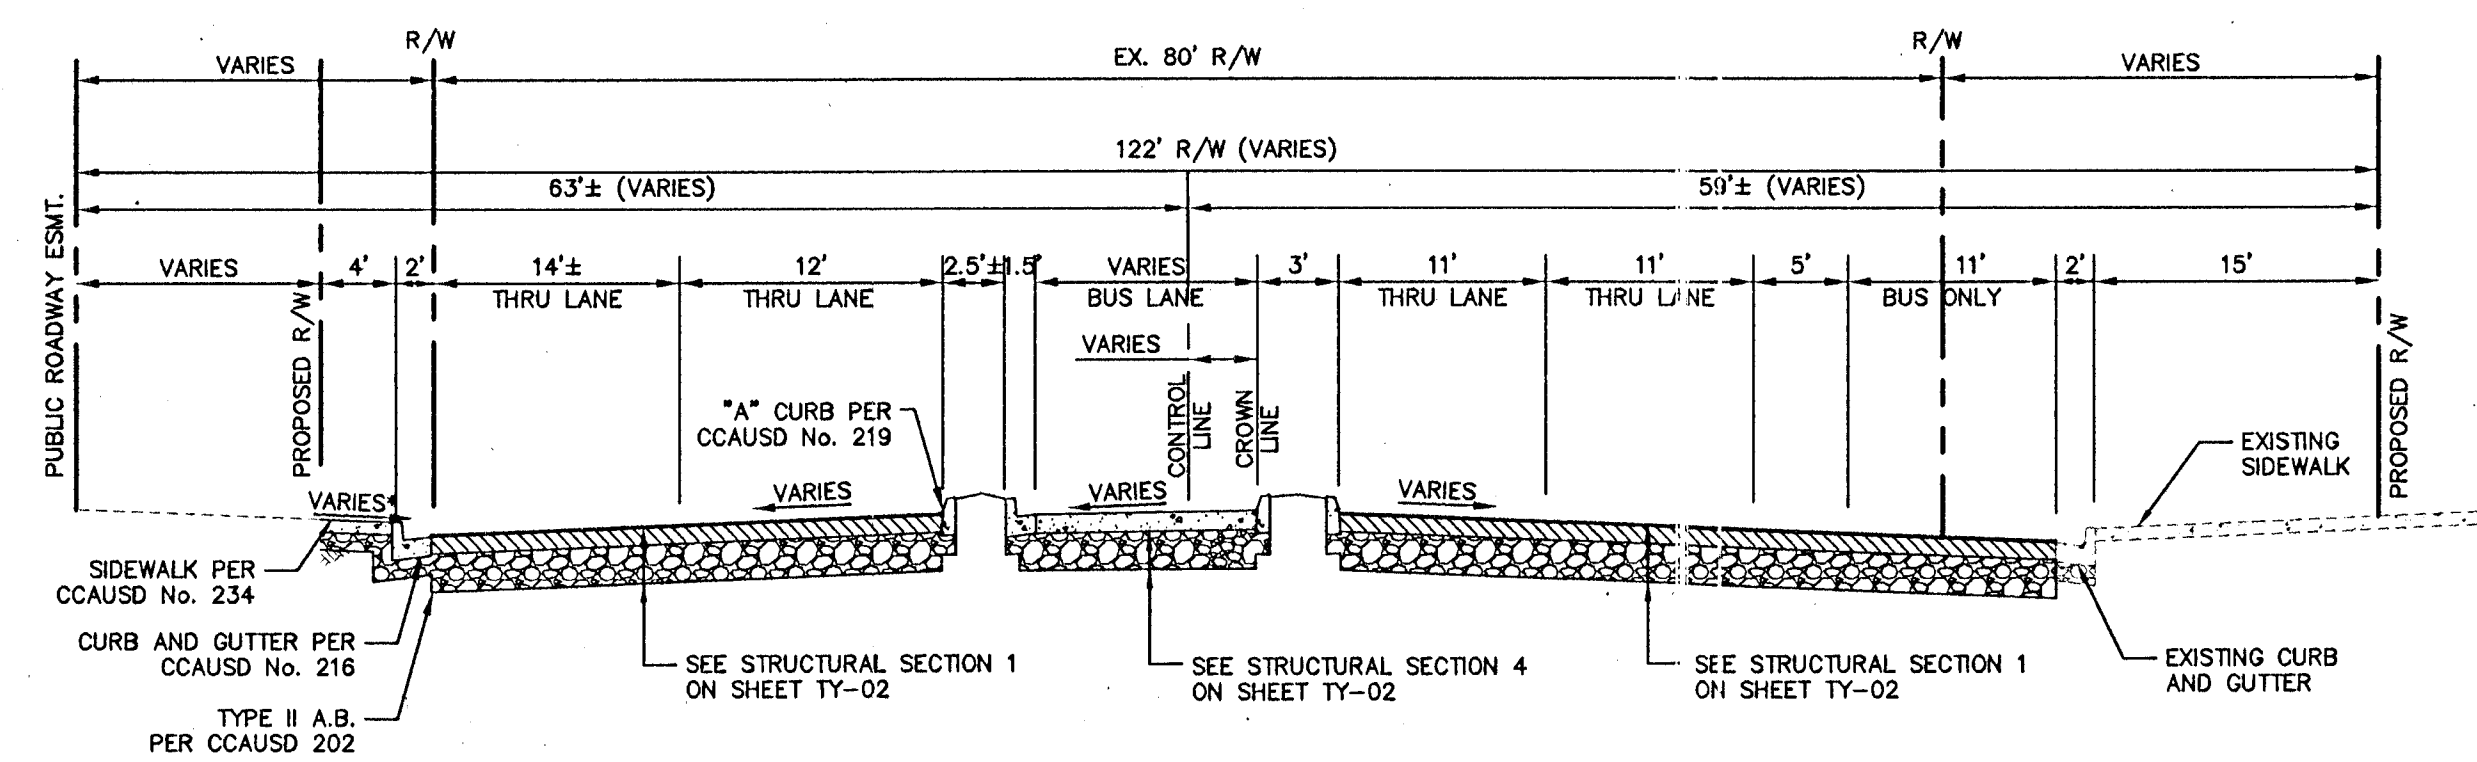


2 BONNEVILLE AVENUE
1ST STREET TO CONNECTOR STA: 103+84.32 TO STA: 105+27.56 NTS

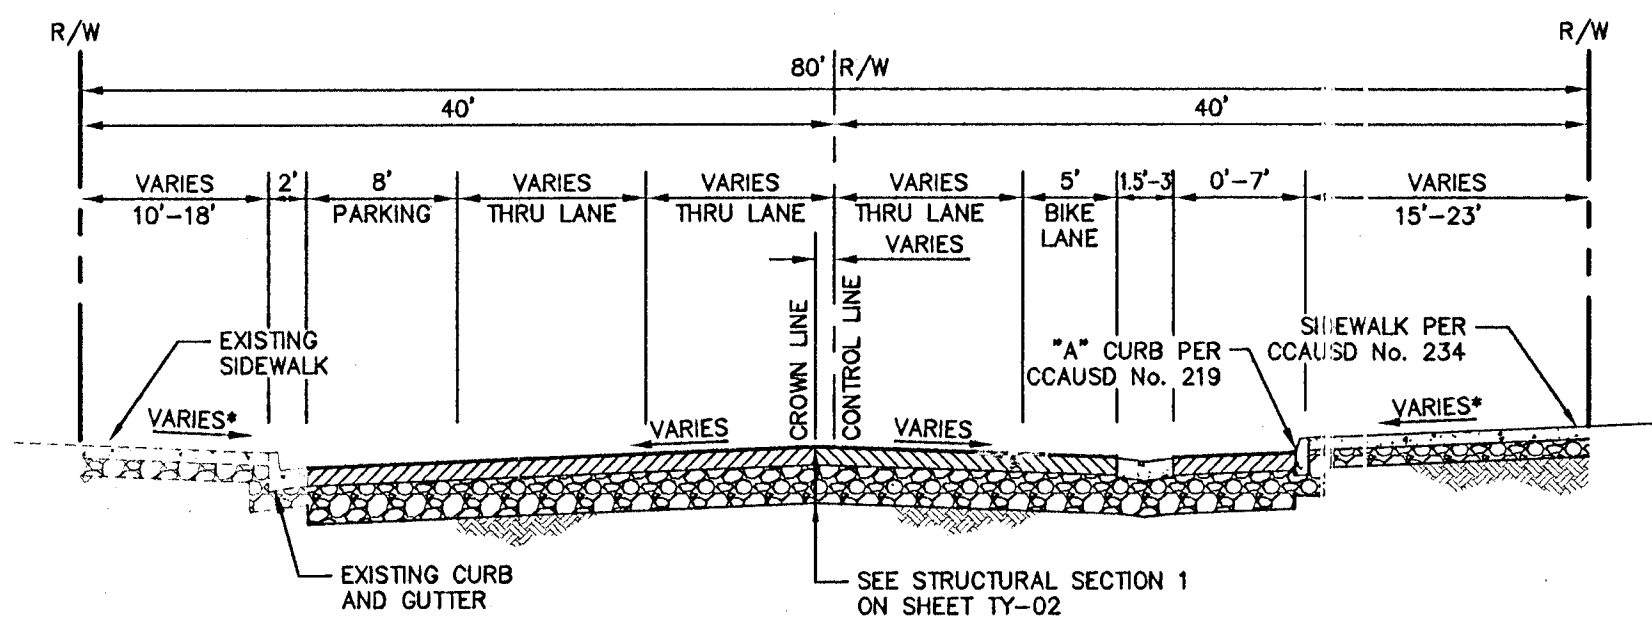

4 BONNEVILLE AVENUE
- CASINO CENTER TO 3RD STREET NTS

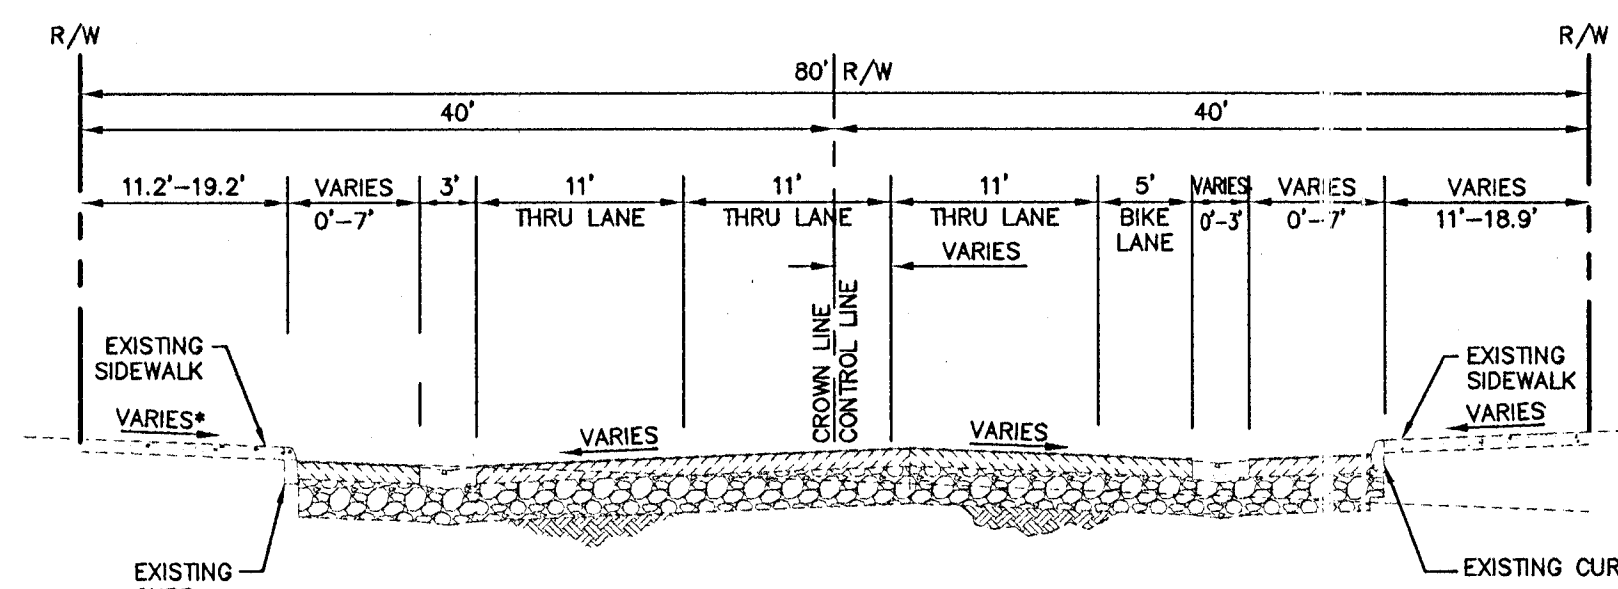

6 BONNEVILLE AVENUE
STA: 112+07.40 TO STA: 113+34.34 NTS

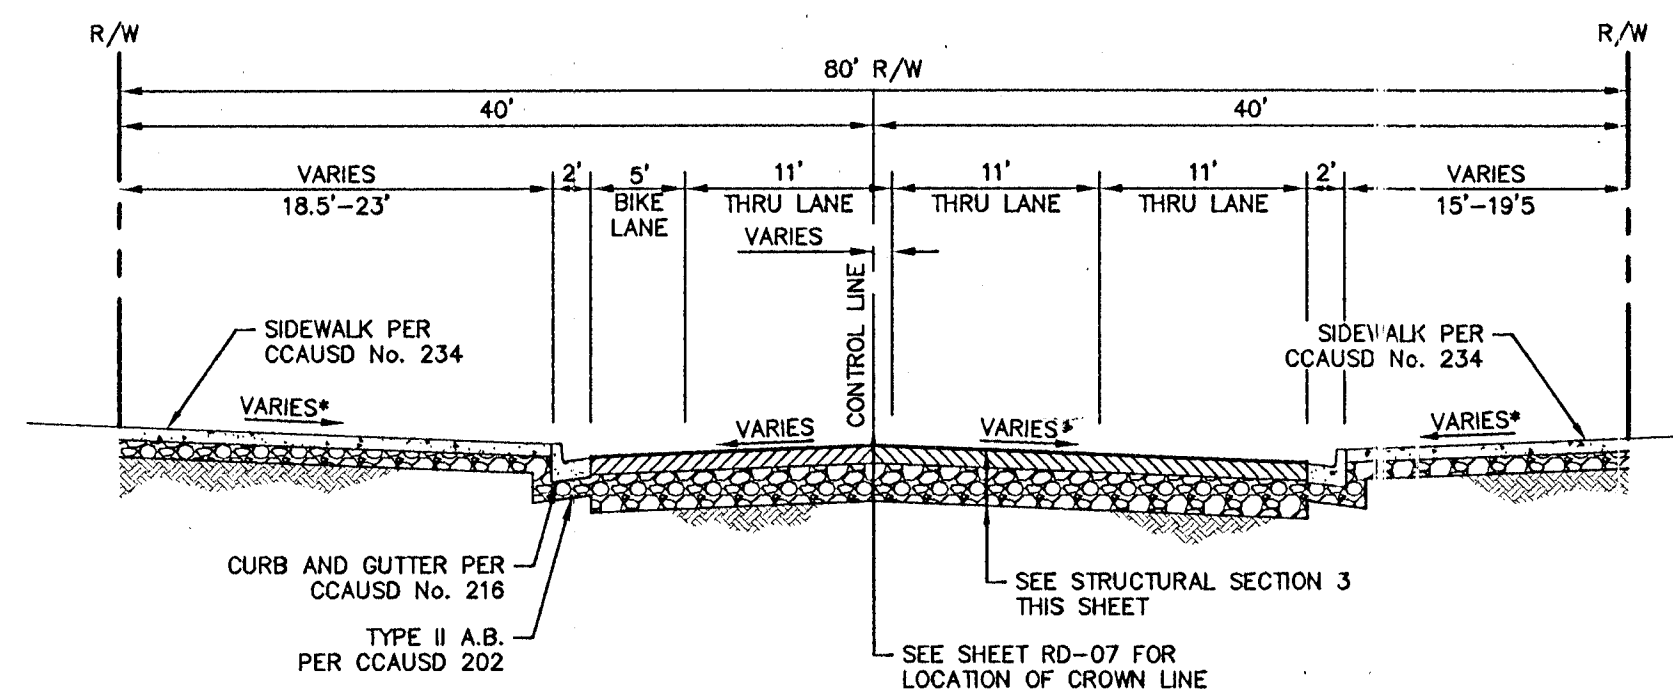

8 CLARK AVENUE
3RD STREET TO 4TH STREET NTS

- SIDEWALK SLOPE VARIES FROM 0.5% MIN TO 2.0% MAX.
SEE PLANS FOR CROSS-SLOPE GRADING.
- ** SEE PLANS FOR EXISTING CURB, SIDEWALK TO REMAIN IN PLACE.

- (1) SEE SHEET TY-2 FOR EXPANSION JOINT DETAIL
- (2) SEE LANDSCAPE PLANS FOR SIDEWALK SCORING PATTERN AND PAVEMENT LIMITS.
- (3) SEE PLAN/PROFILE AND GRADING SHEETS FOR EXACT LOCATION OF CROWN LINE

TAND, INC.
AS-BUILT

DATE DANIEL MEYER

811
know what's below
Call before you dig

SAFETY ALERT
Call
Before You
Overhead
1-702-227-2929


 WAS TESTING UNDERGROUND
 TRAFFIC SIGNAL SYSTEMS
 AND STREET LIGHT SYSTEMS
 AT ONLY
CALL BEFORE
YOU DO
UNDERGROUND

Call before you
UnderGround
 1-702-432-5300
 FREEWAY AND METRO SYSTEM OF TRANSPORTATION



ENGINEER-STATE OF NEVADA
PROFESSIONAL
PETER N. MEYERHOFER
Exp: 12/31/11
CIVIL
No. 18093

9-25-10

SHEET NO.
TY-01
SHEET 14 OF 91
DRAWING NO.
107V5201



ENGINEER-STATE OF NEVADA
PROFESSIONAL
PETER N. MEYERHOFER
Exp: 12/31/11
CIVIL
No. 18093

9-25-10

SHEET NO.
TY-01
SHEET 14 OF 91
DRAWING NO.
107V5201

BID# 09.1730.37