




Apr 25, 2010 - 8:56pm - USER: peter.meyerhofer
\\LAWF01\Projects\LAU_Public\Trans 109225\019 Bonneville-Clark 2008\CAUD\256019-01_0.dwg

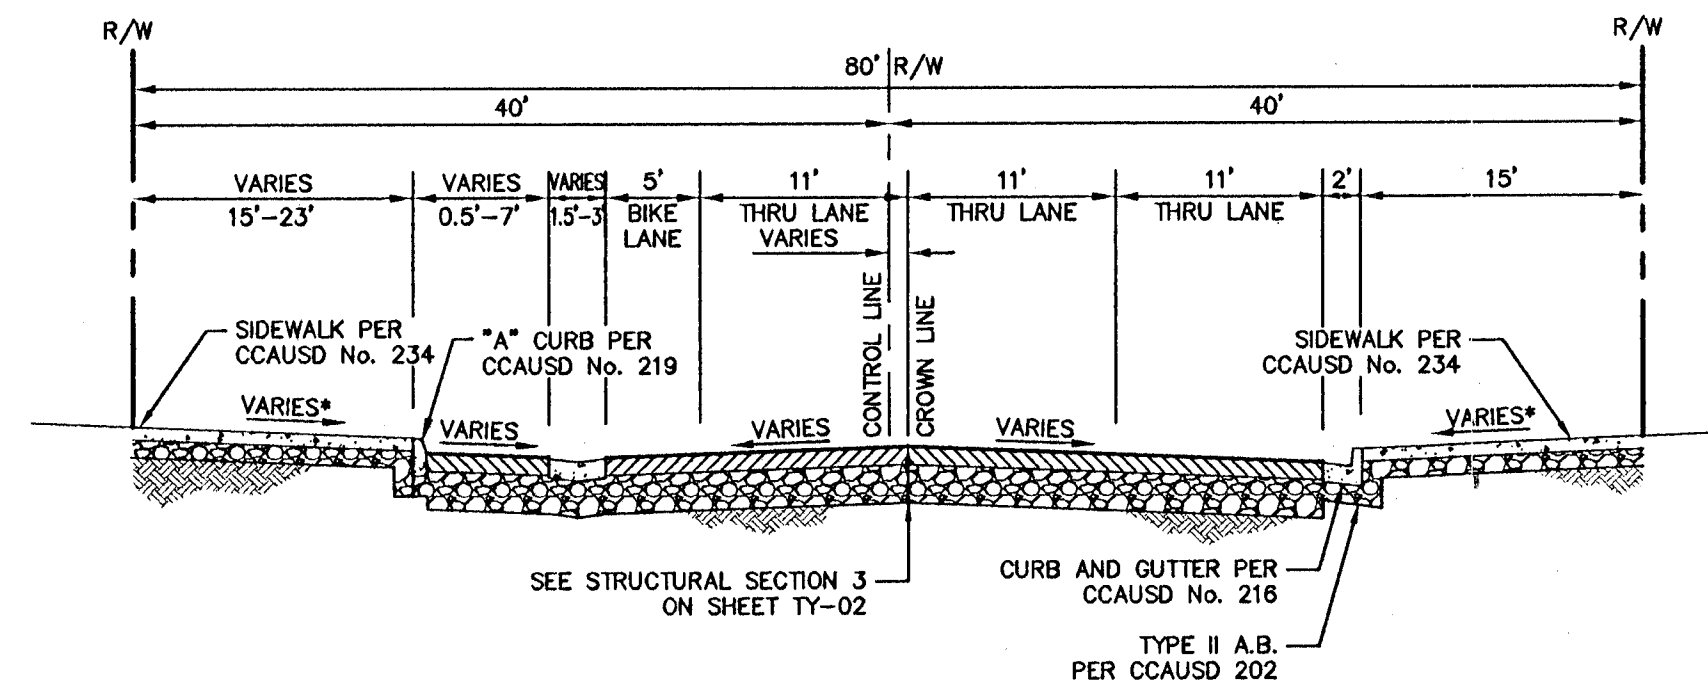


9 CLARK AVENUE
STA: 218+16.73 TO STA: 218+49.47 NTS

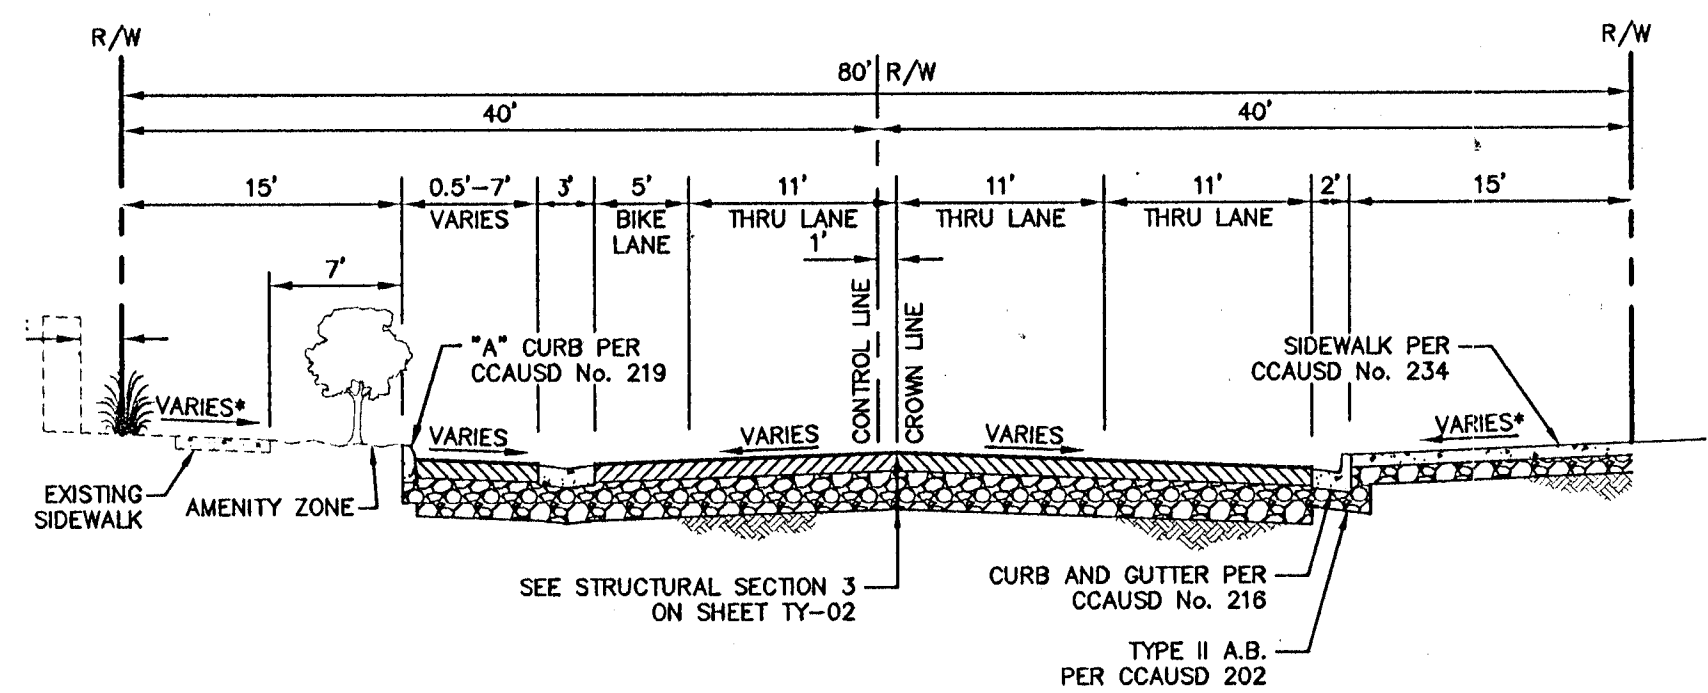


10 CLARK AVENUE
STA: 215+63.71 TO STA: 218+16.73 NTS

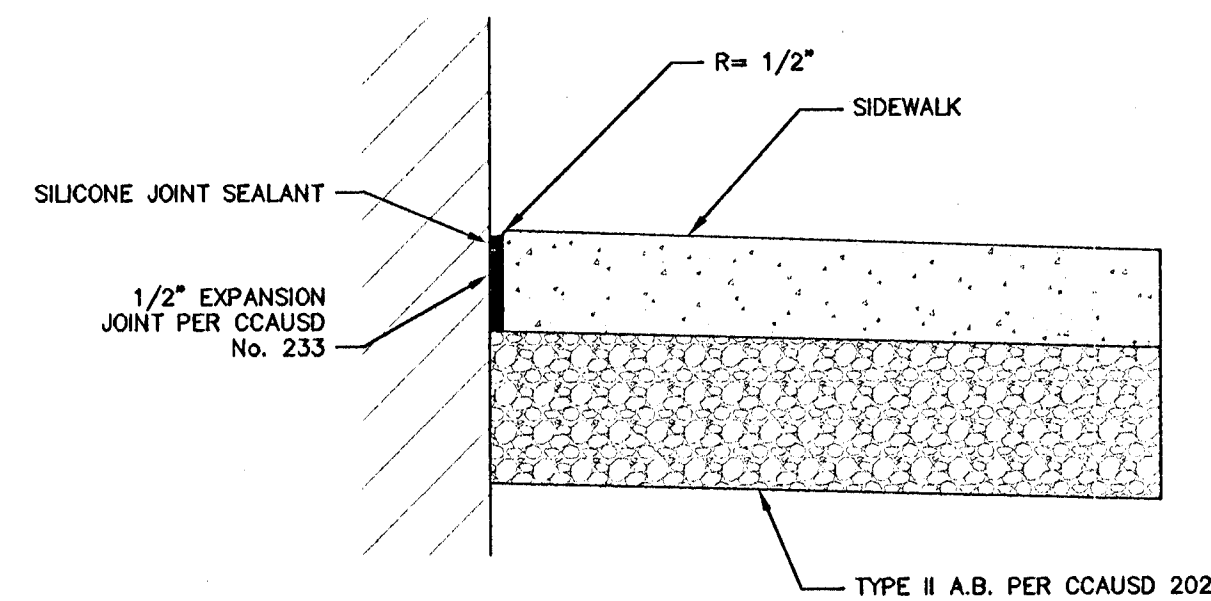


EXPANSION JOINT DETAIL
NTS

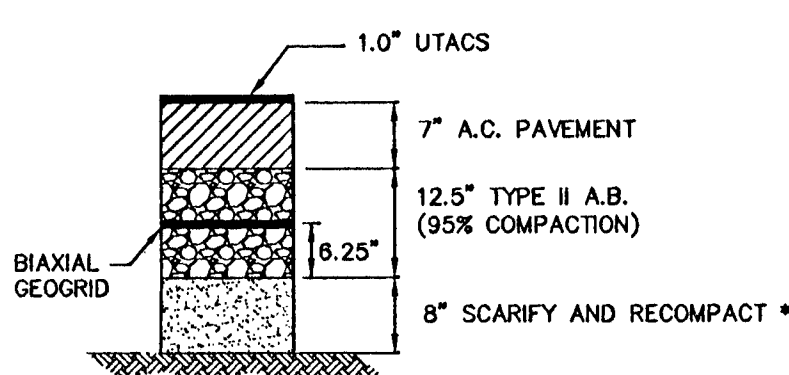


STRUCTURAL SECTION 1
NTS

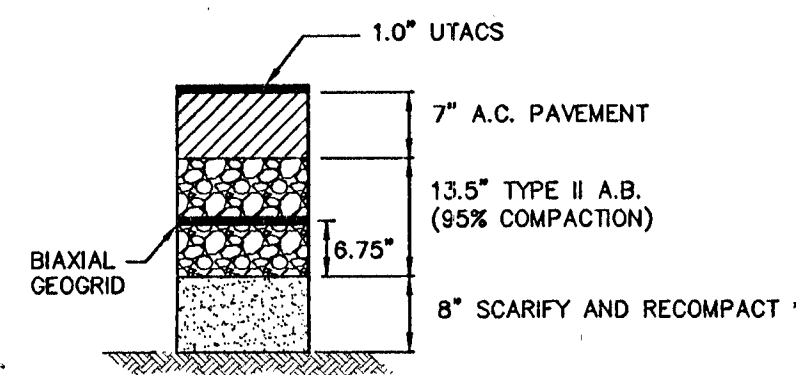


STRUCTURAL SECTION 2
NTS

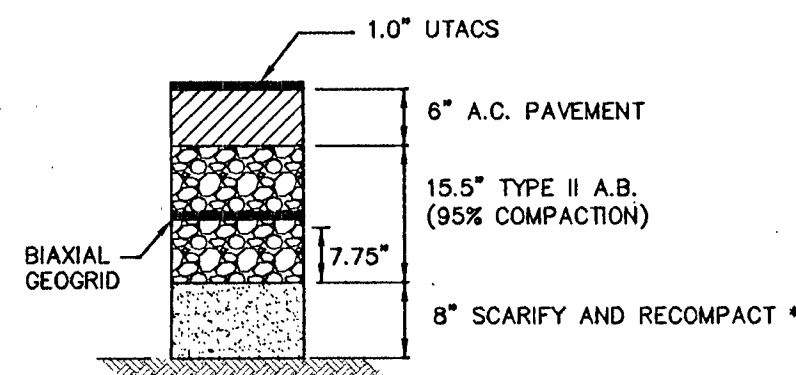


STRUCTURAL SECTION 3
NTS

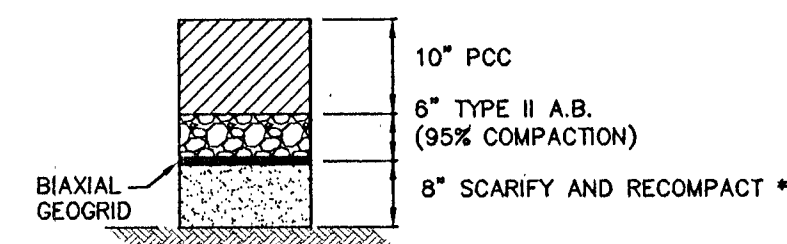


STRUCTURAL SECTION 4
NTS

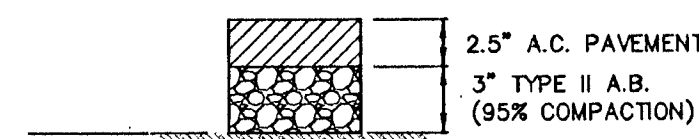

AC PATCH
NTS

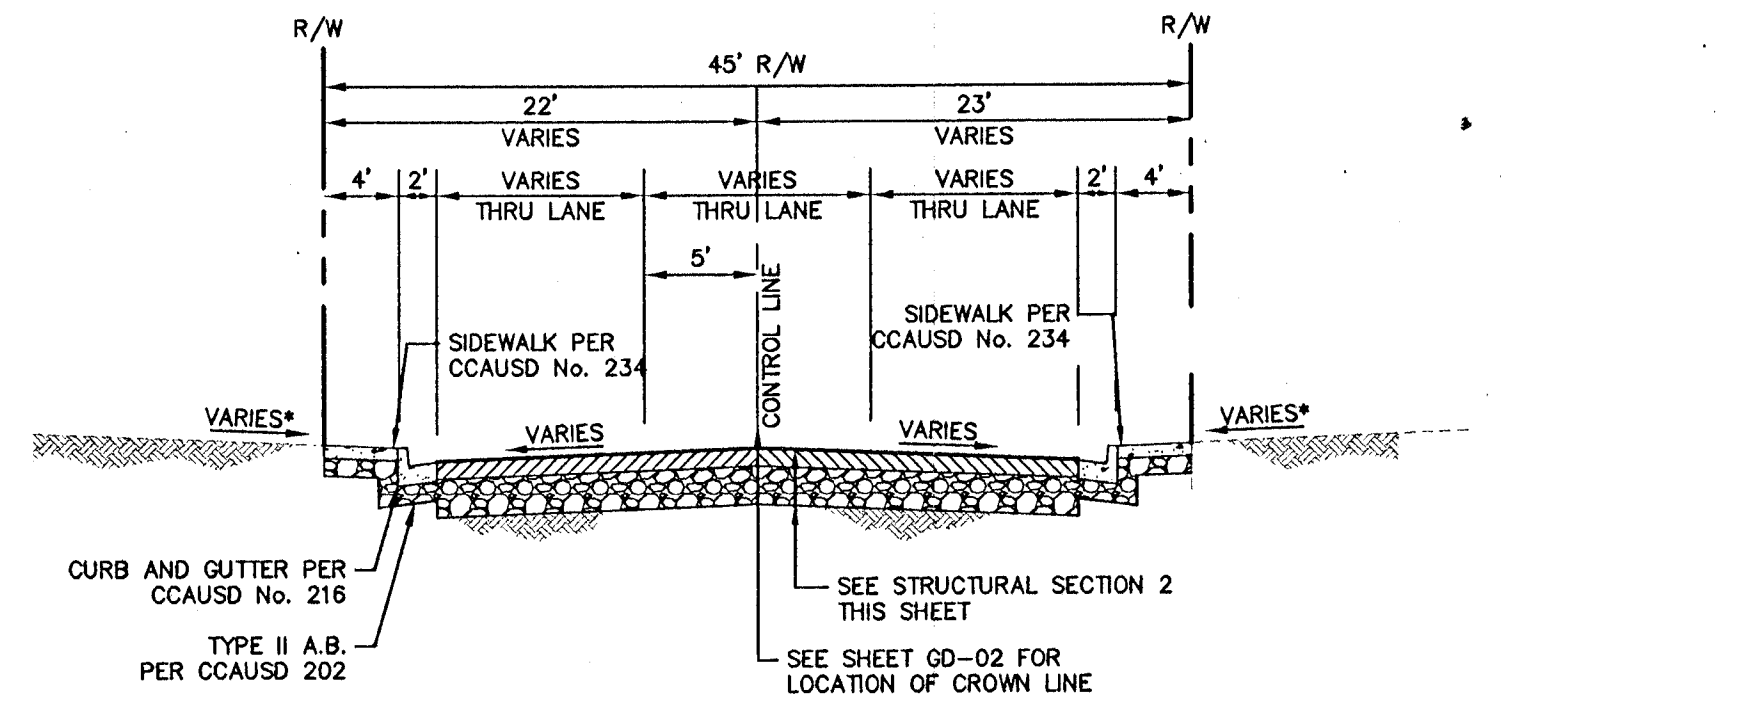

11 CONNECTOR
BONNEVILLE TO CLARK NTS

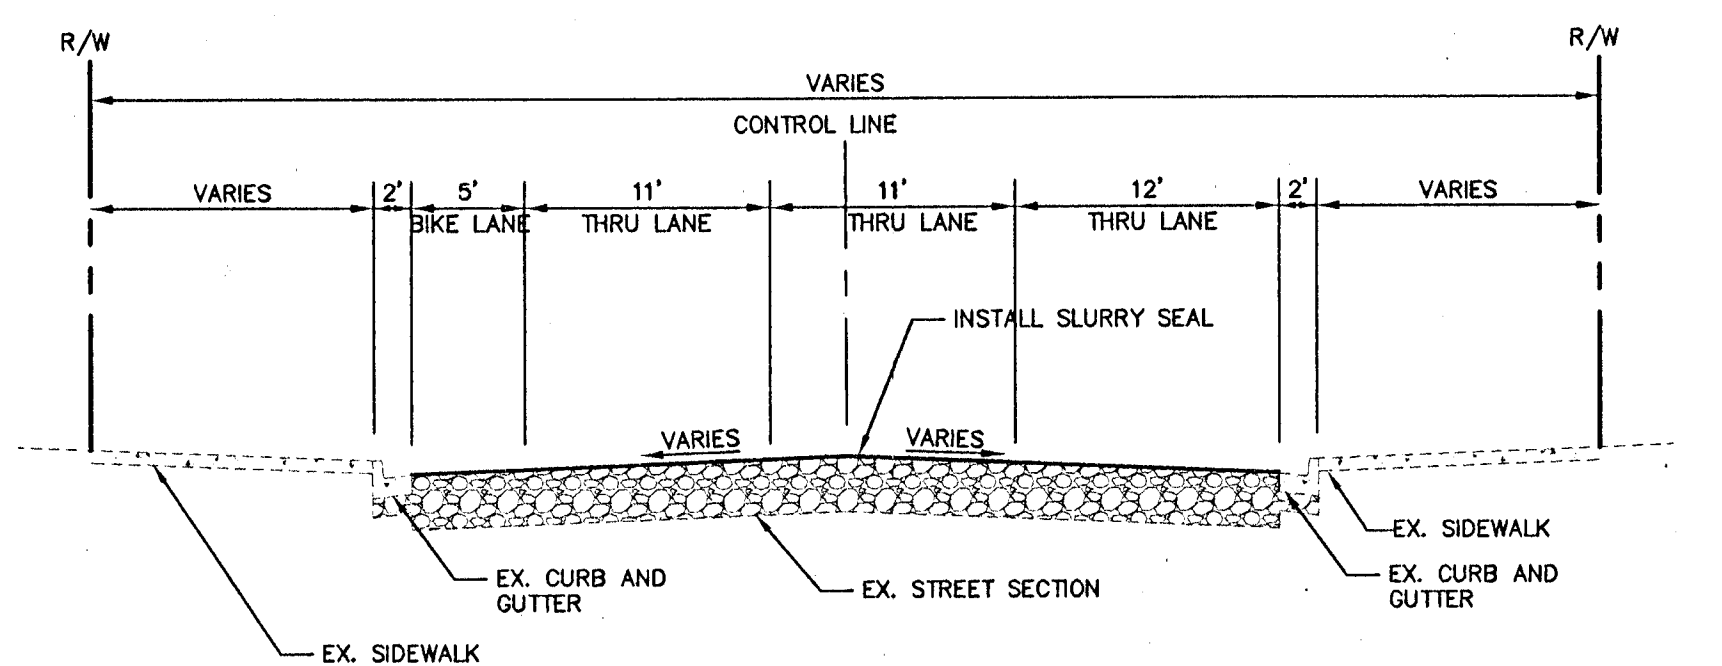

12 EXISTING SECTIONS
CASINO CENTER TO 3RD ST. (CLARK) NTS

- * SIDEWALK SLOPE VARIES FROM 0.5% MIN TO 2.0% MAX. SEE PLANS FOR CROSS-SLOPE GRADING.
- ** SEE PLANS FOR EXISTING CURB, SIDEWALK TO REMAIN IN PLACE.
- (1) SEE THIS SHEET FOR EXPANSION JOINT DETAIL.
- (2) SEE LANDSCAPE PLANS FOR SIDEWALK SCORING PATTERN AND PAYER LIMITS.
- (3) SEE PLAN/PROFILE AND GRADING SHEETS FOR EXACT LOCATION OF CROWN LINE.

* SCARIFY AND RECOMPACT TO 95% MIN 8" OF SUBGRADE. USE STRUCTURAL FILL IF NEEDED.

TAND, INC.
AS-BUILT

811
know what's below
Call before you dig

SAFETY ALERT
Call Before You Overhead

Call before you UnderGround
1-702-432-5300

DEPARTMENT OF PUBLIC WORKS
PROJECT: BONNEVILLE/CLARK ONEWAY COUPLET PHASE 1 IMPROVEMENT PLANS
SHEET: TYPICAL SECTIONS SHEET 2
SHEET NO. TY-02
SHEET 13 OF 31
DRAWING NO. 107V5201

BID# 09.1730.37

20130436