



Apr 25, 2010 - 9:06pm - USER peter.meyerhofer
 \\LA\FP01\Projects\AV_Public\Trans\092255\018 Bonneville-Clark 2008\CADD\256019gr-03_09.dwg

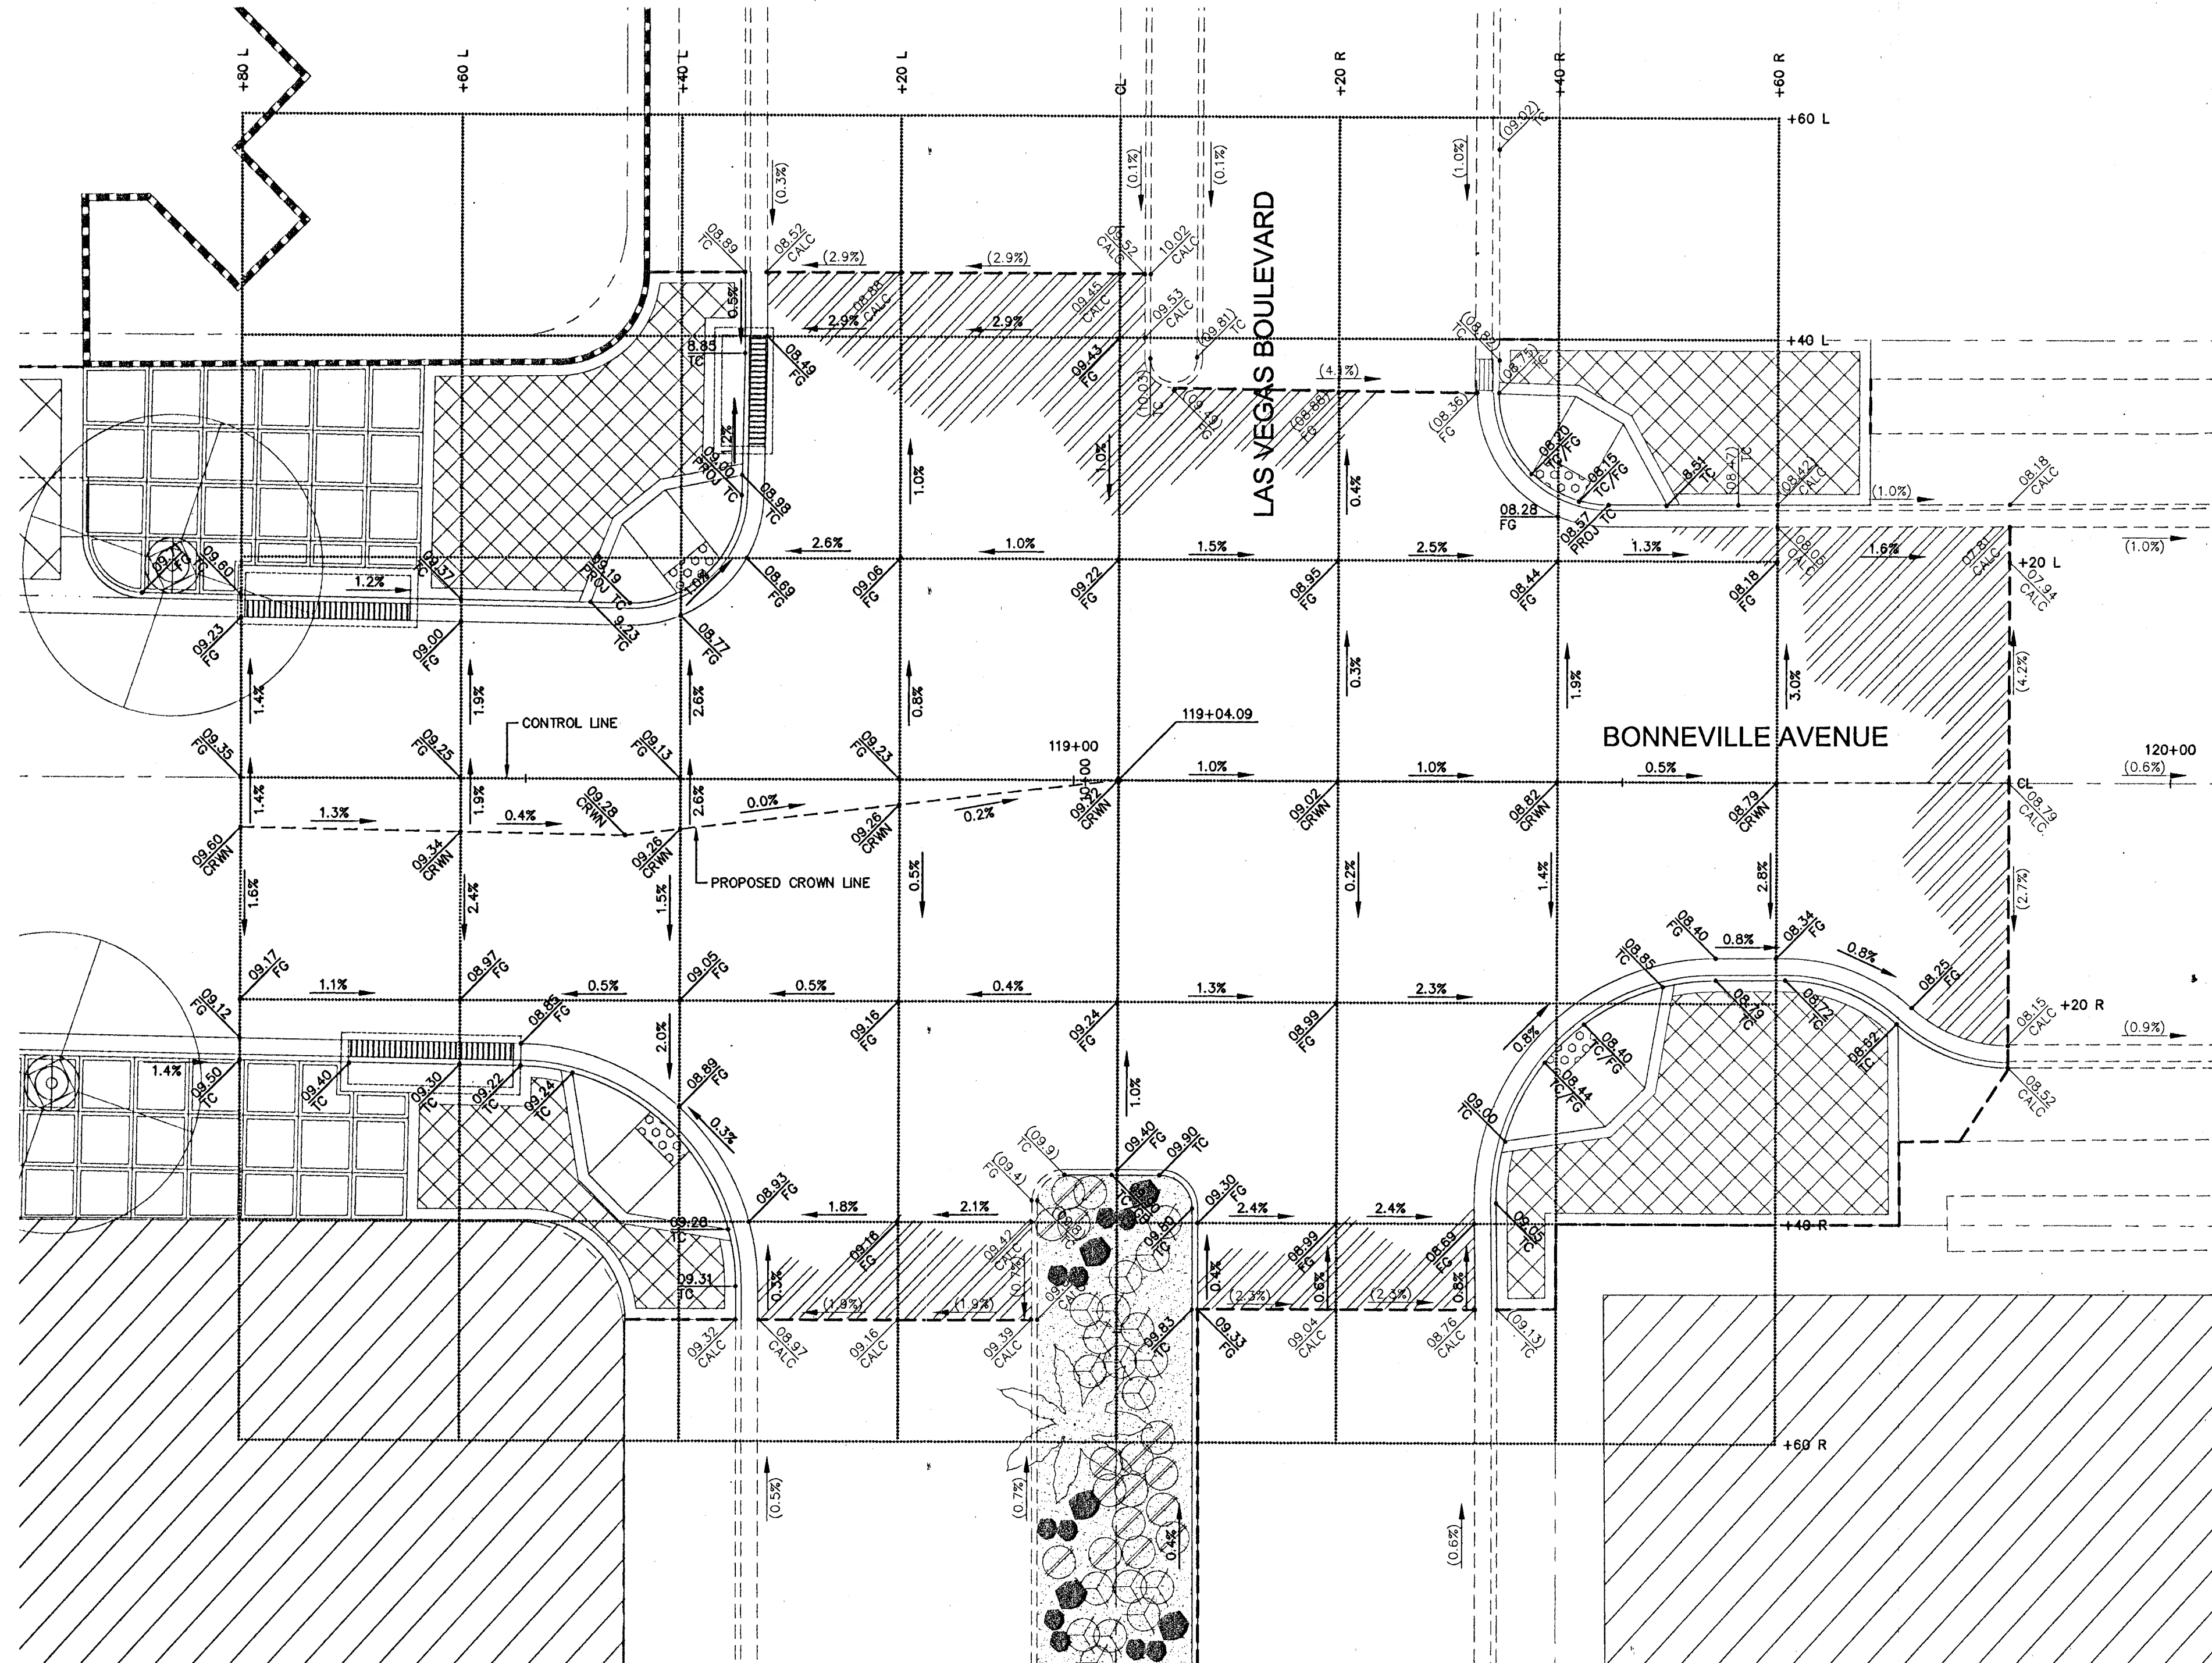

BONNEVILLE/LAS VEGAS INTERSECTION GRADING
 1"=10'

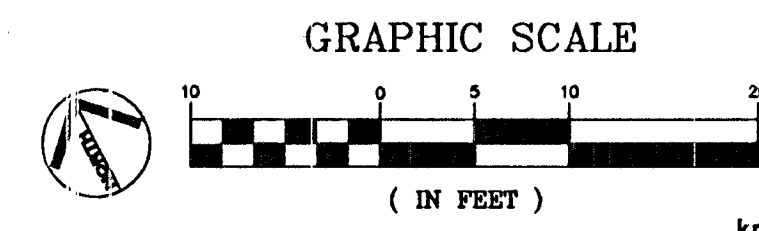

811
 SAFETY ALERT
 Call Before You Dig
 Know what's below
 Call before you dig 1-702-227-2929

TAND, INC.
 AS-BUILT
 DATE: DANIEL MEYER

Professional Engineer Seal for Peter Meyerhofer, State of Nevada, License No. 18093, Exp. 12/31/11.

PROJECT:	BONNEVILLE/CLARK ONEWAY COUPLER PHASE 1 IMPROVEMENT PLANS
SHEET:	GRADING DETAIL INTERSECTION GRADING SHEET
DATE:	FEBRUARY 2010
SCALE (H):	1"=10'
SCALE (V):	N/A
DRAWN BY:	TEA
DESIGNED BY:	TEA
CHECKED BY:	PN/CC
DATE:	FEBRUARY 2010

Kimley-Horn and Associates, Inc.
 Engineering, Planning, and Environmental Consultants
 2080 E. Flamingo Road, Suite 210, Las Vegas, NV 89119
 PH: 702.734.4949



20130415

BID# 09.1730.37