

KEY MAP

STORM DRAIN NOTES

- ① REMOVE EXISTING DROP INLET.
- ② CONNECT PROPOSED IMPROVEMENTS TO EXISTING STORM DRAIN PIPE.
- ③ CONSTRUCT 60 INCH TYPE III MANHOLE PER CCAUSD No. 406.
- ④ CONSTRUCT TYPE "CM2" DROP INLET (L=5.0') PER CCAUSD No. 412A.
- ⑤ CONSTRUCT TYPE "CM2" DROP INLET (L=15.0') PER CCAUSD No. 412A.
- ⑥ INSTALL 24" C-905 PVC PIPE. SEE TRENCH DETAIL SHEET SD-1. STORM PIPE SHALL BE A MINIMUM 6" VERTICAL ABOVE WATER CROSSINGS.
- ⑦ CONSTRUCT 24" REINFORCED CONCRETE PIPE CLASS III.
- ⑧ CONSTRUCT 18" REINFORCED CONCRETE PIPE CLASS III.
- ⑨ REMOVE OR ABANDON EXISTING STORM DRAIN LATERAL. IF ABANDON, CUT AND CAP PIPE, BACKFILL WITH CONCRETE SLURRY.
- ⑩ CONNECT PROPOSED RCP STORM DRAIN TO EXISTING 48" MANHOLE. PROTECT EXISTING MANHOLE IN PLACE.
- ⑪ SAWCUT EXISTING 18" RCP STORM DRAIN 6" FROM EXISTING DROP INLET AND PROTECT EXISTING RCP IN PLACE. CONNECT PROPOSED 18" RCP TO EXISTING 18" RCP WITH CONCRETE PIPE COLLAR PER DETAIL "A" THIS SHEET. SEE TRENCH DETAIL SHEET SD-1.
- ⑫ CONSTRUCT TYPE "CM2" DROP INLET (L=10.0') PER CCAUSD No. 412A.

TAND, INC.
AS-BUILT

11-18-11
DATE DANIEL MEYER

BASIS OF BEARING


THE BASIS OF BEARINGS FOR THIS SURVEY IS GRID NORTH AS DEFINED BY THE NORTH AMERICAN DATUM OF 1983 (NAD 83), NEVADA STATE PLANE EAST (2701) ZONE. SAID BEARINGS WERE DETERMINED BY STATIC GLOBAL POSITIONING SYSTEM (GPS) MEASUREMENTS PROCESSED BY THE NATIONAL GEODETIC SURVEY DIVISION OF THE NATIONAL OCEANIC AND ATMOSPHERIC ADMINISTRATION USING THE ON-LINE POSITIONING USER SERVICE (OPUS). THE REFERENCE FRAME USED WAS NAD83 (GORS96) WITH AN EPOCH OF 2002.0000. ALL DISTANCES SHOWN HEREON ARE GROUND VALUES.

BENCHMARK

CITY OF LAS VEGAS VERTICAL CONTROL POINT "6001 34SW6", BEING A RIVET & PLATE IN TOP OF CURB ON THE EAST SIDE OF MAIN BETWEEN BONNEVILLE & GARCES @ LIGHT POLE.

ELEVATION: 2027.08 (FEET)
617.8544 (METERS)

CITY OF LAS VEGAS VERTICAL CONTROL DATED 06/2002 BASED UPON THE NORTH AMERICAN VERTICAL DATUM OF 1988 (NAVD 88).

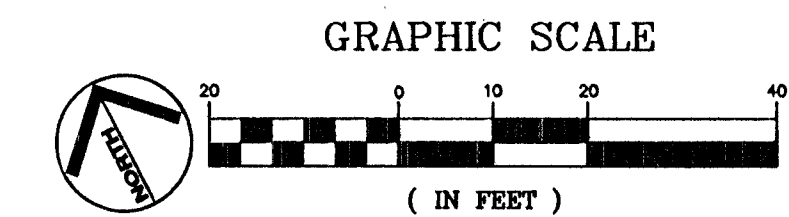

BENCHMARK

CITY OF LAS VEGAS VERTICAL CONTROL POINT "6001 34SW6", BEING A RIVET & PLATE IN TOP OF CURB ON THE EAST SIDE OF MAIN BETWEEN BONNEVILLE & GARCES @ LIGHT POLE.

ELEVATION: 2027.08 (FEET)
617.8544 (METERS)

CITY OF LAS VEGAS VERTICAL CONTROL DATED 06/2002 BASED UPON THE NORTH AMERICAN VERTICAL DATUM OF 1988 (NAVD 88).

811 SAFETY ALERT
Call Before You Overhead
know what's below Call before you dig 1-702-227-2829

UnderGround
CALL BEFORE YOU DIG
1-702-432-5300

REVISIONS

DATE

SCALE (H): 1"=20'
SCALE (V): 1"=2'

DRAWN BY: TEA
DESIGNED BY: TEA
CHECKED BY: PW/JAM

DATE: FEBRUARY 2010

Kimley-Horn and Associates, Inc.
Engineering, Planning, and Environmental Consultants
2080 E. Flamingo Road, Suite 210, Las Vegas, NV 89119
PH: (702) 734-4949 FAX: (702) 734-4949

CITY OF LAS VEGAS

PROJECT: BONNEVILLE/CLARK ONEWAY COUPLLET PHASE 1 IMPROVEMENT PLANS

SHEET: STORM DRAIN SHEET

ENGINEER'S SEAL: DANIEL MEYER, CIVIL ENGINEER, No. 18093, Exp. 12/31/11

SHEET NO: SD-02
SHEET 40 OF 91
DRAWING NO: 107V5201

BID# 09.1730.37

Apr. 25, 2010 - 5:10pm - USER: peter.meyer@tand.com
LANE\Projects\LANV_Public\Trans\052258\019_Bonneville-Clark_2008\CADD\256019se-01_03.dwg

20130461