



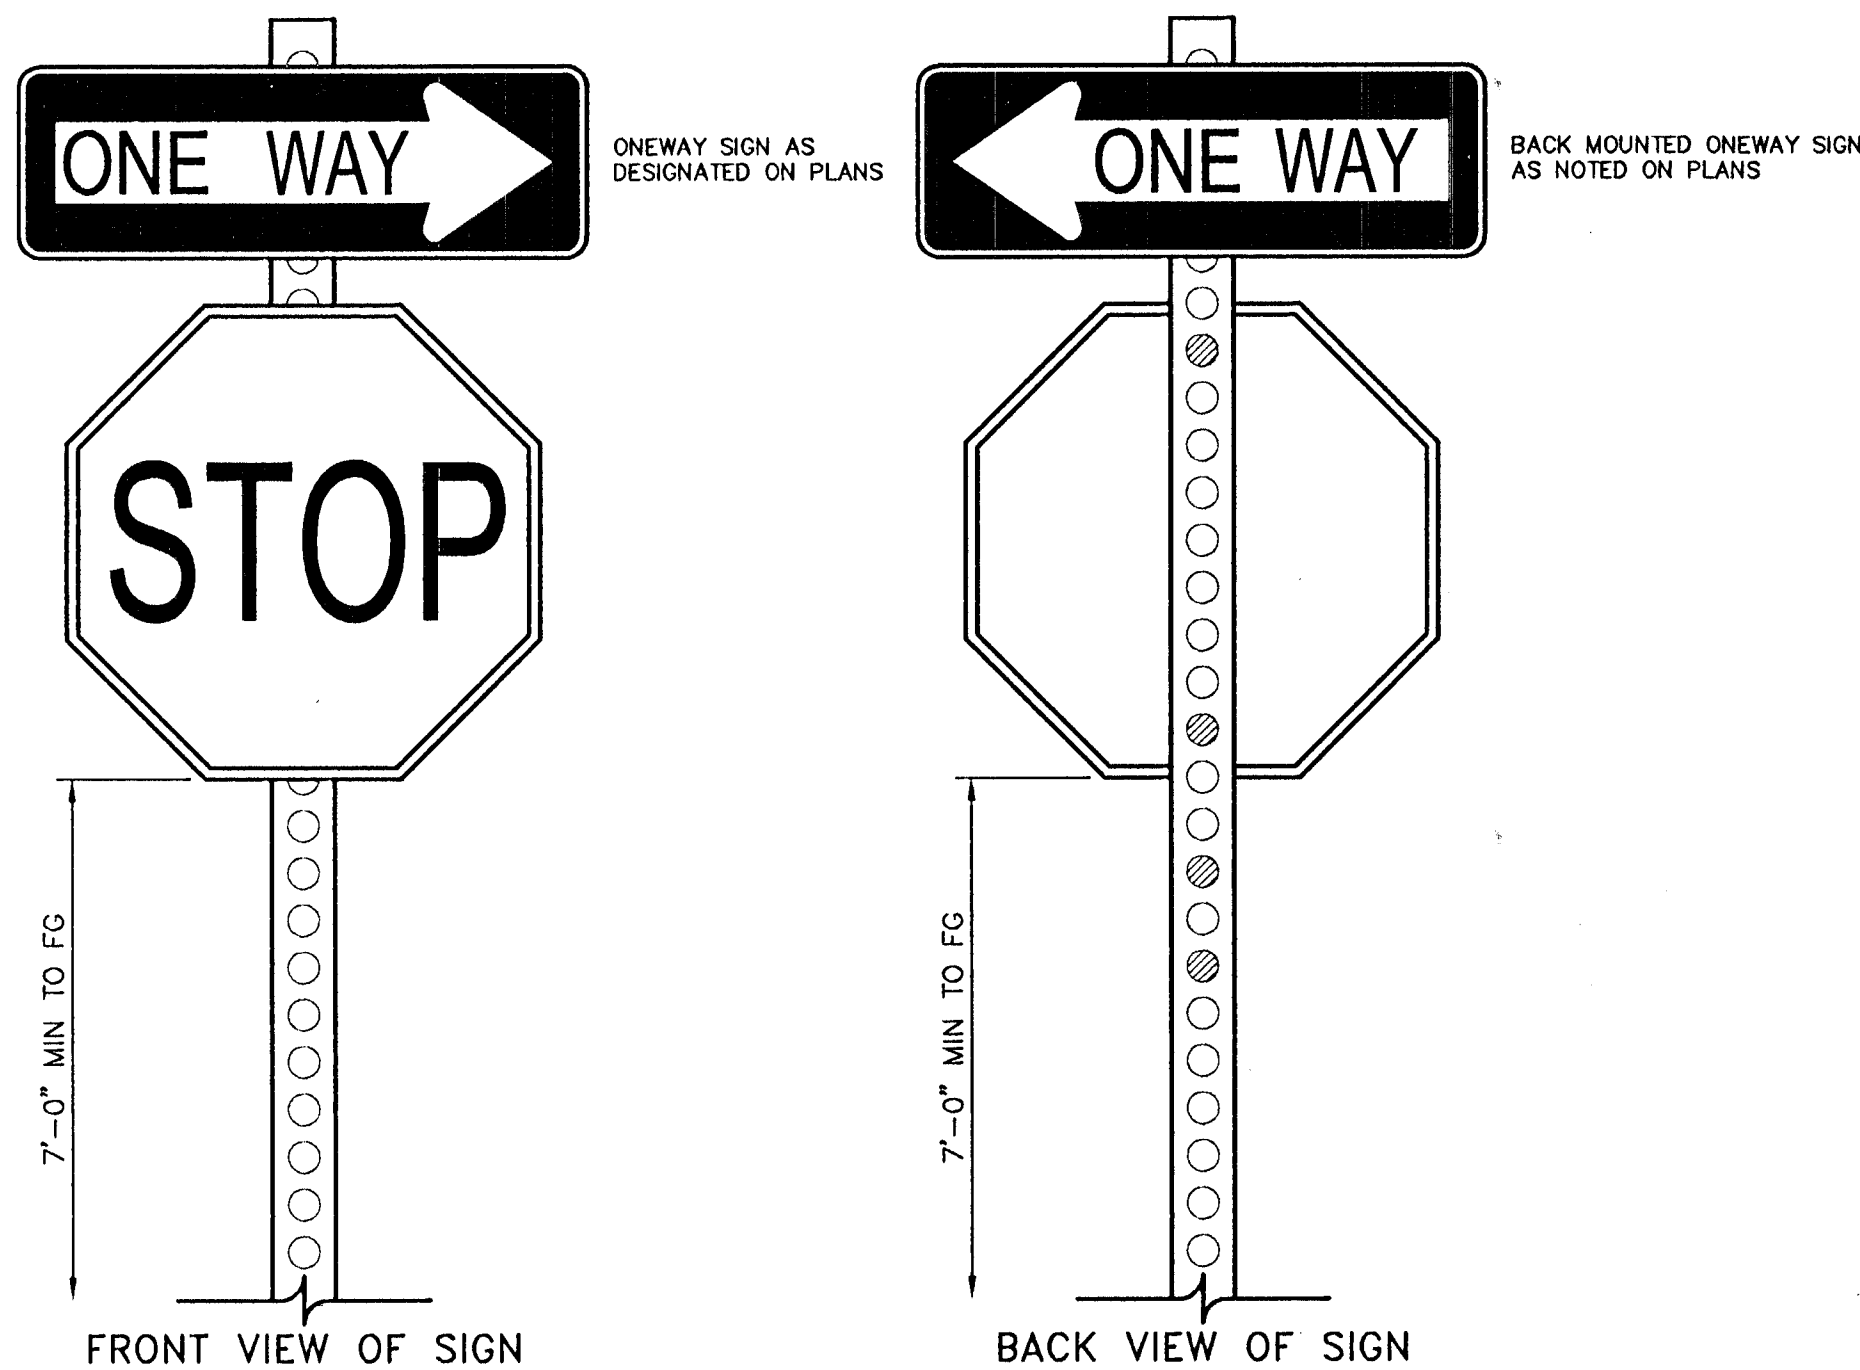

NOTE:
CONTRACTOR SHALL REFER TO CLARK COUNTY AREA STANDARD DRAWINGS FOR ALL SIGN MOUNTING DETAILS


TYPICAL DRIVEWAY/ALLEY SIGN ASSEMBLY

NTS

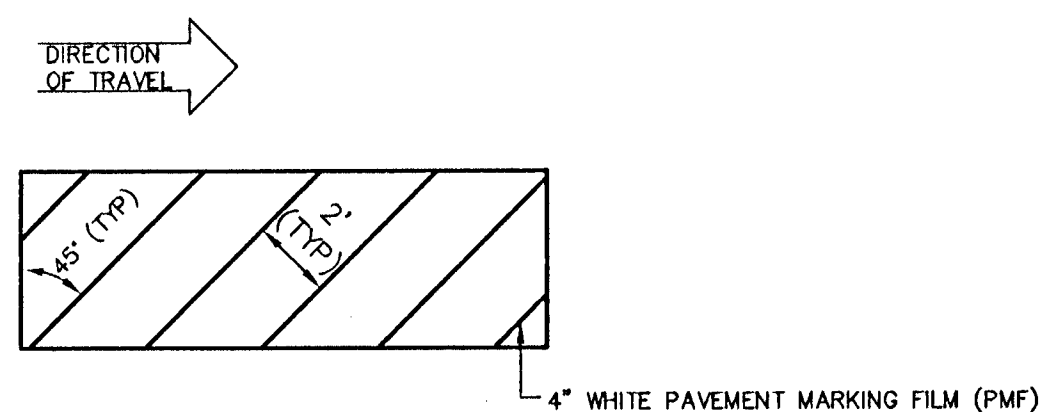

ADA ACCESSIBLE CROSSING

NTS

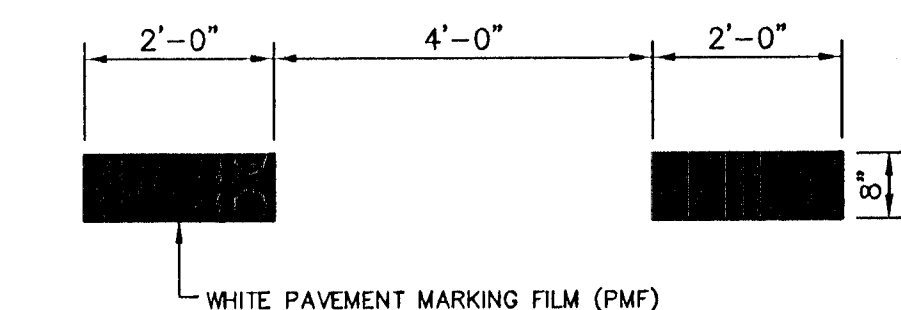

"CAT TRACKS"

NTS

SIGN SCHEDULE			
SYMBOL	DESIGNATION	SIZE	QUANTITY
	AP	24" x 12"	3
	R1-1	30"	26
	R2-1 (XX) "XX"-SPEED LIMIT	24" x 30"	8
	R3-1	24"	16
	R3-2	24"	6
	R3-5	24" x 30" 30" x 36"	3 2
	R3-7L	24"	6
	R3-7R	24"	11
	R3-17	30" x 24"	8
	R3-18	24"	1
	R4-7	24" x 30"	3
	R4-11	30" x 24"	4
	R5-1	24"	38
	R5-1A	36" x 24"	12
	R6-1L	36" x 12"	23
	R6-1R	36" x 12"	18
	RPC-68	12" x 18"	40
	W1-1LA (XX) "XX"-SPEED LIMIT	30"	2
	W1-1RA (XX) "XX"-SPEED LIMIT	30"	1
	W1-8R	18" x 24"	3
	W3-3	30"	1
	W4-4P	24" x 12"	1
	W6-3	30"	1
	W11-1	30"	2
	W11-2	30"	2
	W12-1	30"	1
	W16-1	24" x 12"	2
	W16-7P	24" x 12"	3
	W16-7PR	24" x 12"	1
	W16-9P	24" x 12"	2
TOTAL SIGNS			
RC-17	30" x 30"	2	

PAVEMENT LEGEND SCHEDULE				
SYMBOL	DESIGNATION	AREA (SF)	QUANTITY	TOTAL AREA (SF)
	TURN ARROW (SOLID)**	15.5	35	542.50
	"ONLY"	21.0	34	714.0
	"BUS"	18.0	3	54.0
	THRU-TURN ARROW (SOLID)	12.5	26	325.0
	THRU TRAFFIC ARROW (SOLID)**	27.0	21	567
	BICYCLE (SOLID)	5.5	18	99.0
	STRAIGHT ARROW (SOLID)	3.0	18	54.0
TOTAL LEGEND SQUARE FOOTAGE:				2,355.5

NOTES:
* - ALL PAVEMENT MARKINGS SHALL BE
** - SYMBOL MAY BE MIRRORED

NOTED USING PAVEMENT MARKING FILM (PMF)

TAND, INC.
AS-BUILT

811
SAFETY ALERT
Call Before You Dig
Know what's below
Call before you dig

REVISIONS

DATE

6TH STREET OVERHEAD SIGNAGE

DATE: FEBRUARY 2010

CHECKED BY: CC/PM

DESIGNED BY: TEA

SCALE (H): N/A

SCALE (V): N/A

DRAWN BY: TEA

Kimley-Horn and Associates, Inc.

Engineering, Planning, and Environmental Consultants

2080 E. Flamingo Road, Suite 210, Las Vegas, NV 89119

PH: (702) 735-4949

FAX: (702) 735-4949

DEPARTMENT OF PUBLIC WORKS

PROJECT: BONNEVILLE/CLARK ONEWAY COUPLET PHASE 1 IMPROVEMENT PLANS

SHEET: 107V5201

DATE: 12/31/11

Exp: 12/31/11

CIVIL

107V5201