
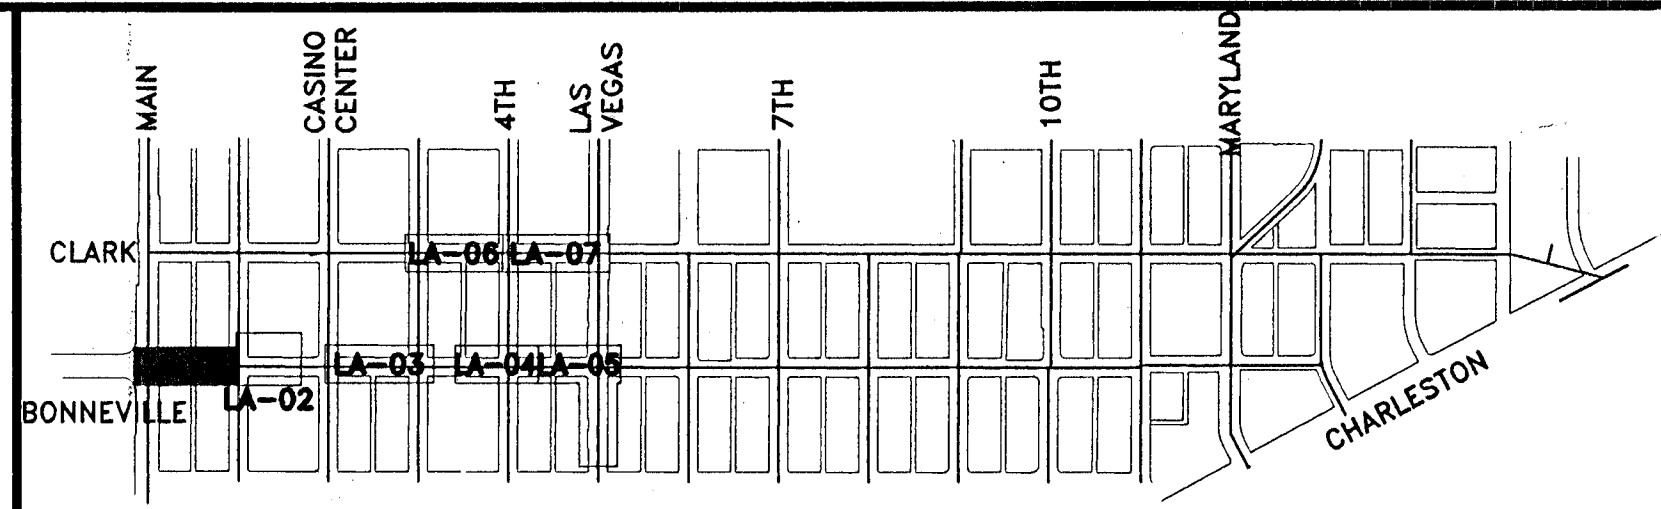


Jun 15, 2010 - 7:24am - USER: david.consebury  
 K:\PHX\_Roadway\092-Las Vegas\092256015-Bonneville\_Clarck\CADD\Bonneville-Clark\LA01-07\_256015c-01\_07.dwg

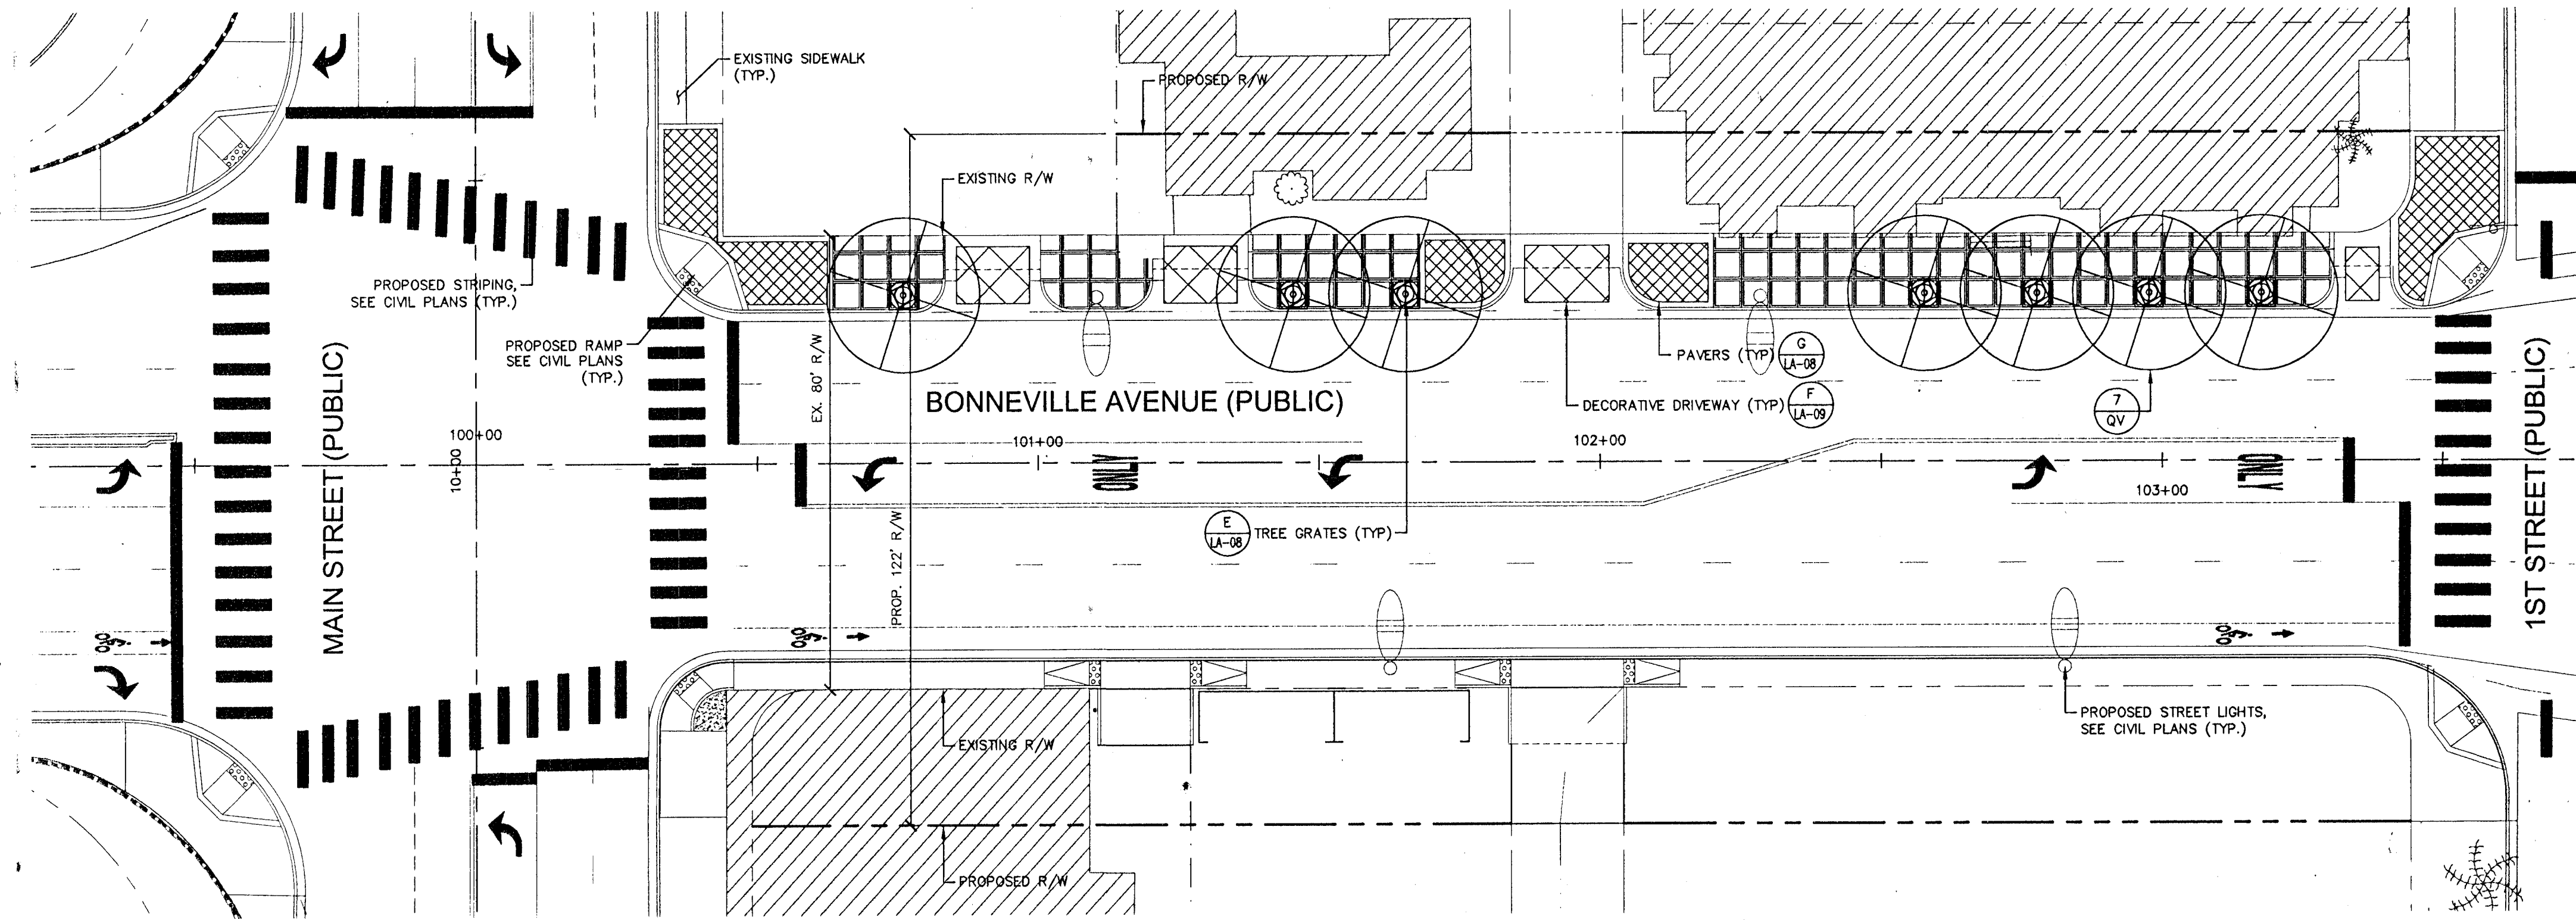

KEY MAP  
RTS

**PLANT SCHEDULE**

TREES, EXISTING TREES, SHRUBS & GROUNDCOVERS				
SYMBOL	BOTANICAL NAME	COMMON NAME	QTY.	SIZE
	QV - <i>Quercus virginiana</i>	Southern Live Oak	49	36" BOX
	PD - <i>Phoenix dactylifera</i>	Phoenix Date Palm	17	36" ROOT BALL 25' HEIGHT
	XT - EXISTING TREE			
	XP - EXISTING PALM TREE			
	CN - <i>Cassia nemophila</i>	Desert Cassia	137	5 GAL
	CD - <i>Cotoneaster dammeri</i> 'Coral Beauty'	Coral Beauty Cotoneaster	122	5 GAL
	AR - <i>Acacia redolens</i> 'Desert Carpet'	Desert Carpet	52	5 GAL
	CO - <i>Convolvulus cneorum</i>	Bush Morning Glory	35	5 GAL
	LS - <i>Lantana camara</i> 'New Gold'	New Gold Lantana	47	5 GAL

**NOTES**

- CONTRACTOR IS RESPONSIBLE TO VERIFY ALL PLANT QUANTITIES. THE PLANT SCHEDULE IS INTENDED AS A REFERENCE ONLY.
  - LANDSCAPE ARCHITECT IS TO APPROVE ALL PLANT MATERIAL PRIOR TO INSTALLATION WITH A 48 HOUR ADVANCED NOTICE.
  - PLANT MATERIAL IS TO HAVE IDENTIFICATION TAGS ON 10% OF THE TOTAL QUANTITY OF EACH SPECIES, SHOWING GENUS, SPECIES, VARIETY, ETC.
  - CONTRACTOR TO PROVIDE MATCHING SIZES AND FORMS OF LIKE SHRUB SPECIES AS SHOWN ON DRAWINGS.
  - DECOMPOSED GRANITE, 1/2" MINUS, COLOR: "PINK CORAL", 2" DEPTH TYPICAL IN ALL PLANTING BEDS. DECOMPOSED GRANITE SHALL CONTAIN 60% AGGREGATE AND 40% FINES. CONTRACTOR TO RECEIVE VERIFICATION FROM ROCK SUPPLIER AND PRESENT VERIFICATION TO THE OWNER PRIOR TO ANY CONSTRUCTION.
- WHOLESALE DEALER:  
 KALAMAZOO MATERIALS, INC.  
 2251 SOUTH FORT APACHE ROAD, SUITE 2079  
 LAS VEGAS, NV 89117  
 TELEPHONE: (702) 298-9133
- LANDSCAPE BOULDERS ARE TO BE GRANITE AND ROUND IN SHAPE. COLOR TO MATCH OR COMPLEMENT ROCK GROUND COVER. CONTRACTOR TO SET 1/4 OF ROCK DIAMETER INTO FINISH GRADE. BOULDERS TO BE 2' TO 4' IN DIAMETER, SIZED ACCORDING TO THE FOLLOWING PERCENTAGES:
 


	20% 4' LARGEST DIAMETER*
	40% 3' LARGEST DIAMETER
	40% 2' LARGEST DIAMETER

\* NOT TO BE USED IN AREAS LESS THAN 7'

TOTAL QUANTITY OF BOULDERS: 68
  - LANDSCAPE UPLIGHTING-  
 ▲ INSTALL TRAILBLAZER LANDSCAPE LIGHT, PRODUCT CODE LT-24-12W-45D-RD-VC-TW-LT6912GRS, OR APPROVED EQUAL.

Note: Tree Grates to be  
 not installed on  
 any new planting

TAND, INC.  
 AS-BUILT  
 DATE: \_\_\_\_\_  
 DANIEL MEYER

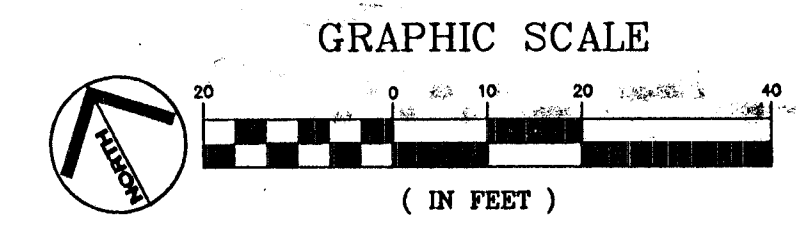

REVISIONS SHEET REPLACEMENT	DATE: FEBRUARY 2010 CHECKED BY: ACP	SCALE (V): N/A DESIGNED BY: DJC DRAWN BY: FR	SCALE (H): 1"=20' DATE: FEBRUARY 2010 CHECKED BY: ACP	PROJECT: BONNEVILLE/CLARK ONEWAY COUPLET PHASE 1 IMPROVEMENT PLANS	SHEET: LANDSCAPE SHEET
Kimley-Horn and Associates, Inc. Engineering, Planning, and Environmental Consultants 2080 E. Flamingo Road, Suite 210, Las Vegas, NV 89119 PH: (702) 734-5666 FAX: (702) 738-4949			DEPARTMENT OF PUBLIC WORKS LANDSCAPE SHEET		
MATCHLINE ~ STA 103+75 SEE SHEET LA-02			REGISTERED LANDSCAPE ARCHITECT STATE OF NEVADA License No. 62011 Expire 6-30-11		
811 know what's below Call before you dig! 702-227-2929			SAFETY ALERT Call before you Overhead 1-702-432-5300		
UNDERGROUND Call before you dig! 702-227-2929			SHEET NO. LA-01 SHEET 73 OF 91 DRAWING NO. 107V5201		

BID# 09.1730.37 REV 3

2013.04.04