

KEY MAP  
NTS

TAND, INC.  
AS-BUILT  
DATE 11-13-11  
DANIEL MEYER


PLANT SCHEDULE

| TREES, EXISTING TREES, SHRUBS & GROUNDCOVERS |                                    |                          |      |                             |
|--|------------------------------------|--------------------------|------|-----------------------------|
| SYMBOL                                       | BOTANICAL NAME                     | COMMON NAME              | QTY. | SIZE                        |
| QV   | Quercus virginiana                 | Southern Live Oak        | 49   | 36" BOX                     |
| PD   | Phoenix dactylifera                | Phoenix Date Palm        | 17   | 36" ROOT BALL<br>25' HEIGHT |
| XT   | EXISTING TREE                      |                          |      |                             |
| XP   | EXISTING PALM TREE                 |                          |      |                             |
| CN   | Cassia nemophila                   | Desert Cassia            | 137  | 5 GAL                       |
| CD   | Coloneaster dammeri 'Coral Beauty' | Coral Beauty Cotoneaster | 122  | 5 GAL                       |
| AR   | Acaia redolens 'Desert Carpet'     | Desert Carpet            | 52   | 5 GAL                       |
| CO   | Convolvulus cneorum                | Bush Morning Glory       | 35   | 5 GAL                       |
| LS   | Lantana camara 'New Gold'          | New Gold Lantana         | 47   | 5 GAL                       |

NOTES

- CONTRACTOR IS RESPONSIBLE TO VERIFY ALL PLANT QUANTITIES. THE PLANT SCHEDULE IS INTENDED AS A REFERENCE ONLY.
- LANDSCAPE ARCHITECT IS TO APPROVE ALL PLANT MATERIAL PRIOR TO INSTALLATION WITH A 48 HOUR ADVANCED NOTICE.
- PLANT MATERIAL IS TO HAVE IDENTIFICATION TAGS ON 10% OF THE TOTAL QUANTITY OF EACH SPECIES, SHOWING GENUS, SPECIES, VARIETY, ETC.
- CONTRACTOR TO PROVIDE MATCHING SIZES AND FORMS OF LIKE SHRUB SPECIES AS SHOWN ON DRAWINGS.
- DECOMPOSED GRANITE, 1/2" MINUS, COLOR: "PINK CORAL", 2" DEPTH TYPICAL IN ALL PLANTING BEDS. DECOMPOSED GRANITE SHALL CONTAIN 60% AGGREGATE AND 40% FINES. CONTRACTOR TO RECEIVE VERIFICATION FROM ROCK SUPPLIER AND PRESENT VERIFICATION TO THE OWNER PRIOR TO ANY CONSTRUCTION.
- LANDSCAPE BOULDERS ARE TO BE GRANITE AND ROUND IN SHAPE. COLOR TO MATCH OR COMPLIMENT ROCK GROUND COVER. CONTRACTOR TO SET 1/4 OF ROCK DIAMETER INTO FINISH GRADE. BOULDERS TO BE 2' TO 4' IN DIAMETER, SIZE ACCORDING TO THE FOLLOWING PERCENTAGES:
  - 20% 4' LARGEST DIAMETER\*
  - 40% 3' LARGEST DIAMETER
  - 40% 2' LARGEST DIAMETER
 TOTAL QUANTITY OF BOULDERS: 68  
 \* NOT TO BE USED IN AREAS LESS THAN 7'
- LANDSCAPE LIGHTING--  
 ▲ INSTALL TRAILBLAZER LANDSCAPE LIGHT, PRODUCT CODE LT-24-12W-450-RD-VC-TW-LT6912GRS, OR APPROVED EQUAL

WHOLESALE DEALER:  
KALAMAZOO MATERIALS, INC.  
2251 SOUTH FORT APACHE ROAD, SUITE 2079  
LAS VEGAS, NV 89117  
TELEPHONE: (702) 296-9133

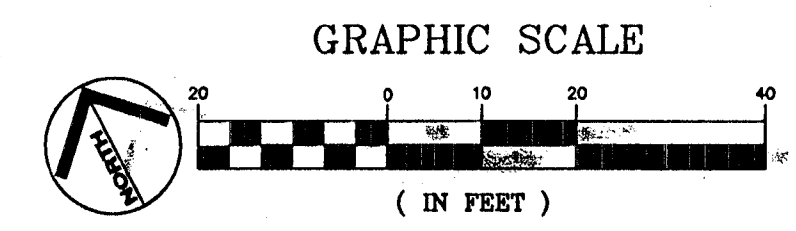

REVISIONS  
SHEET REPLACEMENT

DATE: FEBRUARY 2010  
CHECKED BY: ACP

SCALE (V): N/A  
DESIGNED BY: D/C

SCALE (H): 1"=20'  
DRAWN BY: FR

Kimley-Horn and Associates, Inc.  
Engineering, Planning, and Environmental Consultants  
2080 E. Flamingo Road, Suite 210, Las Vegas, NV 89119  
PH (702) 735-4949  
FAX (702) 735-5666

DEPARTMENT OF PUBLIC WORKS  
PROJECT: BONNEVILLE/CLARK ONEWAY COUPLER PHASE 1 IMPROVEMENT PLANS  
SHEET: LANDSCAPE SHEET

REGISTERED LANDSCAPE ARCHITECT  
STATE OF NEVADA  
791  
6-5-11

811  
know\_what's\_below  
Call before you dig! 702-227-2829

SAFETY ALERT  
Call before you Overhead  
1-702-432-5300  
FURNISH AN ADEQUATE NOTICE TO THE UTILITY OWNERS

SHEET NO. LA-04  
SHEET 78 OF 91  
DRAWING NO. 107V5201

BID# 09.1730.37 REV 3

Jun 15, 2010 - 7:44am - USER: david.casselbury  
K:\P\X\_Roadway\092-Las Vegas\092256019-Bonneville-Clark\CADD\Bonneville-Clark\_LA01-07\256019a-01.dwg

2015097