

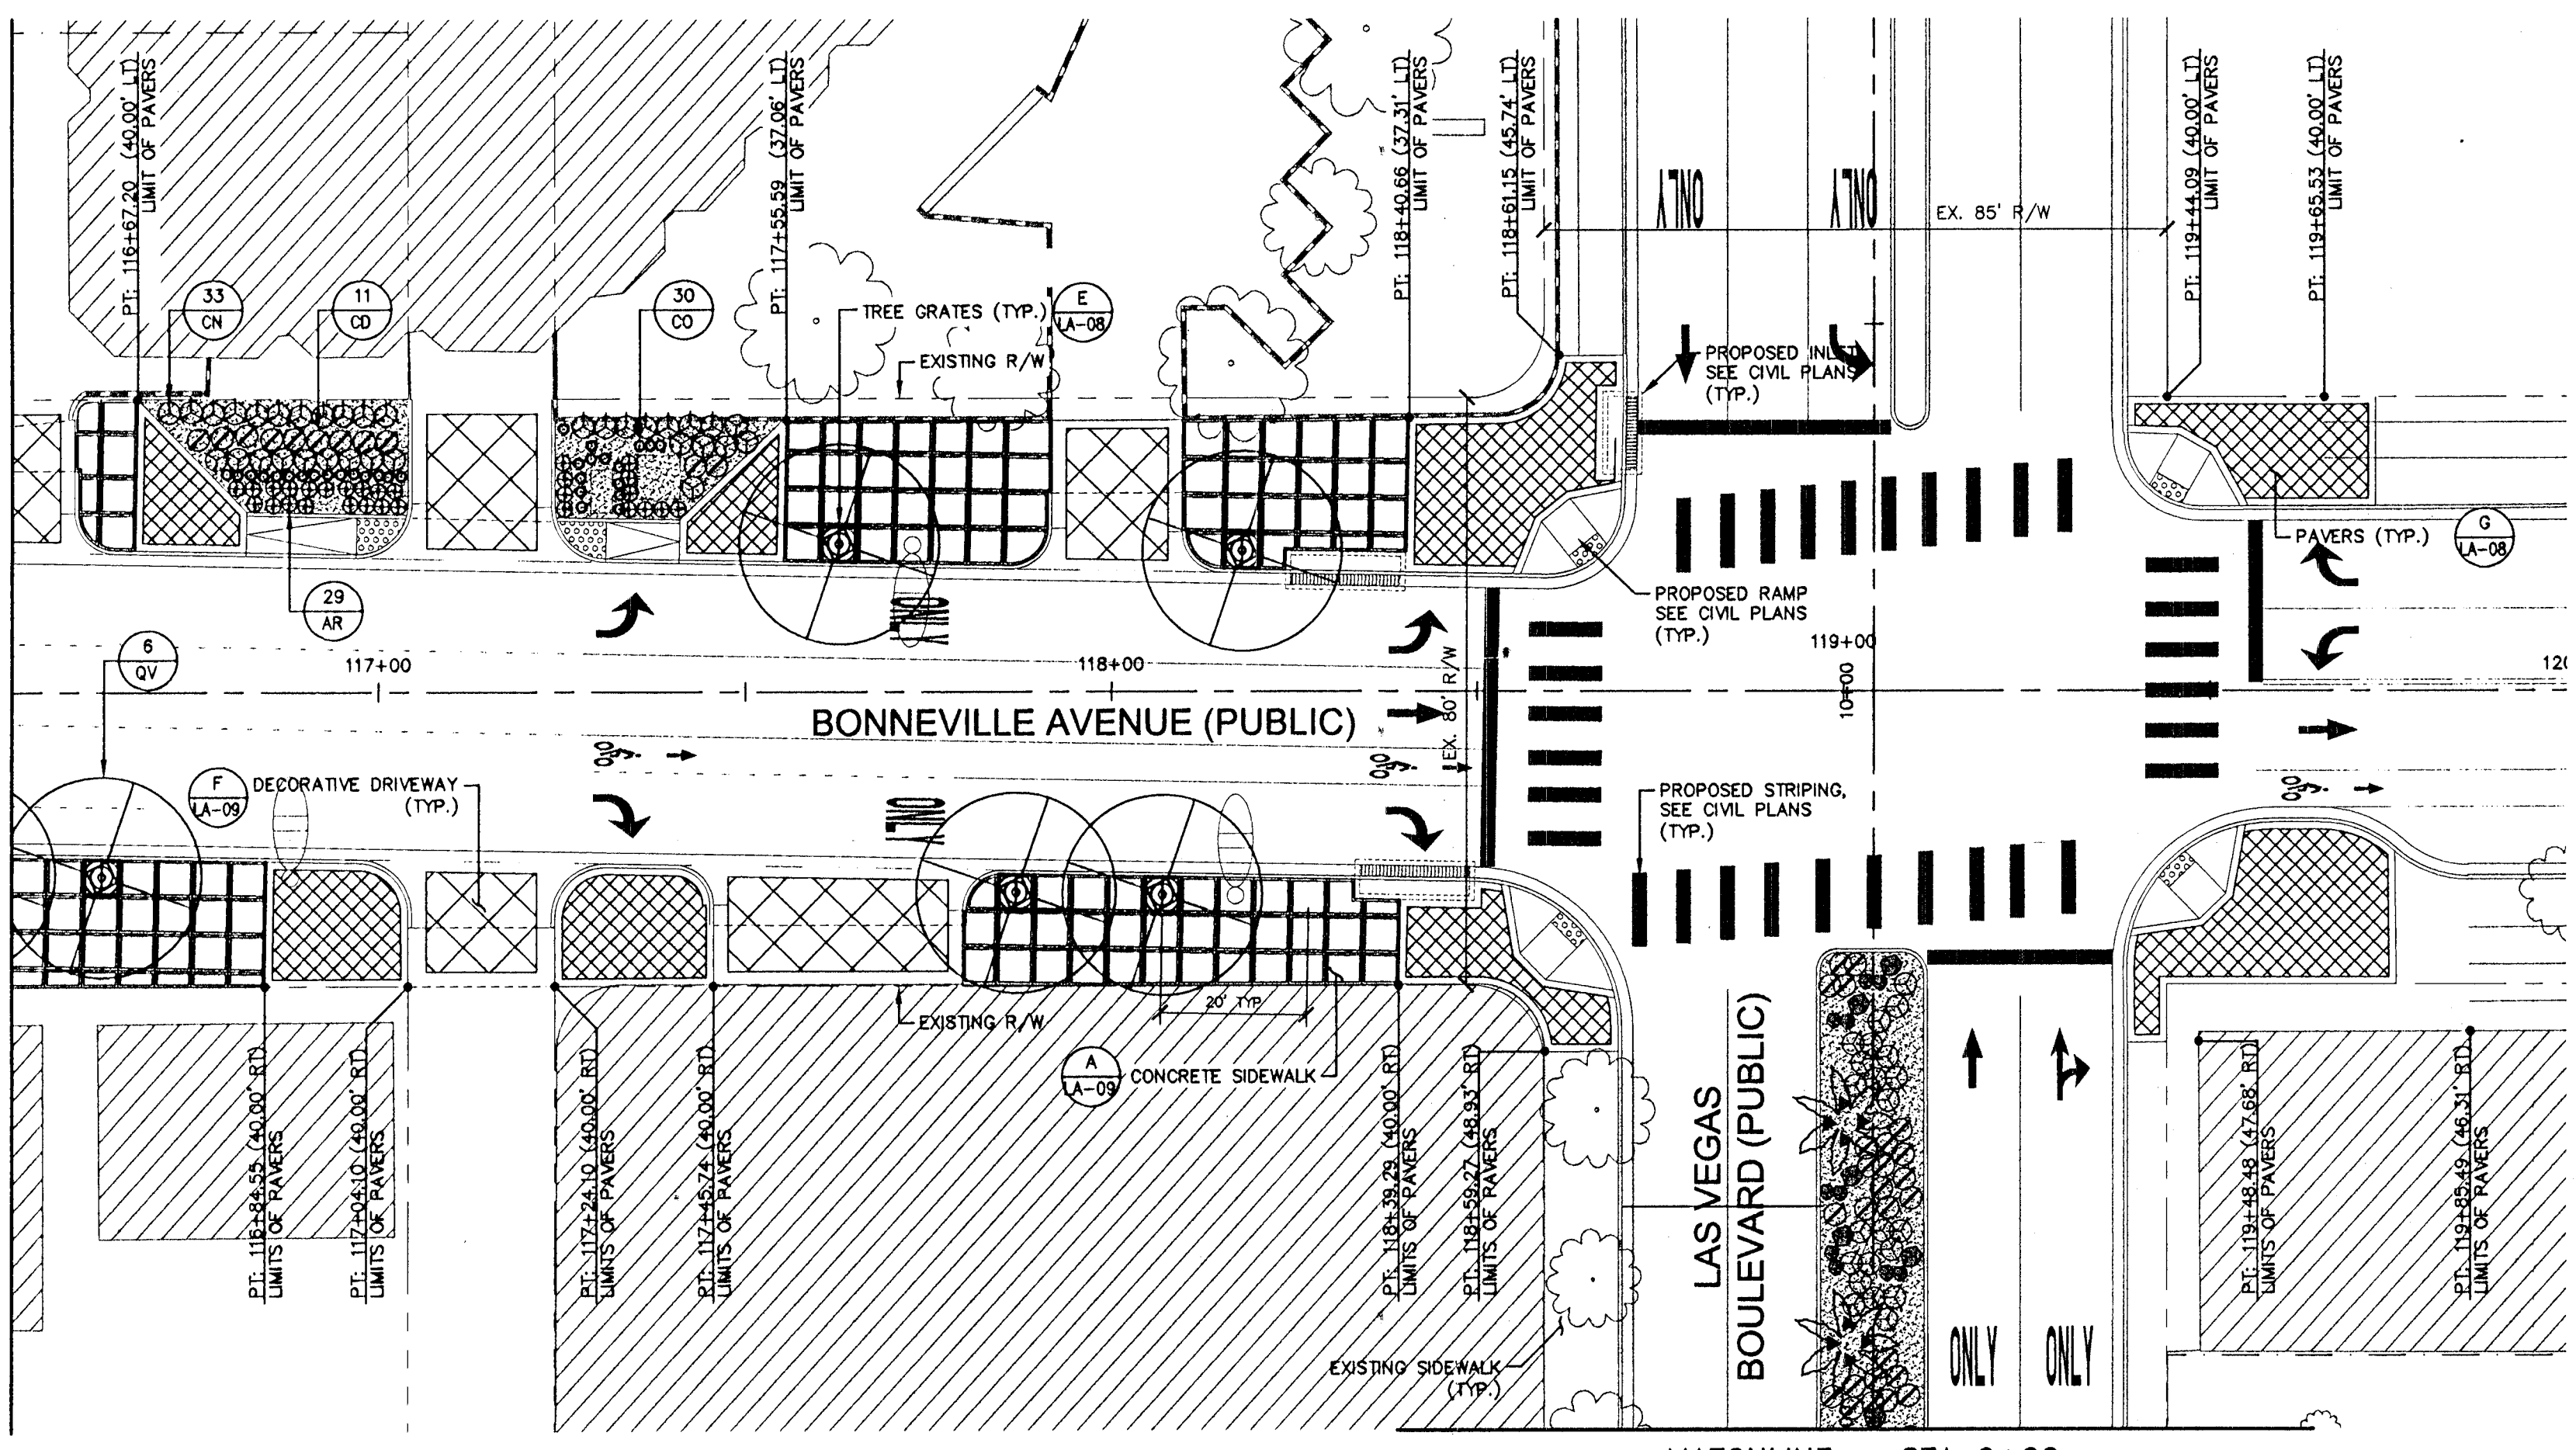


Jun 15, 2010 - 8:07am - USER: dmed, cseabury
 K:\PHX_Roadway\092-Las Vegas\09256019-Bonneville-Clark\CADD\Bonneville-Clark\LA-07.dwg

MATCHLINE ~ STA 116+50
 SEE SHEET LA-04

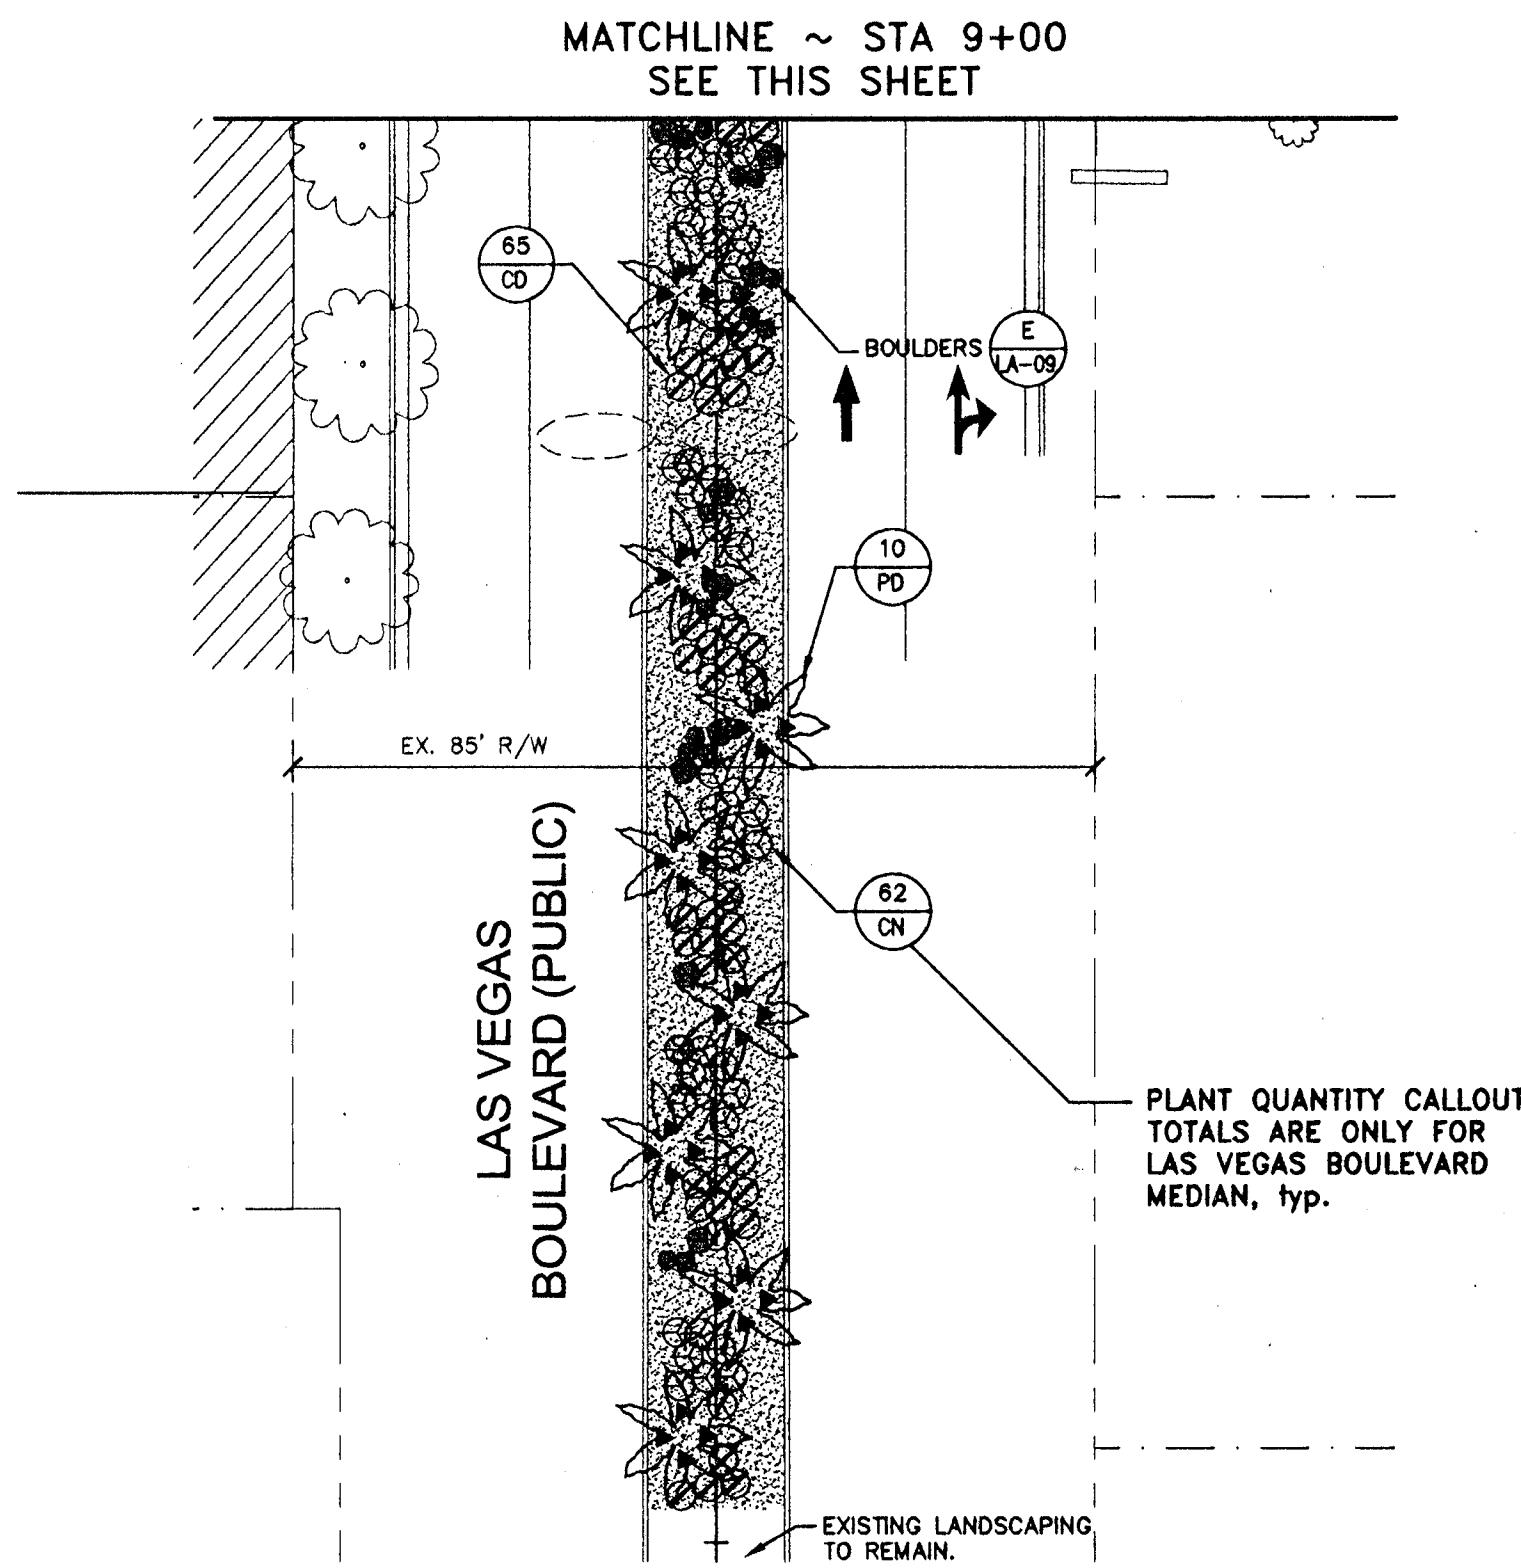

MATCHLINE ~ STA 9+00
 SEE THIS SHEET

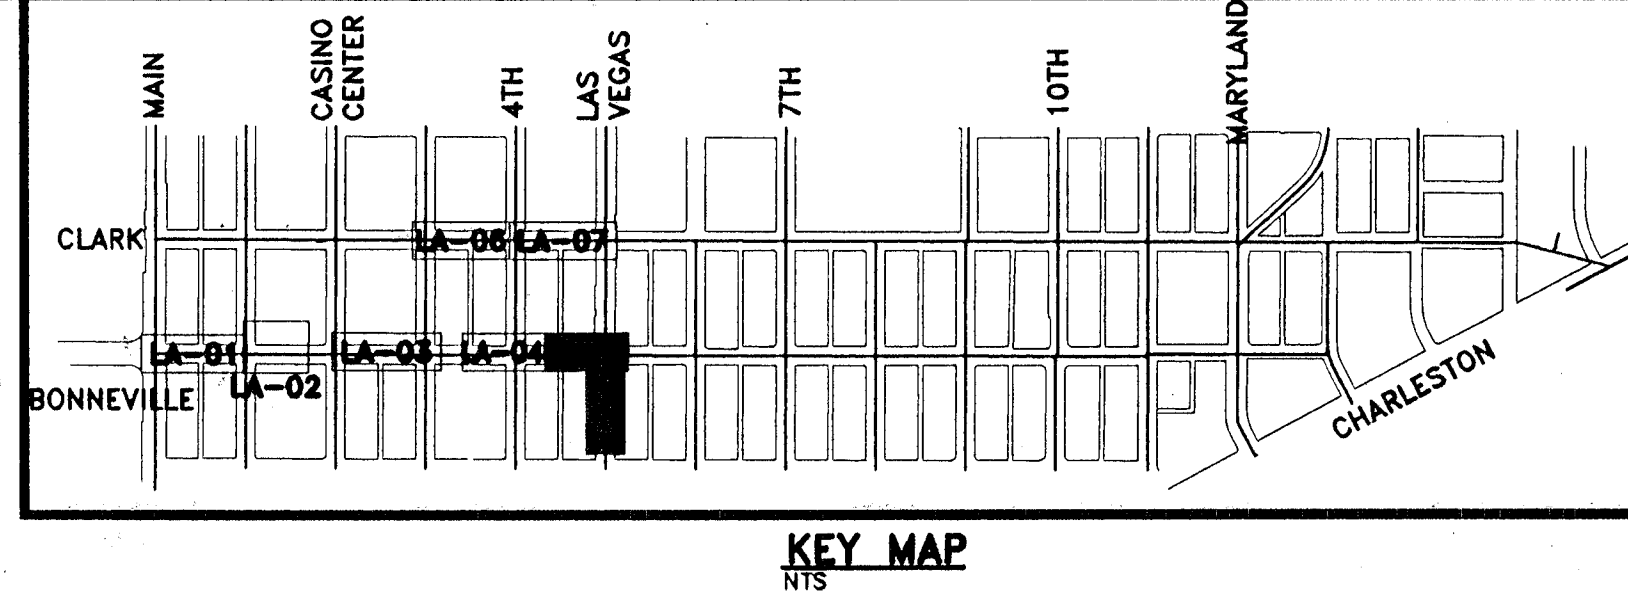

TAND, INC.
AS-BUILT
 DATE: _____
 DANIEL MEYER

PLANT SCHEDULE

TREES, EXISTING TREES, SHRUBS & GROUNDCOVERS				
SYMBOL	BOTANICAL NAME	COMMON NAME	QTY.	SIZE
QV	Quercus virginiana	Southern Live Oak	49	36" BOX
PD	Phoenix dactylifera	Phoenix Date Palm	17	36" ROOT BALL 25' HEIGHT
XT	EXISTING TREE			
XP	EXISTING PALM TREE			
CN	Cassia nemophila	Desert Cassia	137	5 GAL
CD	Cotoneaster dammeri 'Coral Beauty'	Coral Beauty Cotoneaster	122	5 GAL
AR	Acacia redolens 'Desert Carpet'	Desert Carpet	52	5 GAL
CO	Convolvulus cneorum	Bush Morning Glory	35	5 GAL
LS	Lantana camara 'New Gold'	New Gold Lantana	47	5 GAL


NOTES

- CONTRACTOR IS RESPONSIBLE TO VERIFY ALL PLANT QUANTITIES. THE PLANT SCHEDULE IS INTENDED AS A REFERENCE ONLY.
 - LANDSCAPE ARCHITECT IS TO APPROVE ALL PLANT MATERIAL PRIOR TO INSTALLATION WITH A 48 HOUR ADVANCED NOTICE.
 - PLANT MATERIAL IS TO HAVE IDENTIFICATION TAGS ON 10% OF THE TOTAL QUANTITY OF EACH SPECIES, SHOWING GENUS, SPECIES, VARIETY, ETC.
 - CONTRACTOR TO PROVIDE MATCHING SIZES AND FORMS OF LIKE SHRUB SPECIES AS SHOWN ON DRAWINGS.
 - DECOMPOSED GRANITE, 1/2" MINUS. COLOR: "PINK CORAL", 2" DEPTH TYPICAL IN ALL PLANTING BEDS. DECOMPOSED GRANITE SHALL CONTAIN 80% AGGREGATE AND 40% FINES. CONTRACTOR TO RECEIVE VERIFICATION FROM ROCK SUPPLIER AND PRESENT VERIFICATION TO THE OWNER PRIOR TO ANY CONSTRUCTION.
- WHOLESALE DEALER:
 KALAMAZOO MATERIALS, INC.
 2251 SOUTH FORT APACHE ROAD, SUITE 2079
 LAS VEGAS, NV 89117
 TELEPHONE: (702) 298-9133
- LANDSCAPE BOULDERS ARE TO BE GRANITE AND ROUND IN SHAPE. COLOR TO MATCH OR COMPLEMENT ROCK GROUND COVER. CONTRACTOR TO SET 1/4 OF ROCK DIAMETER INTO FINISH GRADE. BOULDERS TO BE 2' TO 4' IN DIAMETER, SIZED ACCORDING TO THE FOLLOWING PERCENTAGES:

20%	4' LARGEST DIAMETER*
40%	3' LARGEST DIAMETER
40%	2' LARGEST DIAMETER

* NOT TO BE USED IN AREAS LESS THAN 7'

TOTAL QUANTITY OF BOULDERS: 68
 - LANDSCAPE UP LIGHTING—
 ▲ INSTALL TRAILBLAZER LANDSCAPE LIGHT, PRODUCT CODE LT-24-12W-4SD-RD-VC-TW-LT6912GRS, OR APPROVED EQUAL

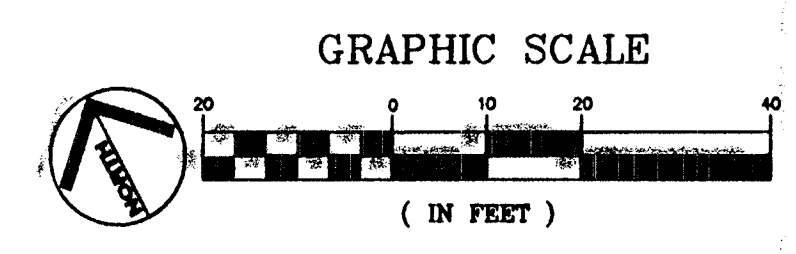

 Kimley-Horn and Associates, Inc. <small>Engineering, Planning, and Environmental Consultants 2080 E. Flamingo Road, Suite 210, Las Vegas, NV 89119 PH: (702) 734-5666 FAX: (702) 734-4949</small>	 DANIEL MEYER REGISTERED LANDSCAPE ARCHITECT STATE OF NEVADA No. 791 EXPIRES: 6/30/11	DATE: FEBRUARY 2010 CHECKED BY: ACP DESIGNED BY: DUC DRAWN BY: FR	SCALE (V): N/A SCALE (H): 1" = 20' DATE: 4/15/10 SHEET REPLACEMENT	DEPARTMENT OF PUBLIC WORKS BONNEVILLE/CLARK ONEWAY COUPLER PHASE 1 IMPROVEMENT PLANS LANDSCAPE SHEET SHEET: 1075201
--	---	--	---	---

811
 know what's below
 Call before you dig! 702-227-2929

SAFETY ALERT
 Call Before You Overhead
 UnderGround
 1-702-432-5300
 HEAVY AND MEDIUM TENSION CABLES

20130403

BID# 09.1730.37 REV 3