
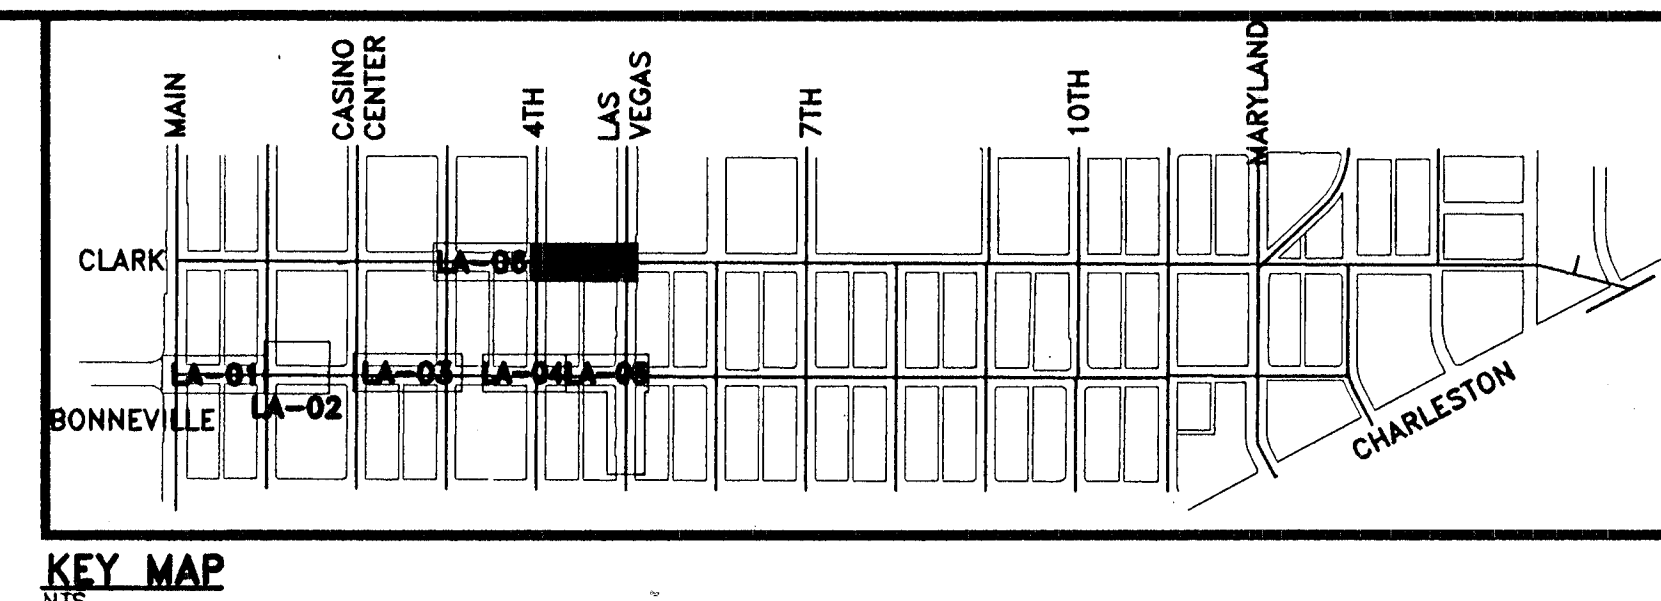


Jun 15, 2010 - 7:51am - USER: davis.cassebury
 K:\PIX_Roadway\092-Las Vegas\09225019-Bonneville\Clark\CADD\Bonneville-Clark_LA01-07_2560196-01_07.dwg

MATCHLINE ~ STA 215+25
 SEE SHEET LA-07

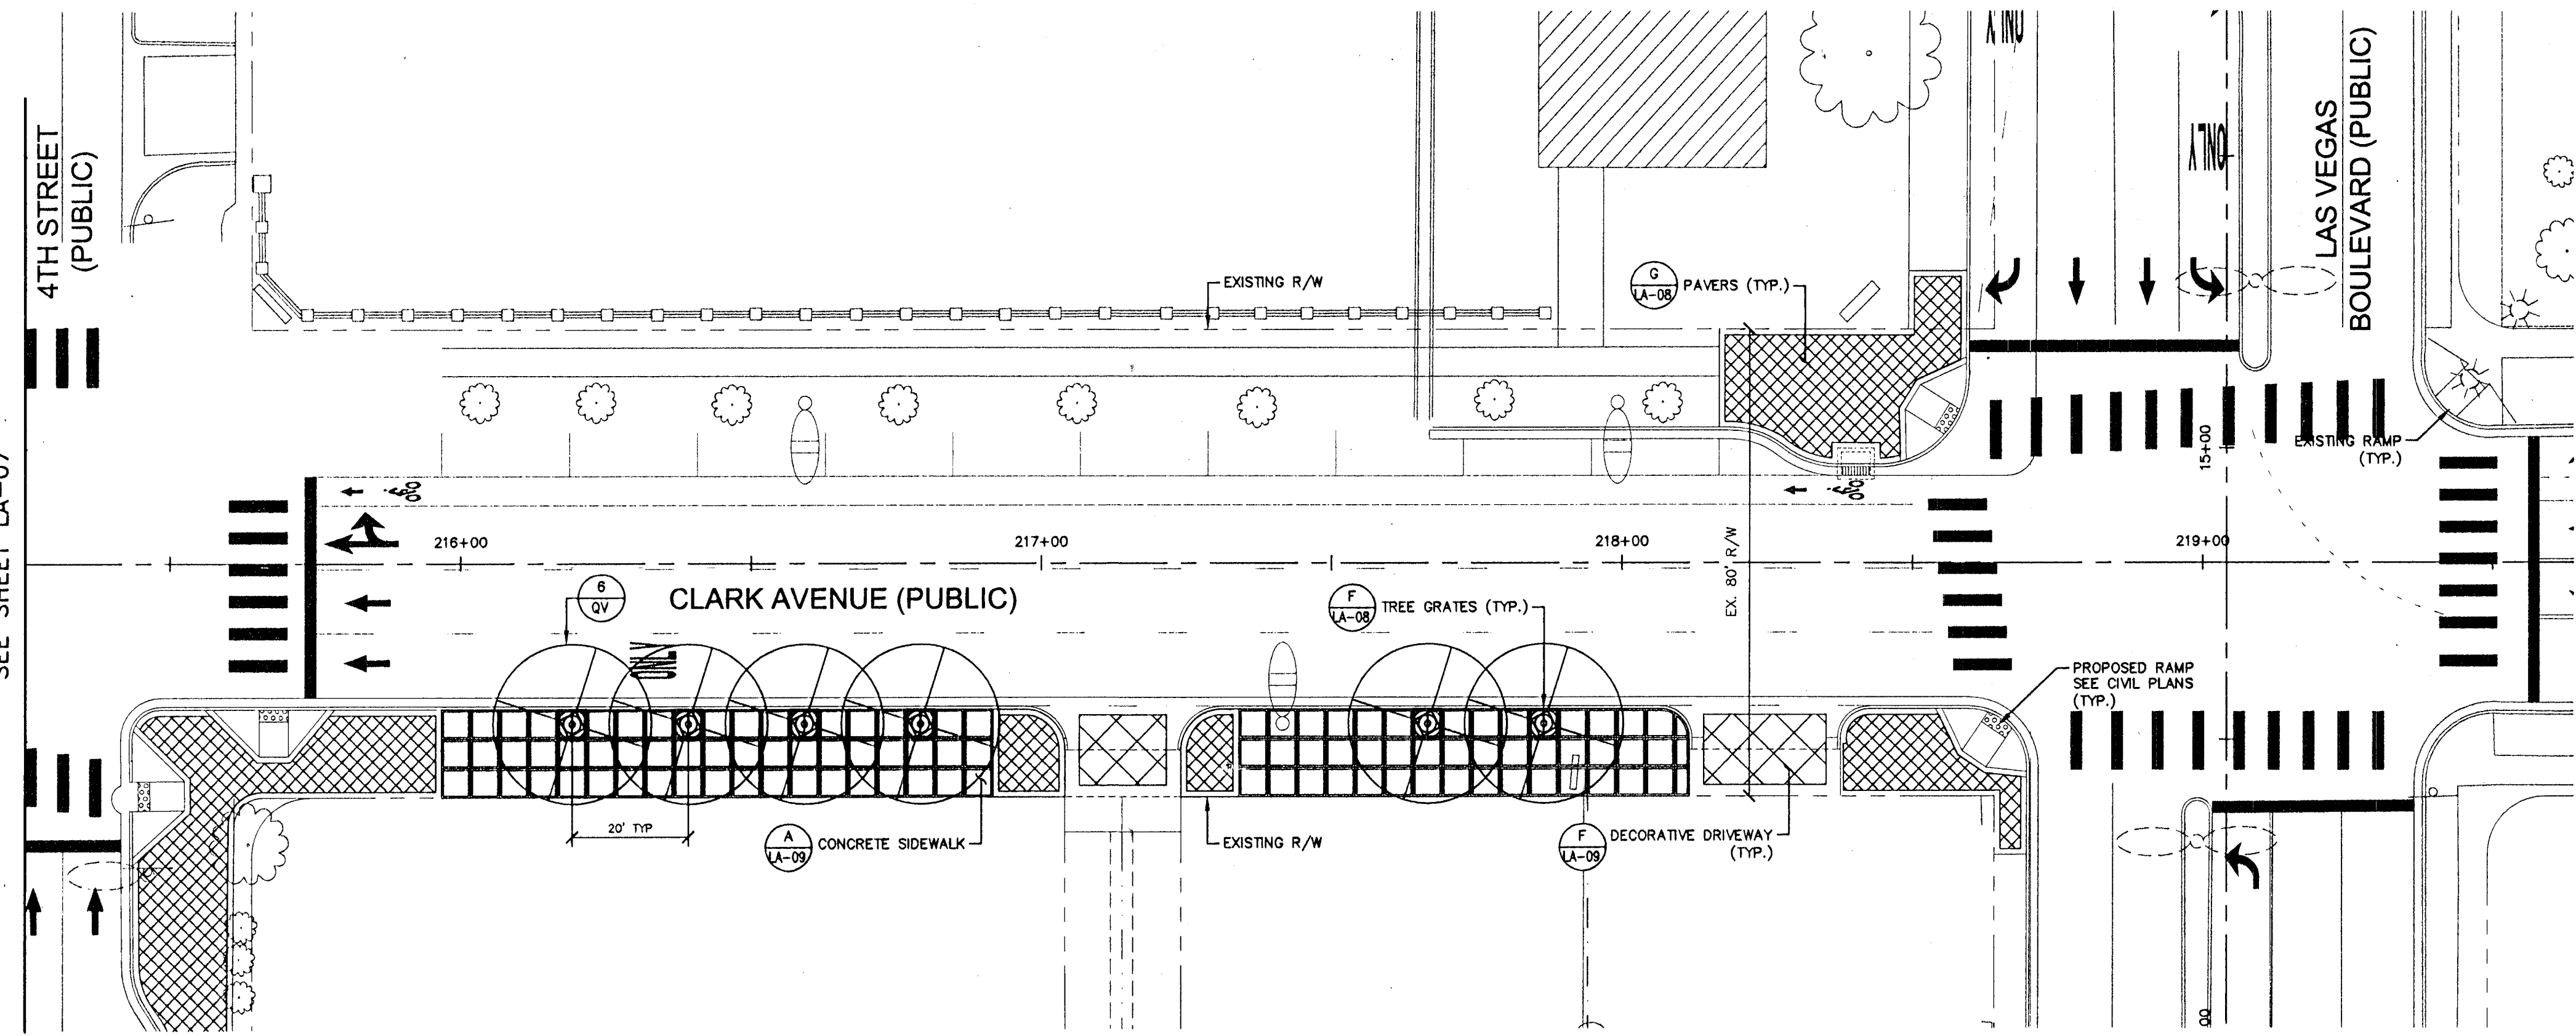

PLANT SCHEDULE

| TREES, EXISTING TREES, SHRUBS & GROUNDCOVERS | | | | |
|--|------------------------------------|--------------------------|------|-----------------------------|
| SYMBOL | BOTANICAL NAME | COMMON NAME | QTY. | SIZE |
| QV | Quercus virginiana | Southern Live Oak | 49 | 36" BOX |
| PD | Phoenix dactylifera | Phoenix Date Palm | 17 | 36" ROOT BALL 25' HEIGHT |
| XT | EXISTING TREE | | | |
| XP | EXISTING PALM TREE | | | |
| CN | Cassia nemophila | Desert Cassia | 137 | 5 GAL |
| CD | Cotoneaster dammeri 'Coral Beauty' | Coral Beauty Cotoneaster | 122 | 5 GAL |
| AR | Acacia redolens 'Desert Carpet' | Desert Carpet | 52 | 5 GAL |
| CG | Convolvulus cneorum | Bush Morning Glory | 35 | 5 GAL |
| LS | Lantana camara 'New Gold' | New Gold Lantana | 47 | 5 GAL |


NOTES

- CONTRACTOR IS RESPONSIBLE TO VERIFY ALL PLANT QUANTITIES. THE PLANT SCHEDULE IS INTENDED AS A REFERENCE ONLY.
- LANDSCAPE ARCHITECT IS TO APPROVE ALL PLANT MATERIAL PRIOR TO INSTALLATION WITH A 48 HOUR ADVANCED NOTICE.
- PLANT MATERIAL IS TO HAVE IDENTIFICATION TAGS ON 10% OF THE TOTAL QUANTITY OF EACH SPECIES, SHOWING GENUS, SPECIES, VARIETY, ETC.
- CONTRACTOR TO PROVIDE MATCHING SIZES AND FORMS OF LIKE SHRUB SPECIES AS SHOWN ON DRAWINGS.
- DECOMPOSED GRANITE, 1/2" MINUS, COLOR: "PINK CORAL", 2" DEPTH TYPICAL IN ALL PLANTING BEDS. DECOMPOSED GRANITE SHALL CONTAIN 60% AGGREGATE AND 40% FINES, CONTRACTOR TO RECEIVE VERIFICATION FROM ROCK SUPPLIER AND PRESENT VERIFICATION TO THE OWNER PRIOR TO ANY CONSTRUCTION.
- LANDSCAPE BOULDERS ARE TO BE GRANITE AND ROUND IN SHAPE, COLOR TO MATCH OR COMPLIMENT ROCK GROUND COVER. CONTRACTOR TO SET 1/4 OF ROCK DIAMETER INTO FINISH GRADE. BOULDERS TO BE 2' TO 4' IN DIAMETER, SIZED ACCORDING TO THE FOLLOWING PERCENTAGES:
 - 20% 4' LARGEST DIAMETER*
 - 40% 3' LARGEST DIAMETER
 - 40% 2' LARGEST DIAMETER
 TOTAL QUANTITY OF BOULDERS: 68
 * NOT TO BE USED IN AREAS LESS THAN 7'
- LANDSCAPE LIGHTING—
 ▲ INSTALL TRAILBLAZER LANDSCAPE LIGHT, PRODUCT CODE LT-24-12W-45D-RD-VC-TW-LT8912GRS, OR APPROVED EQUAL.

WHOLESALE DEALER:
 KALAMAZOO MATERIALS, INC.
 2251 SOUTH FORT APACHE ROAD, SUITE 2079
 LAS VEGAS, NV 89117
 TELEPHONE: (702) 296-9133

TAND, INC.
 AS-BUILT

DATE: 11-18-11
 DANIEL MEYER

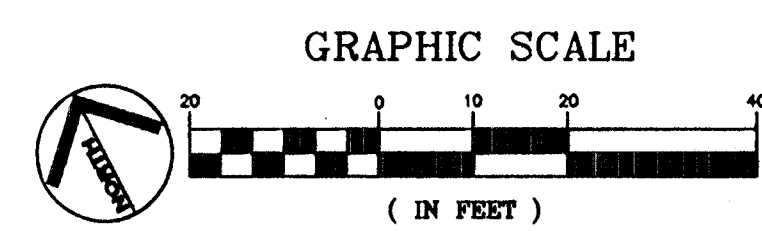

REVISIONS: SHEET REPLACEMENT
 DATE: 6/13/10
 CHECKED BY: ACP
 SCALE (H): 1"=20'
 SCALE (V): N/A
 DESIGNED BY: DJC
 DRAWN BY: FR
 DATE: FEBRUARY 2010
 CHECKED BY: ACP
 © 2010
Kimley-Horn and Associates, Inc.
 Engineering, Planning, and Environmental Consultants
 2080 E. Flamingo Road, Suite 210, Las Vegas, NV 89119
 PH: (702) 734-4949
 FAX: (702) 734-4949

DEPARTMENT OF PUBLIC WORKS
 BONNEVILLE/CLARK ONEWAY COUPLLET PHASE 1 IMPROVEMENT PLANS
 LANDSCAPE SHEET
 SHEET: 79 OF 91
 LA-07
 107V5201

REGISTERED LANDSCAPE ARCHITECT
 DANIEL MEYER
 7911
 Expire 06-30-11
 STATE OF NEVADA

811 SAFETY ALERT
 Call Before You Dig
 Know what's below
 Call before you dig! 702-227-2829

UnderGround
 Before you dig
 1-800-482-5300
 24 HOURS A DAY
 EXCEPT ON HOLIDAYS

BID # 09-1730-37 REV 3

20130500