

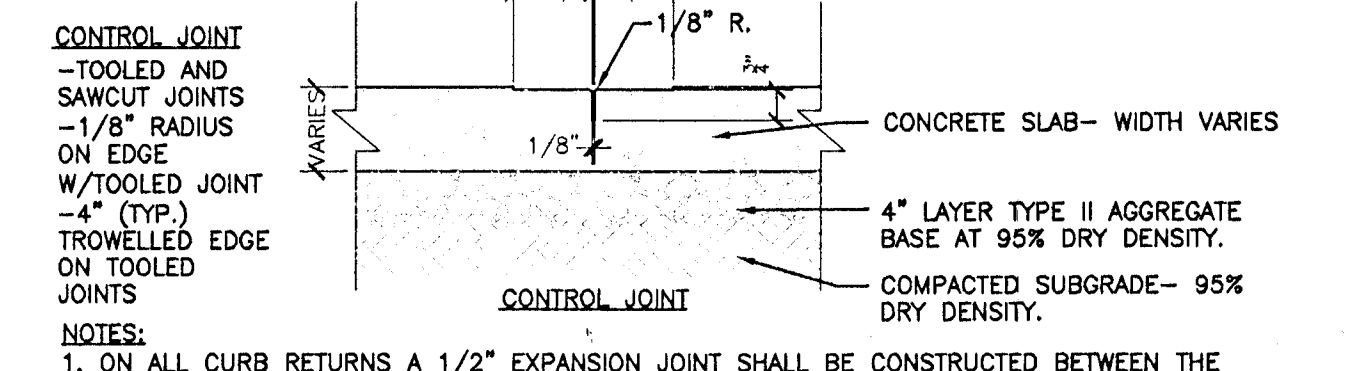



**A** CONCRETE SIDEWALK  
DETAIL NTS

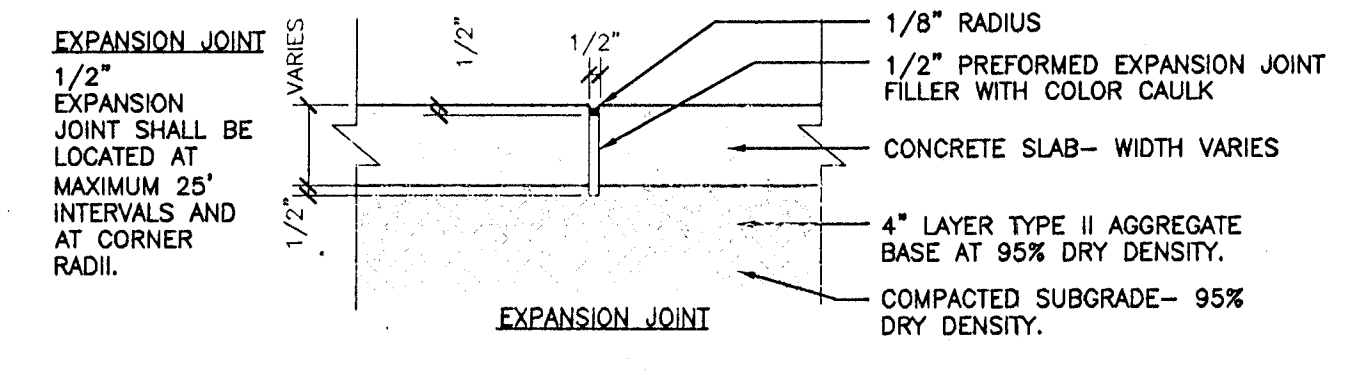


**B** EXPANSION & CONTROL JOINT  
DETAIL NTS

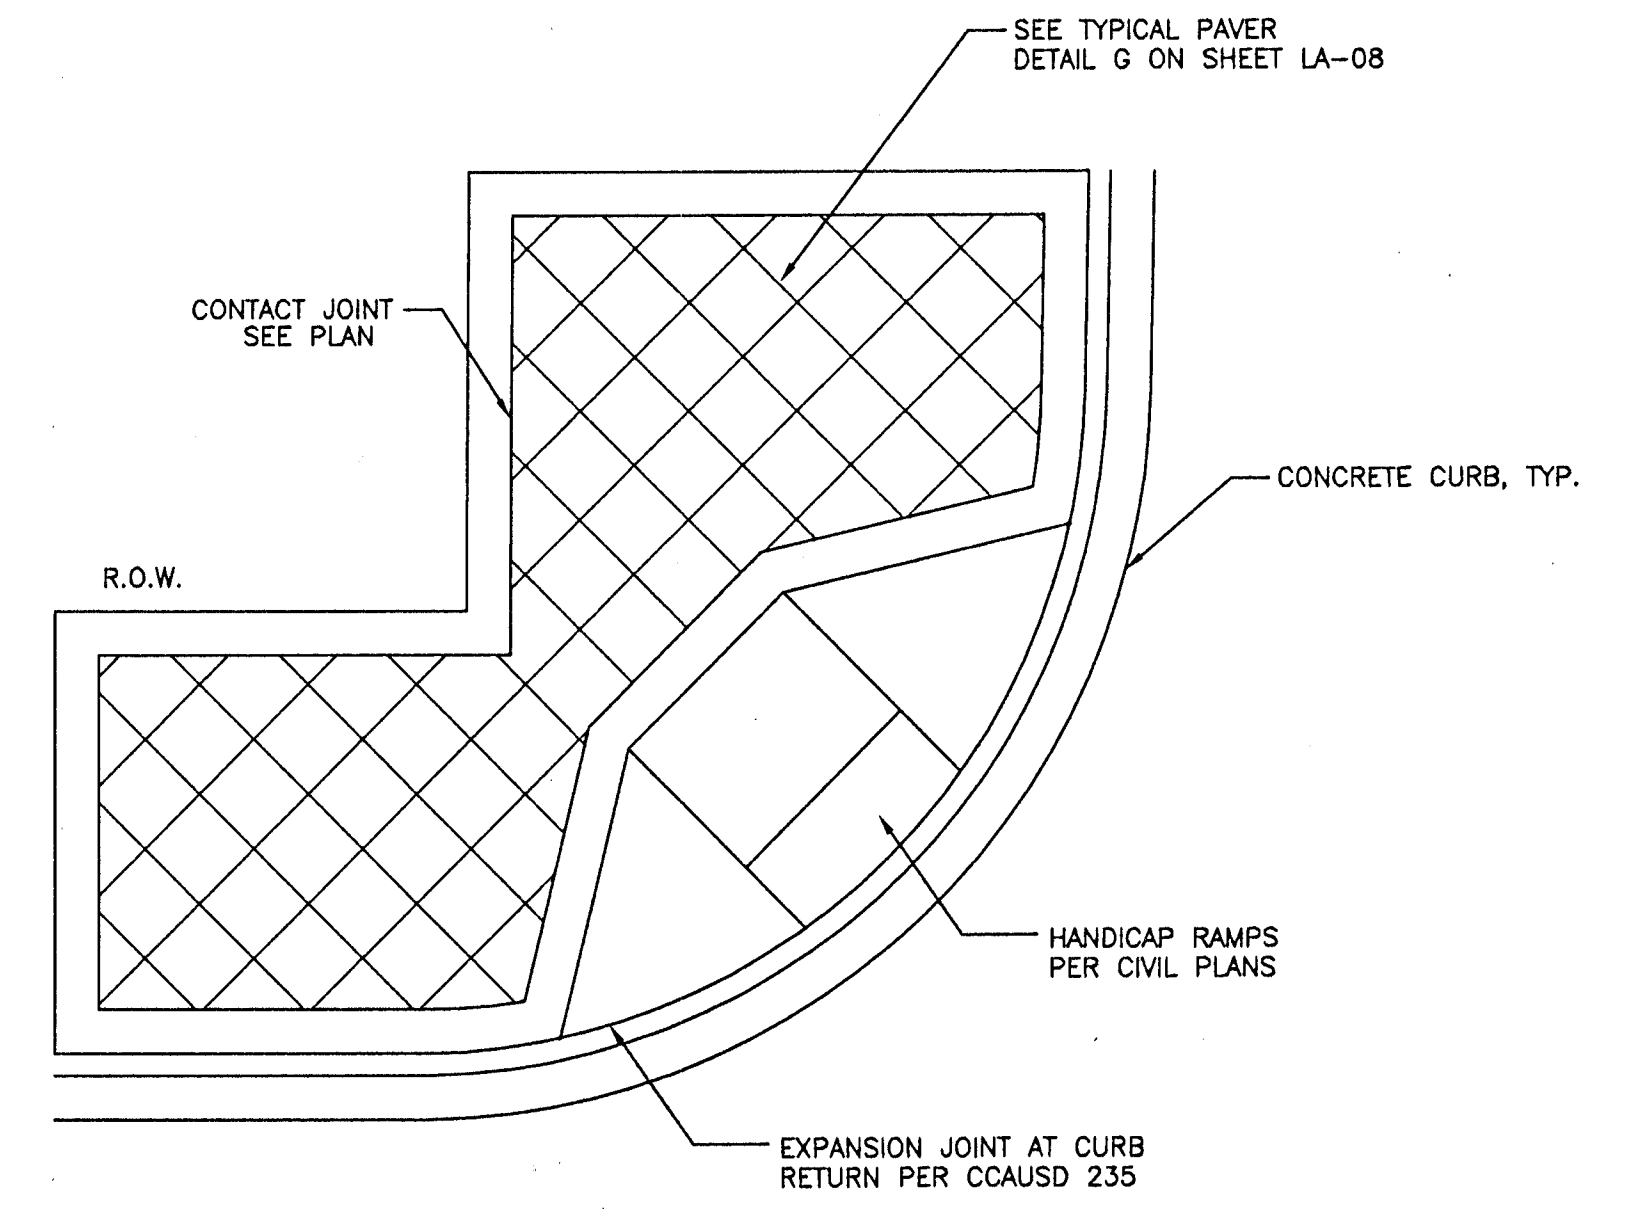


**C** TYPICAL CORNER TREATMENT  
DETAIL NTS

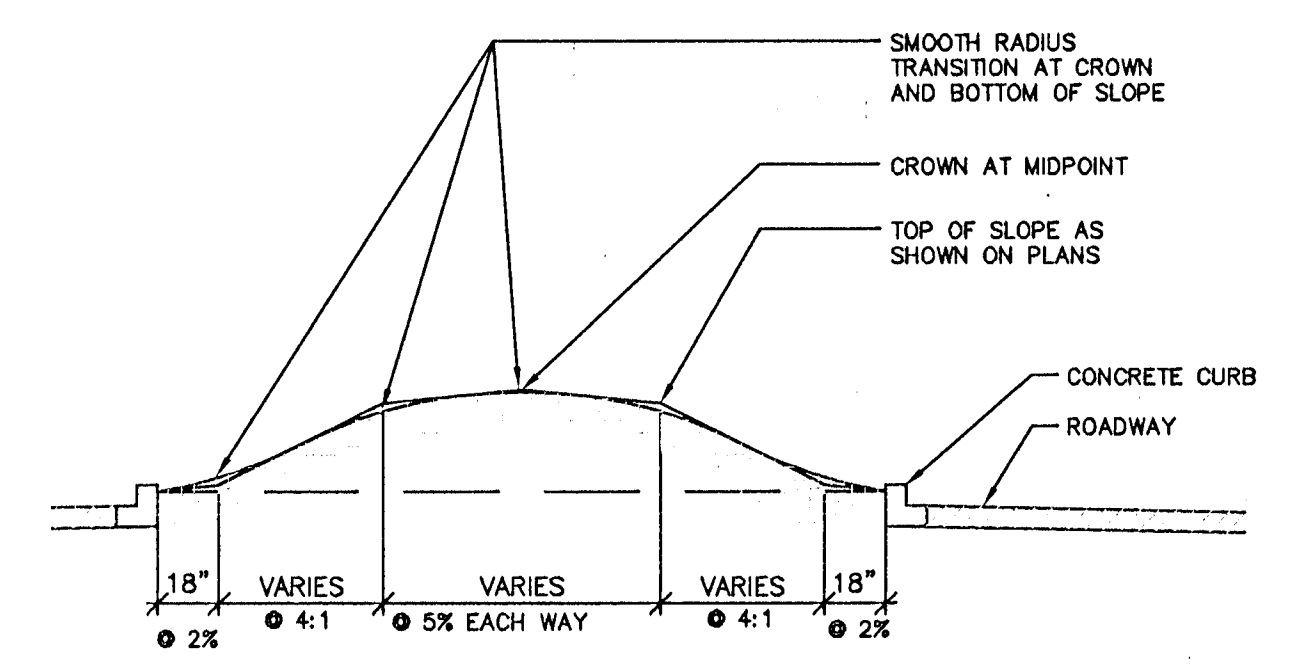

**D** LANDSCAPE MOUNDS @ MEDIAN  
DETAIL NTS

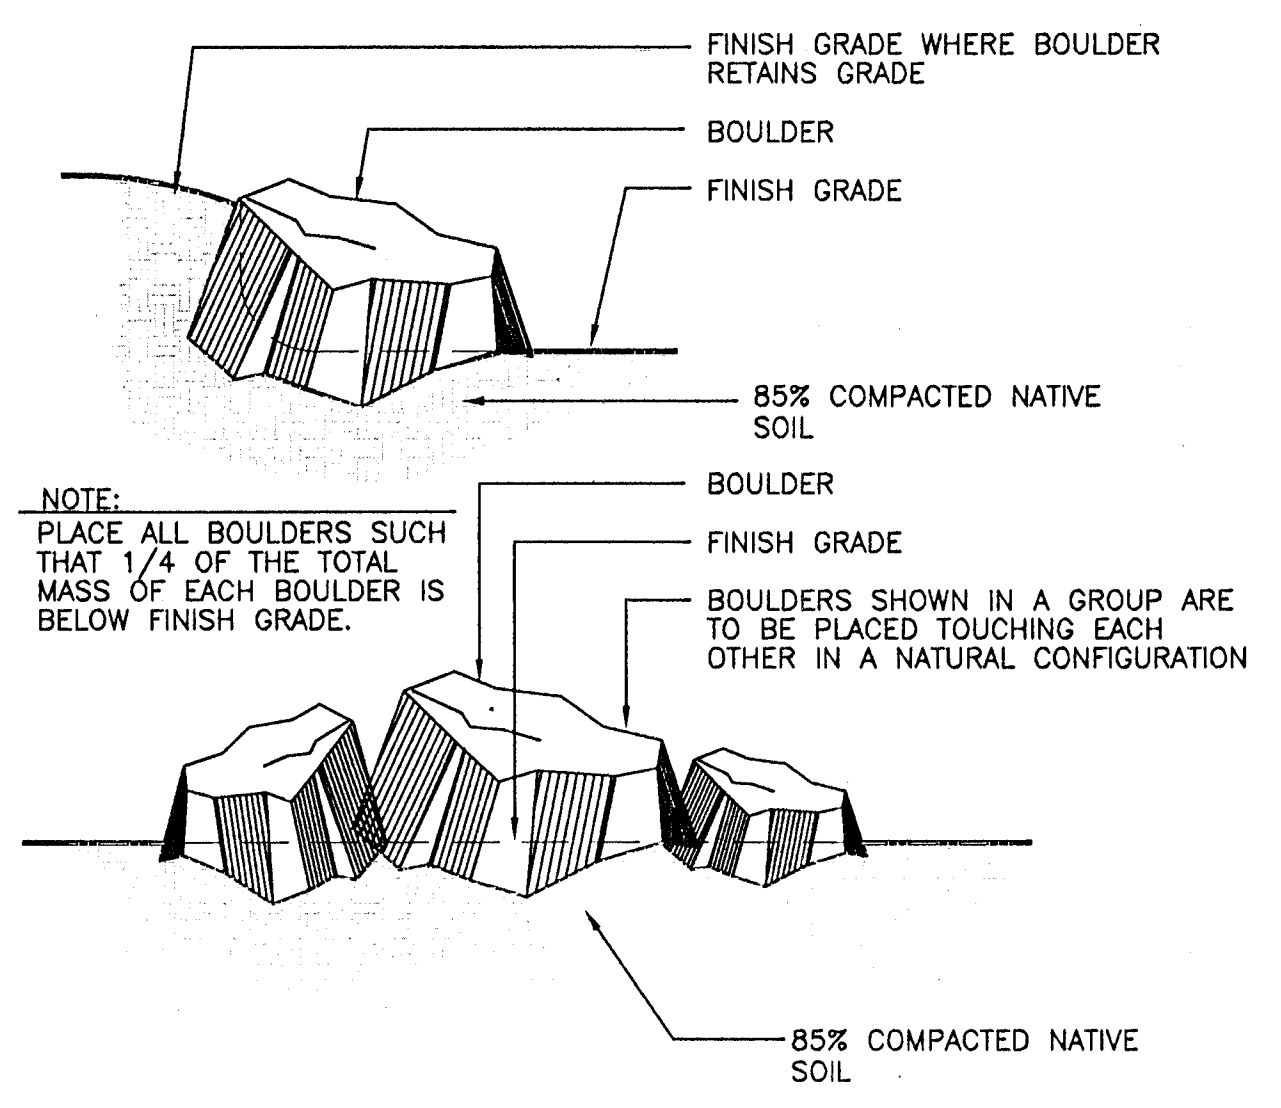

**E** LANDSCAPE BOULDERS DETAIL  
DETAIL NTS

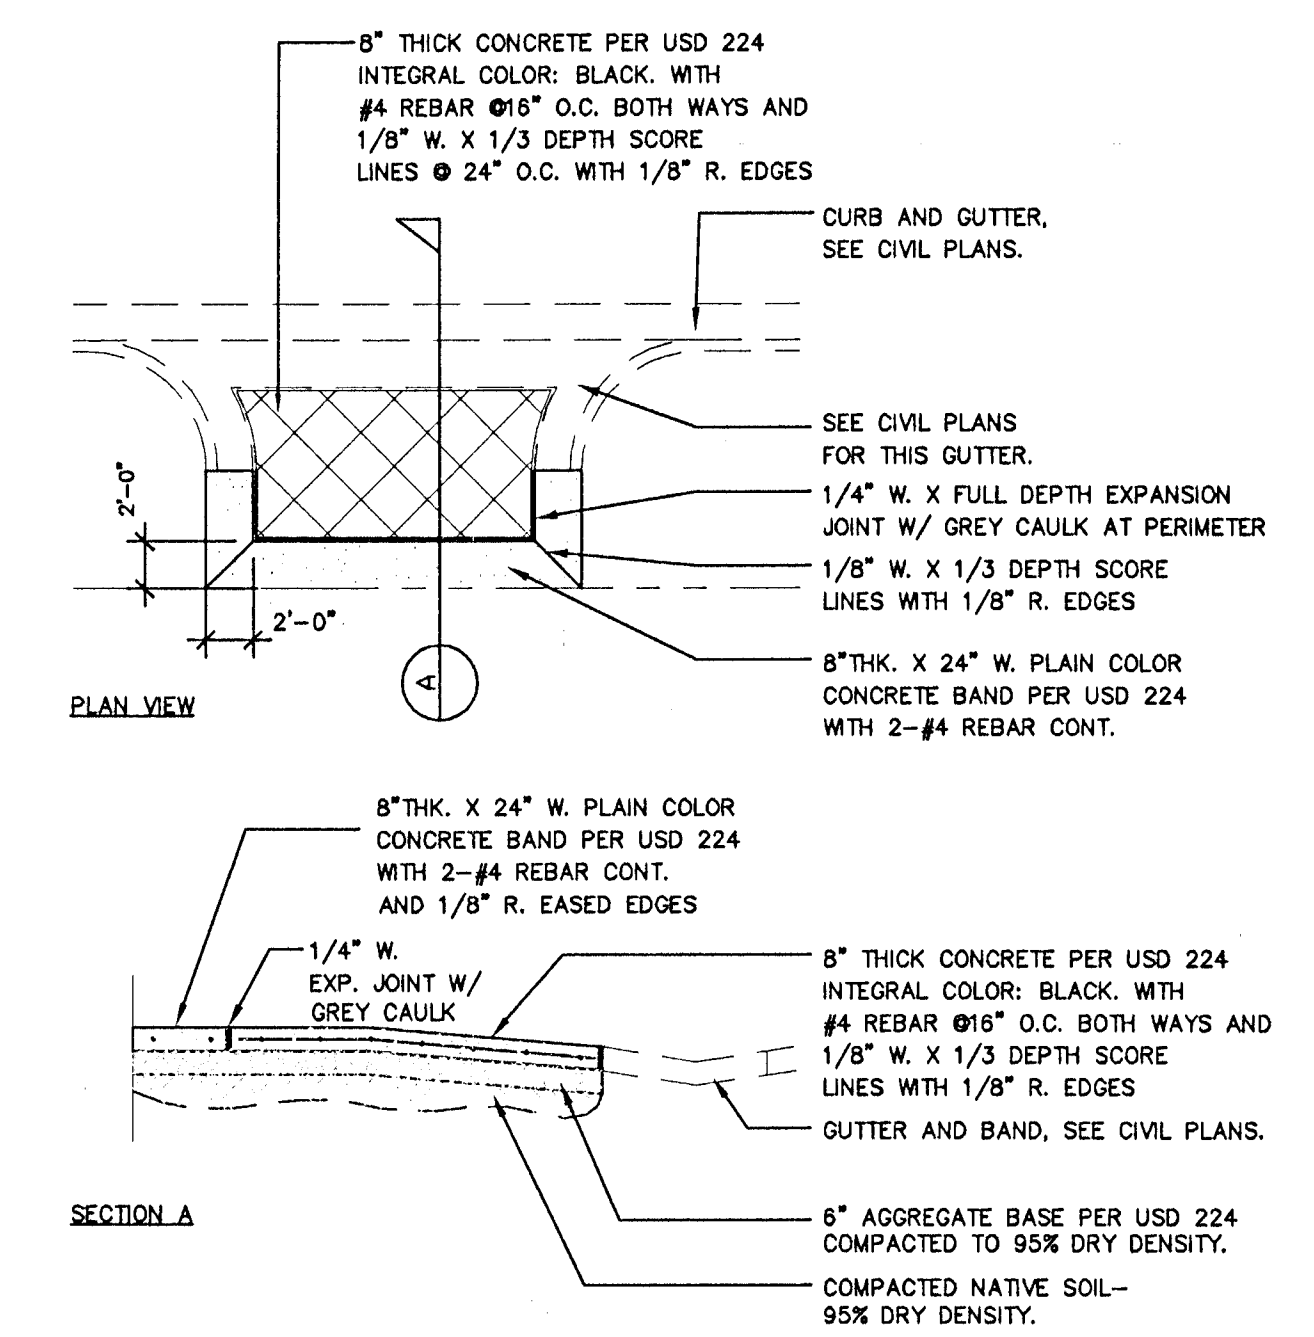

**F** DECORATIVE DRIVEWAY / ALLEY ENTRANCE  
DETAIL NTS

11:34am - USER: patermeyer@...  
 2013.05.02

2013.05.02

**TAND, INC. AS-BUILT**

**811 SAFETY ALERT**  
Call Before You Dig  
1-702-432-5300

**UnderGround**  
1-702-432-5300

**DEPARTMENT OF PUBLIC WORKS**

**BONNEVILLE/CLARK ONEWAY COUPLER PHASE 1 IMPROVEMENT PLANS**

**LANDSCAPE DETAILS**

**Kimley-Horn and Associates, Inc.**  
Engineering, Planning, and Environmental Consultants  
2080 E. Flamingo Road, Suite 210, Las Vegas, NV 89119  
PH: (702) 735-4549 FAX: (702) 735-4549

DATE: FEBRUARY 2010  
CHECKED BY: ACP  
DESIGNED BY: D.J.C.  
DRAWN BY: ER

SCALE (V): N/A  
SCALE (H): NTS

REVISIONS

SHEET NO. LA-09  
SHEET 01 OF 01  
DRAWING NO. 107V5201

BID# 09.1730.37