


Jun 14, 2010 - 5:10pm - USER: daniel.meyer - K:\PHX_Roadway\092-Las Vegas\092256019-Bonneville_ClarK_CADD\Bonneville-Clark_IR01-07A256019r01_07.dwg

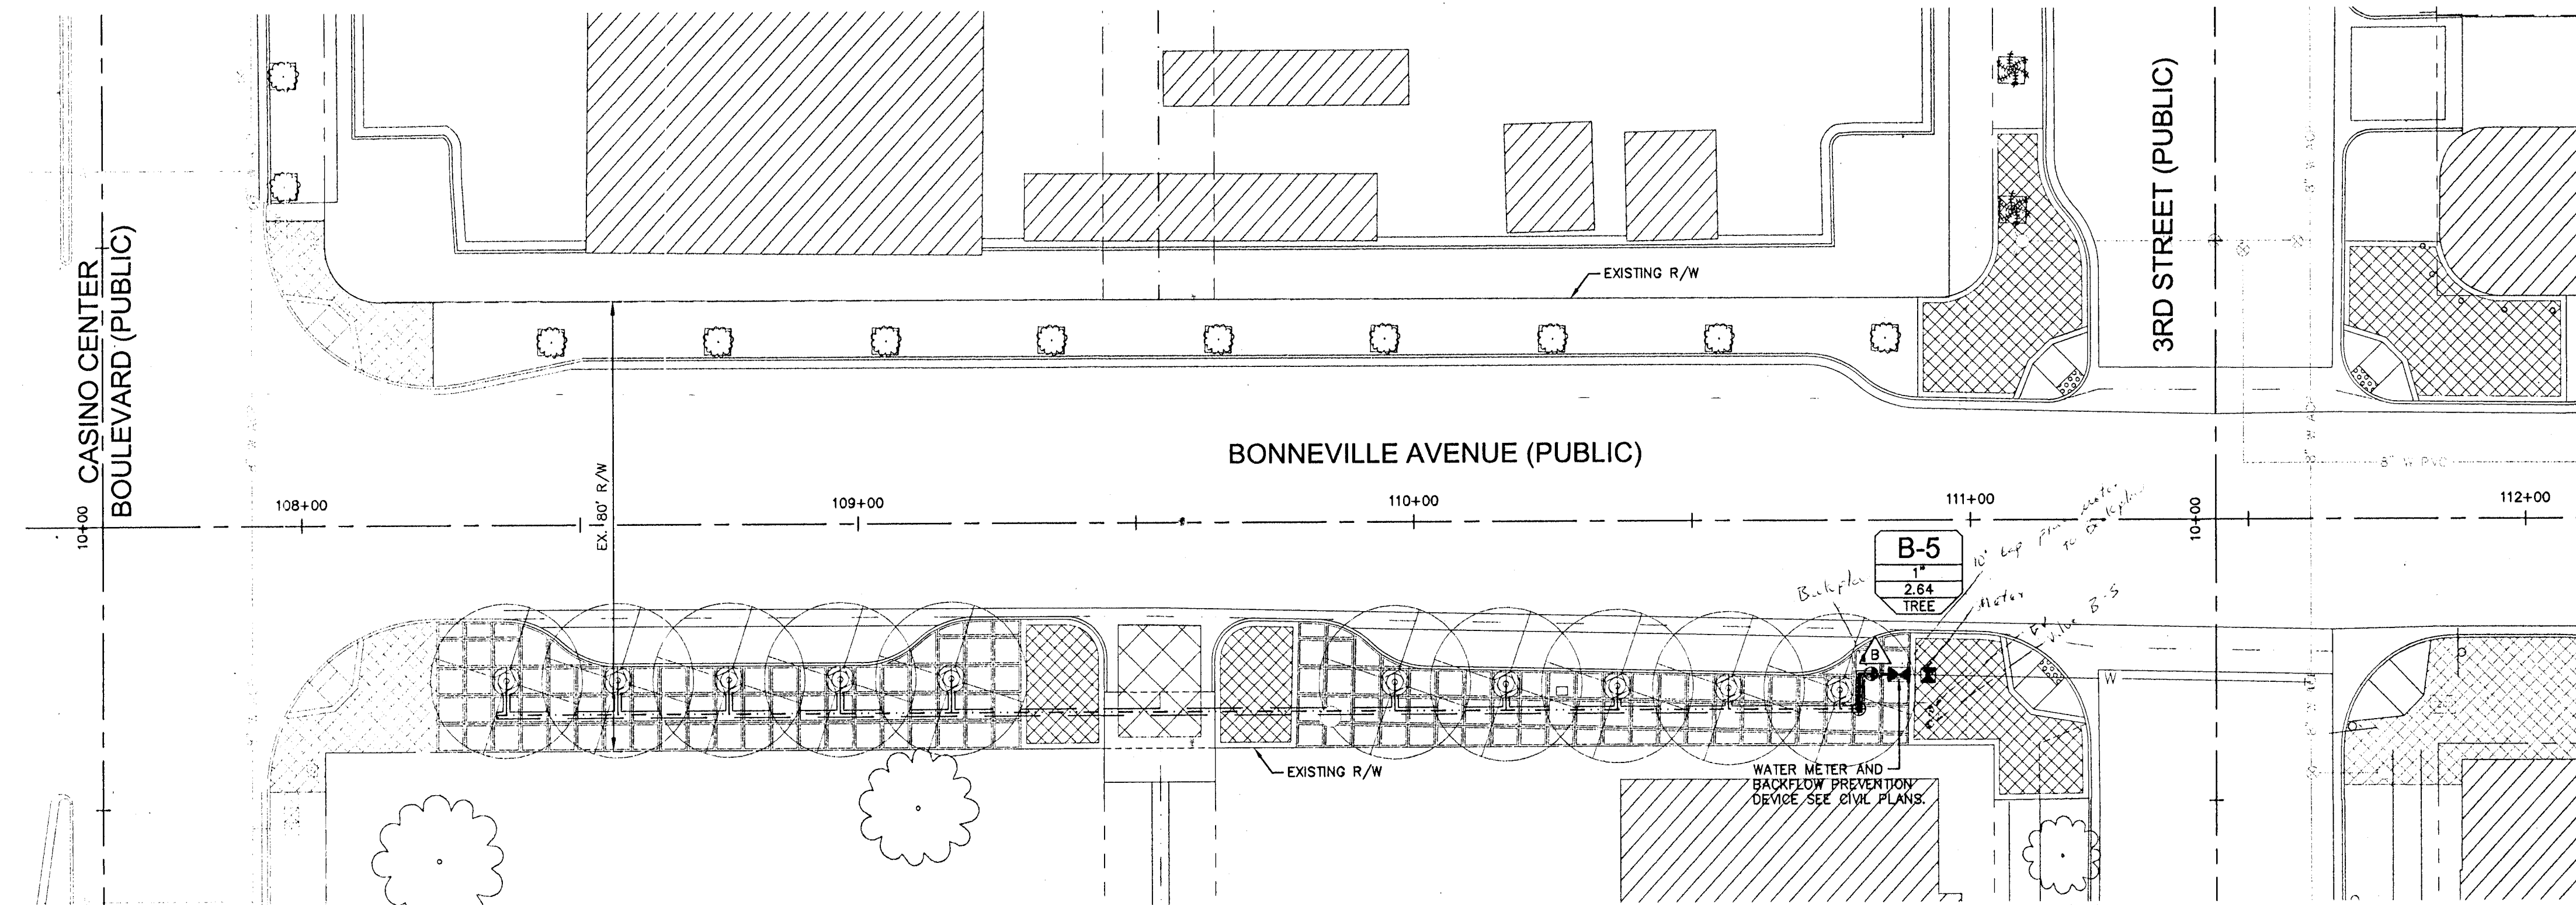

IRRIGATION SCHEDULE

EMITTERS							
SYMBOL	DESCRIPTION	PAT.	RAD.	PSI	GPM/H	MANUFACTURER	MODEL
NOT SHOWN	BUBBLER	BUB.	-	10	25 GPM	RAINBIRD	1401 IN PALM TUBE (3) PER PALM
NOT SHOWN	EMITTER	DRIP	-	7	2.0 GPH	BOWSMITH	SL-220 (FOR TREES)
NOT SHOWN	EMITTER	DRIP	-	7	1.0 GPH	BOWSMITH	SL-210 (FOR SHRUBS)

EQUIPMENT			
SYMBOL	DESCRIPTION	MODEL	DETAIL/SHEET
A	AUTOMATIC PEDESTAL MOUNT CONTROLLER(S) (A-D) - 12 STATION CONTROLLER	RAINBIRD ESP-SITE-SAT-S WITH ONE REMOTE CONTROL TECHNOLOGY COMMANDER PER PROJECT.	A/IR-08
B	WATER METER (SEE SHEET UT-01 TO UT-02)		
C	BACKFLOW PREVENTION DEVICE: (SEE SHEET UT-01 TO UT-02)		
F	FLOW SENSOR ASSEMBLY (OPERABLE BETWEEN 7.0 TO 225.0 GPM)	DATA INDUSTRIAL	C/IR-08
G	GATE VALVE (1")	NIBCO T-113	D/IR-08
H	DRIP VALVE (SIZE PER PLAN) (OPERATING RANGES FROM 3.0 - 20.0 GPM)	XCZ-100-B-COM SERIES RAINBIRD	E/IR-08
I	DRIP VALVE (SIZE PER PLAN) (OPERATING RANGES FROM .20 - 5.0 GPM)	XCZ-LF-100 SERIES RAINBIRD	E/IR-08
J	PALM VALVE ASSEMBLY: CENTURY 700 SERIES ELECTRIC VALVE (1") WITH FLOW CONTROL		E/IR-08
K	1" QUICK COUPLER VALVE	RAINBIRD 44 LRC, 1", 300GPM	F/IR-08
L	DRIP END BALL VALVE	-	G/IR-08

PIPE			
SYMBOL	MANUFACTURER - MODEL NUMBER	MODEL	DETAIL/SHEET
---	MAINLINE: PVC SCH. 40 (1"); UNLESS NOTED OTHERWISE		H/IR-08
---	LATERAL TREE LINE: PVC SCH. 40 MIN. (3/4" MIN. SIZE NOTED OTHERWISE)	EXCALIBUR	H/IR-08
---	LATERAL SHRUB LINE: PVC SCH. 40 MIN. (3/4" MIN. SIZE NOTED OTHERWISE)	EXCALIBUR	H/IR-08
---	LATERAL PALM LINE: PVC SCH. 40 MIN. (3/4" MIN. SIZE NOTED OTHERWISE)	EXCALIBUR	H/IR-08
---	MAINLINE SLEEVES, PVC SCH. 40 - 2 TIMES (2X) DIA. OF MAINLINE PIPE BEING USED; UNLESS OTHERWISE NOTED; MIN. 2"		I/IR-08
---	LATERAL SLEEVES, PVC SCH. 40 - 2 TIMES (2X) DIA. OF LATERAL PIPE BEING USED; UNLESS OTHERWISE NOTED; MIN. 2"		I/IR-08

NOTES

- THE IRRIGATION PLANS ARE SCHEMATIC, PLACE ALL EQUIPMENT, PIPING AND WIRING IN LANDSCAPE PLANTERS WHEREVER POSSIBLE.
- IT IS THE INTENT OF THESE DRAWINGS TO PROVIDE A 100% COVERAGE IRRIGATION SYSTEM TO ALL PROPOSED PLANTINGS.
- IF DISCREPANCIES EXIST BETWEEN THESE PLANS AND ACTUAL SITE CONDITIONS, BRING THE DISCREPANCIES TO THE IMMEDIATE ATTENTION OF THE CONSTRUCTION MANAGER.
- THE CONTRACTOR SHALL COMPLY WITH ALL LAWS, CODES AND ORDINANCES AS THEY PERTAIN TO THE SPECIFIED WORK.
- THE CONTRACTOR IS RESPONSIBLE FOR OBTAINING AND PAYING FOR ALL PERMITS AND FEES ASSOCIATED WITH THE SPECIFIED WORK, EXCEPT ORDINANCES AS THEY PERTAIN TO THE SPECIFIED WORK.
- THE LANDSCAPE ARCHITECT HAS WORKED TO ASCERTAIN THE LOCATION OF UTILITIES THAT MAY CONFLICT WITH THE WORK. IT IS THE CONTRACTOR'S RESPONSIBILITY TO ARRANGE FOR THE MARKING OF ALL UTILITIES PRIOR TO BEGINNING WORK.
- THE CONTRACTOR SHALL BE RESPONSIBLE FOR ALL DAMAGE TO EXISTING UTILITIES AND/OR STRUCTURES DURING THE CONSTRUCTION PERIOD. THE CONTRACTOR SHALL REPAIR ALL DAMAGE TO THE OWNER'S STANDARDS AT NO ADDITIONAL COST TO THE OWNER.
- THE CONTRACTOR SHALL CAP ALL IRRIGATION LINES AND RECOAT EXISTING EMITTERS CURRENTLY LOCATED IN DEMOLITION AREAS. CONTRACTOR SHALL REGRADE, REPAIR AND REPLACE BOULDER BANDS, CRUSHED STONE PAVING, REPLACE GLASS BLOCK BAND AND ILLUMINATOR AT CONTRACTORS EXPENSE. CONTRACTOR IS RESPONSIBLE FOR VERIFYING CONDITIONS PRIOR TO BIDDING.

A-1	CONTROLLER/STATION NUMBER
1"	VALVE SIZE
00.0	GPM
SHRUB	TREE/SHRUB


LOCATION OF IRRIGATION EQUIPMENT IS SHOWN
DIAGRAMMATICALLY FOR CLARITY. LOCATE EQUIPMENT
WITHIN PLANTING AREAS WHEREVER POSSIBLE.

EMITTER QUANTITIES	
PLANT SIZE	QTY
TREES:	
36" BOX	10-2 GPH
SHRUBS:	
5 GAL.	2-1 GPH

CONTROLLER	STATION	VALVE SIZE	GPM	TYPE
A	2	1"	1.85	TREE
A	3	1"	3.10	SHRUB
A	4	1"	4.50	PALM
B	5	1"	2.64	TREE
C	6	1"	3.30	SHRUB
C	7	1"	3.17	TREE
D	8	1"	0.80	SHRUB
D	9	1"	5.54	TREE

TAND, INC.
AS-BUILT

DATE 11-12-11
DANIEL MEYER

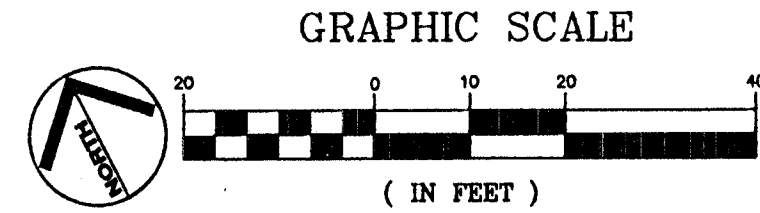

811 SAFETY ALERT
Before You Overhead
Call before you dig
1-800-432-5300
UnderGround
Call before you dig
1-800-432-5300

REVISIONS
SHEET REPLACEMENT
DATE 6/15/10
CHECKED BY: ACJ
DESIGNED BY: DJC
SCALE (H): 1"=20'
SCALE (V): N/A
DRAWN BY: FR

Kimley-Horn
and Associates, Inc.
Engineering, Planning, and Environmental Consultants
2000 E. Flamingo Road, Suite 200, Las Vegas, NV 89119
PH (702) 735-5555
FAX (702) 735-5555

DEPARTMENT OF PUBLIC WORKS
PROJECT: BONNEVILLE/CLARK
ONEWAY COUPLET PHASE 1
IMPROVEMENT PLANS
SHEET: IRRIGATION SHEET

STATE OF NEVADA
LANDSCAPE ARCHITECT
ADAM PERILO
Expire: 6/30/11
SHEET NO. 84 OF 91
DRAWING NO. 107V5201

BID# 09.1730.37 REV 3