

SHEET NOTES M2.04

- ① SEE SHEET M2.03 FOR CONTINUATION.
- ② SEE SHEET M2.05 FOR CONTINUATION.
- ③ SEE SHEET M2.07 FOR CONTINUATION.
- ④ SEE SHEET M3.00 FOR CONTINUATION.
- ⑤ 56x18 SA UP THRU ROOF TO UNIT OPENING.
- ⑥ 44x18 SA UP THRU ROOF TO UNIT OPENING.
- ⑦ 55x12 RA UP THRU ROOF TO UNIT OPENING. LINE WITH 1" 1-1/2# DENSITY ACOUSTIC DUCT LINER.
- ⑧ 24x14 TRANSFER AIR DUCT. LINE WITH 1" 1-1/2# DENSITY ACOUSTIC DUCT LINER.
- ⑨ 14x14 EA UP THRU ROOF.
- ⑩ 34x20 TRANSFER AIR DUCT. LINE WITH 1" 1-1/2# DENSITY ACOUSTIC DUCT LINER.
- ⑪ 12x12 TRANSFER AIR DUCT.
- ⑫ 22x14 TRANSFER AIR DUCT. LINE WITH 1" 1-1/2# DENSITY ACOUSTIC DUCT LINER.
- ⑬ 16x16 TRANSFER AIR DUCT.
- ⑭ 55x14 RA TURNED UP WITH 90° ELBOW AND TURNING VANES.
- ⑮ 3" CHS/R UP THRU ROOF.
- ⑯ 2-1/2" HWS/R UP THRU ROOF.
- ⑰ 8x4 COBUSTION AIR DUCT FROM 12" ABOVE FINISHED FLOOR UP THRU ROOF TO GOOSENECK WITH BIRDSCREEN.
- ⑱ 8x4 COBUSTION AIR DUCT FROM 12" BELOW FINISHED CEILING UP THRU ROOF TO GOOSENECK WITH BIRDSCREEN.

ROOM NAME SCHEDULE

- 401 VESTIBULE
- 402 LOBBY
- 403 RECEPTION
- 404 COMPUTER LOUNGE
- 405 VIEWING AREA
- 406 CIRCULATION
- 407 VIEWING AREA
- 408 VESTIBULE
- 409 COMPUTER LOUNGE
- 411 CIRCULATION
- 412 CHILD WATCH
- 413 JANITOR
- 414 F.R.
- 415 TOILET ROOM
- 416 STORAGE
- 417 TOILET ROOM
- 418 TOILET ROOM
- 419 TOILET ROOM
- 421 PAINT & CRAFT
- 422 GYMNASIUMS
- 423 PRE-SCHOOL
- 424 STORAGE
- 425 CIRCULATION
- 426 RESTROOM
- 427 RESTROOM
- 428 OFFICE
- 429 PRE-SCHOOL
- 431 STORAGE
- 432 TELE-AUX
- 433 ELEC-AUX
- 434 RESTROOM
- 435 RESTROOM
- 436 STORAGE
- 437 GAME ROOM
- 438 OFFICE
- 439 CONFERENCE
- 441 OFFICE
- 442 OFFICE
- 443 OFFICE
- 444 CIRCULATION
- 445 COPY & FILE
- 446 I.T.
- 447 TOILET ROOM
- 448 WORKSTATION
- 449 WORKSTATION
- 451 WORKSTATION
- 452 WORKSTATION
- 453 WORKSTATION
- 454 WORKSTATION
- 455 STORAGE


Disclaimer: These record drawings prepared by LUCCESE GALATI ARCHITECTS, INC. are based on information provided by others. Luccese Galati Architects, Inc. has not verified the accuracy and/or completeness of its information supplied by others, and shall not be responsible for any errors or omissions, which may be incorporated herein as a result.

CITY OF LAS VEGAS
CENTENNIAL HILLS COMMUNITY CENTER
FLOOR PLAN - AREA D
MECHANICAL

1/20/07

05.15341.01
6.11.43


M2.04

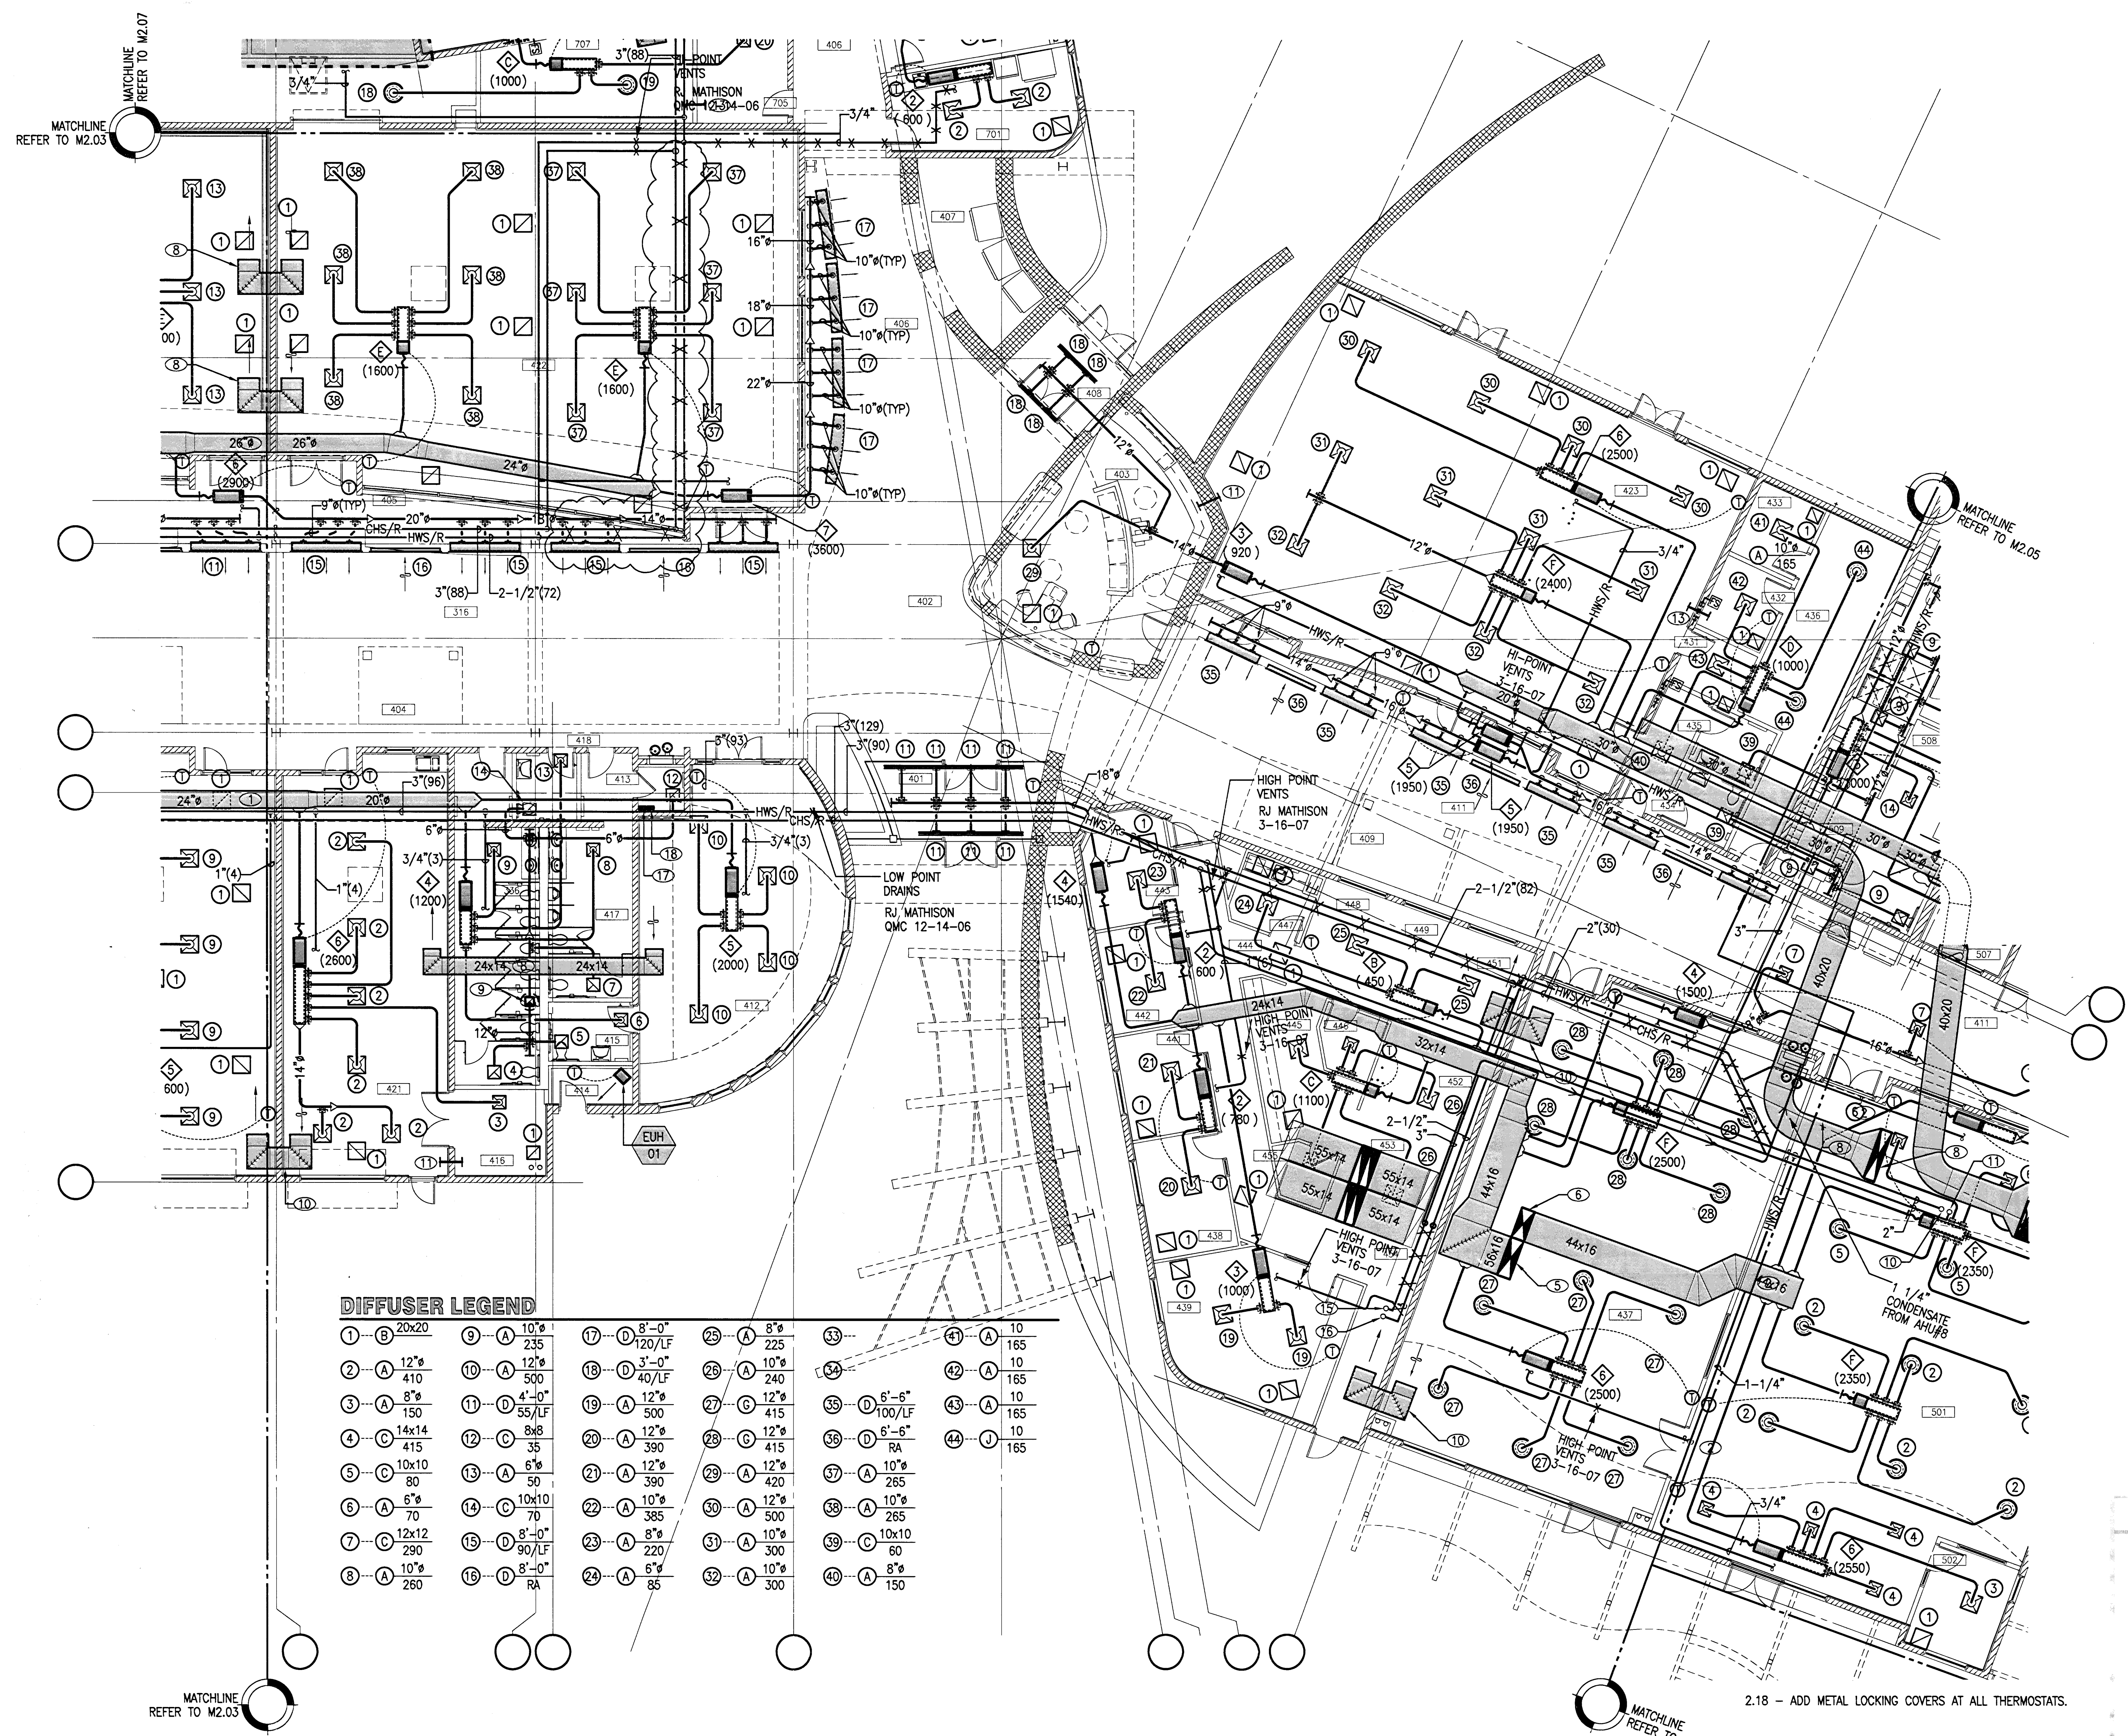

DIFFUSER LEGEND

① - 20x20	⑨ - 10"ø	⑰ - 8"-0"	⑳ - 8"ø	⑳ - 10
② - 12"ø	⑩ - 12"ø	⑱ - 3"-0"	㉑ - 10"ø	㉑ - 10
③ - 8"ø	⑪ - 4"-0"	⑲ - 12"ø	㉒ - 6"-6"	㉒ - 10
④ - 14x14	⑫ - 8x8	⑳ - 12"ø	㉓ - 6"-6"	㉓ - 10
⑤ - 10x10	⑬ - 6"ø	㉑ - 12"ø	㉔ - 10"ø	㉔ - 10
⑥ - 6"ø	⑭ - 10x10	㉒ - 12"ø	㉕ - 10"ø	㉕ - 10
⑦ - 12x12	⑮ - 8"-0"	㉓ - 12"ø	㉖ - 10x10	㉖ - 60
⑧ - 10"ø	⑯ - 8"-0"	㉔ - 10"ø	㉗ - 8"ø	㉗ - 8"ø
	⑰ - 8"-0"	㉕ - 10"ø	㉘ - 10"ø	㉘ - 150
	⑱ - 8"ø	㉖ - 10"ø		
	⑳ - 8"ø	㉗ - 10"ø		
	㉑ - 8"ø	㉘ - 10"ø		
	㉒ - 8"ø	㉙ - 10"ø		
	㉓ - 8"ø	㉚ - 10"ø		
	㉔ - 8"ø	㉛ - 10"ø		
	㉕ - 8"ø	㉜ - 10"ø		
	㉖ - 8"ø	㉝ - 10"ø		
	㉗ - 8"ø	㉞ - 10"ø		
	㉘ - 8"ø	㉟ - 10"ø		
	㉙ - 8"ø	㊀ - 10"ø		
	㉚ - 8"ø	㊁ - 10"ø		
	㉛ - 8"ø	㊂ - 10"ø		
	㉜ - 8"ø	㊃ - 10"ø		
	㉝ - 8"ø	㊄ - 10"ø		
	㉞ - 8"ø	㊅ - 10"ø		
	㉟ - 8"ø	㊆ - 10"ø		
	㊀ - 8"ø	㊇ - 10"ø		
	㊁ - 8"ø	㊈ - 10"ø		
	㊂ - 8"ø	㊉ - 10"ø		
	㊃ - 8"ø	㊊ - 10"ø		
	㊄ - 8"ø	㊋ - 10"ø		
	㊅ - 8"ø	㊌ - 10"ø		
	㊆ - 8"ø	㊍ - 10"ø		
	㊇ - 8"ø	㊎ - 10"ø		
	㊈ - 8"ø	㊏ - 10"ø		
	㊉ - 8"ø	㊑ - 10"ø		
	㊊ - 8"ø	㊒ - 10"ø		
	㊋ - 8"ø	㊓ - 10"ø		
	㊌ - 8"ø	㊔ - 10"ø		
	㊍ - 8"ø	㊕ - 10"ø		
	㊎ - 8"ø	㊖ - 10"ø		
	㊏ - 8"ø	㊗ - 10"ø		
	㊑ - 8"ø	㊘ - 10"ø		
	㊒ - 8"ø	㊙ - 10"ø		
	㊓ - 8"ø	㊚ - 10"ø		
	㊔ - 8"ø	㊛ - 10"ø		
	㊕ - 8"ø	㊜ - 10"ø		
	㊖ - 8"ø	㊝ - 10"ø		
	㊗ - 8"ø	㊞ - 10"ø		
	㊘ - 8"ø	㊟ - 10"ø		
	㊙ - 8"ø	㊠ - 10"ø		
	㊚ - 8"ø	㊡ - 10"ø		
	㊛ - 8"ø	㊢ - 10"ø		
	㊜ - 8"ø	㊣ - 10"ø		
	㊝ - 8"ø	㊤ - 10"ø		
	㊞ - 8"ø	㊦ - 10"ø		
	㊟ - 8"ø	㊧ - 10"ø		
	㊠ - 8"ø	㊨ - 10"ø		
	㊡ - 8"ø	㊩ - 10"ø		
	㊢ - 8"ø	㊪ - 10"ø		
	㊣ - 8"ø	㊫ - 10"ø		
	㊤ - 8"ø	㊬ - 10"ø		
	㊦ - 8"ø	㊭ - 10"ø		
	㊧ - 8"ø	㊮ - 10"ø		
	㊨ - 8"ø	㊯ - 10"ø		
	㊩ - 8"ø	㊰ - 10"ø		
	㊪ - 8"ø	㊱ - 10"ø		
	㊫ - 8"ø	㊲ - 10"ø		
	㊬ - 8"ø	㊳ - 10"ø		
	㊭ - 8"ø	㊴ - 10"ø		
	㊮ - 8"ø	㊵ - 10"ø		
	㊯ - 8"ø	㊶ - 10"ø		
	㊰ - 8"ø	㊷ - 10"ø		
	㊱ - 8"ø	㊸ - 10"ø		
	㊲ - 8"ø	㊹ - 10"ø		
	㊳ - 8"ø	㊺ - 10"ø		
	㊴ - 8"ø	㊻ - 10"ø		
	㊵ - 8"ø	㊼ - 10"ø		
	㊶ - 8"ø	㊽ - 10"ø		
	㊷ - 8"ø	㊾ - 10"ø		
	㊸ - 8"ø	㊿ - 10"ø		

FLOOR PLAN - AREA D
SCALE: 1/8" = 1'-0"

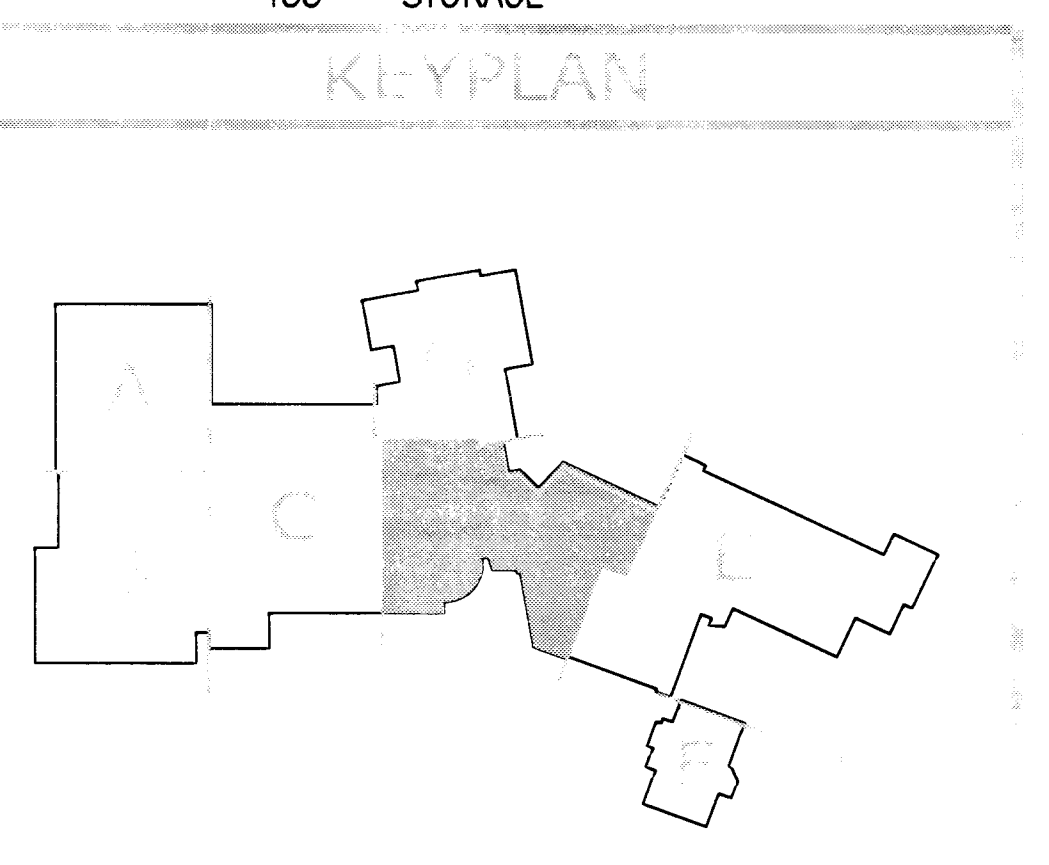

2.18 - ADD METAL LOCKING COVERS AT ALL THERMOSTATS.

MATCHLINE REFER TO M2.05

MATCHLINE REFER TO M2.03

127735

JUL 10 2007 10:10 AM