

**SHEET NOTES** M2.07

- ① SEE SHEET M2.03 FOR CONTINUATION.
- ② SEE SHEET M2.04 FOR CONTINUATION.
- ③ SEE SHEET M3.00 FOR CONTINUATION.
- ④ 54x14 SA DUCT UP THRU ROOF.
- ⑤ 60x14 RA UP THRU ROOF TO UNIT OPENING. LINE WITH 1", 1-1/2# DENSITY ACOUSTIC DUCT LINER.
- ⑥ 30x18 TRANSFER AIR DUCT. LINE WITH 1", 1-1/2# DENSITY ACOUSTIC DUCT LINER.
- ⑦ 14x14 EA DUCT UP THRU ROOF.
- ⑧ 3" CHS/R UP THRU ROOF.
- ⑨ 2-1/2" HWS/R UP THRU ROOF.
- ⑩ 60x14 RA TURNED UP WITH 90° ELBOW AND TURNING VANES.
- ⑪ 8x4 COBUSTION AIR DUCT FROM 12" ABOVE FINISHED FLOOR UP THRU ROOF TO GOOSENECK WITH BIRDSCREEN.
- ⑫ 8x4 COBUSTION AIR DUCT FROM 12" BELOW FINISHED CEILING UP THRU ROOF TO GOOSENECK WITH BIRDSCREEN.
- ⑬ 12x12 TRANSFER AIR DUCT.

PROJECT: CITY OF LAS VEGAS  
 CENTENNIAL HILLS COMMUNITY CENTER  
 FLOOR PLAN - AREA G  
 MECHANICAL



Disclaimer: These record drawings prepared by Lucchesi Galati Architects, Inc., are based on information provided by others. Lucchesi Galati Architects, Inc. has not verified the accuracy and/or completeness of this information supplied by others, and shall not be responsible for any errors or omissions, which may be incorporated herein as a result.

CITY OF LAS VEGAS  
 CENTENNIAL HILLS COMMUNITY CENTER  
 FLOOR PLAN - AREA G  
 MECHANICAL

**DIFFUSER LEGEND**

|           |           |          |          |          |
|-----------|-----------|----------|----------|----------|
| ① - 20x20 | ⑤ - 8x8   | ⑨ - 12"ø | ⑬ - 8"ø  | ⑰ - 10"ø |
| ② - 10"ø  | ⑥ - 8x8   | ⑩ - 10"ø | ⑭ - 8"ø  | ⑱ - 10"ø |
| ③ - 10"ø  | ⑦ - 14x14 | ⑪ - 10"ø | ⑮ - 8"ø  | ⑲ - 10"ø |
| ④ - 10"ø  | ⑧ - 12"ø  | ⑫ - 12"ø | ⑯ - 12"ø | ⑳ - 12"ø |
| 250       | 65        | 425      | 200      | 290      |
| 230       | 50        | 250      | 210      | 330      |
| 230       | 415       | 230      | 190      | 330      |
| 230       | 360       | 475      | 490      | 330      |



SEE 4  
 FOR ENLARGED  
 MECHANICAL  
 PLAN


1-1/4" CONDENSATE  
 DRAIN FROM AHU#5  
 TO MOP-SINK.  
 RJ MATHISON  
 OMC 1-4-07

LOW POINTS  
 DRAINS  
 RJ MATHISON  
 OMC 12-14-06

RJ MATHISON  
 OMC 12-12-06

**FLOOR PLAN - AREA G**  
 M2.07 SCALE: 1/8" = 1'-0"

2.18 - ADD METAL LOCKING COVERS AT ALL THERMOSTATS.

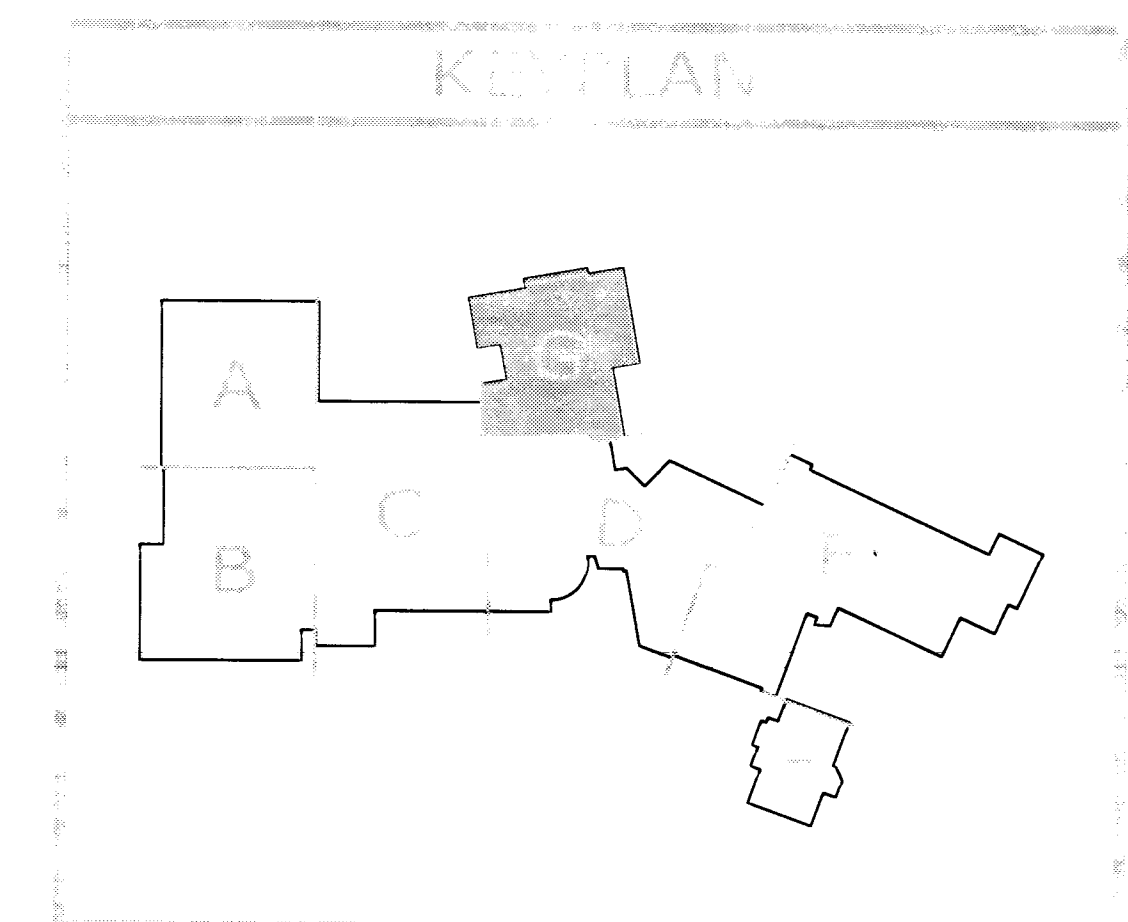

127033