


SHEET NOTES

- ① SECURE YARD HYDRANT TO STRUCTURE BELOW. FLASH ROOF PENETRATION WATER TIGHT.

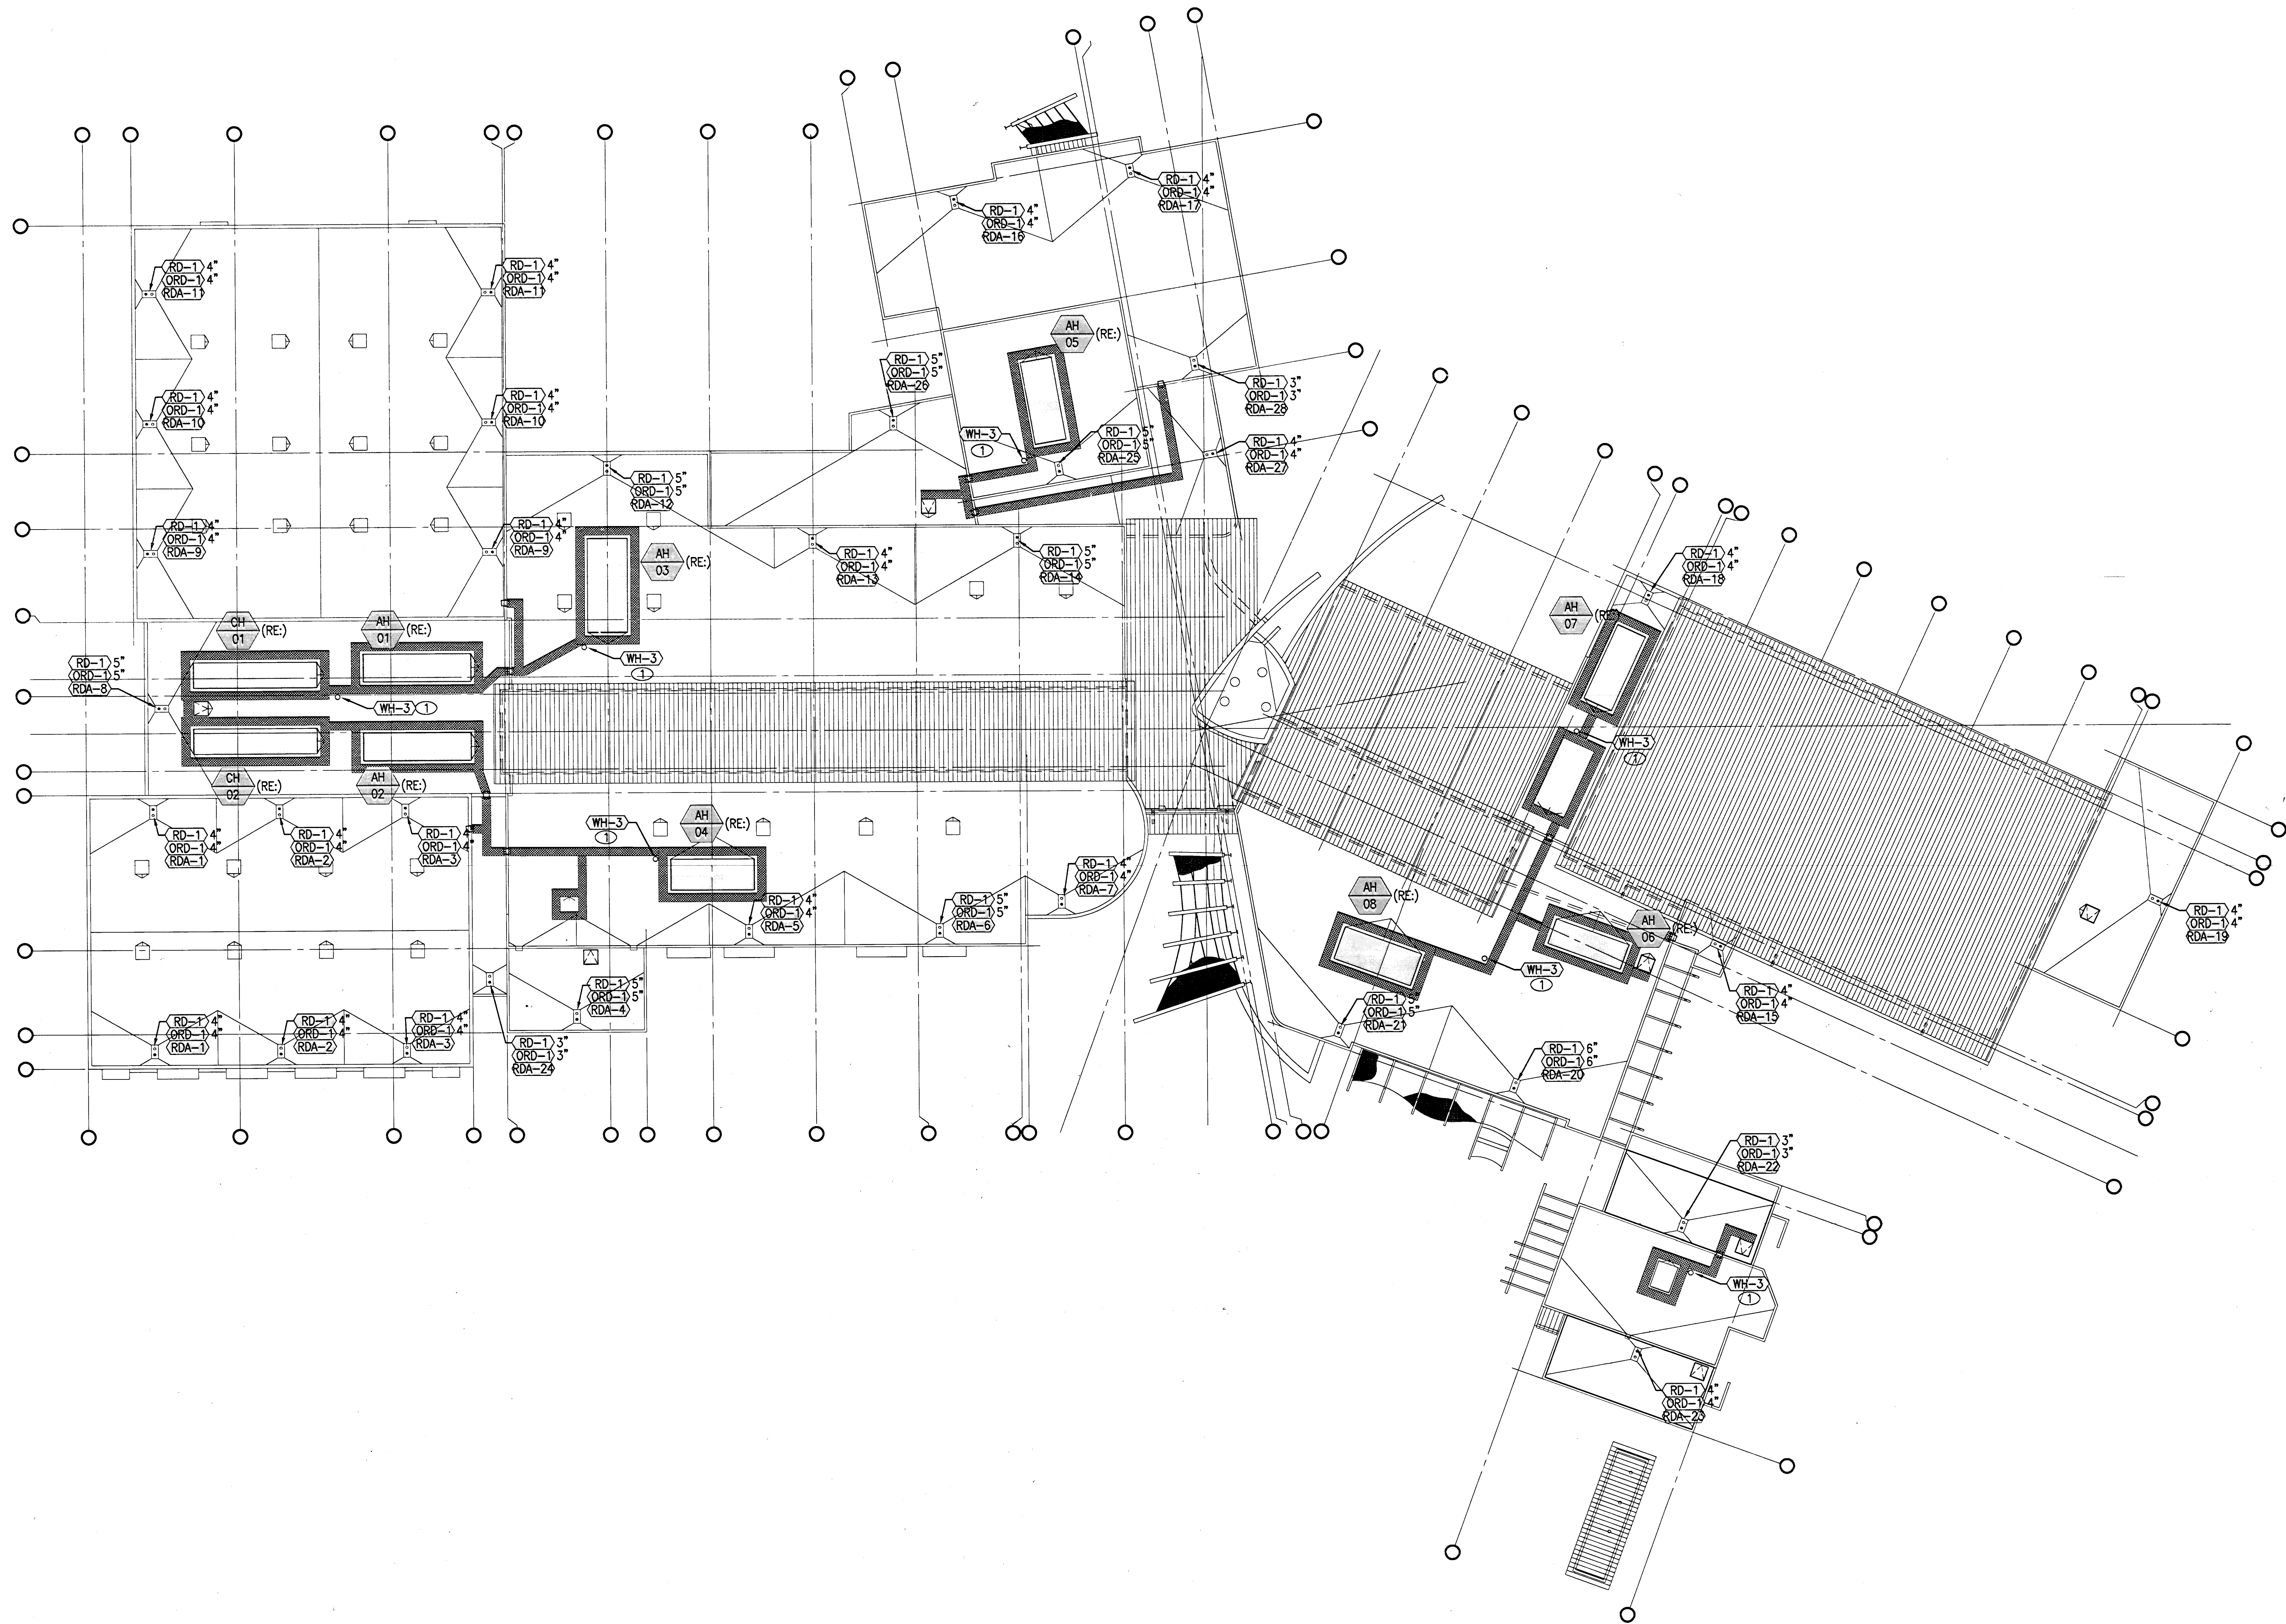

RECORD DRAWING 1/25/07

127793

300 FIRST ROAD, SUITE A
LAS VEGAS, NEVADA 89109
702 253-7111 FAX
702 253-7111

LUCCHESI GALATI

Disclaimer: These record drawings prepared by Lucchese Galati Architects, Inc. are based on information provided by others. Lucchese Galati Architects, Inc. has not verified the accuracy and/or completeness of its information supplied by others, and shall not be responsible for any errors or omissions, which may be incorporated herein as a result.

CITY OF LAS VEGAS
CENTENNIAL HILLS COMMUNITY CENTER
ROOF PLAN

ROOF PLAN
P3.01 SCALE: 1" = 20'-0"

05-18-09
051534101
611-49