


ELECTRICAL LIGHTING PLAN AREA F

SCALE: 1/8"=1'-0"

- NOTES:**
- ① ROUTE CIRCUIT THROUGH TIMELOCK AND CONTACTOR. SEE CONTACTOR SCHEDULE.
 - ② OVERRIDE SWITCH FOR POOL/CANOPY LIGHTS. ROUTE 5#12, 3/4" C TO CONTACTOR "CB" AND "CBC".
 - ③ MOUNT FIXTURE ON WALL ABOVE PARTITION WALL OF THE SHOWER AREA.

2.14 REFERENCE: DRAWING E1.06
 ADD: JUNCTION BOX AS REQUIRED FOR BUILDING SIGNAGE INDICATED ON ARCHITECTURAL DRAWING AS.02 ROUTE 3#10, 3/4" C FROM SIGNAGE TO L6-41. ROUTE THROUGH CONTACTOR C6C.

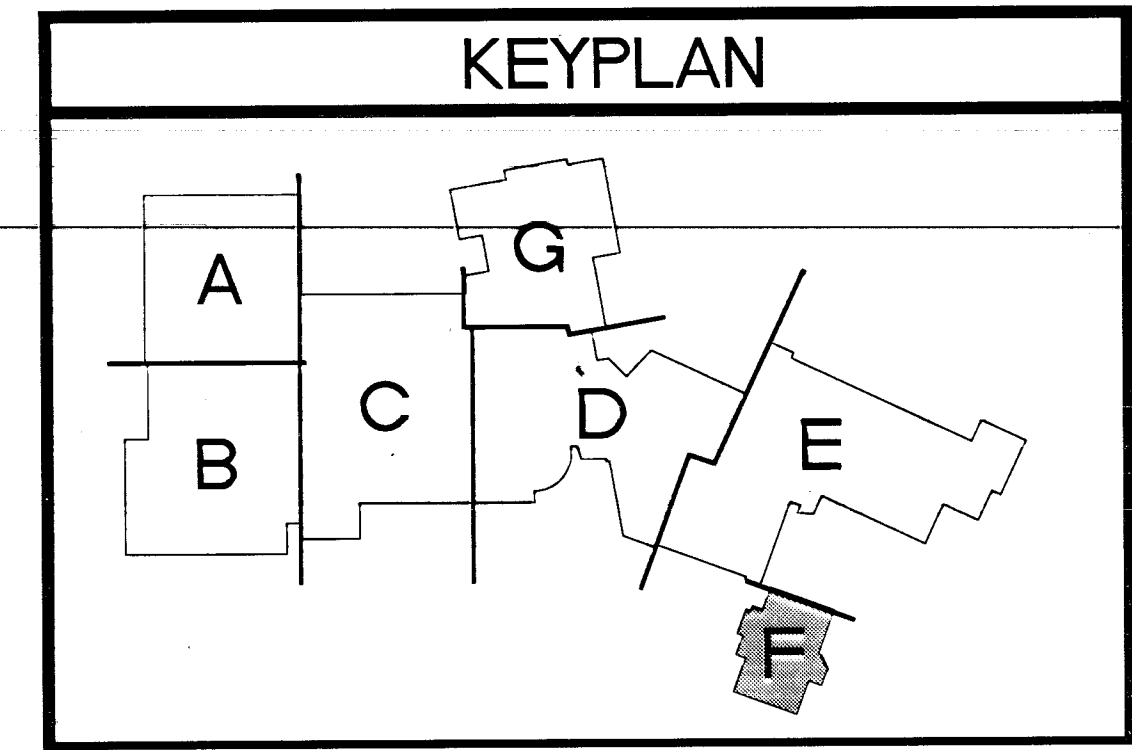

THESE RECORD DOCUMENTS HAVE BEEN PREPARED BASED ON INFORMATION PROVIDED BY OTHERS. THE DESIGN PROFESSIONAL HAS NOT VERIFIED THE ACCURACY AND/OR COMPLETENESS OF THIS INFORMATION AND SHALL NOT BE RESPONSIBLE FOR ANY ERRORS OR OMISSIONS WHICH MAY BE INCORPORATED HEREIN AS A RESULT.

<p>REVISIONS</p> <table border="1" style="width: 100%; border-collapse: collapse;"> <tr><td>NO.</td><td>DESCRIPTION</td><td>DATE</td></tr> <tr><td> </td><td> </td><td> </td></tr> <tr><td> </td><td> </td><td> </td></tr> <tr><td> </td><td> </td><td> </td></tr> </table>	NO.	DESCRIPTION	DATE										<p>CONSULTANT</p>	<p style="text-align: center;">LUCCHESI GALATI</p> <p style="text-align: center;">500 PILOT ROAD, SUITE A LAS VEGAS, NEVADA 89119 (702) 263-7111 FAX (702) 263-3111</p>
NO.	DESCRIPTION	DATE												
<p>CITY OF LAS VEGAS CENTENNIAL HILLS COMMUNITY CENTER RECORD DRAWINGS ELECTRICAL LIGHTING PLAN AREA F</p>														
<p>OWNER: CITY OF LAS VEGAS DEPARTMENT OF PUBLIC WORKS ARCHITECTURAL SERVICES</p>														
<p>400 EAST STEWART AVENUE LAS VEGAS, NEVADA 89101 PHONE: (702) 229-6535 FAX: (702) 229-4845 TDD: (702) 386-9108</p>														
<p>DATE: 03/26/05</p>	<p>SCALE: 05/534/01</p>	<p>CHECKED: 6/11/05</p>												
<p>E1.06</p>														

04 E1.06 TIF
 12-7-110