

ELECTRICAL POWER PLAN AREA D

SCALE: 1/8"=1'-0"


NOTES:

- ① RECP. UNDER COUNTER COORDINATE INSTALLATION WITH CABINERY.
- ② J-BOX FOR AUTOMATIC DOORS.
- ③ POWER (DOUBLE DUPLEX RECEPTACLE) TO THE SOUND SYSTEM. MOUNT IN UPPER CABINERY COORDINATE LOCATION WITH SOUND SYSTEM INSTALLER.
- ④ PROVIDE LOCKABLE COVERS SUITABLE FOR WET LOCATIONS WHILE IN USE.
- ⑤ PROVIDE TAMPER PROOF RECEPTACLES WITHIN THESE ROOMS.
- ⑥ COORDINATE LOCATION WITH OWNER REPRESENTATIVE.
- ⑦ SEE ONLINE DIAGRAM FOR FEEDER REQUIREMENTS.
- ⑧ SEE DRAWINGS E3.08 AND E3.09 FOR SECURITY CONDUIT REQUIREMENTS. PROVIDE FOR LOW VOLTAGE TRANSFORMER TO DOOR CONTACTS.
- ⑨ J-BOX FOR FLUSH VALVE AND SENSORS. COORDINATE INSTALLATIONS OF 3#12, 1/2" BETWEEN FLUSH VALVES AND SENSORS WITH MECHANICAL CONTRACTOR.
- ⑩ SEE SHEET E2.05 FOR CONTINUATION.
- ⑪ J-BOX FOR SECURITY GATE.
- ⑫ J-BOX FOR CONNECTION TO OWNER FURNITURE. INSTALL BASE FEED AFTER OWNER FURNITURE IS INSTALLED.
- ⑬ J-BOX FOR CONTROL POWER AT THE SKYLIGHT.
- ⑭ CONTROL STATION FOR SKYLIGHT LOUVER CONTROL.
- ⑮ J-BOX FOR HANDICAP CONTROLLER AND CARD READER. SEE E3.09 AND ARCHITECTURAL DRAWINGS FOR ADDITIONAL INFORMATION.
- ⑯ SEE ARCHITECTURAL DRAWINGS FOR ADDITIONAL INFORMATION.
- ⑰ J-BOX FOR ELECTRIC SENSOR AT SINK. COORDINATE INSTALLATION OF 3#12, 1/2" BETWEEN EACH SINK SENSOR WITH MECHANICAL CONTRACTOR.

GENERAL NOTES:

1. ALL WIRING AND CONDUIT SHALL BE CONCEALED WITHIN THE WALLS, INCLUDING BLOCK WALLS. COORDINATE CONDUIT INSTALLATION WITH OTHER TRADES PRIOR TO ROUGH-IN.
- REFER TO SPECIFICATIONS AND ARCHITECTURAL FINISH.
2. SCHEDULE FOR DEVICE COVERPLATE REQUIREMENTS.

THESE RECORD DOCUMENTS HAVE BEEN PREPARED BASED ON INFORMATION PROVIDED BY OTHERS. THE DESIGN PROFESSIONAL HAS NOT VERIFIED THE ACCURACY AND/OR COMPLETENESS OF THIS INFORMATION AND SHALL NOT BE RESPONSIBLE FOR ANY ERRORS OR OMISSIONS WHICH MAY BE INCORPORATED HEREIN AS A RESULT.

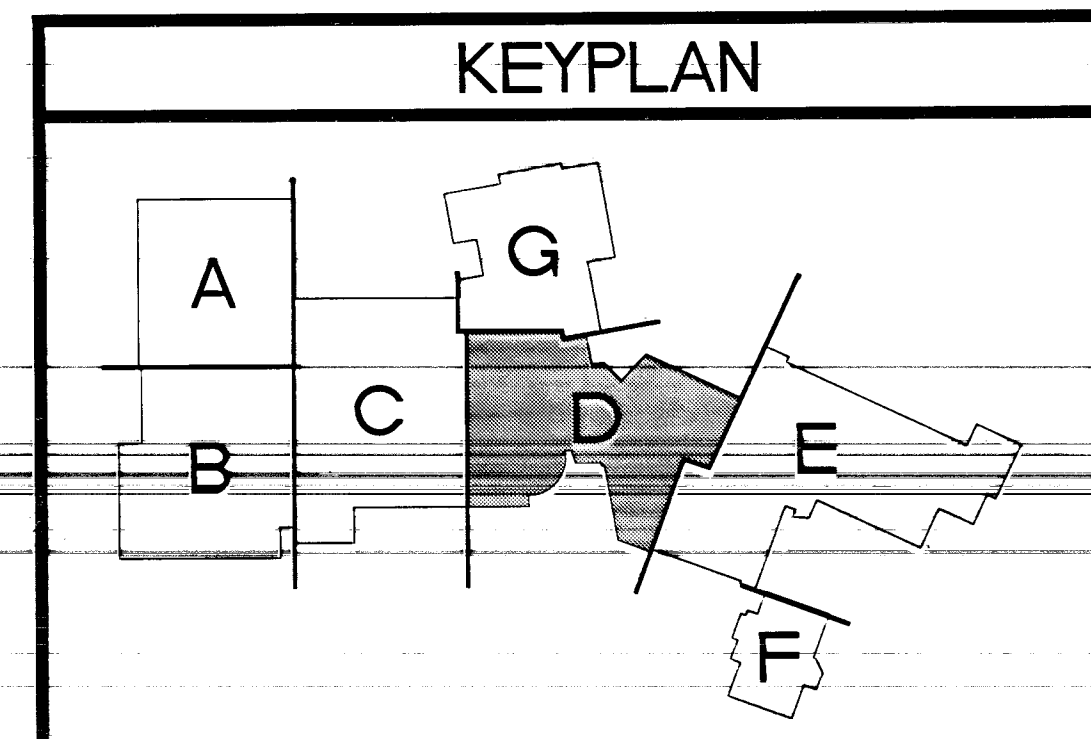

REVISIONS
 MICRO-DRAWING SUPPORT
 CONSULTANT
 500 PILOT ROAD, SUITE A
 LAS VEGAS, NEVADA 89119
 (702) 263-7111
 (702) 263-8111 FAX
LUCCHESI GALATI

Disclaimer: These record drawings prepared by Lucchesi Galati Architects, Inc., are based on information provided by the client and/or architects. The design professional has not verified the accuracy and/or completeness of this information and shall not be responsible for any errors or omissions, which may be incorporated herein as a result.

CITY OF LAS VEGAS
 CENTENNIAL HILLS COMMUNITY CENTER
 RECORD DRAWINGS
 ELECTRICAL POWER PLAN AREA D

OWNER: CITY OF LAS VEGAS
 DEPARTMENT OF PUBLIC WORKS
 ARCHITECTURAL SERVICES

400 EAST STEWART AVENUE
 LAS VEGAS, NEVADA 89101
 PHONE: (702) 258-8880
 FAX: (702) 258-8880
 TDD: (702) 258-8880

DATE	03/18/05
SCALE	05/324/01
CD NO.	67143
CLINING	
DATE	

E2.04

06/23/04 TIF
 127116