


ELECTRICAL POWER PLAN AREA E

SCALE: 1/8"=1'-0"

- NOTES:**
1. PROVIDE J-BOX FOR FUTURE CONNECTION TO ROLL UP DOORS. MINIMUM 1"Ø.
 2. SEE SWIMMING POOL DRAWINGS FOR ADDITIONAL 120V CONNECTIONS TO EQUIPMENT INCLUDING POOL LIGHTS, CONTROL EQUIPMENT, ETC.
 3. POWER (DOUBLE DUPLEX RECEPTACLE) TO THE SOUND SYSTEM. MOUNT IN UPPER CABINETRY. COORDINATE LOCATION WITH SOUND SYSTEM INSTALLER.
 4. SEE ONELINE DIAGRAM FOR FEEDER REQUIREMENTS.
 5. SWIMSUIT DRYER.
 6. SEE SHEET E2.04 FOR CONTINUATION.
 7. J-BOX FOR ELECTRIC FLUSH VALVES. COORDINATE INSTALLATION OF 3#12, 1/2" BETWEEN EACH FLUSH VALVE WITH MECHANICAL CONTRACTOR.
 8. MOUNT EQUIPMENT ON 4" HOUSEKEEPING PAD.
 9. PROVIDE LOCKABLE COVER SUITABLE FOR NET LOCATION WHILE IN USE.
 10. ROUTE 3#12, 1/2" TO INDOOR POOL EQUIPMENT. PROVIDE LATCHING MUSHROOM-TYPE-PUSH-BUTTON.

- GENERAL NOTES:**
1. ALL WIRING AND CONDUIT SHALL BE CONCEALED WITHIN THE WALLS, INCLUDING BLOCK WALLS. COORDINATE CONDUIT INSTALLATION WITH OTHER TRADES PRIOR TO ROUGH-IN.
 2. REFER TO SPECIFICATIONS AND ARCHITECTURAL FINISH SCHEDULE FOR DEVICE COVERPLATE REQUIREMENTS.

THESE RECORD DOCUMENTS HAVE BEEN PREPARED BASED ON INFORMATION PROVIDED BY OTHERS. THE DESIGN PROFESSIONAL HAS NOT VERIFIED THE ACCURACY AND/OR COMPLETENESS OF THIS INFORMATION AND SHALL NOT BE RESPONSIBLE FOR ANY ERRORS OR OMISSIONS WHICH MAY BE INCORPORATED HEREIN AS A RESULT.

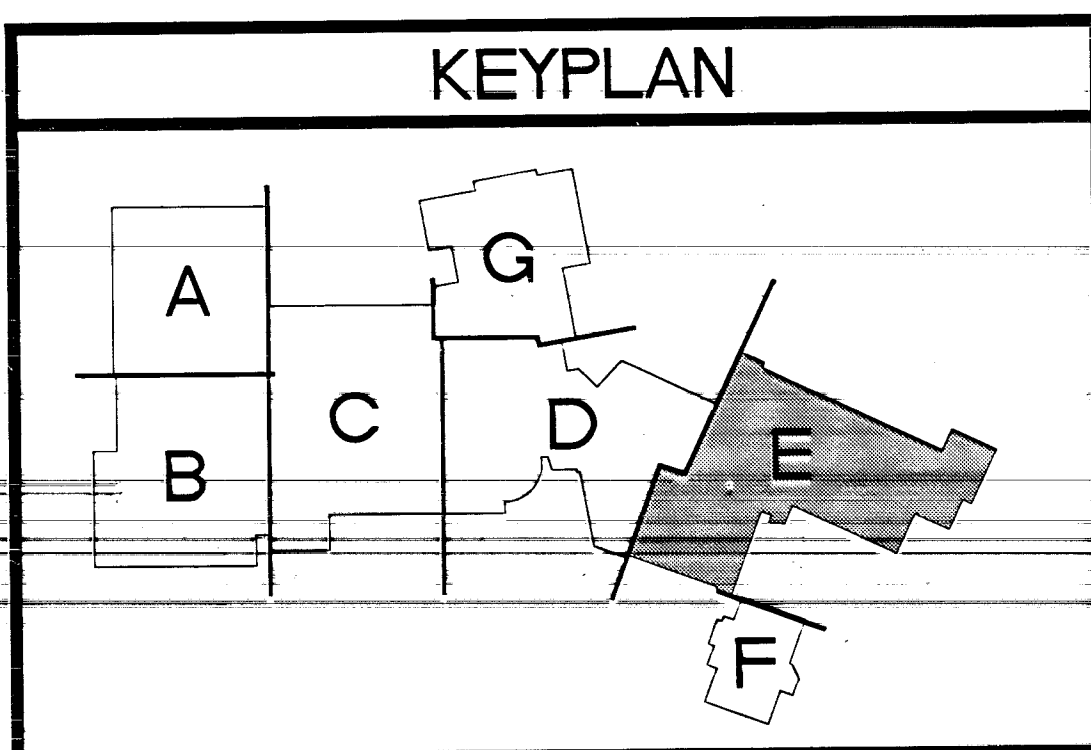

RECORDS/REVISED/DATE

CONTRACT

300 PILOT ROAD, SUITE A
LAS VEGAS, NEVADA 89119
(702) 263-7111 FAX
(702) 263-8111

LUCCHESI GALATI

Disclaimer: These record drawings prepared by Lucchesi Galati Architects, Inc. are based on information provided by others. Lucchesi Galati Architects, Inc. has not verified the accuracy and/or completeness of its information supplied by others, and shall not be responsible for any errors or omissions, which may be incorporated herein as a result.

CITY OF LAS VEGAS
CENTENNIAL HILLS COMMUNITY CENTER
RECORD DRAWINGS
ELECTRICAL POWER PLAN AREA E

OWNER: CITY OF LAS VEGAS
DEPARTMENT OF PUBLIC WORKS
ARCHITECTURAL SERVICES

400 EAST STEWART AVENUE
LAS VEGAS, NEVADA 89101
PHONE: (702) 228-8031
FAX: (702) 228-8848
TDD: (702) 228-8108

DATE: 05/20/05

SCALE: 05.534101

CITY NO: 671-49

E2.05

060 E2.05.TIF