



**ELECTRICAL POWER PLAN AREA G**

SCALE: 1/8"=1'-0"


**NOTES:**

- 1 RECEPTACLE UNDER CASEWORK.
- 2 PROVIDE J-BOX FOR CONNECTION TO FUTURE ROLL-UP DOORS.
- 3 LOW VOLTAGE TRANSFORMER FOR THE SPEAKER SYSTEM. MOUNT IN ACCESSIBLE SPACE ABOVE CEILING.
- 4 J-BOX FOR POWERED DOORS. (NIC)
- 5 J-BOX FOR MOTORIZED DIVIDER.
- 6 J-BOX FOR MOTORIZED SCREEN.
- 7 J-BOX FOR FAN, SUITABLE FOR 50 LBS. COORDINATE LOCATION WITH ARCHITECTURAL DRAWINGS.
- 8 J-BOX FOR ELECTRIC FLUSH VALVE AND SENSORS. COORDINATE INSTALLATION OF 3/12, 1/2" C BETWEEN EACH FLUSH VALVE AND SENSORS WITH MECHANICAL CONTRACTOR.
- 9 PROVIDE LOCKABLE COVER SUITABLE FOR WET LOCATION WHILE IN USE.

**GENERAL NOTES:**

1. ALL WIRING AND CONDUIT SHALL BE CONCEALED WITHIN THE WALLS, INCLUDING BLOCK WALLS. COORDINATE CONDUIT INSTALLATION WITH OTHER TRADES PRIOR TO ROUGH-IN.
2. REFER TO SPECIFICATIONS AND ARCHITECTURAL FINISH SCHEDULE FOR DEVICE COVERPLATE REQUIREMENTS.

THESE RECORD DOCUMENTS HAVE BEEN PREPARED BASED ON INFORMATION PROVIDED BY OTHERS. THE DESIGN PROFESSIONAL HAS NOT VERIFIED THE ACCURACY AND/OR COMPLETENESS OF THIS INFORMATION AND SHALL NOT BE RESPONSIBLE FOR ANY ERRORS OR OMISSIONS WHICH MAY BE INCORPORATED HEREIN AS A RESULT.

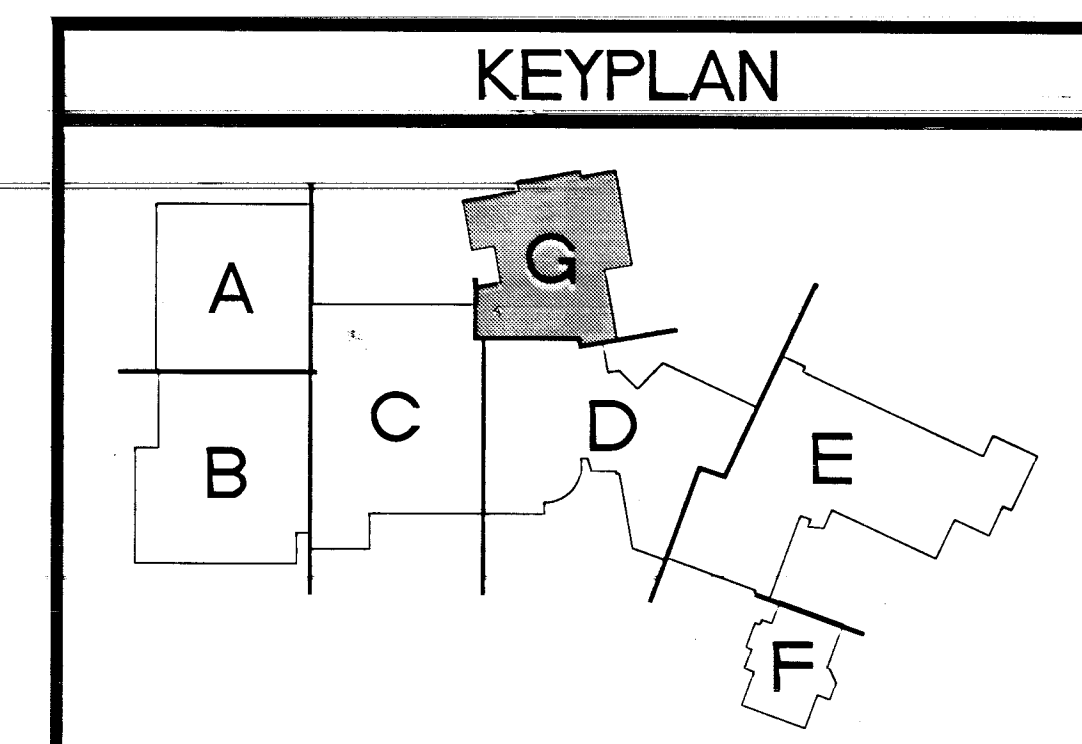

REVISIONS  
RECORD DRAWING 10/20/07

CONSULTANT

985 WEST FLAVIN BLVD  
LAS VEGAS, NEVADA 89109  
(702) 883-7111  
(702) 883-8111 FAX

**LUCCHESI GALATI**

Disclaimer: These record drawings prepared by Lucchesi Galati Architects, Inc., are based on information provided by others. Lucchesi Galati Architects, Inc. has not verified the accuracy and/or completeness of this information supplied by others, and shall not be responsible for any errors or omissions, which may be incorporated herein as a result.

**CITY OF LAS VEGAS  
CENTENNIAL HILLS COMMUNITY CENTER  
RECORD DRAWINGS  
ELECTRICAL POWER PLAN AREA G**

OWNER: CITY OF LAS VEGAS  
DEPARTMENT OF PUBLIC WORKS  
ARCHITECTURAL SERVICES

400 EAST STEWART AVENUE LAS VEGAS, NEVADA 89103 PHONE: (702) 229-8228 FAX: (702) 229-8840 TDD: (702) 229-8108
DATE: 03/16/05
NO: 05153410
REVISED: 6/11/05
<b>E2.07</b>

12719