

ELECTRICAL COMMUNICATION PLAN AREA D

SCALE: 1/8"=1'-0"

NOTES:


- ① J-BOX FOR SPEAKER INTERFACE.
- ② VERIFY HEIGHT OF TV OUTLET WITH OWNER REPRESENTATIVE COORDINATE ASSOCIATED TV DUPLEX RECEPTACLE HEIGHT.
- ③ J-BOX FOR OWNER FURNISHED FURNITURE. INSTALL BASE FEED AFTER FURNITURE IS INSTALLED.
- ④ ROUTE TO IT ROOM 446. MINIMUM 1" UNO. SEE DETAIL 3/E4.01 FOR ADDITIONAL INFORMATION U.N.O.
- ⑤ ROUTE 1" TO NEAREST AUX. TELEPHONE ROOM THAT IS ACCESSIBLE WITHOUT CROSSING THE CIRCULATION CORRIDOR. SEE DETAIL 3/E4.01 FOR ADDITIONAL INFORMATION.
- ⑥ PROVIDE 3/4" FIRE TREATED PLYWOOD BACKBOARD ON ALL WALLS, 8" HIGH.

- ⑦ SEE DETAIL 1/E4.04 FOR TV CONDUIT INFORMATION.
- ⑧ SEE DRAWING E3.03 FOR CONTINUATION.
- ⑨ ROUTE CABLE A, 3/4" TO CLOCK/INTERCOM CABINET IN ROOM 403.
- ⑩ ROUTE CABLE B, 3/4" TO CLOCK/INTERCOM CABINET POWER SUPPLY IN ROOM 403.
- ⑪ SEE DRAWING E3.05 FOR CONTINUATION.
- ⑫ SOUND SYSTEM EQUIPMENT MOUNTED IN CABINETRY. COORDINATE LOCATION OF CONDUIT ENTRANCES WITH ARCHITECTURAL ELEVATIONS.

GENERAL NOTES:

- 1. ALL CONDUIT IS 3/4" MIN. UNO.
- 2. CONTRACTOR MAY COMBINE ALL TYPE A HOMERUNS.
- 3. MOUNT ALL EXPOSED CONDUIT ALONG CEILING SNUG TO BOTTOM OF STRUCTURE.
- 4. SURFACE MOUNTED CONDUITS ARE NOT ACCEPTABLE. ALL CONDUITS ARE TO BE CONCEALED WITHIN WALLS OR BELOW GRADE.
- 5. ALL WIRING AND CONDUIT SHALL BE CONCEALED WITHIN THE WALLS, INCLUDING BLOCK WALLS. COORDINATE CONDUIT INSTALLATION WITH OTHER TRADES PRIOR TO ROUGH-IN.
- 6. REFER TO SPECIFICATIONS AND ARCHITECTURAL FINISH SCHEDULE FOR DEVICE COVERPLATE REQUIREMENTS.
- 7. SEE SPECIFICATION 18710. PROVIDE SCALED DRAWINGS DRAWING PER SUBMITTAL REQUIREMENTS. PROVIDE MINIMUM 20% GROWTH FOR ALL IT ROOMS.

THESE RECORD DOCUMENTS HAVE BEEN PREPARED BASED ON INFORMATION PROVIDED BY OTHERS. THE DESIGN PROFESSIONAL HAS NOT VERIFIED THE ACCURACY AND/OR COMPLETENESS OF THIS INFORMATION AND SHALL NOT BE RESPONSIBLE FOR ANY ERRORS OR OMISSIONS WHICH MAY BE INCORPORATED HEREIN AS A RESULT.

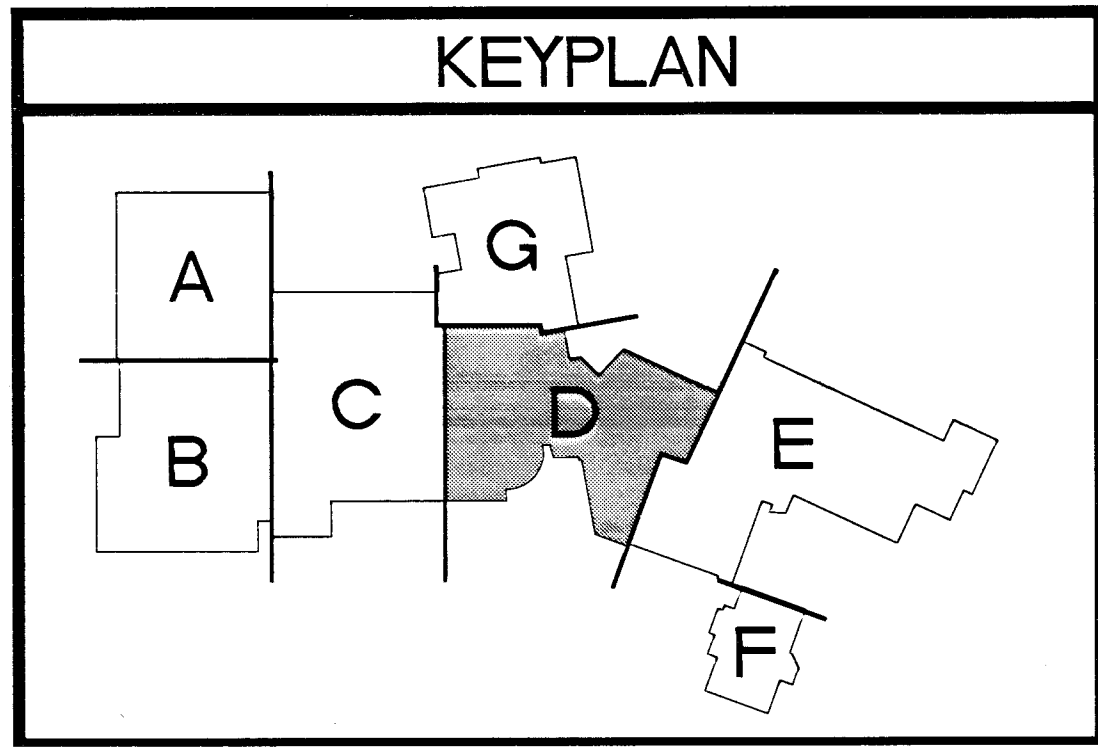

REVISIONS	RECORD DRAWINGS 1/20/22
CONSULTANT	
OWNER	CITY OF LAS VEGAS
DEPARTMENT	DEPARTMENT OF PUBLIC WORKS
ARCHITECTURAL SERVICES	ARCHITECTURAL SERVICES
400 EAST STEWART AVENUE LAS VEGAS, NEVADA 89101 PHONE: (702) 228-8534 FAX: (702) 264-8848 TDD: (702) 386-9308	
DATE	03/28/22
SCALE	
NO.	03 E3.04.01
REVISED BY	671-43
DATE	
NO.	E3.04

300 PLOT ROAD, SUITE A
LAS VEGAS, NEVADA 89109
702 263-7111
702 263-8111 FAX

LUCCHESI
-GALATI-

Disclaimer: These record drawings prepared by Lucchese Galati Architects, Inc., are based on information provided by others. Lucchese Galati Architects, Inc. has not verified the accuracy and/or completeness of this information and shall not be responsible for any errors or omissions, which may be incorporated herein as a result.

**CITY OF LAS VEGAS
CENTENNIAL HILLS COMMUNITY CENTER
RECORD DRAWINGS
ELECTRICAL COMMUNICATION PLAN AREA D**

057 E3.04.TIF
12/7/24