

1 NURSE CALL DIAGRAM
E3.07 SCALE: NONE

NURSE CALL LEGEND

- CALL CORD (DUKANE CAT # 9A2205) PROVIDE WITH 8' CORD
- DOME LIGHT - WALL MOUNT (DUKANE CAT # 18A521)
- NURSE CALL CENTRAL EQUIPMENT - FLUSH MOUNT AT 48\"/>

NURSE CALL CABLE LEGEND

- A 54 CONDUCTOR CABLE - DUKANE CAT # 176-238
- B 6 CONDUCTOR CABLE - DUKANE CAT # 176-186
- C 3 CONDUCTOR CABLE - DUKANE CAT # 176-184
- D 20 AWG CU CONDUCTOR

ELECTRICAL COMMUNICATION PLAN AREA G

SCALE: 1/8"=1'-0"


NOTES:

- 1 J-BOX FOR SPEAKER INTERFACE.
- 2 ROUTE 1" C TO NEAREST AUX. TELEPHONE ROOM THAT IS ACCESSIBLE WITHOUT CROSSING THE CIRCULATION CORRIDOR.
- 3 SEE DRAWING E3.03 FOR CONTINUATION.
- 4 ROUTE CABLE B, 3/4" C TO CLOCK/INTERCOM CABINET POWER SUPPLY IN ROOM 403.
- 5 ROUTE CABLE B, 3/4" C TO CLOCK/INTERCOM CABINET POWER SUPPLY IN ROOM 403.
- 6 SOUND SYSTEM EQUIPMENT MOUNTED IN CABINETS. COORDINATE LOCATION OF CONDUIT ENTRANCES WITH ARCHITECTURAL ELEVATIONS.
- 7 SEE DETAIL 1/E4.04 FOR TV RISER DIAGRAM AND CONDUIT INFORMATION.
- 8 SEE DETAIL 1/E3.07 FOR FEEDER INFORMATION.

GENERAL NOTES:

1. ALL CONDUIT IS 3/4" MIN. UNO.
2. CONTRACTOR MAY COMBINE ALL TYPE A HOMERUNS.
3. MOUNT ALL EXPOSED CONDUIT ALONG CEILING SNUG TO BOTTOM OF STRUCTURE.
4. SURFACE MOUNTED CONDUITS ARE NOT ACCEPTABLE. ALL CONDUITS ARE TO BE CONCEALED WITHIN WALLS OR BELOW GRADE.
5. ALL WIRING AND CONDUIT SHALL BE CONCEALED WITHIN THE WALLS, INCLUDING BLOCK WALLS. COORDINATE CONDUIT INSTALLATION WITH OTHER TRADES PRIOR TO ROUGH-IN.
6. REFER TO SPECIFICATIONS AND ARCHITECTURAL FINISH SCHEDULE FOR DEVICE COVERPLATE REQUIREMENTS.

THESE RECORD DOCUMENTS HAVE BEEN PREPARED BASED ON INFORMATION PROVIDED BY OTHERS. THE DESIGN PROFESSIONAL HAS NOT VERIFIED THE ACCURACY AND/OR COMPLETENESS OF THIS INFORMATION AND SHALL NOT BE RESPONSIBLE FOR ANY ERRORS OR OMISSIONS WHICH MAY BE INCORPORATED HEREIN AS A RESULT.

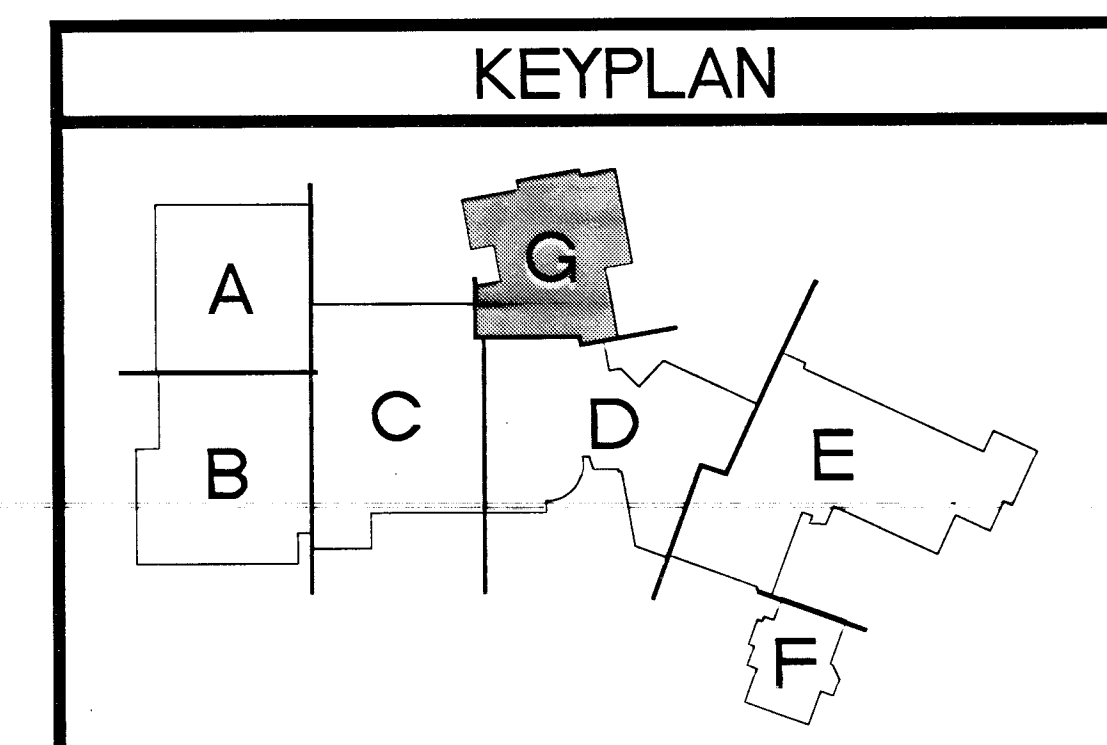

REVISIONS

CONSULTANT

500 PLOTT ROAD, SUITE A
LAS VEGAS, NEVADA 89119
(702) 263-7111
(702) 263-8111 FAX

LUCCHESI GALATI

Disclaimer: These record drawings prepared by Lucchesi Galati Architects, Inc., are based on information provided by others. Lucchesi Galati Architects, Inc. has not verified the accuracy and/or completeness of its information supplied by others, and shall not be responsible for any errors or omissions, which may be incorporated herein as a result.

CITY OF LAS VEGAS
CENTENNIAL HILLS COMMUNITY CENTER
RECORD DRAWINGS
ELECTRICAL COMMUNICATION PLAN AREA G

OWNER: CITY OF LAS VEGAS
DEPARTMENT OF PUBLIC WORKS
ARCHITECTURAL SERVICES

400 EAST STEWART AVENUE
LAS VEGAS, NEVADA 89101
PHONE: (702) 229-8335
FAX: (702) 384-8845
TDD: (702) 386-9109

DATE: 03/28/05
SCALE: 05.534101
CLV: 611-49

E3.07

090 E3.07 TH