


**ELECTRICAL SECURITY PLAN - AREAS D, E, F, G**

SCALE: 1/16"=1'-0"

- NOTES:**
- ① PROVIDE J-BOX ABOVE CEILING FOR FUTURE CAMERA.
  - ② PROVIDE J-BOX AT RECEPTION COUNTER (+18") FOR FUTURE CAMERA EQUIPMENT.
  - ③ COORDINATE INSTALLATION OF CARD READER WITH HANDICAP DOOR OPERATOR.

- GENERAL NOTES:**
1. ALL CONDUIT IS 3/4" MIN. UNO.
  2. CONTRACTOR MAY COMBINE ALL TYPE A HOMERUNS.
  3. MOUNT ALL EXPOSED CONDUIT ALONG CEILING SNUG TO BOTTOM OF STRUCTURE.
  4. SURFACE MOUNTED CONDUITS ARE NOT ACCEPTABLE. ALL CONDUITS ARE TO BE CONCEALED WITHIN WALLS OR BELOW GRADE.
  5. ALL WIRING AND CONDUIT SHALL BE CONCEALED WITHIN THE WALLS, INCLUDING BLOCK WALLS. COORDINATE CONDUIT INSTALLATION WITH OTHER TRADES PRIOR TO ROUGH-IN.
  6. REFER TO SPECIFICATIONS AND ARCHITECTURAL FINISH SCHEDULE FOR DEVICE COVERPLATE REQUIREMENTS.

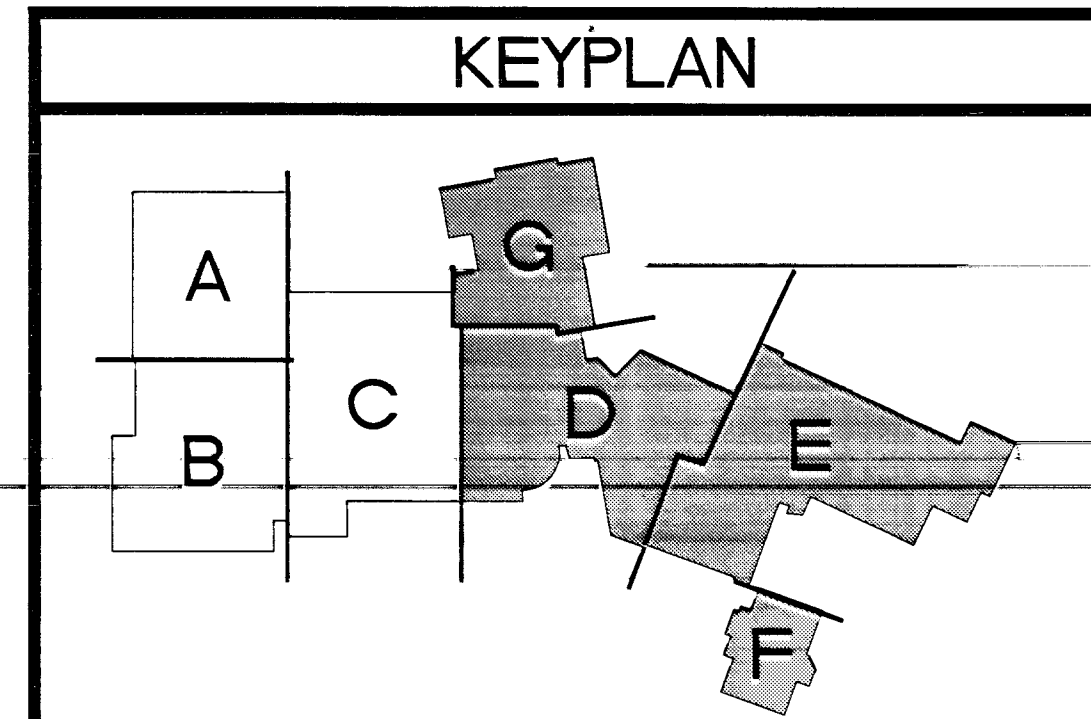

THESE RECORD DOCUMENTS HAVE BEEN PREPARED BASED ON INFORMATION PROVIDED BY OTHERS. THE DESIGN PROFESSIONAL HAS NOT VERIFIED THE ACCURACY AND/OR COMPLETENESS OF THIS INFORMATION AND SHALL NOT BE RESPONSIBLE FOR ANY ERRORS OR OMISSIONS WHICH MAY BE INCORPORATED HEREIN AS A RESULT.

<p>OWNER: CITY OF LAS VEGAS DEPARTMENT OF PUBLIC WORKS ARCHITECTURAL SERVICES</p> <p>400 EAST STEWART AVENUE LAS VEGAS, NEVADA 89101 PHONE: (702) 229-5555 FAX: (702) 386-9555 TDD: (702) 386-9108</p> <p>DRAWN: [ ] FILE: [ ] DATE: 03/05 SCALE: [ ] REV NO: 05.153410 CIVIL NO: 671-43</p> <p style="text-align: right; font-size: 1.2em; font-weight: bold;">E3.09</p>	<p style="text-align: center; font-weight: bold;">CITY OF LAS VEGAS CENTENNIAL HILLS COMMUNITY CENTER RECORD DRAWING ELECTRICAL SECURITY PLAN - AREAS D, E, F, G</p> <p style="text-align: center; font-weight: bold;">LUCCHESI •GALATI•</p> <p style="text-align: center; font-size: 0.8em;">505 WEST KEAY SUITE A LAS VEGAS, NEVADA 89109 (702) 263-2711 FAX (702) 263-8111 FAX</p> <p style="font-size: 0.7em;">Disclaimer: These record drawings prepared by Lucchesi Galati Architects, Inc., are based on information provided by others. Lucchesi Galati Architects, Inc. has not verified the accuracy and/or completeness of its information supplied by others, and shall not be responsible for any errors or omissions, which may be incorporated herein as a result.</p> <p style="font-size: 0.6em;">DRAWING AND SPECIFICATIONS ARE THE PROPERTY OF THE DESIGN PROFESSIONAL. WHOLE OR IN PART WITHOUT WRITTEN CONSENT IS STRICTLY PROHIBITED. COPIES OF THE DRAWING AND SPECIFICATIONS RETAINED BY THE CLIENT MAY BE UTILIZED ONLY FOR OCCUPANCY OF THE PROJECT FOR WHICH THEY WERE PREPARED AND NOT FOR THE CONSTRUCTION OF ANY OTHER PROJECT. N. A. C. 833.780</p>
---	--

051E3.09.TF  
127123