




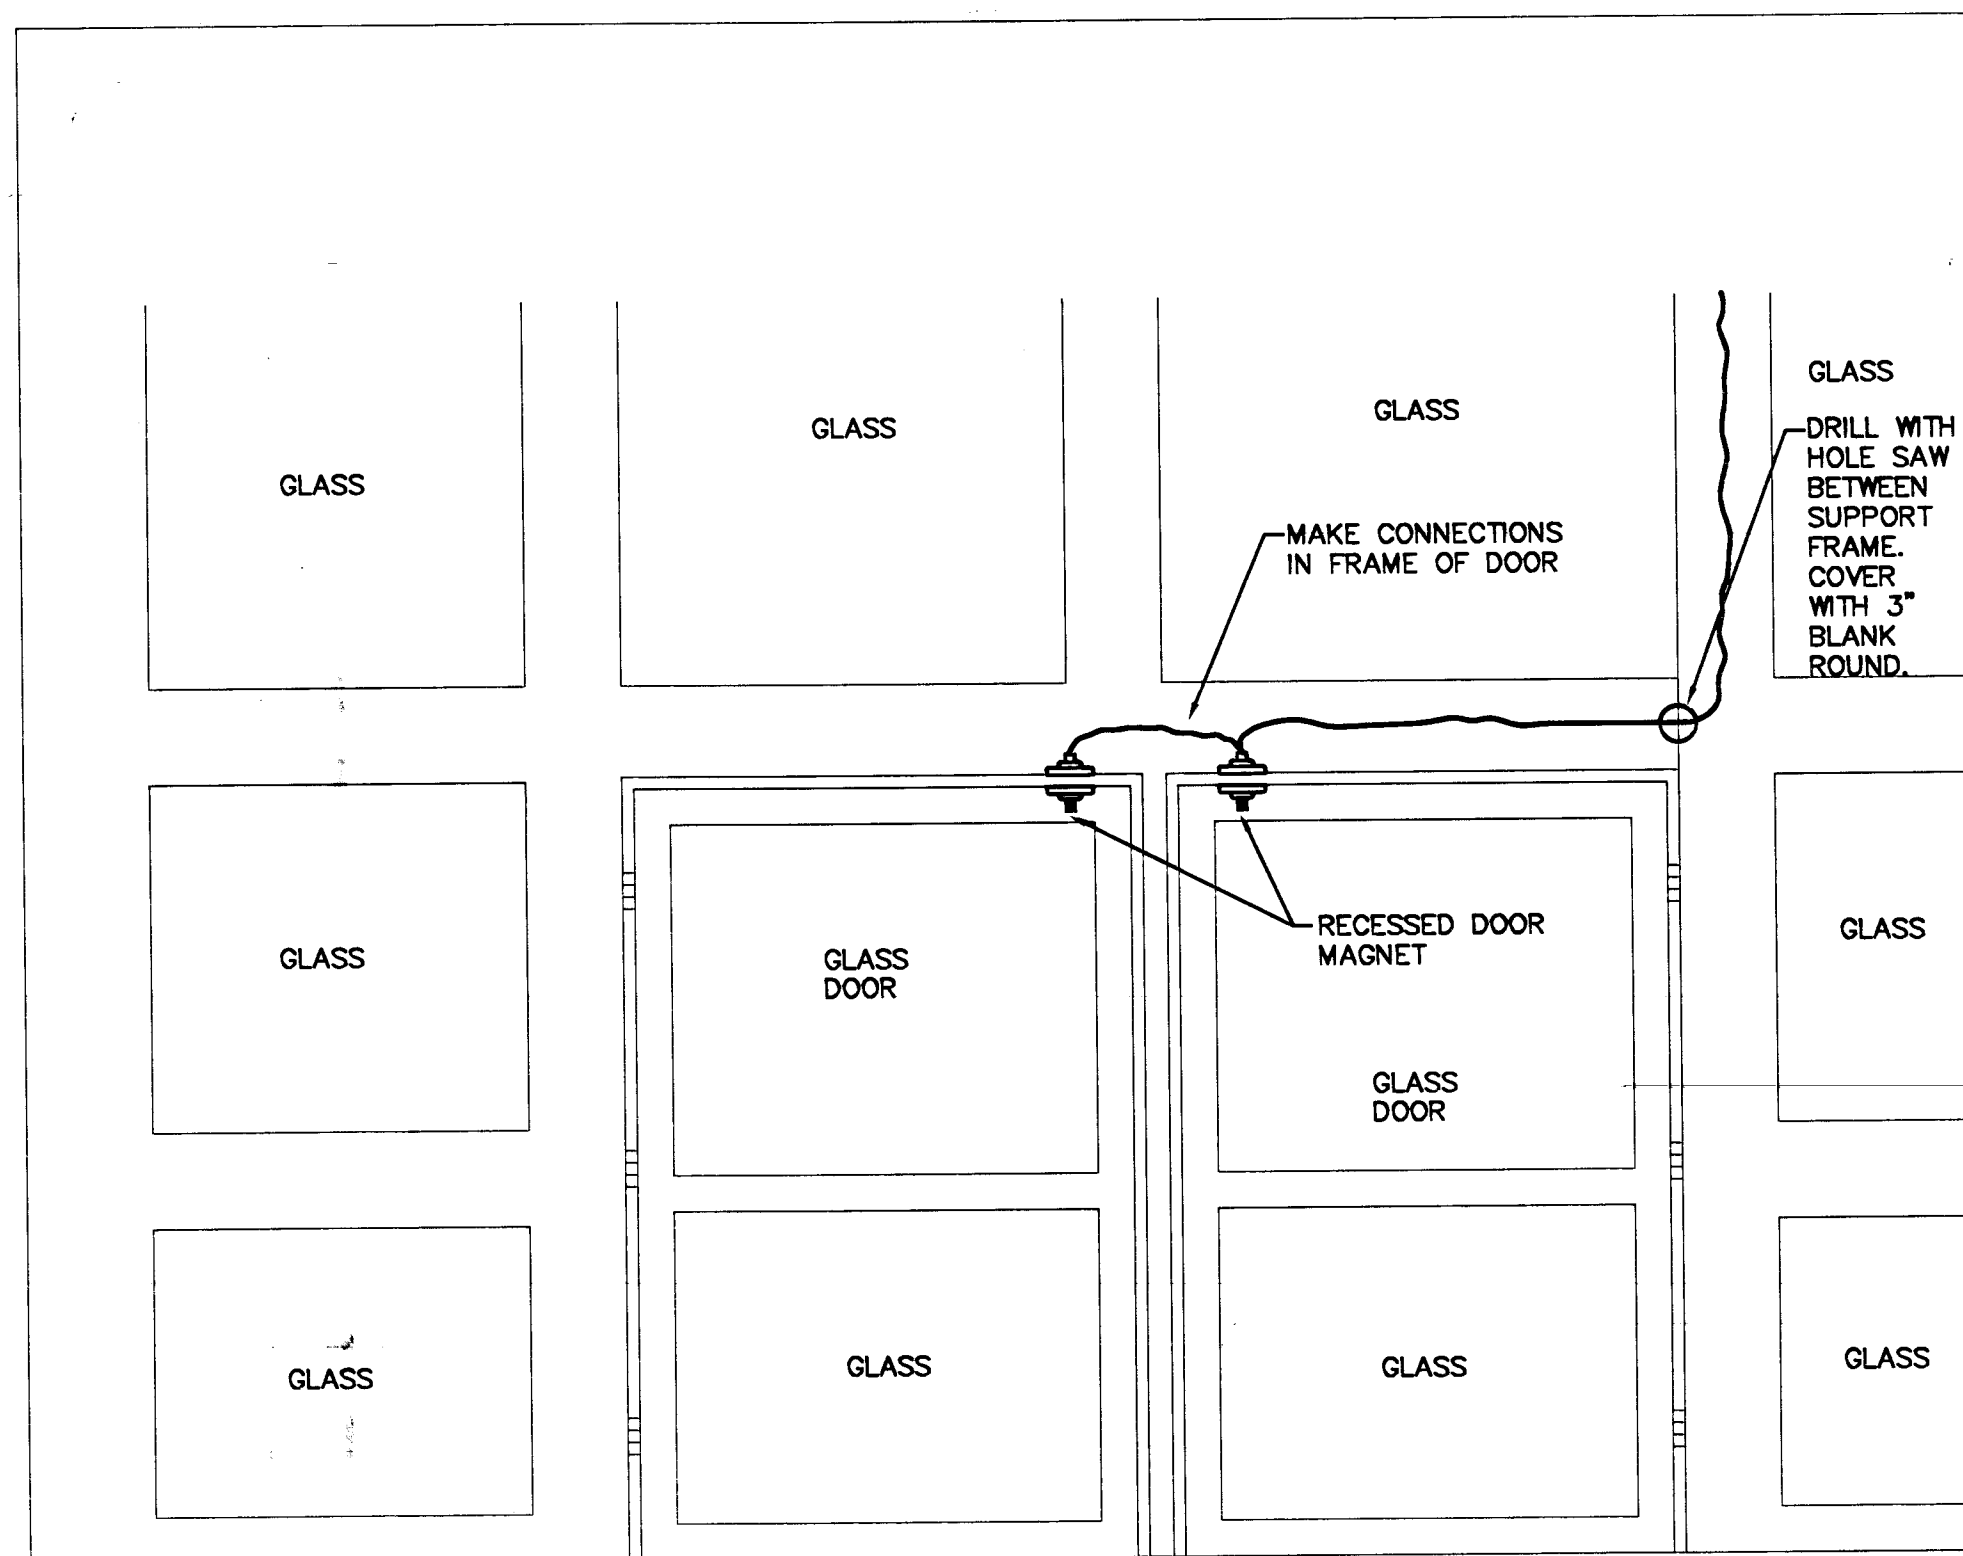


**1 DOUBLE DOOR ILLUSTRATION**  
E4.02 NOT TO SCALE

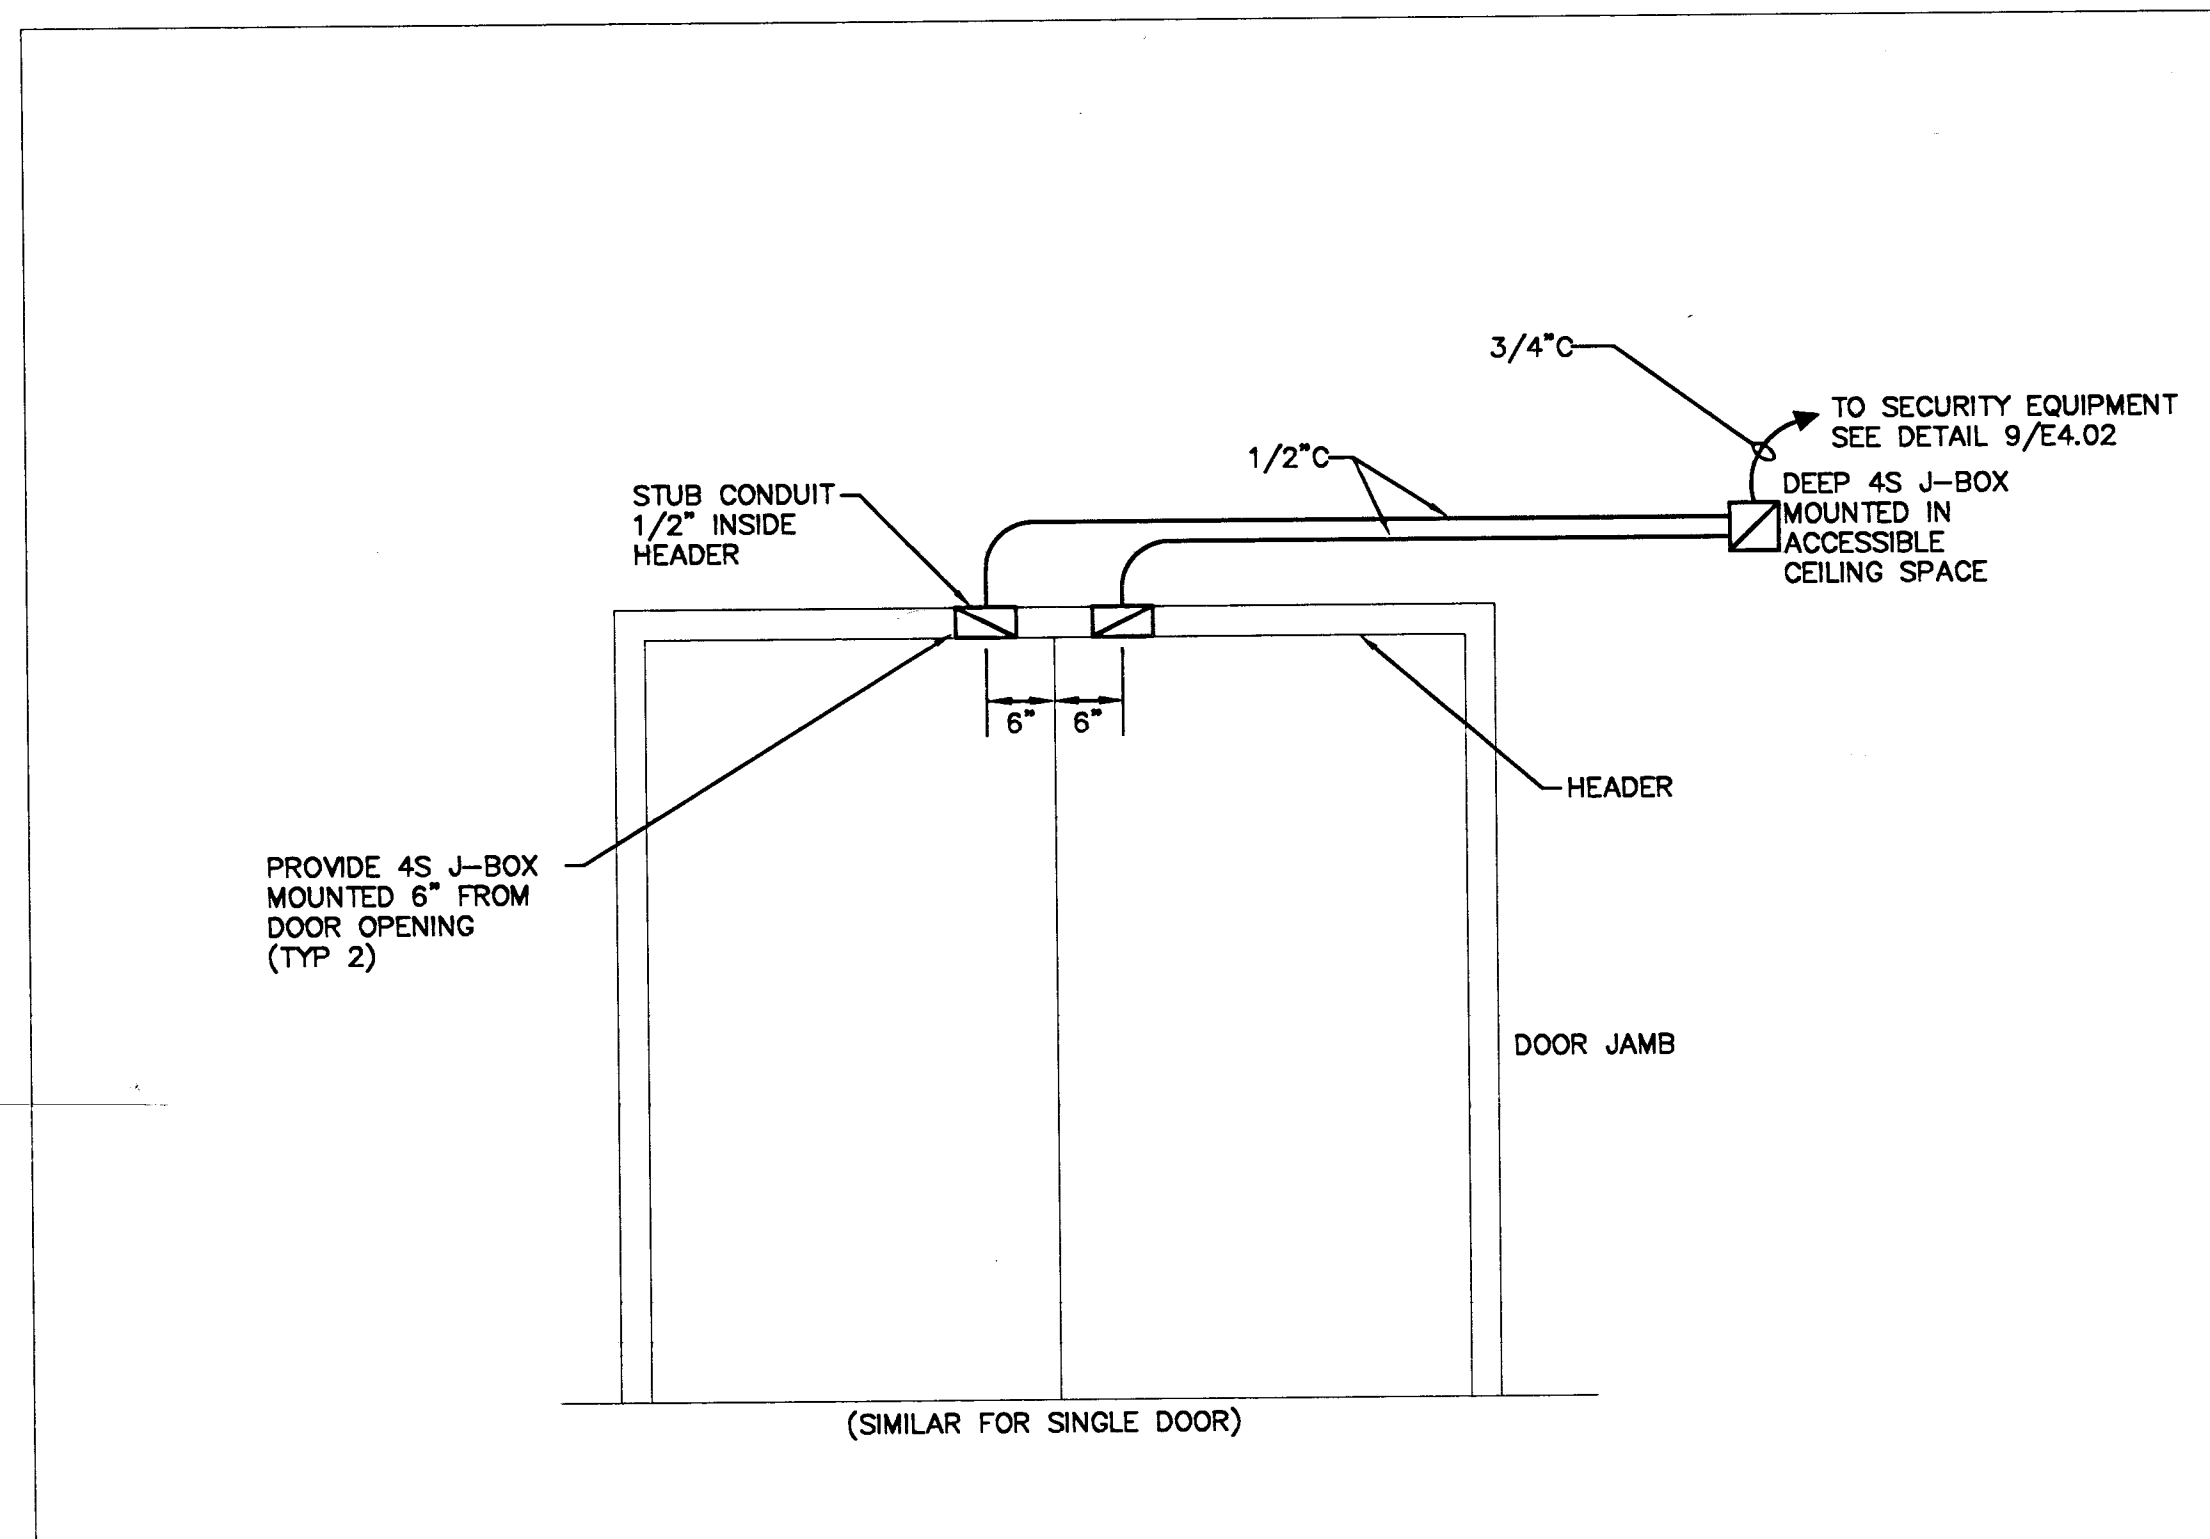


**2 SECURITY SYSTEM CONDUIT DIAGRAM**  
E4.02 NOT TO SCALE

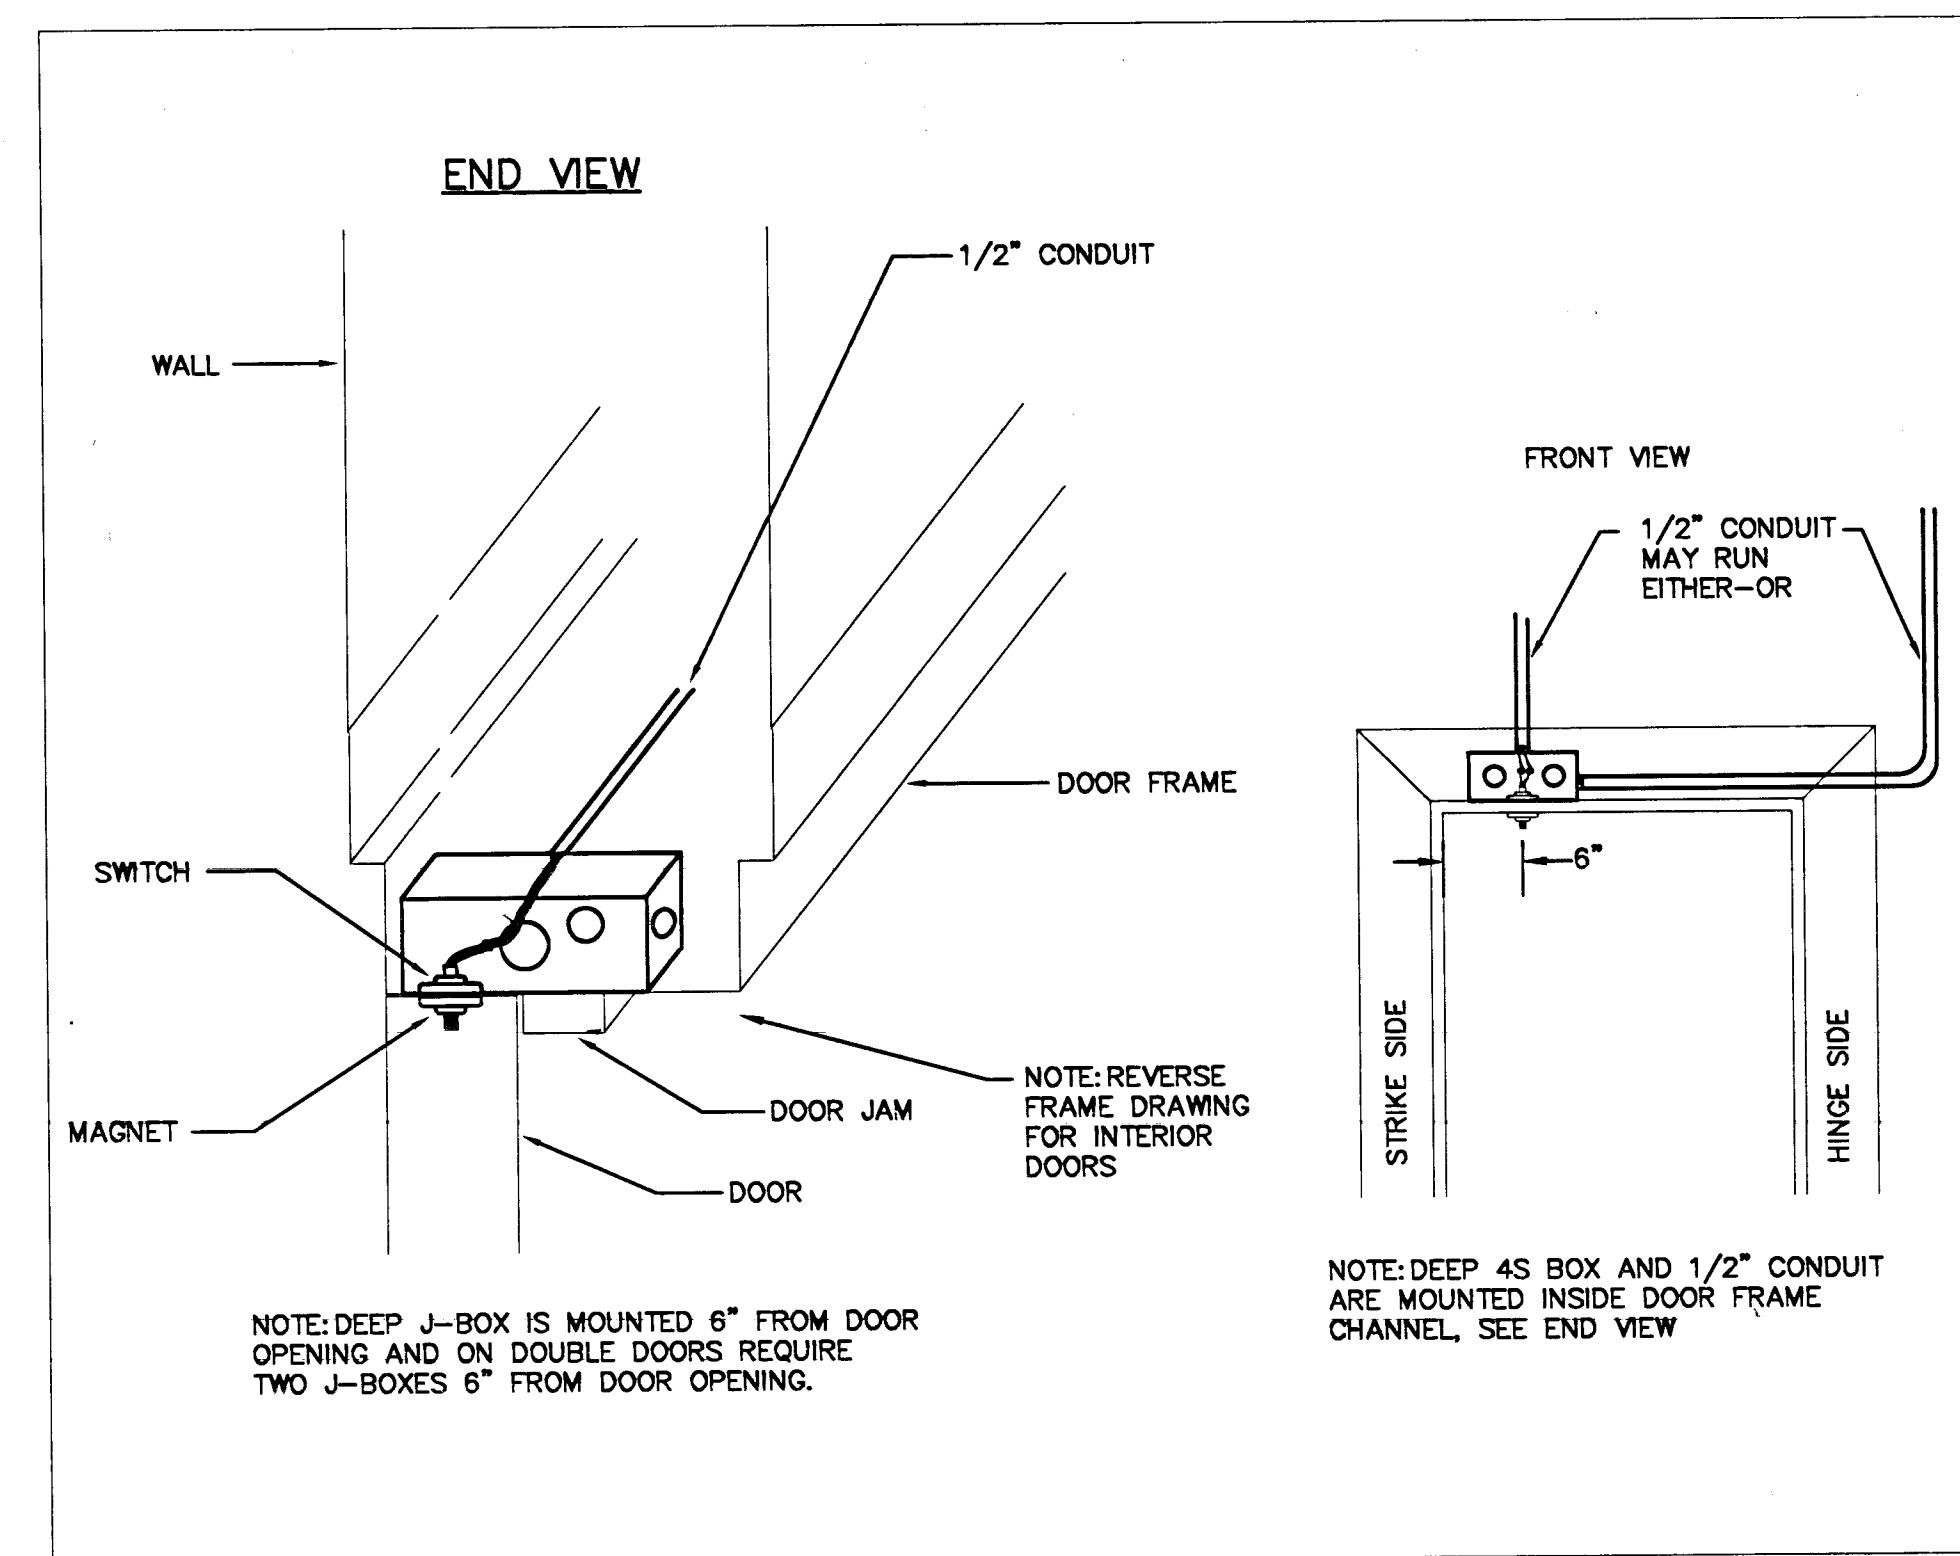

**3 EXTERIOR DOOR FRAME 4S BOX AND PIPE POSITION**  
E4.02 NOT TO SCALE

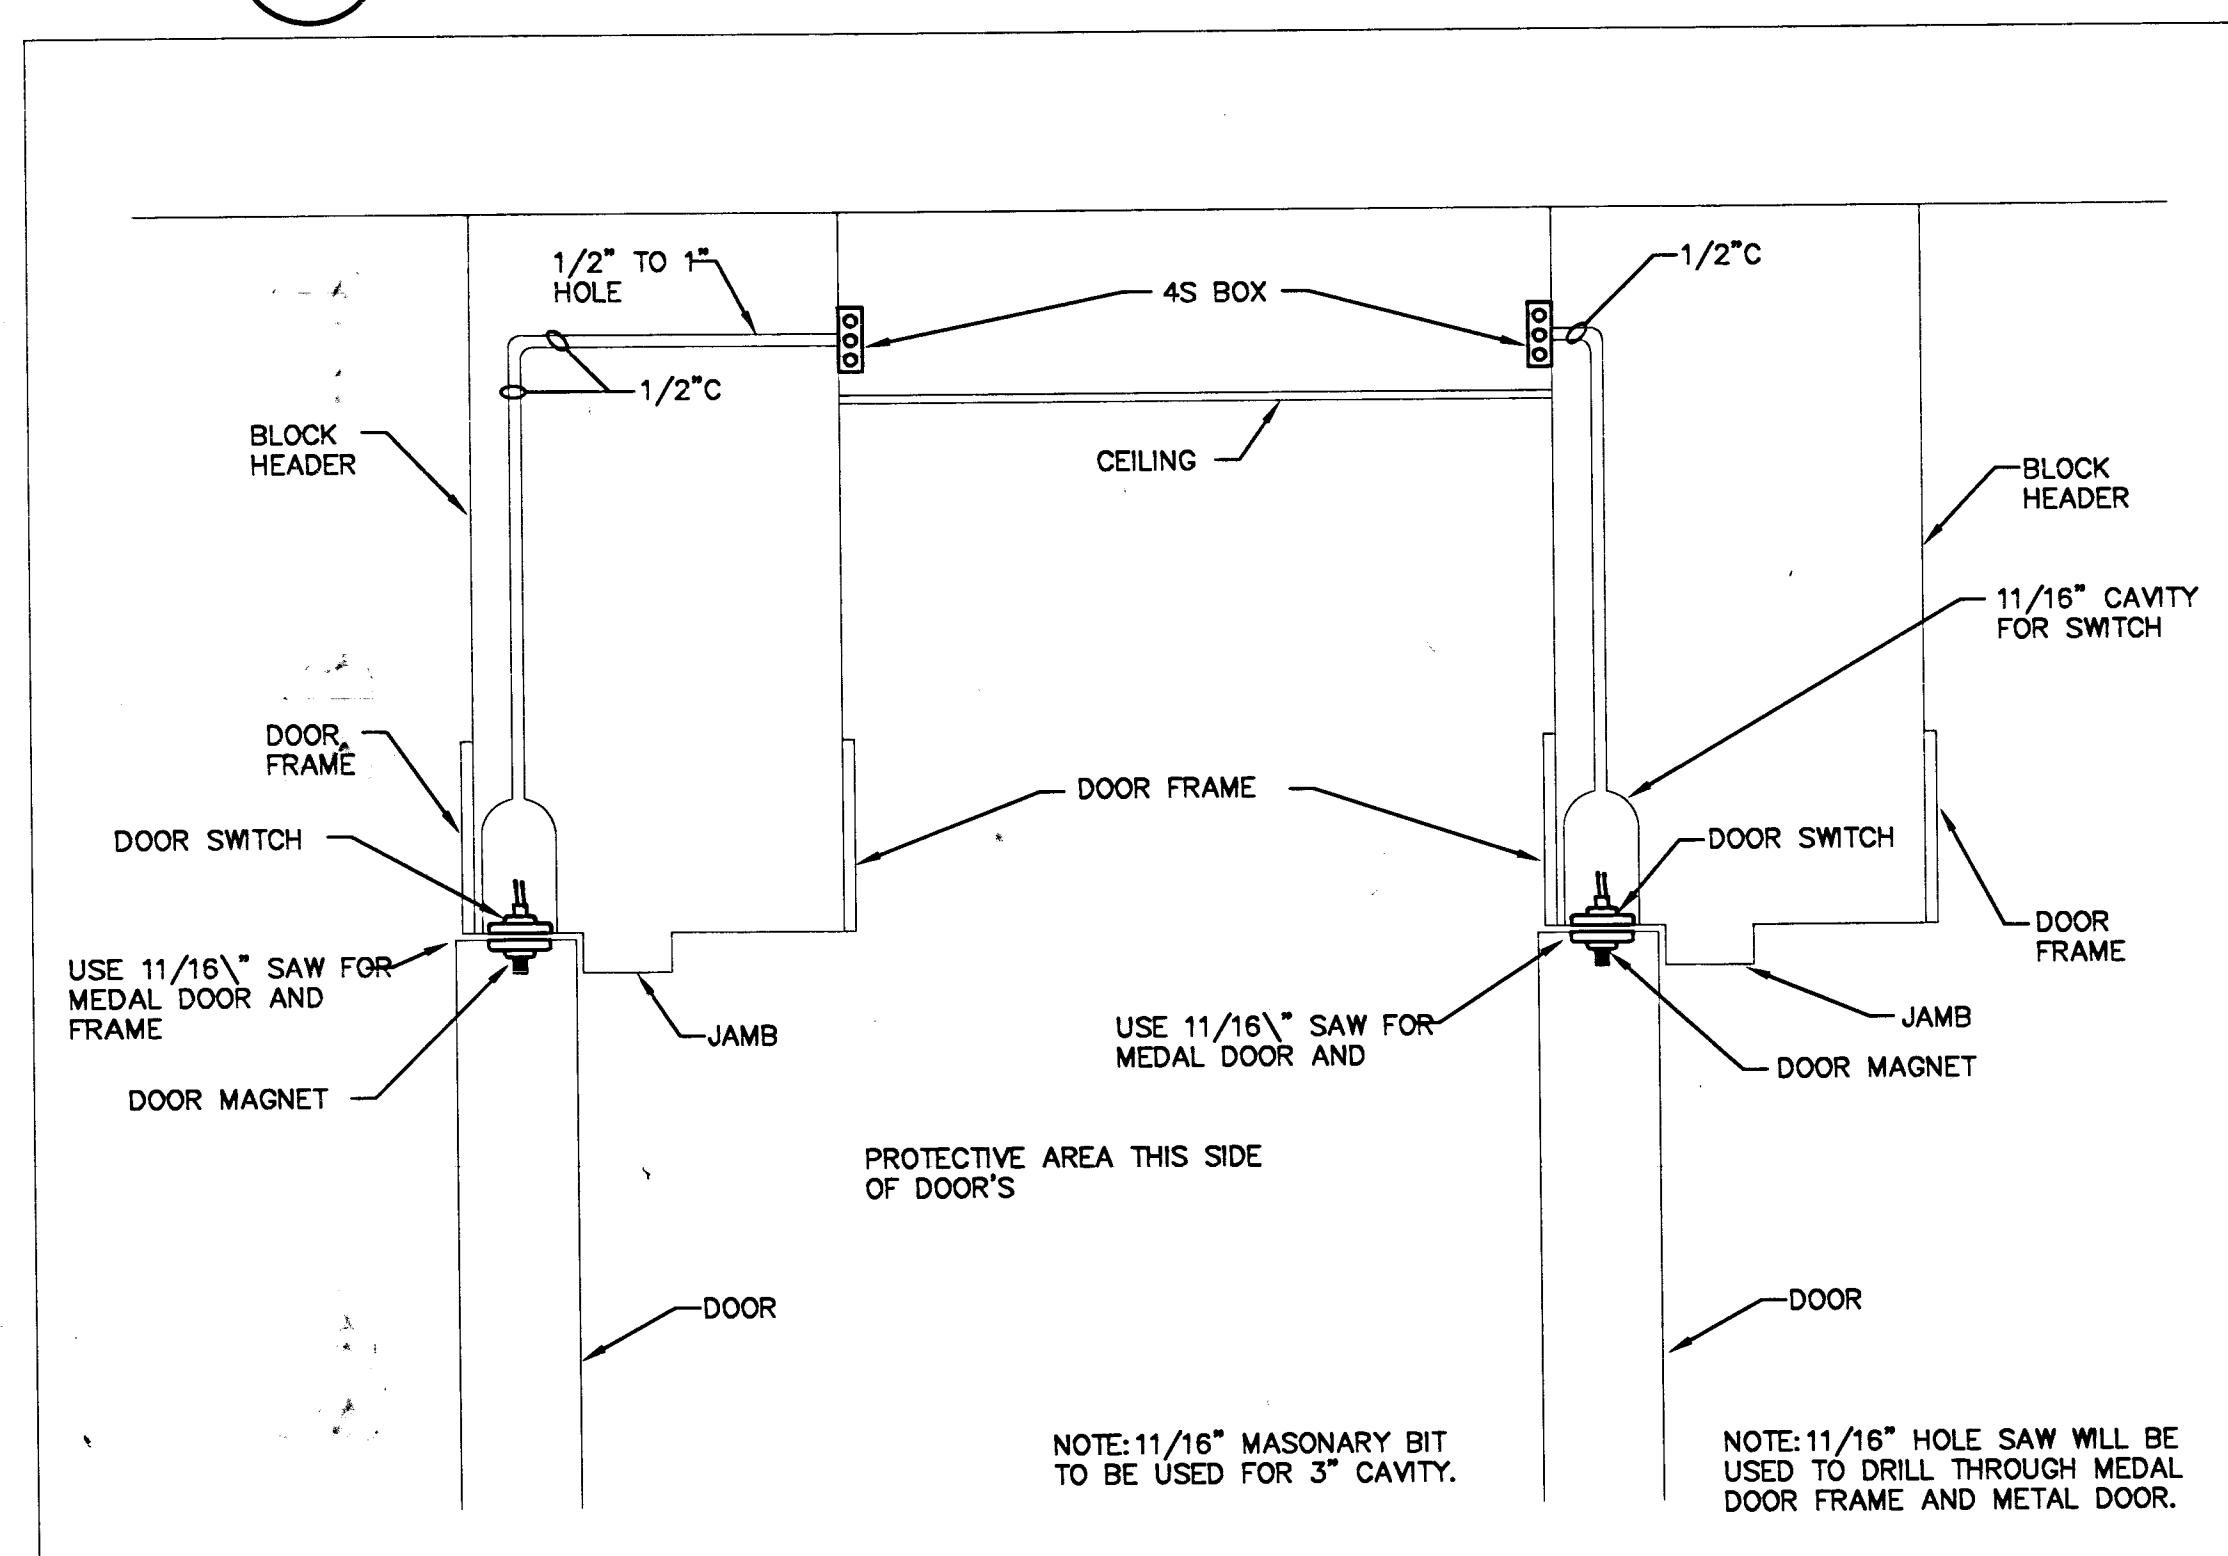


**4 NON-GROUTED DOOR FRAME FOR RECESSED SWITCH AND MAGNET**  
E4.02 NOT TO SCALE  
• REFER TO ARCH FOR ADDITIONAL INFORMATION CMU DOOR FRAME INTERFACE

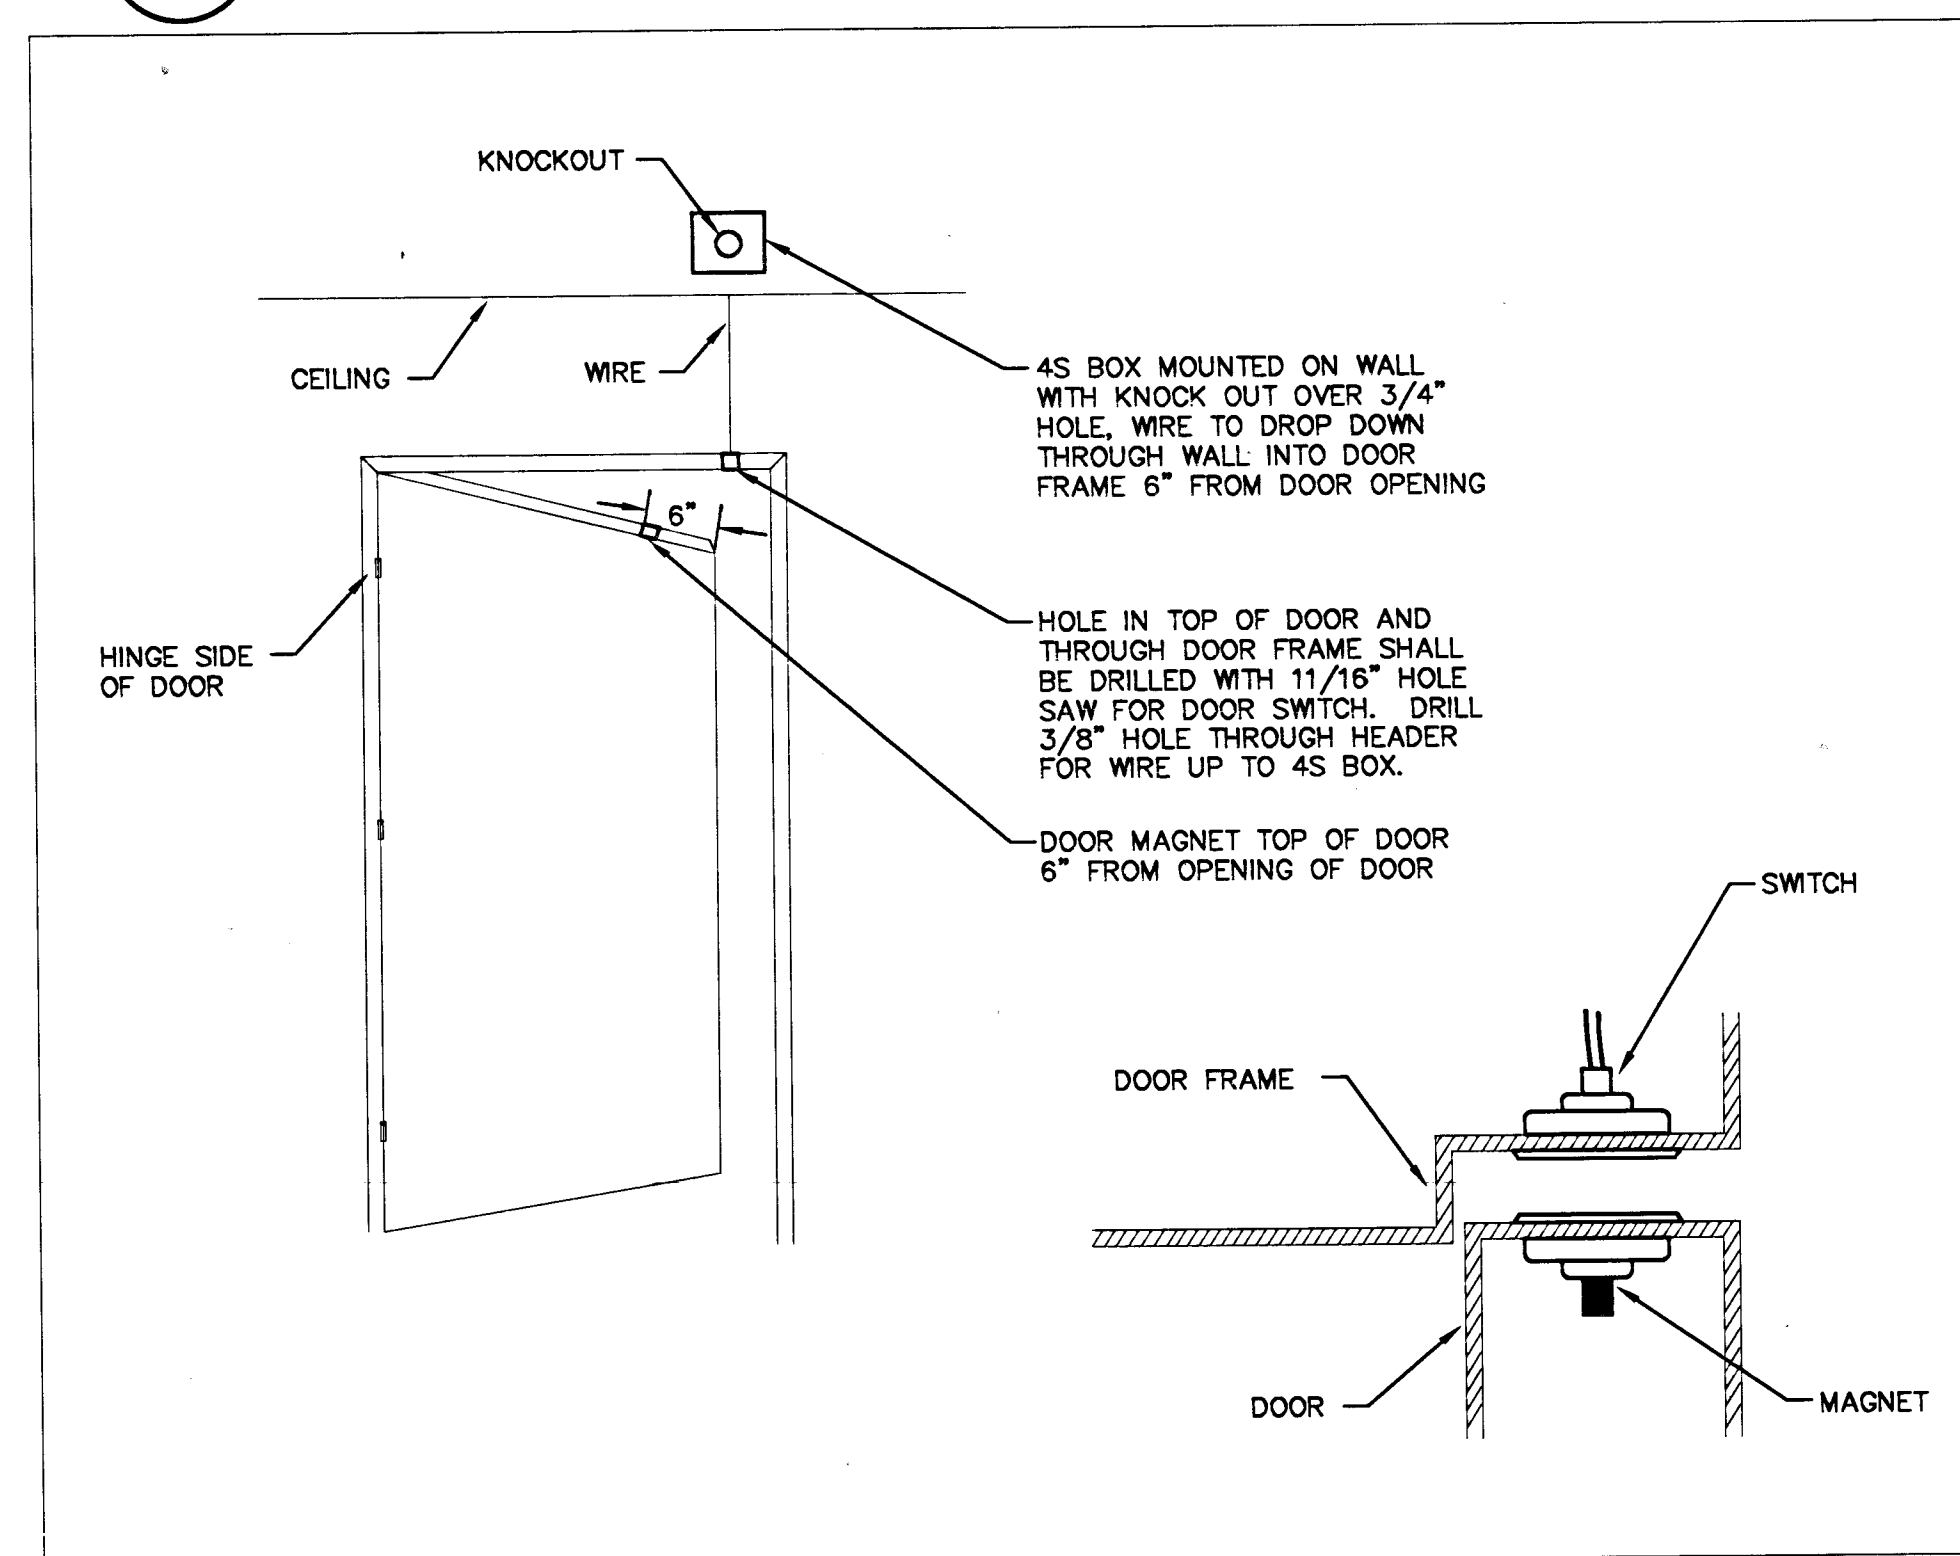


**5 INSIDE DOOR INSTALLATION OF DOOR SWITCH 'RECESSED'**  
E4.02 NOT TO SCALE


**6 NOT USED**  
E4.02 NOT TO SCALE

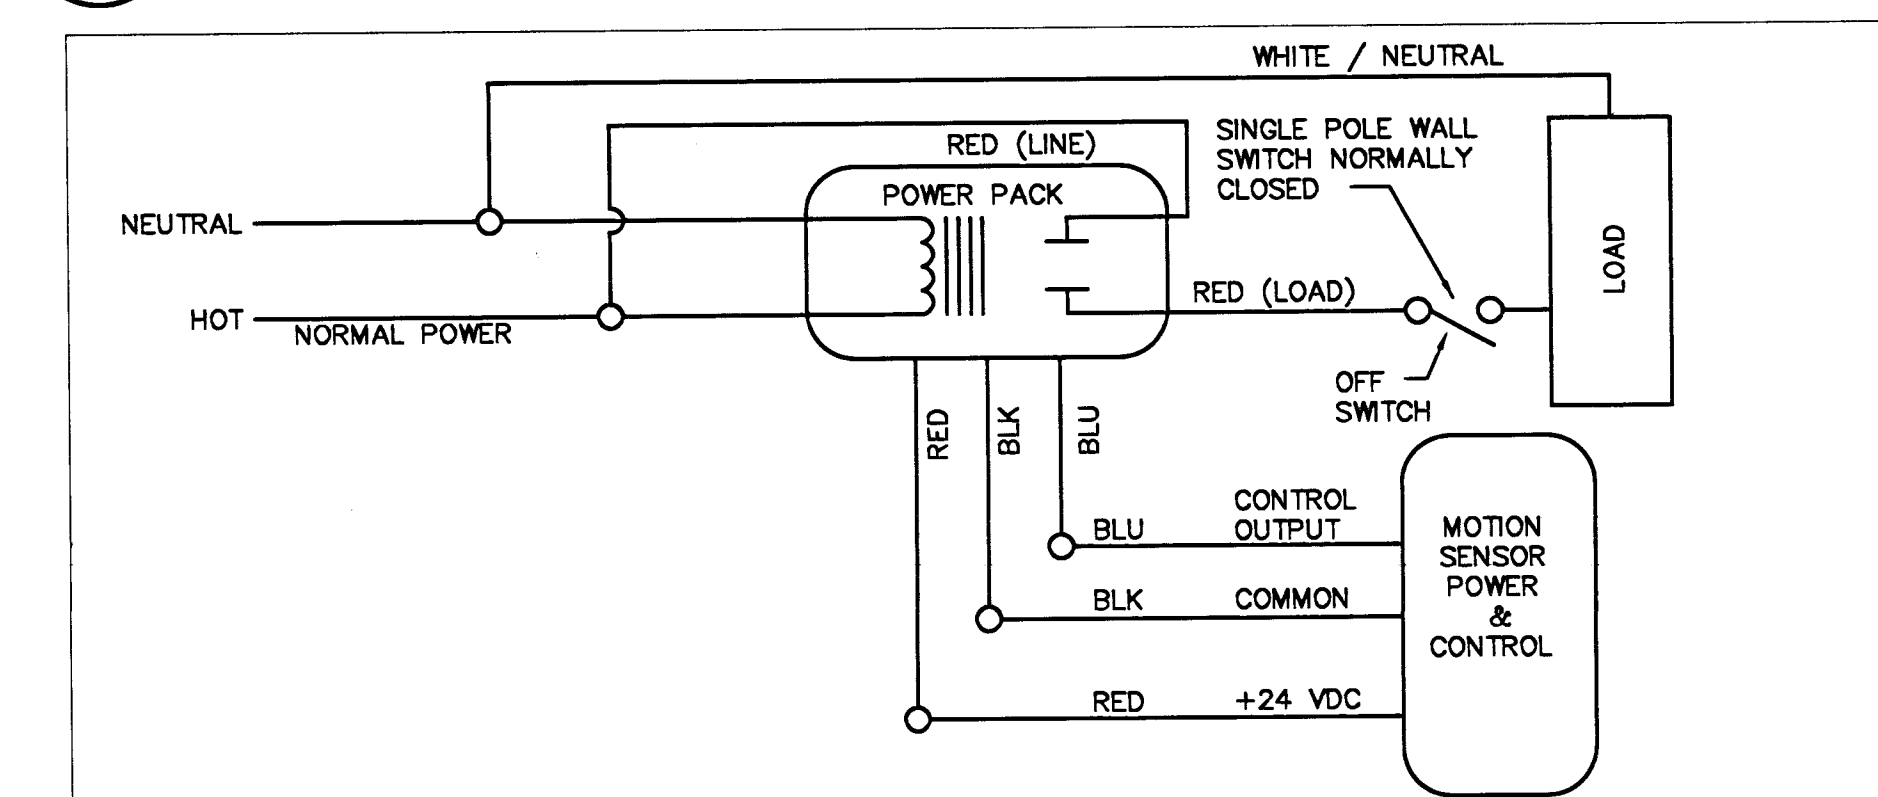


**10 ELECTRICAL WIRING DIAGRAM FOR MOTION SENSORS**  
E4.02 NOT TO SCALE

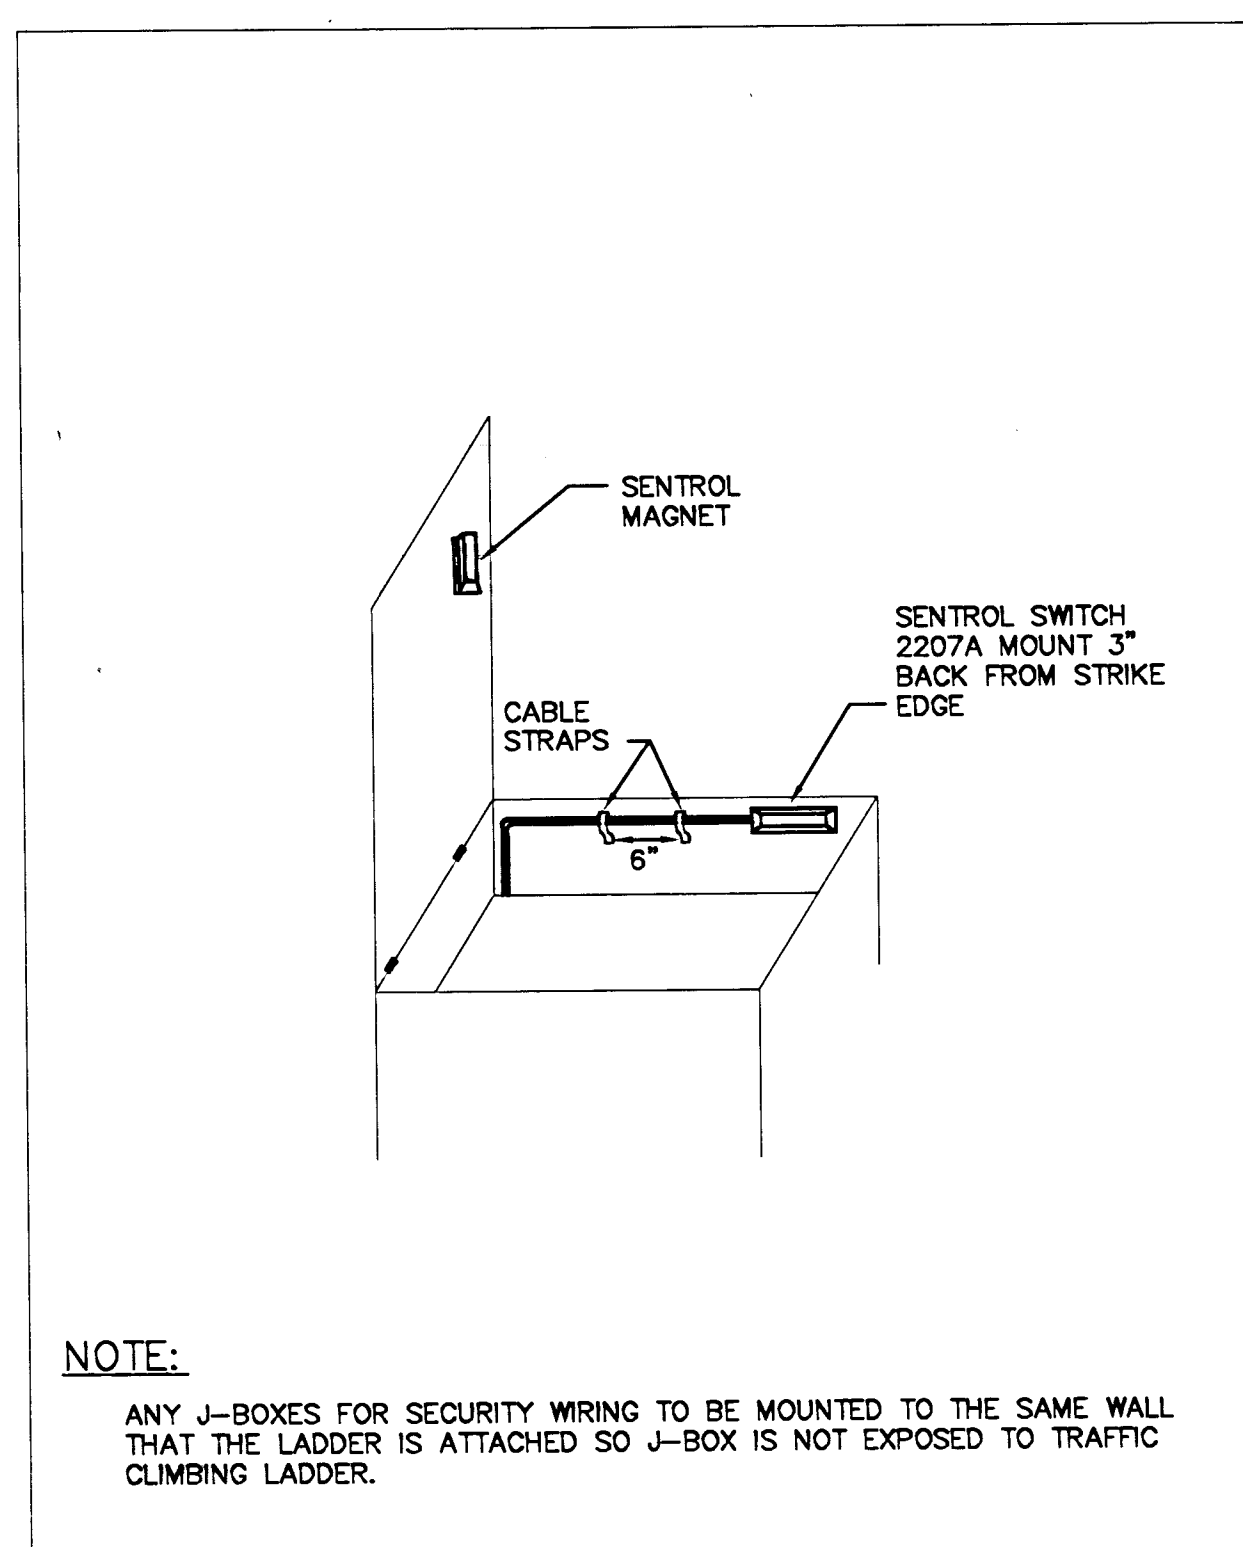

**7 INSTALLATION OF ROOF HATCH WITH ON THE STRICK SIDE OF HATCH**  
E4.02 NOT TO SCALE

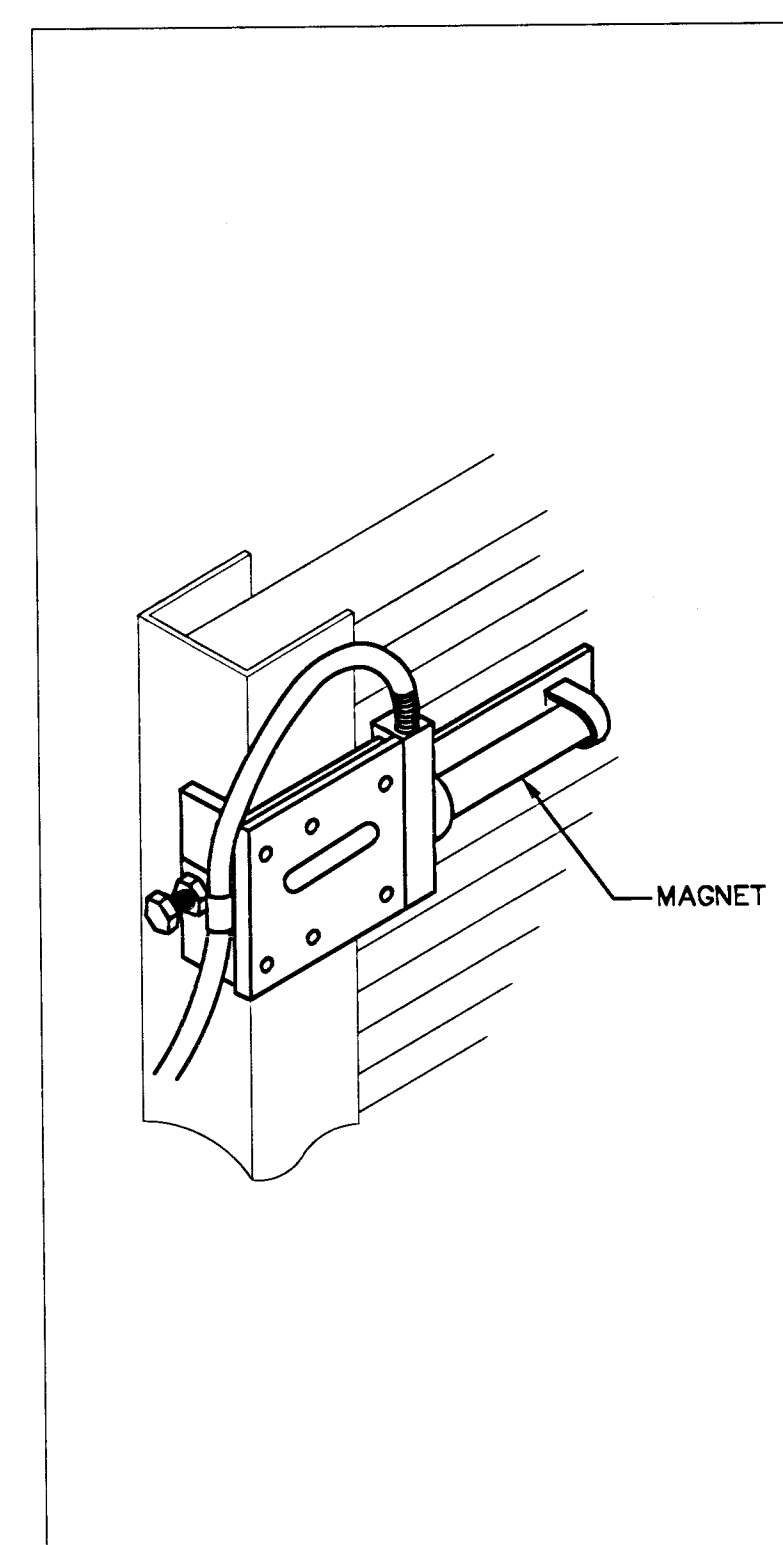

**8 INSTALLATION FOR ROLLUP DOOR SWITCH**  
E4.02 NOT TO SCALE

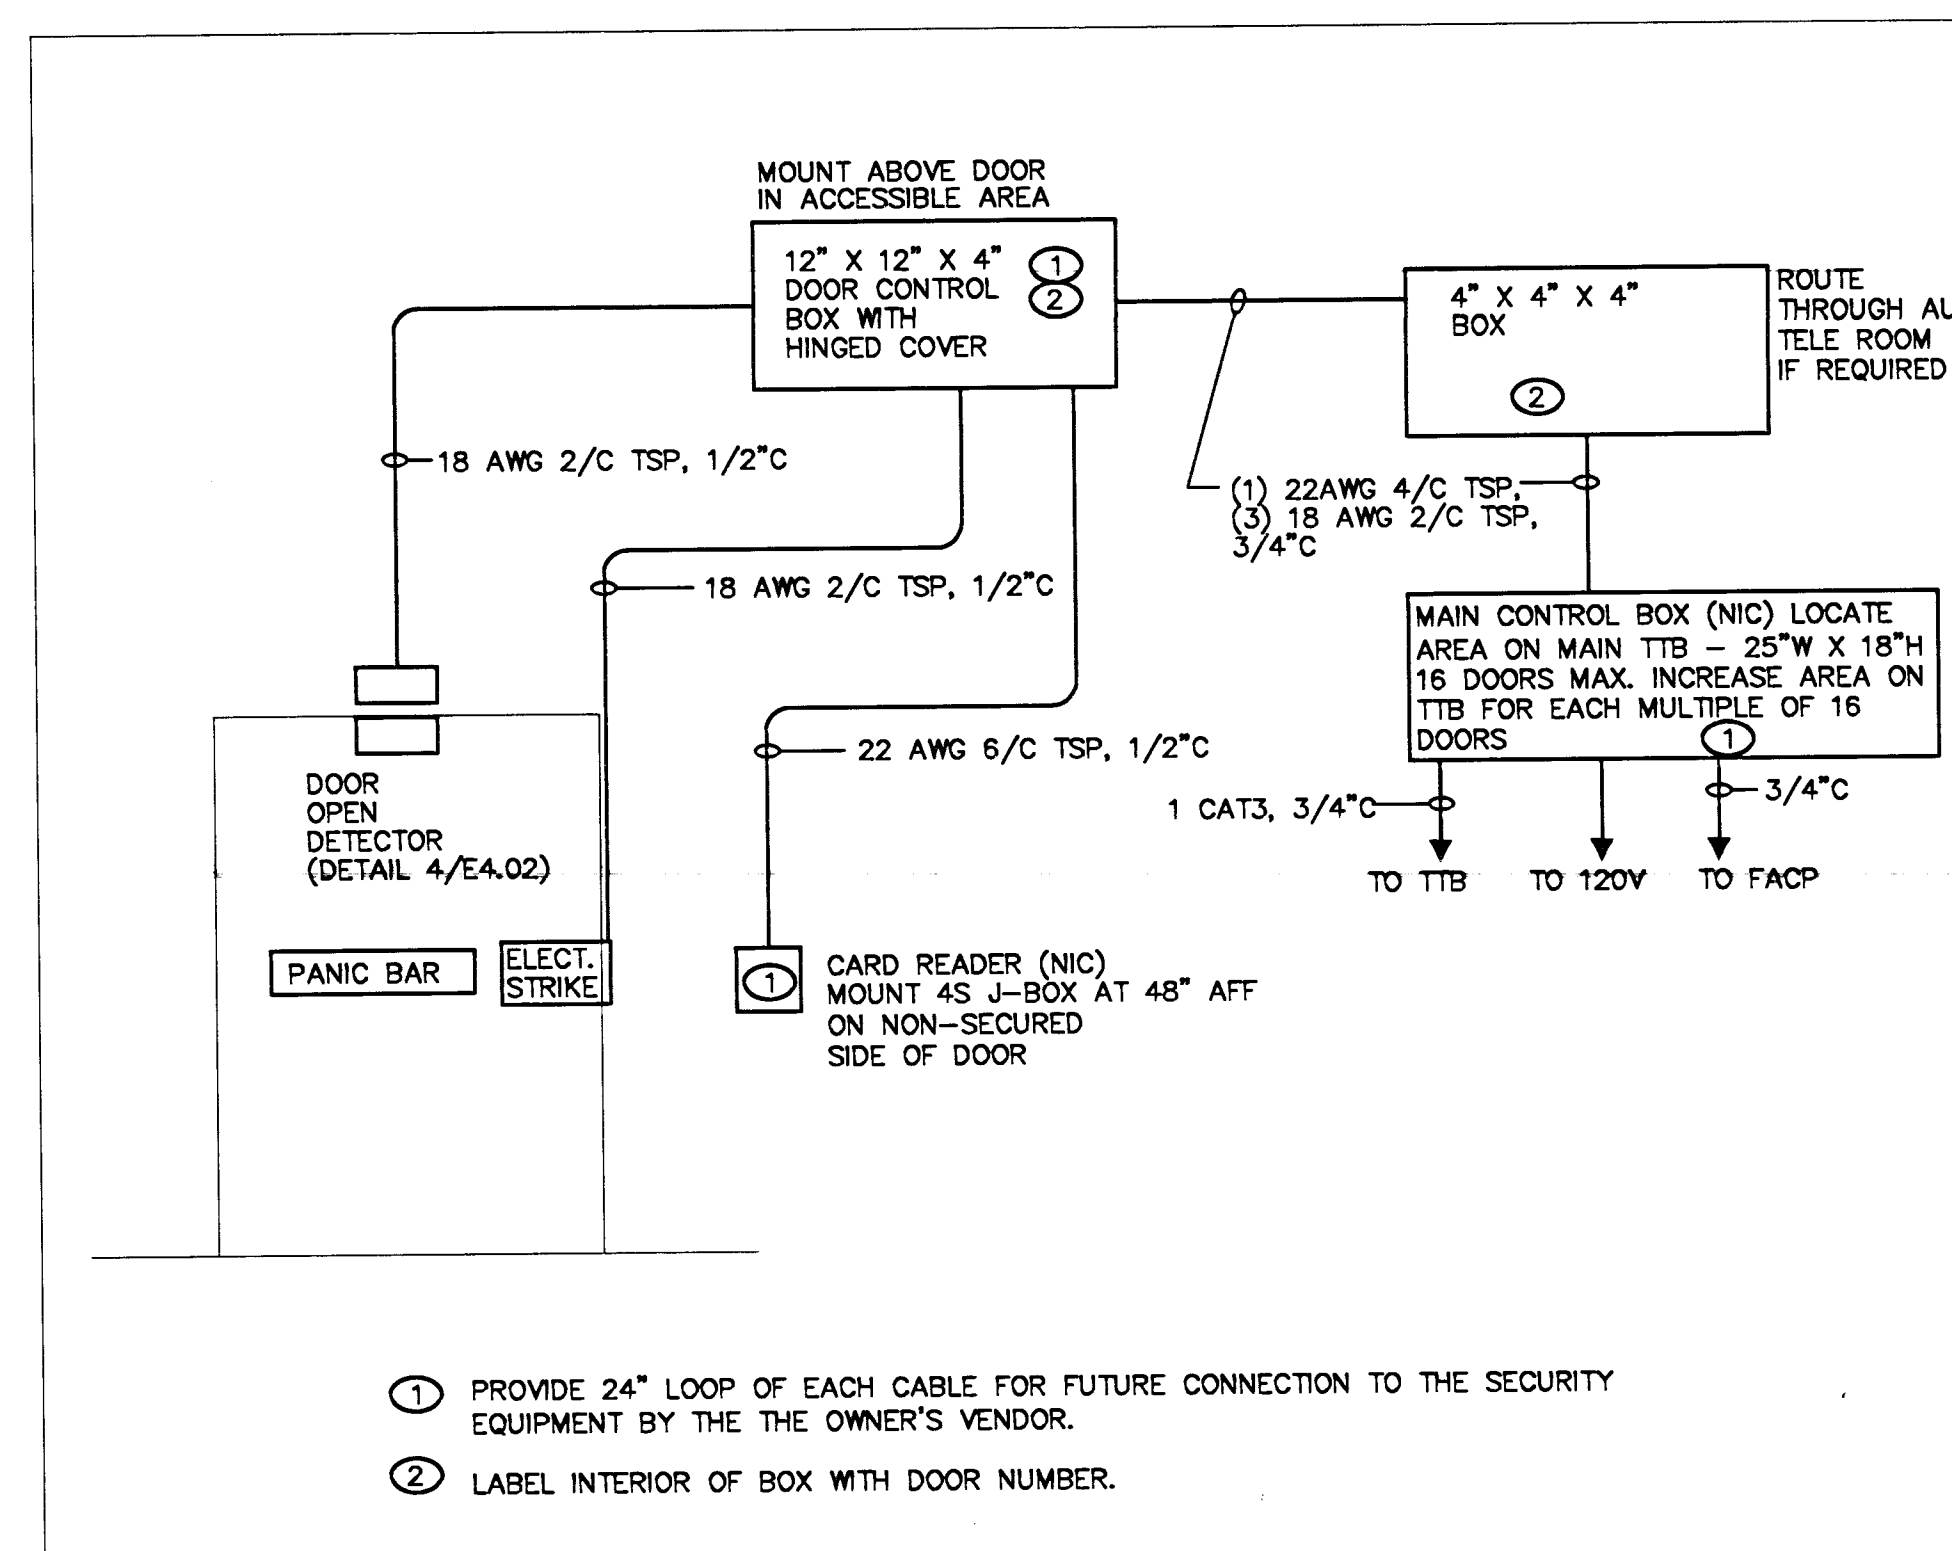

**9 CARD KEY SECURITY DETAIL - ELEVATION**  
E4.02 NOT TO SCALE

THESE RECORD DOCUMENTS HAVE BEEN PREPARED BASED ON INFORMATION PROVIDED BY OTHERS. THE DESIGN PROFESSIONAL HAS NOT VERIFIED THE ACCURACY AND/OR COMPLETENESS OF THIS INFORMATION AND SHALL NOT BE RESPONSIBLE FOR ANY ERRORS OR OMISSIONS WHICH MAY BE INCORPORATED HEREIN AS A RESULT.

Disclaimer: These record drawings prepared by Lucchese Galati Architects, Inc. are based on information provided by others. Lucchese Galati Architects, Inc. has not verified the accuracy and/or completeness of its information supplied by others, and shall not be responsible for any errors or omissions, which may be incorporated herein as a result.