



LEGEND

---	EJ	=	EXPANSION JOINT	(2A) (2C)
---	CJ	=	CONTROL JOINT	(2B) (3)
---	TSD	=	TOP OF SLOT DRAIN	(3) (4)
---	TCO	=	TOP OF CLEAN-OUT	(4) (5F-3)
---	HB	=	HOSE BIBB	(4) (5F-3)
---	TAD	=	TOP OF AREA DRAIN	(4) (5F-3)
---	DL	=	DISABLED LIFT	(6) (5F-3)
---	CW	=	COLD WATER	(6) (5F-3)
---	SL	=	SLOPE DIRECTION	
---	WL	=	WATERLEVEL	
---	TD	=	TOP OF DECK	
---	TFF	=	TOP OF FINISHED FLOOR	
---	IE	=	INVERT ELEVATION	

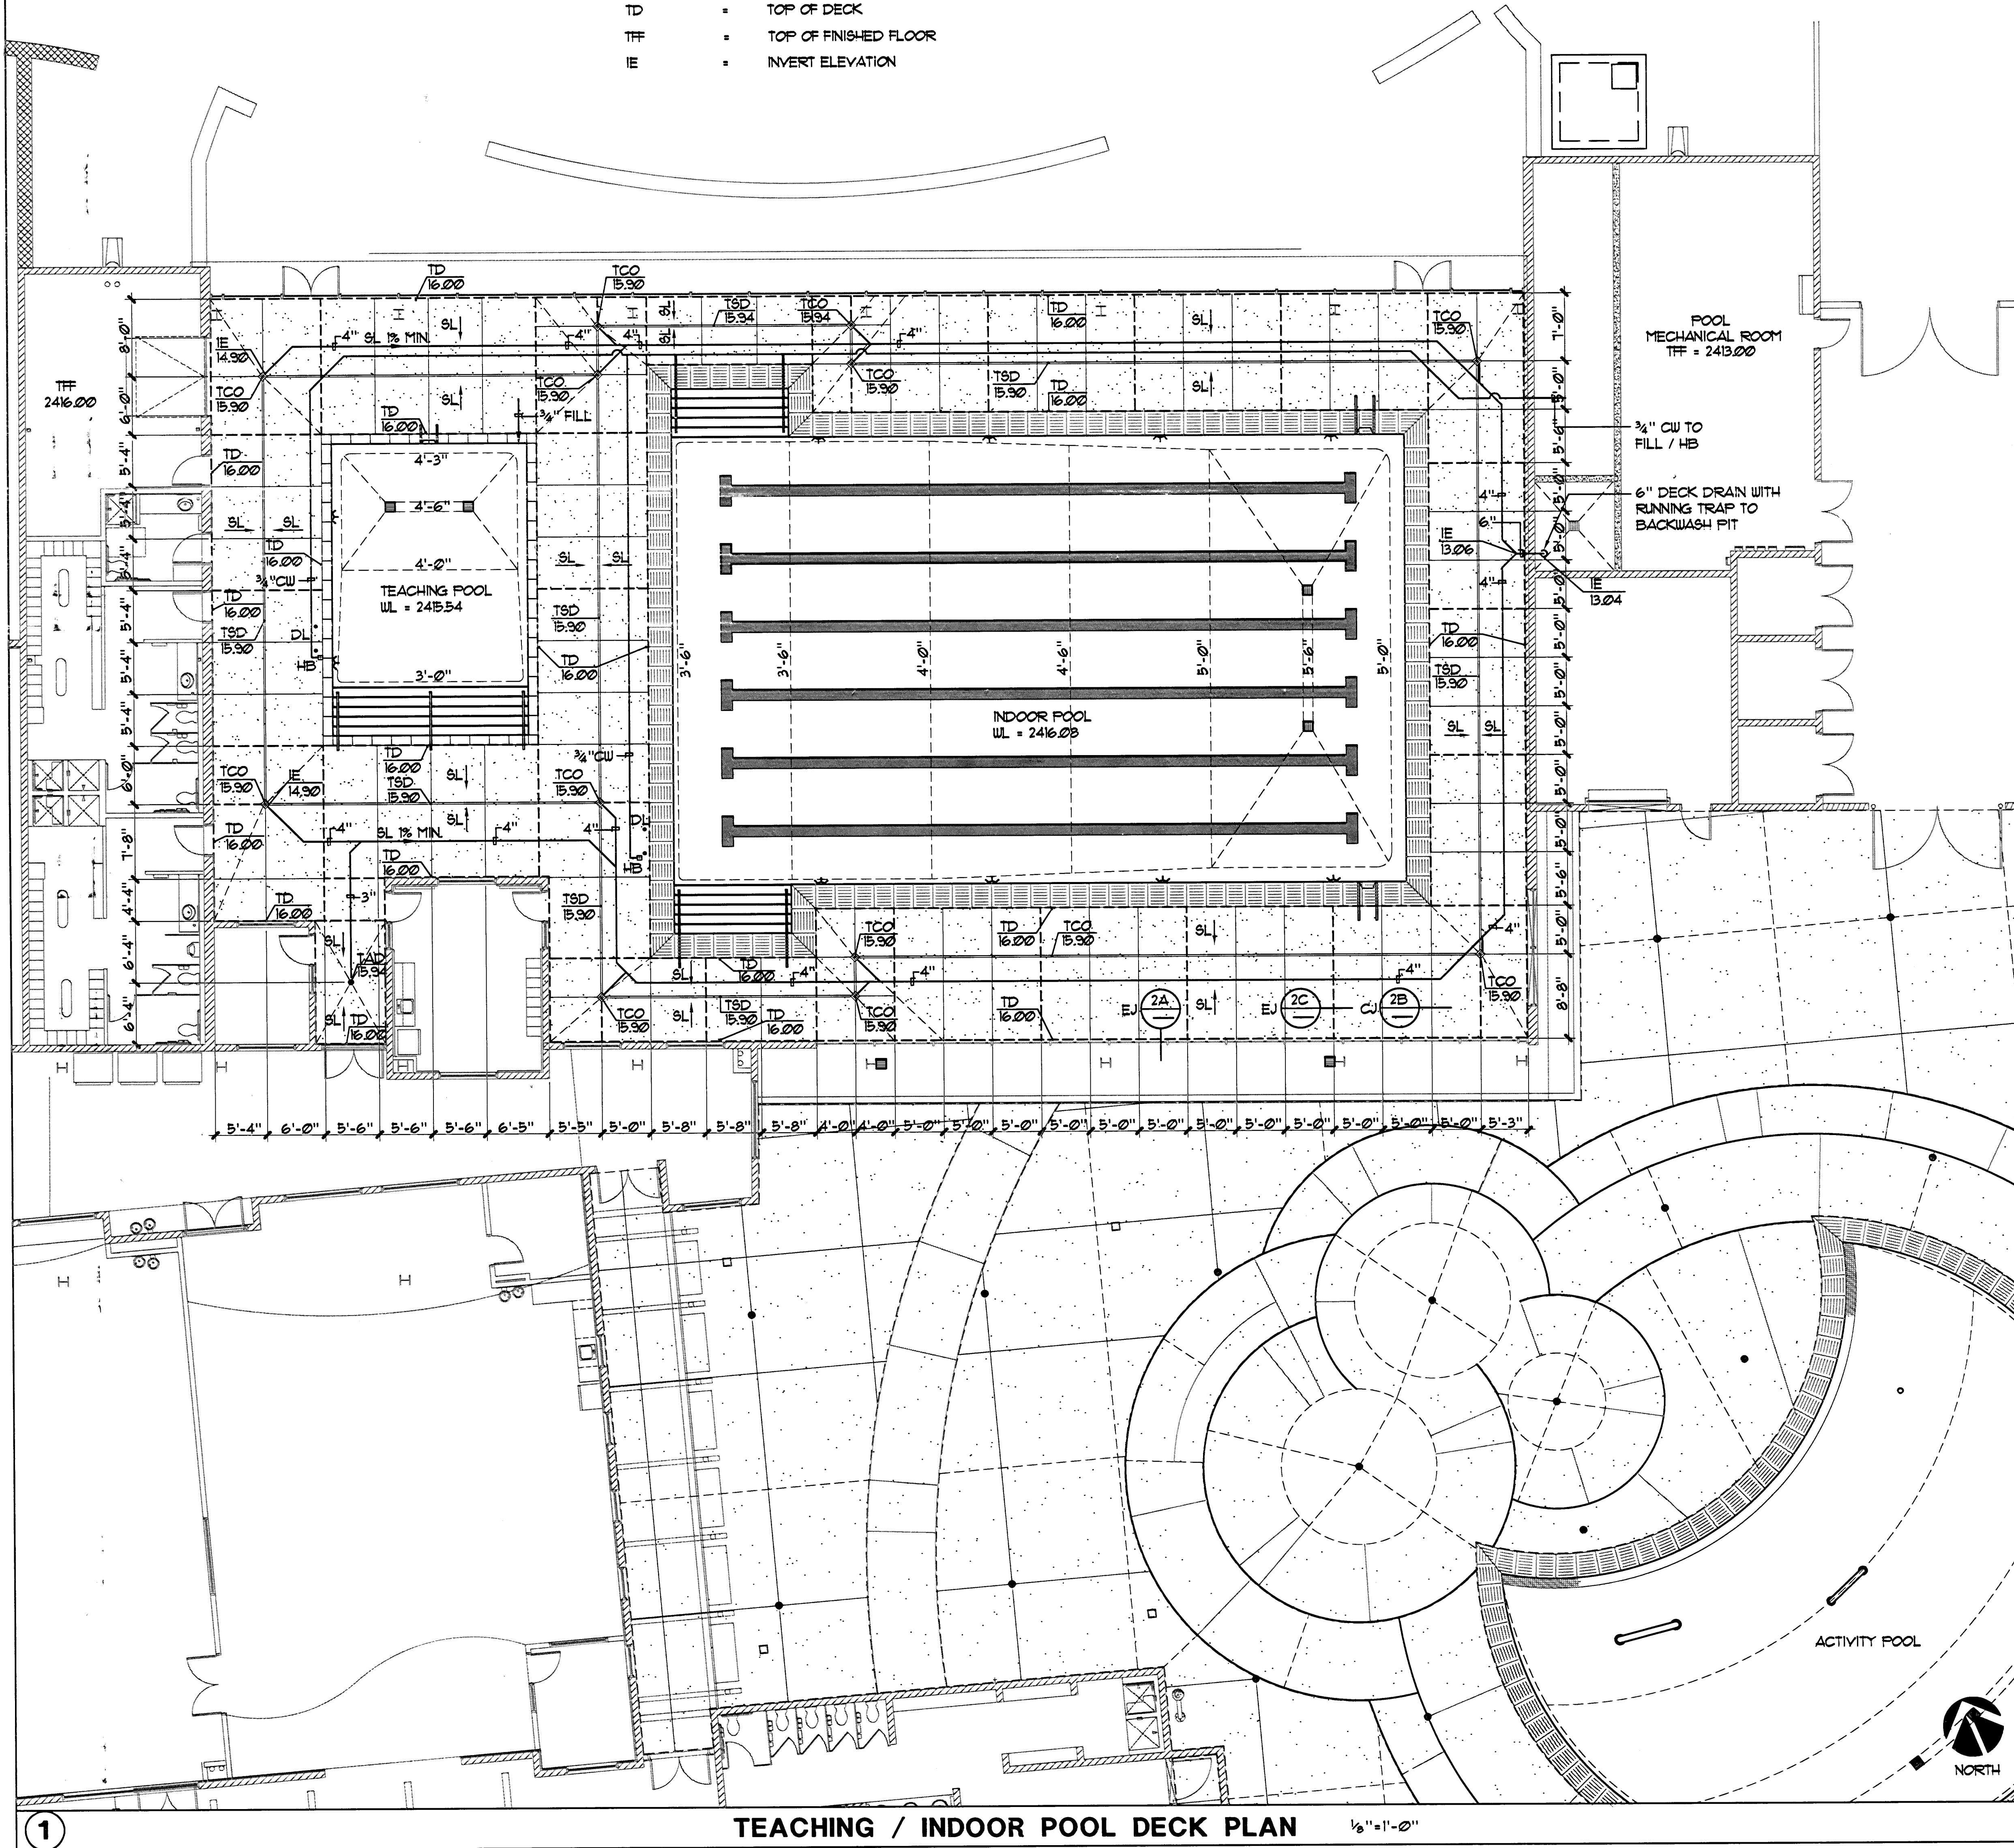


TEACHING / INDOOR POOL DECK PLAN

1/8" = 1'-0"

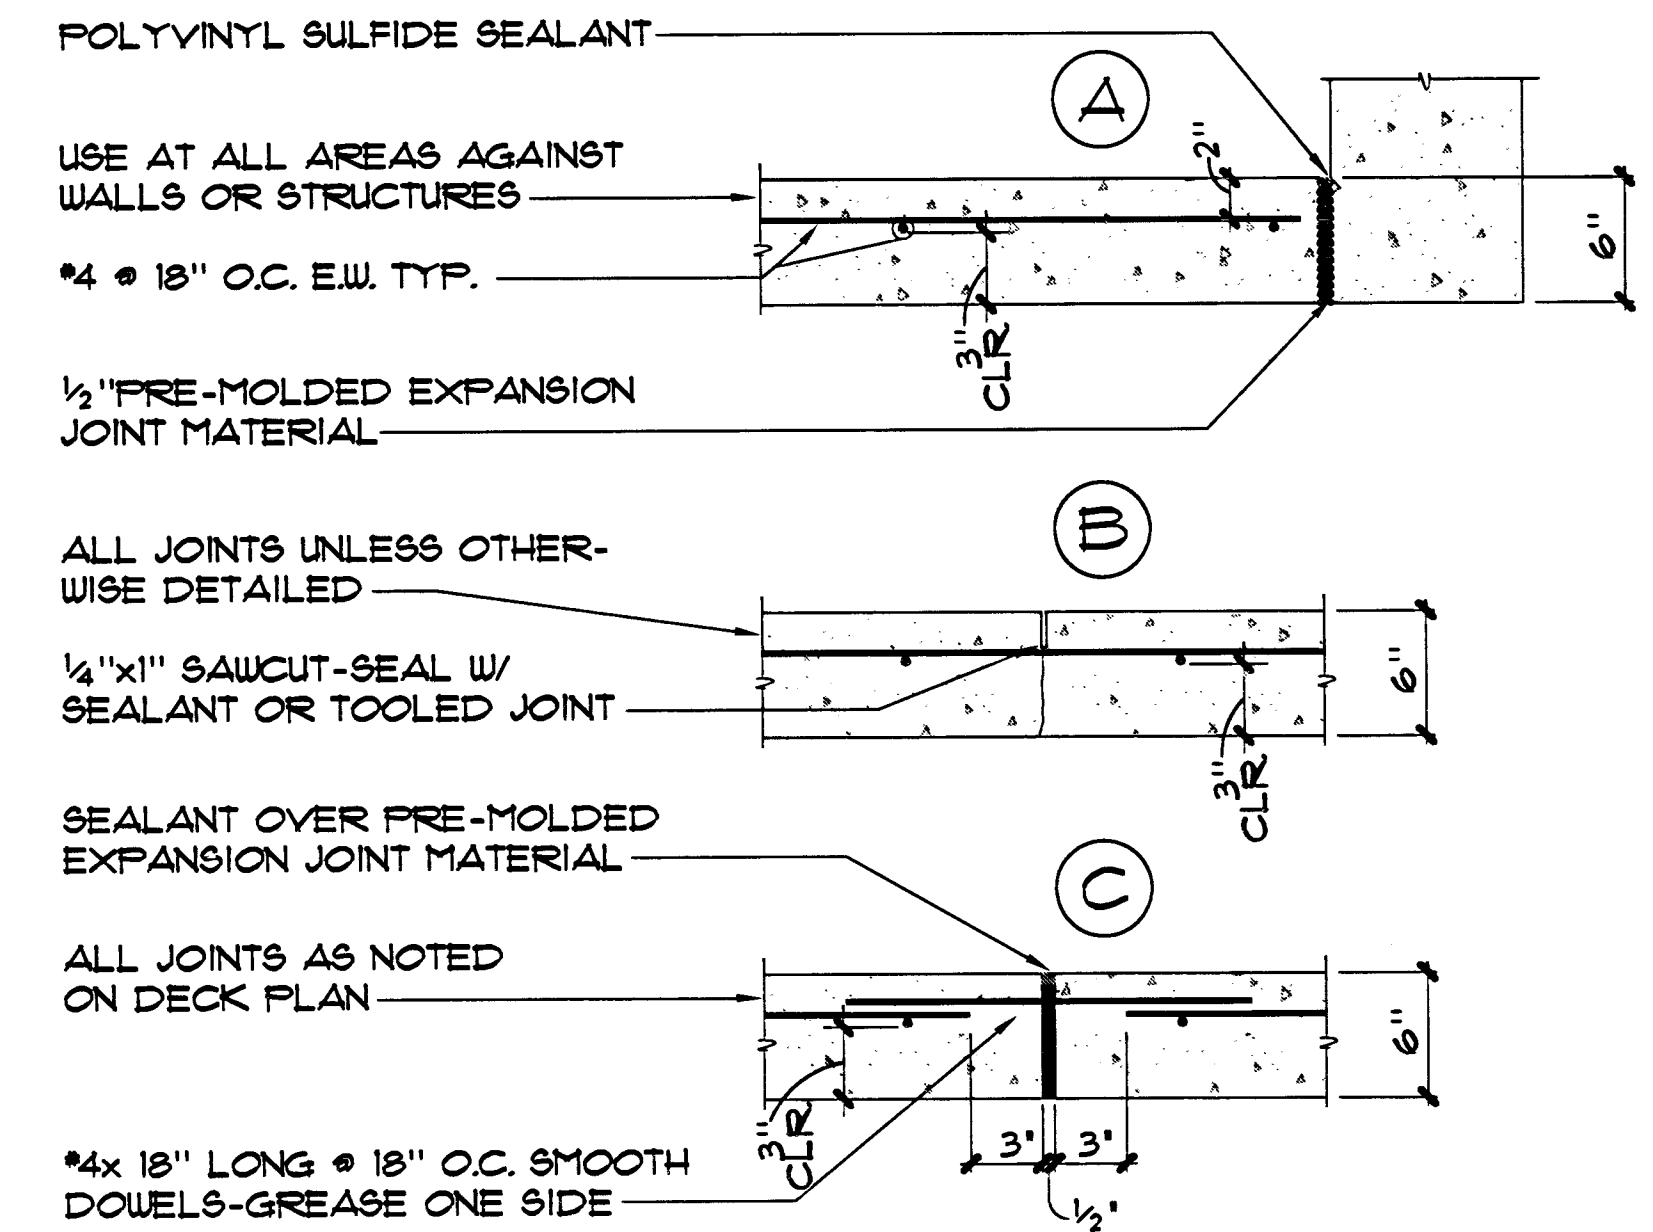


NOTE: PROVIDE MIN. 4" OF TYPE II AGGREGATE BASE OVERLYING 6" OF 90% COMPACTED STRUCTURAL FILL UNDER ALL INTERIOR/EXTERIOR SLABS.

DECK DETAILS

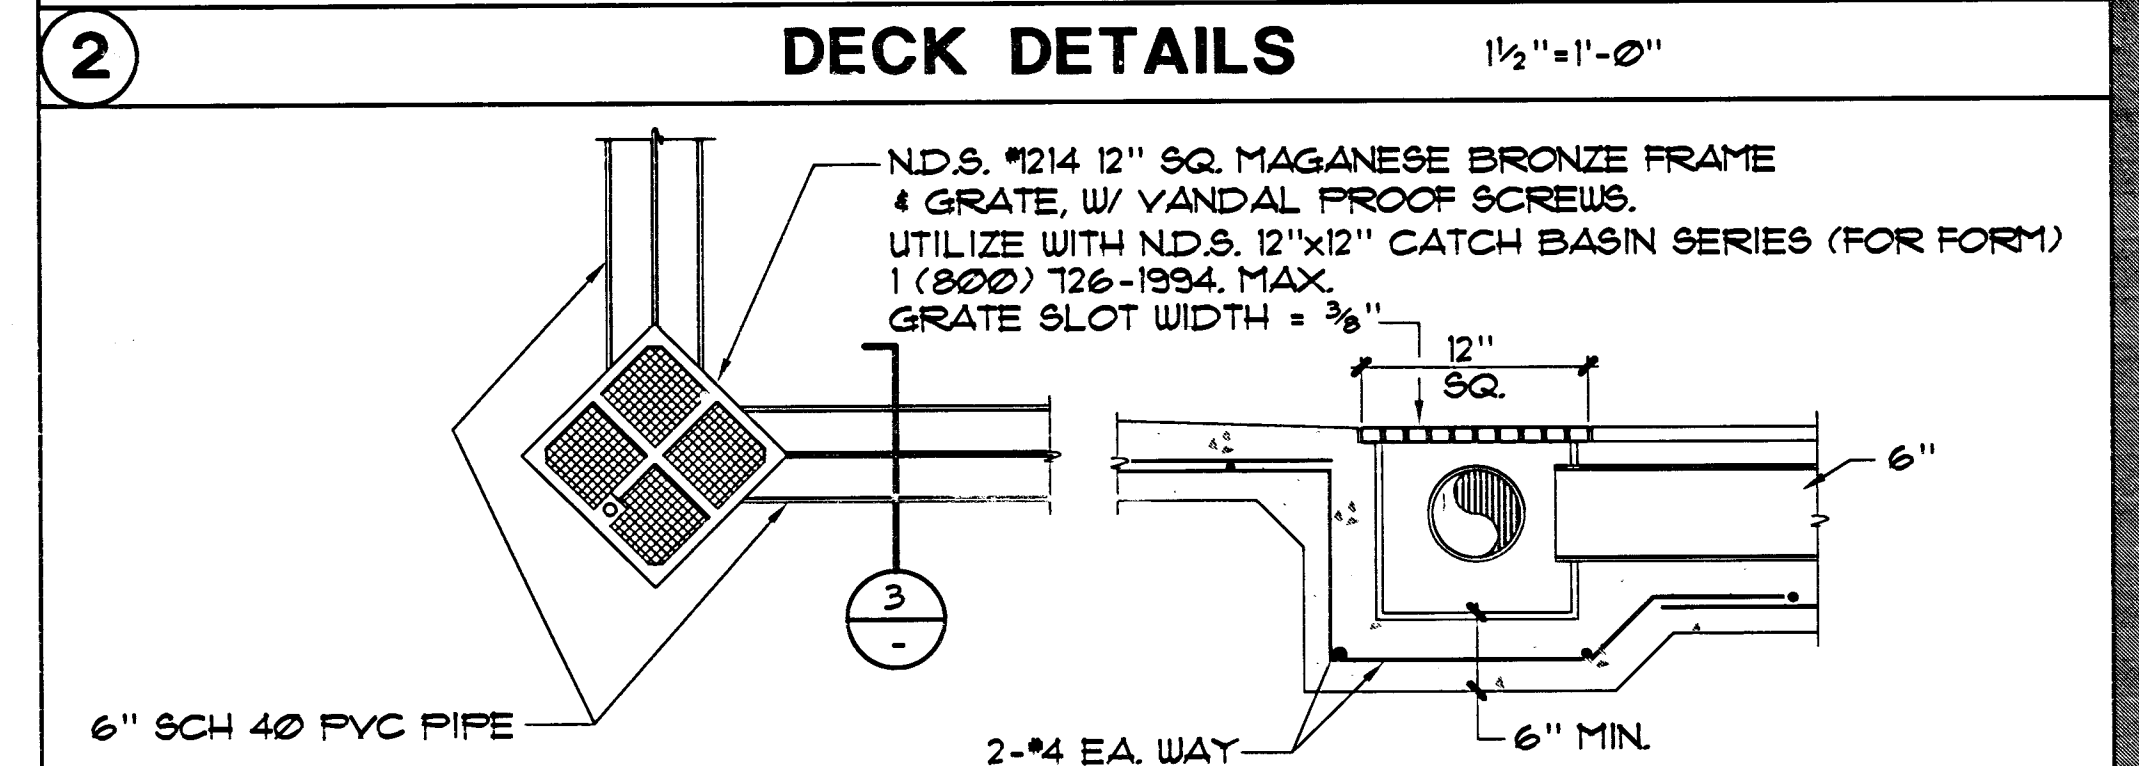

SLOT DRAIN CLEAN OUT

1 1/2" = 1'-0"

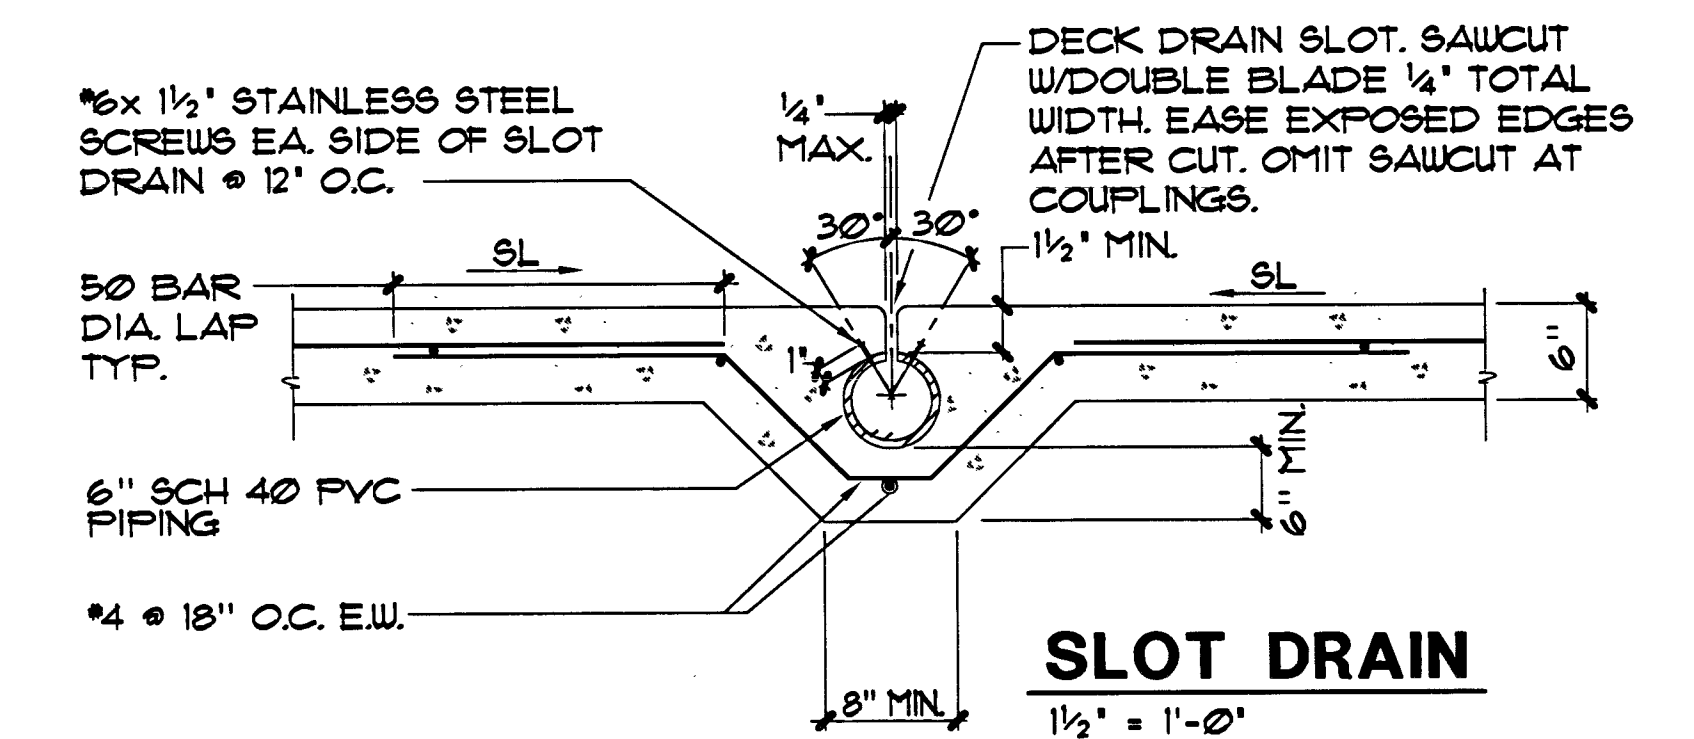


SLOT DRAIN

1 1/2" = 1'-0"

NOTE: PROVIDE MIN. 4" OF TYPE II AGGREGATE BASE OVERLYING 6" OF 90% COMPACTED STRUCTURAL FILL UNDER ALL INTERIOR/EXTERIOR SLABS.


SLOT DRAIN

1 1/2" = 1'-0"

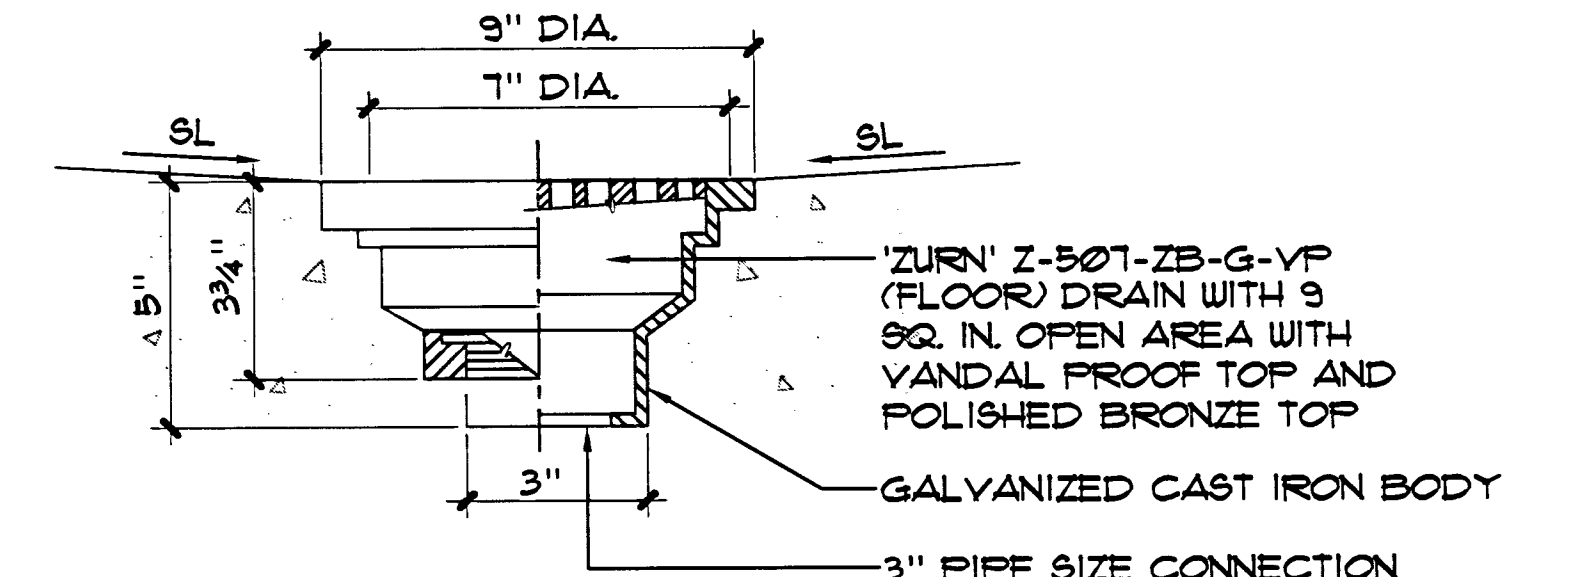


AREA DRAIN DETAIL

3" = 1'-0"

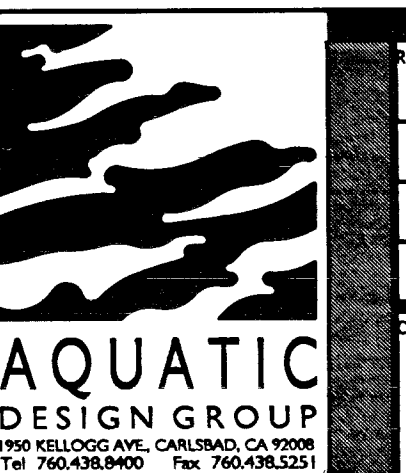


500 PLOT ROAD, SUITE A
LAS VEGAS, NEVADA 89165
TEL: 702.333.7711 FAX: 702.333.7711

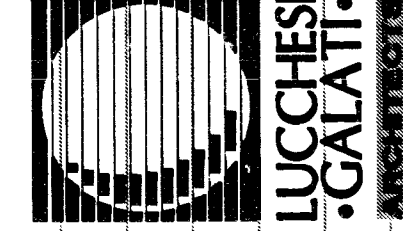

Disclaimer: These record drawings prepared by Lucchesi Architects, Inc., are based on information provided by others. Lucchesi Architects, Inc. has not verified the accuracy and/or completeness of its information supplied by others, and shall not be responsible for any errors or omissions, which may be incorporated herein as a result.

CITY OF LAS VEGAS
CENTENNIAL HILLS COMMUNITY CENTER
RECORD DRAWINGS
TEACHING / INDOOR POOL
DECK PLAN AND DETAILS

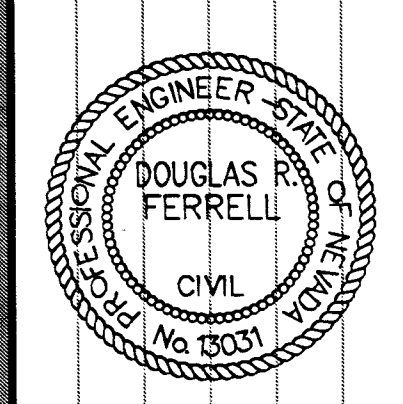

OWNER: CITY OF LAS VEGAS
DEPARTMENT OF PUBLIC WORKS
ARCHITECTURAL SERVICES

400 EAST STEWART AVENUE
LAS VEGAS, NEVADA 89103
PHONE: (702) 229-5535
FAX: (702) 384-8848
TDD: (702) 386-9108

DATE	10/22
REV	CE-01
DATE	10/22/03
SCALE	AS NOTED
REV NO	051534101
REV DATE	07-14-03

DP-1