




AQUATIC
DESIGN GROUP
190 KELLWOOD AVE. CARLETON, CA 95006
TEL: (925) 253-3111 FAX: (925) 253-3111

LEGEND

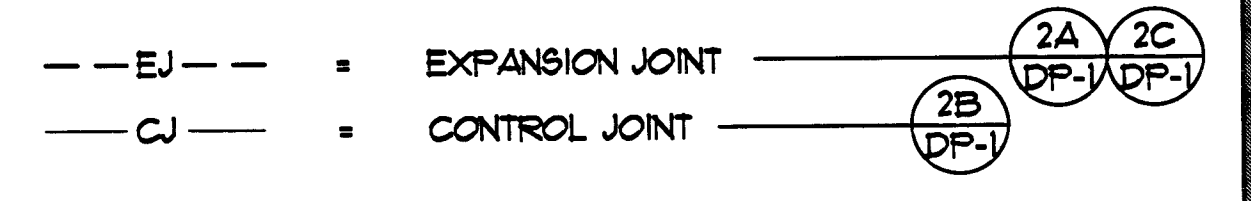

POOL DECK COLOR SCHEDULE

- ① DAVIS COLORS: WILLOW GREEN
- ② DAVIS COLORS: SPANISH GOLD
- ③ DAVIS COLORS: BRICK RED
- ④ STANDARD CONCRETE GRAY


NOTES:

1. FINISH SHALL BE MEDIUM BROOM. (PROVIDE MIN. 3 SAMPLES PER SPECIFICATIONS)
2. BROOM PATTERN SHALL BE PARALLEL TO RADI FOR COLORS ① ② ③ BANDS AND ④ BANDS AROUND WET PLAY GRATING.
3. ALL OTHER COLOR ④ SHALL HAVE ALTERNATING CHECKERBOARD BROOM PATTERN WITHIN 12'x12' SQUARES.
4. POOL DECKING SHALL BE OVER 4" TYPE II AGGREGATE BASE OVER 6" OF 92% COMPACTED SOILS.
5. CONCRETE SHALL BE 4000 PSI MIN. AT 28 DAYS WITH MAXIMUM 0.45 WATER-CEMENT RATIO UTILIZING TYPE V CEMENT.

300 WEST WOODS SUITE 100
700 S. WASHINGTON BLVD
70300 LAS VEGAS, NV 89103
TEL: (702) 253-3111 FAX: (702) 253-3111

Disclaimer: These record drawings prepared by Lucchesi Galati Architects, Inc., are based on information provided by others. Lucchesi Galati Architects, Inc. has not verified the accuracy and/or completeness of the information supplied by others, and shall not be responsible for any errors or omissions, which may be incorporated herein as a result.

CITY OF LAS VEGAS
CENTENNIAL HILLS COMMUNITY CENTER
RECORD DRAWINGS
ACTIVITY/SWIMMING POOL
DECK PLAN (HORIZONTAL CONTROL)

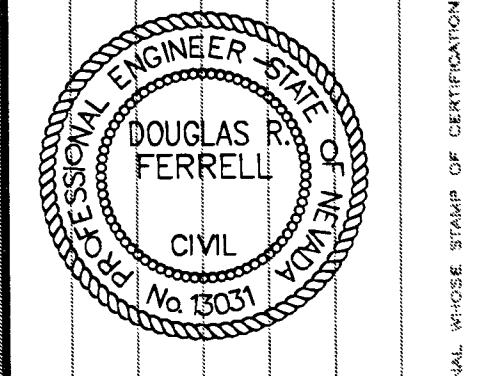


OWNER: CITY OF LAS VEGAS
DEPARTMENT OF PUBLIC WORKS
ARCHITECTURAL SERVICES

400 EAST STEWART AVENUE
LAS VEGAS, NEVADA 89103
PHONE: (702) 229-8335
FAX: (702) 384-4846
TDD: (702) 384-6108

DATE	02/15/05
REV	02/15/05
SCALE	AS NOTED
PROJECT NO.	05153410
DRAWING NO.	671-49

DP-2

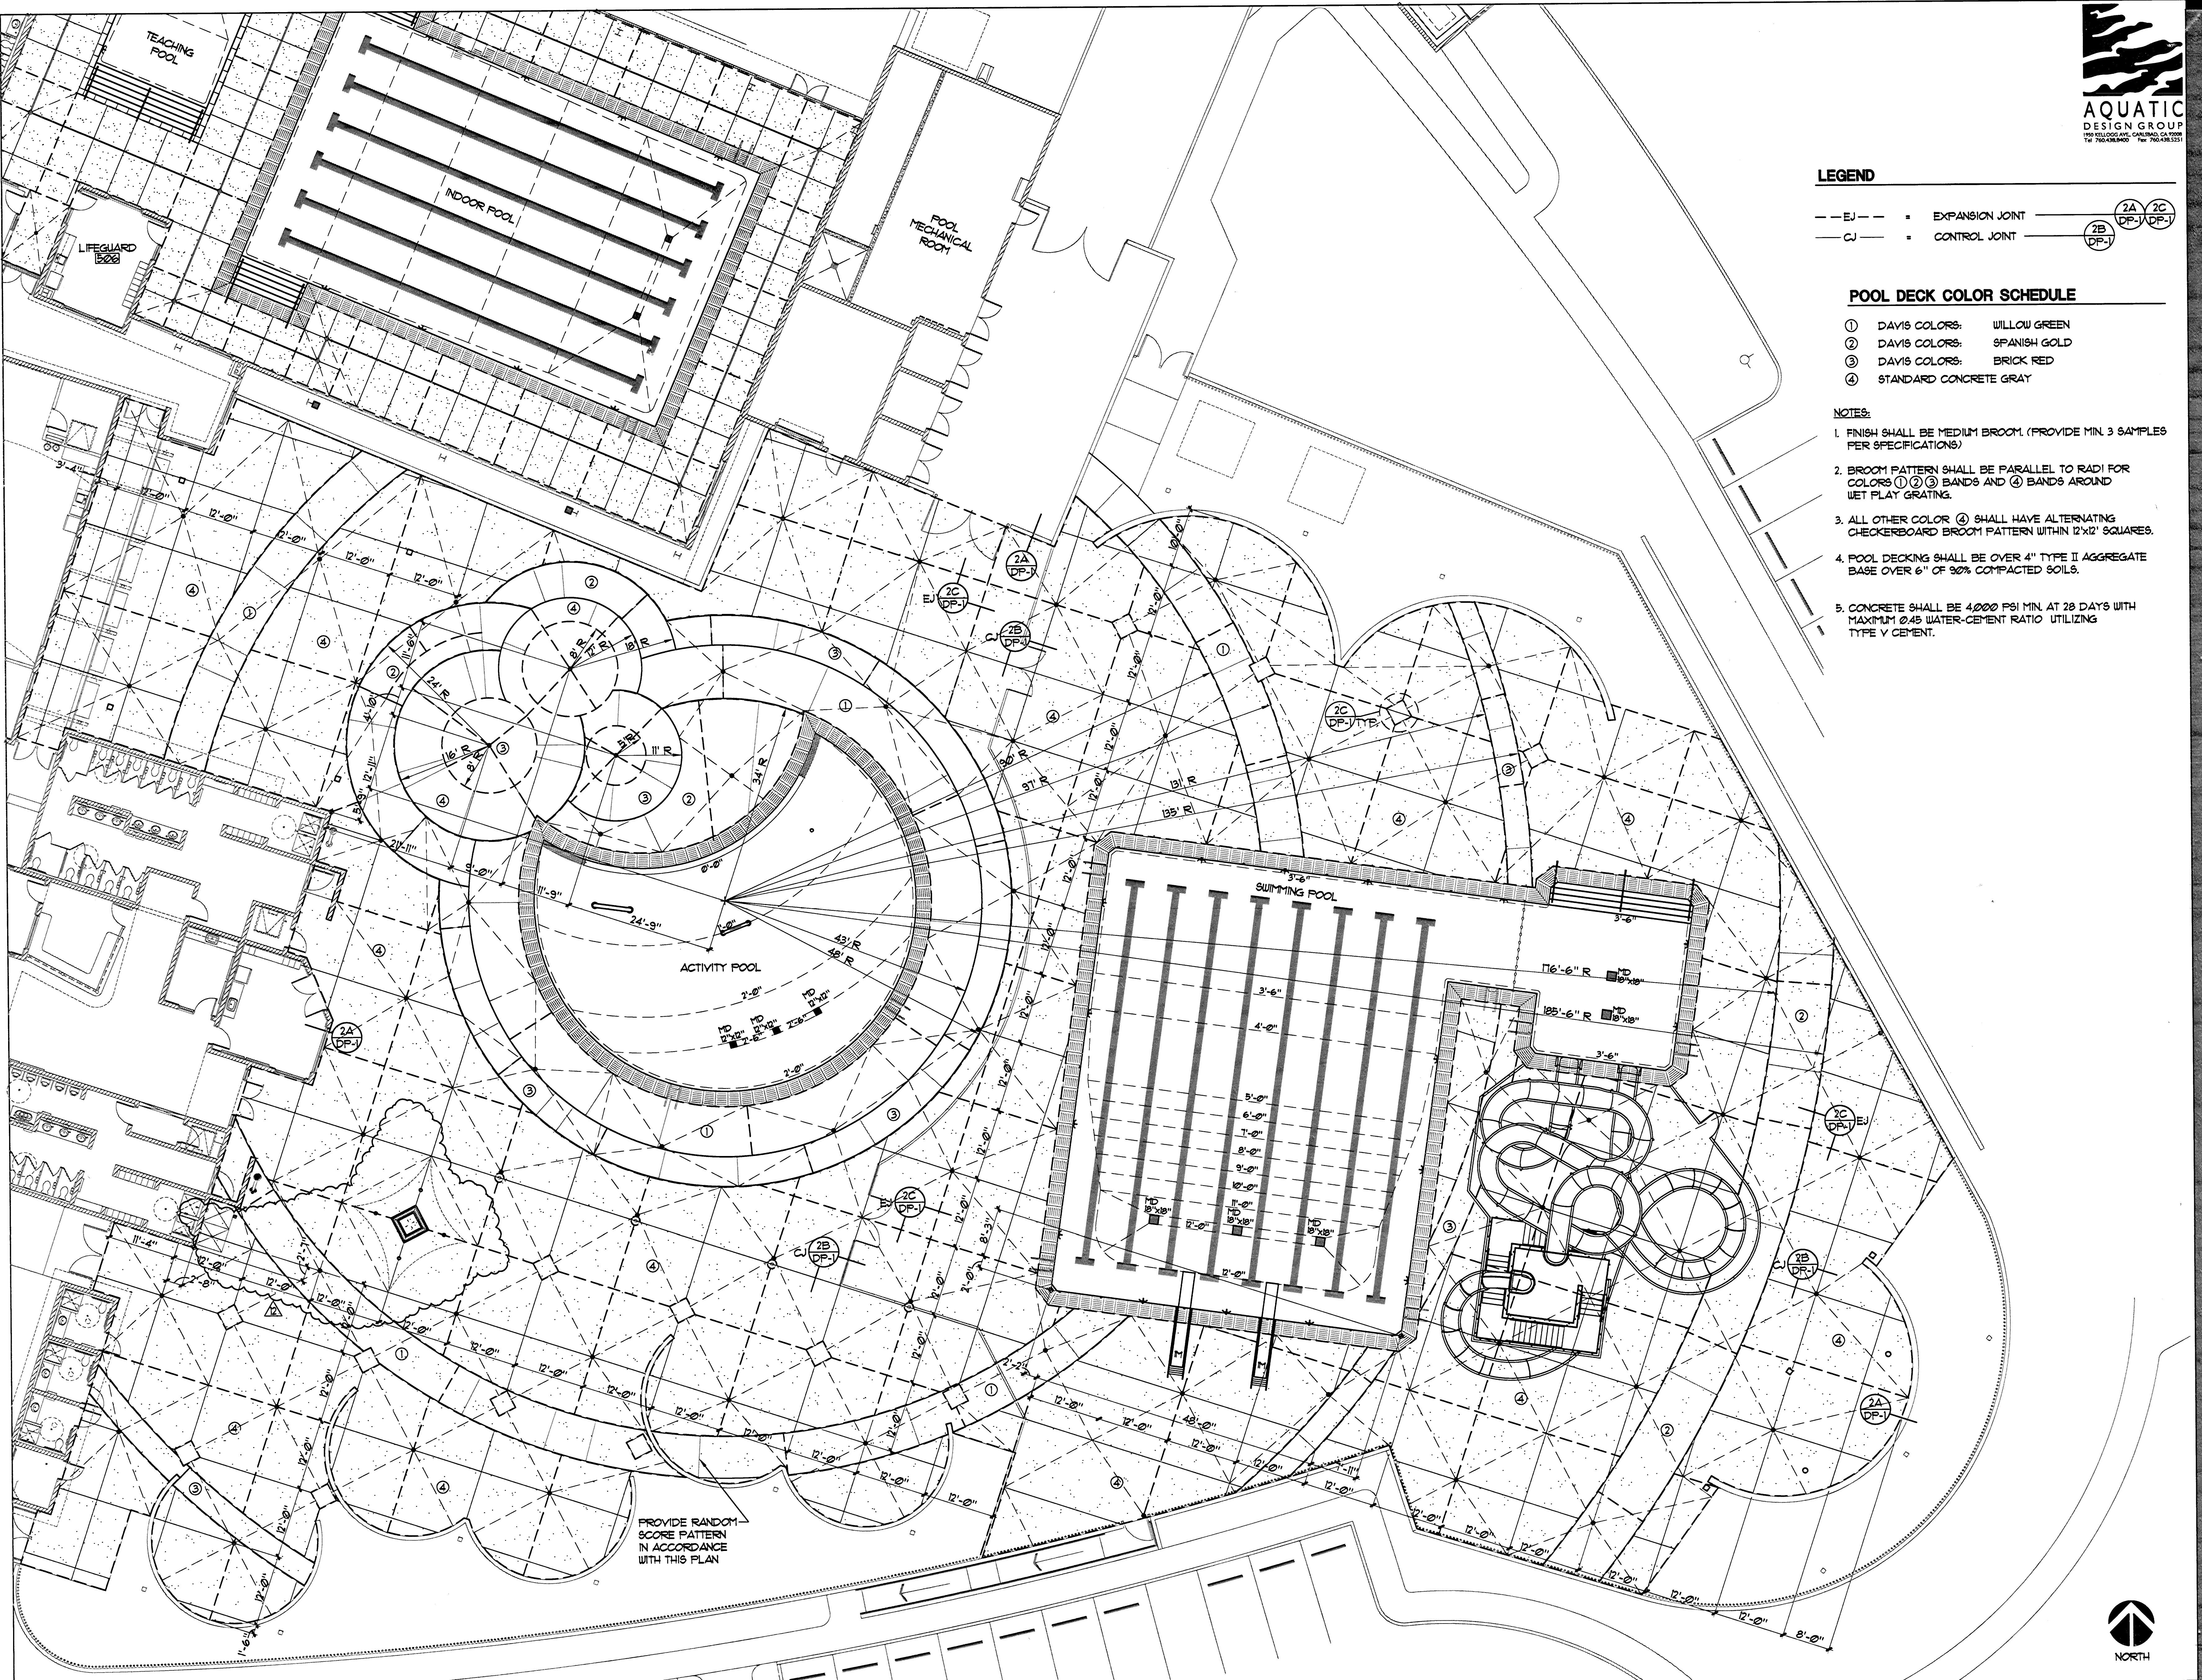

ACTIVITY/SWIMMING POOL DECK PLAN (HORIZONTAL CONTROL)

1"=10'-0"

1

12-15-3
071 DP-2.TIF