



1900 KELLGROVE, CARLSBAD, CA 92008
TEL 760-438-8900 FAX 760-438-8321

200 FLOTT ROAD, SUITE A
LAS VEGAS, NEVADA 89119
702-885-2711 FAX
702-885-8111

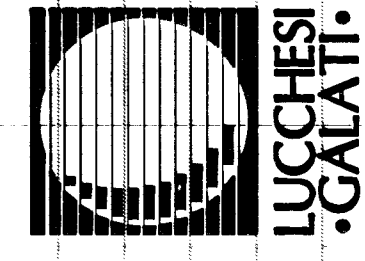

Disclaimer: These record drawings prepared by Lucchesi Galati Architects, Inc. are based on information provided by others. Lucchesi Galati Architects, Inc. has not verified the accuracy and/or completeness of its information supplied by others, and shall not be responsible for any errors or omissions, which may be incorporated herein as a result.

CITY OF LAS VEGAS
CENTENNIAL HILLS COMMUNITY CENTER
RECORD DRAWINGS
MECHANICAL
DETAILS

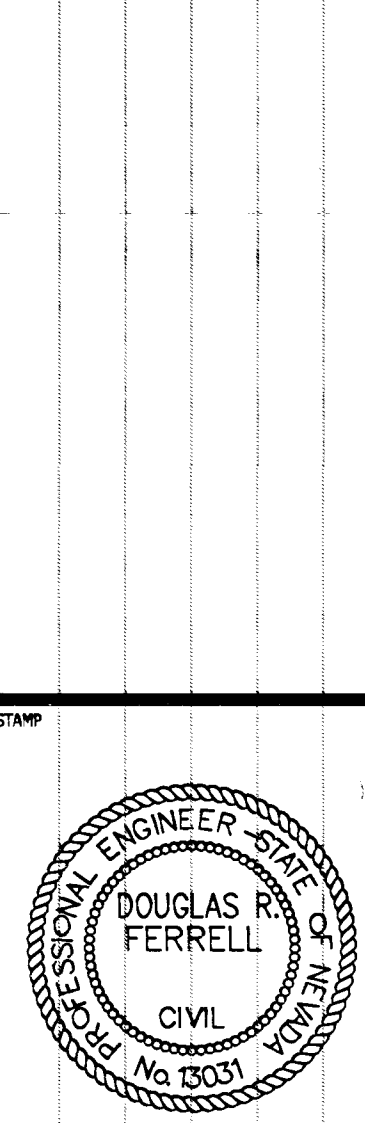


OWNER: CITY OF LAS VEGAS
DEPARTMENT OF PUBLIC WORKS
ARCHITECTURAL SERVICES


400 EAST STEWART AVENUE
LAS VEGAS, NEVADA 89101
PHONE: (702) 229-8535
FAX: (702) 388-8186
TDD: (702) 388-8108

DATE	REV
03/08/05	CE-MB
AS NOTED	
NO	051534101
REV	671-49


MR-3

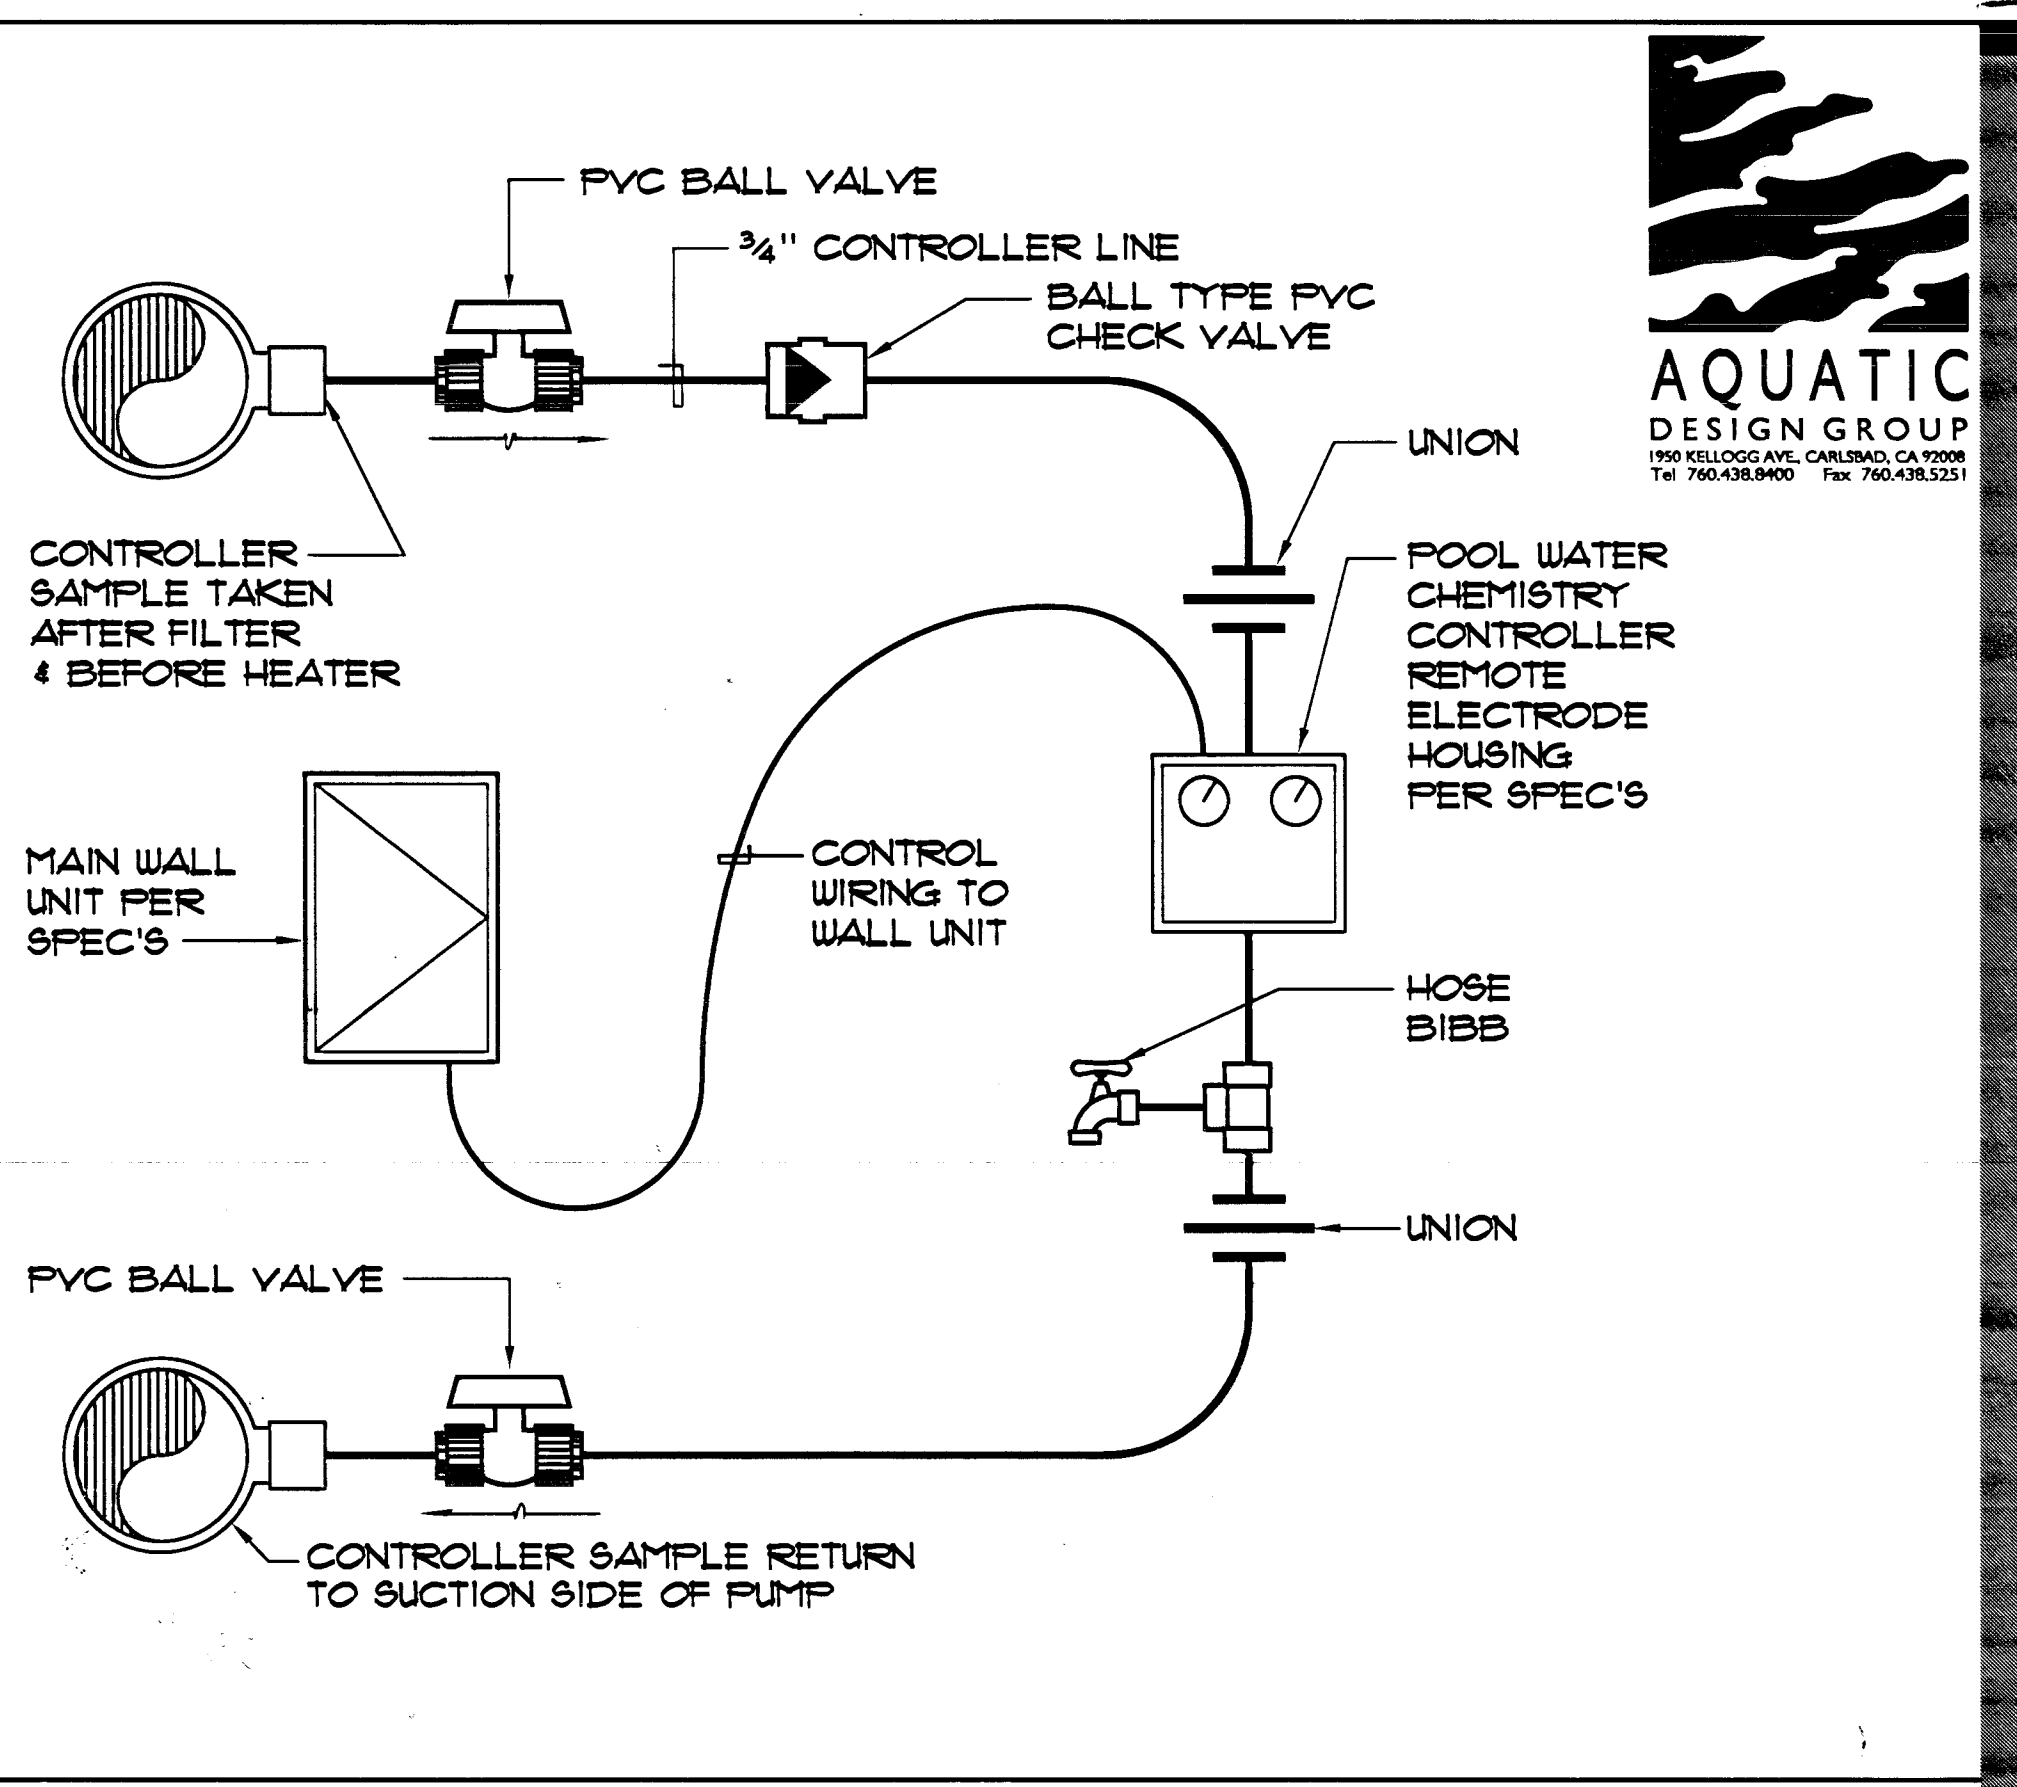


3 POOL WATER CHEMISTRY CONTROLLER SCHEMATIC NO SCALE

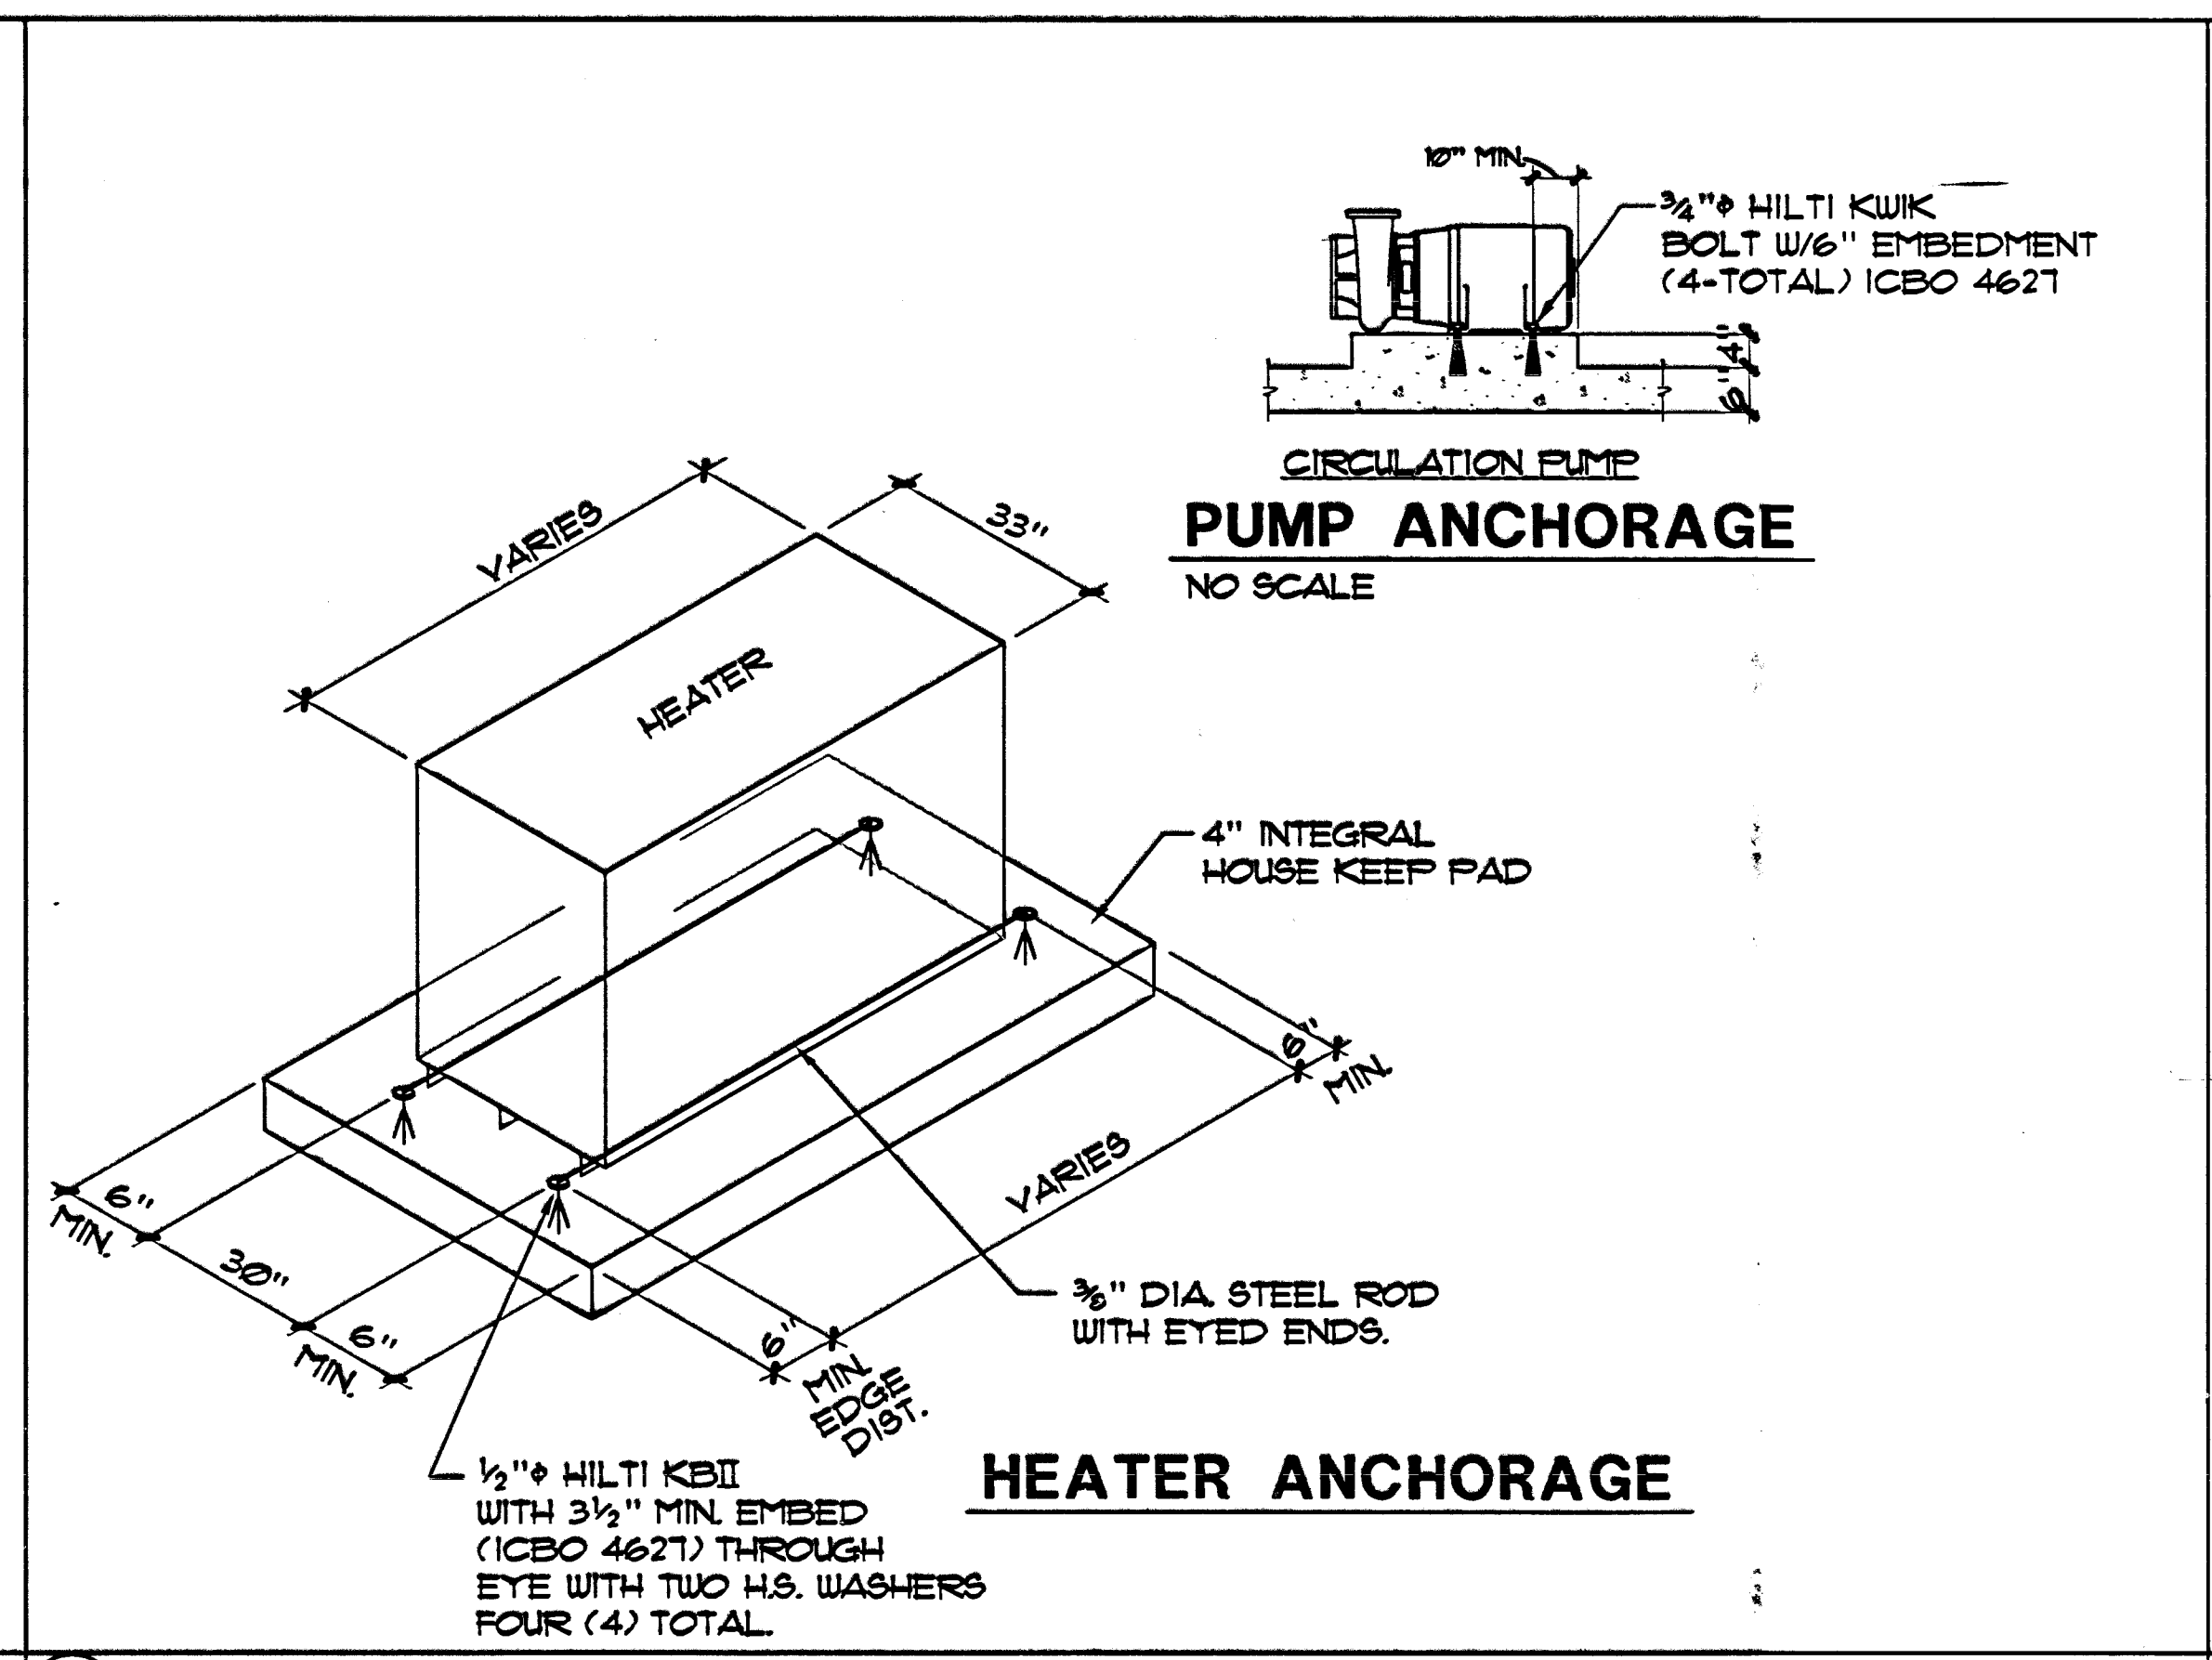


2 ANCHORAGE DETAILS NO SCALE

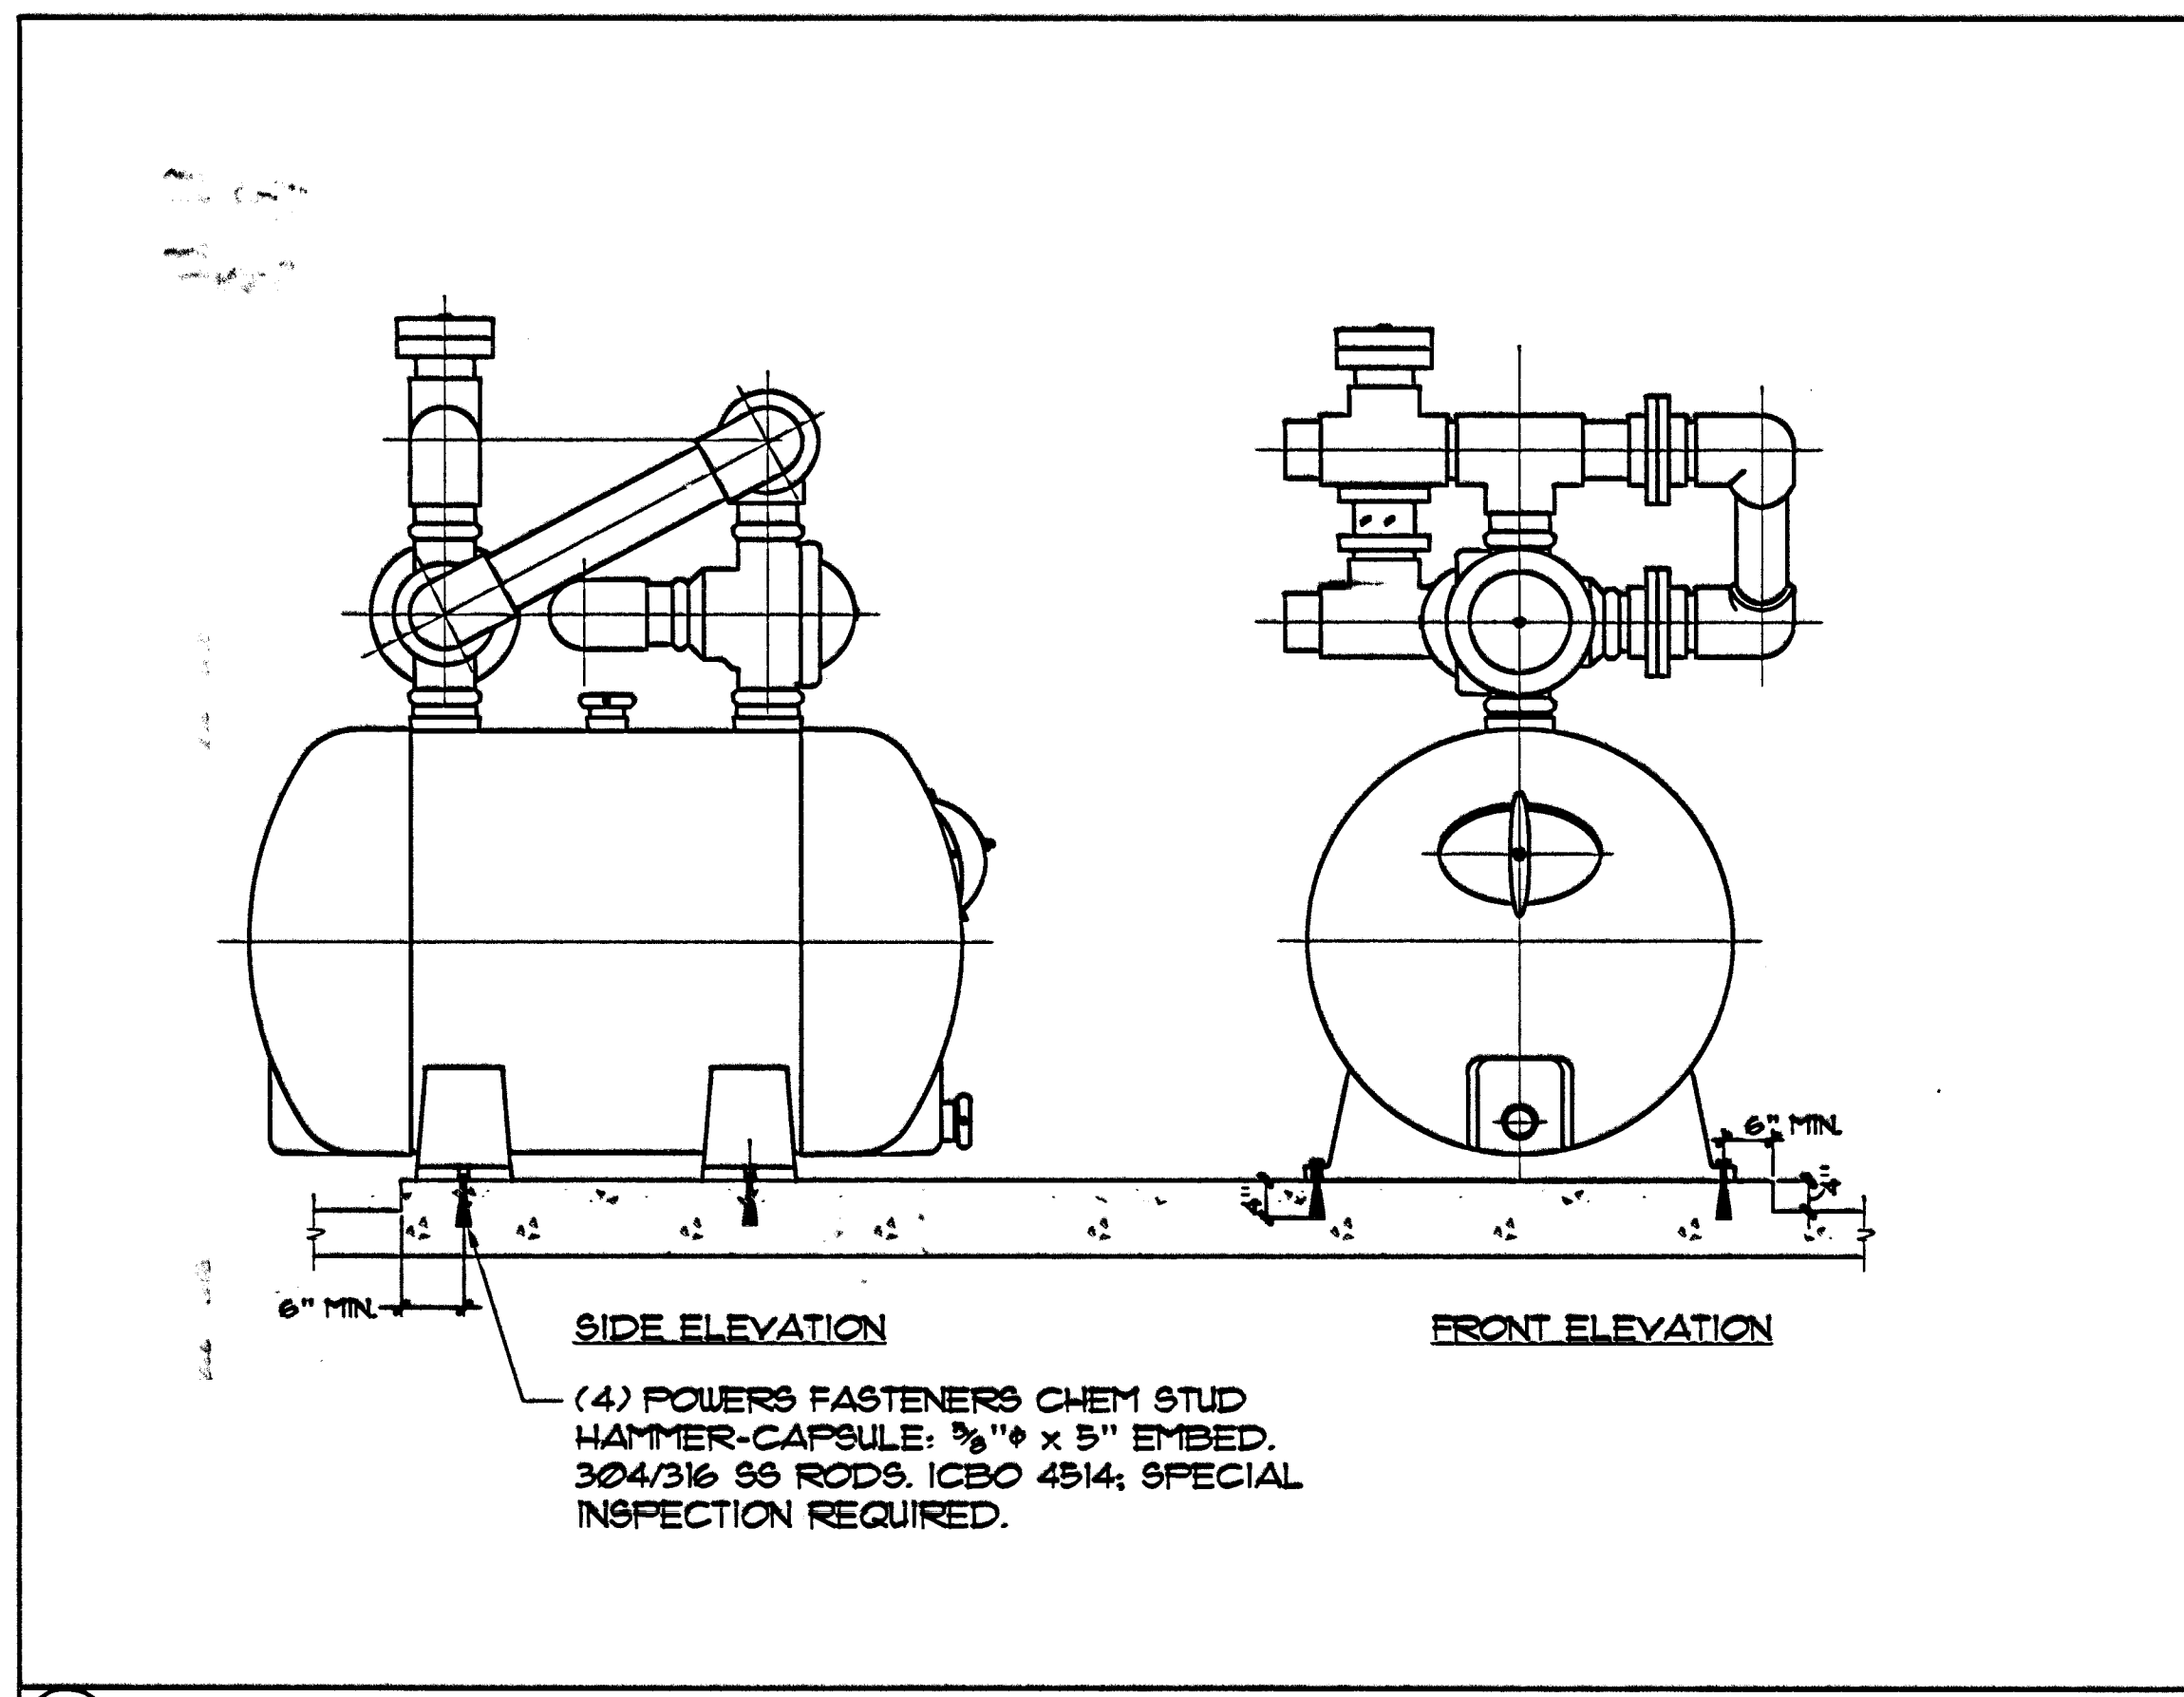


1 FILTER ANCHORAGE NO SCALE

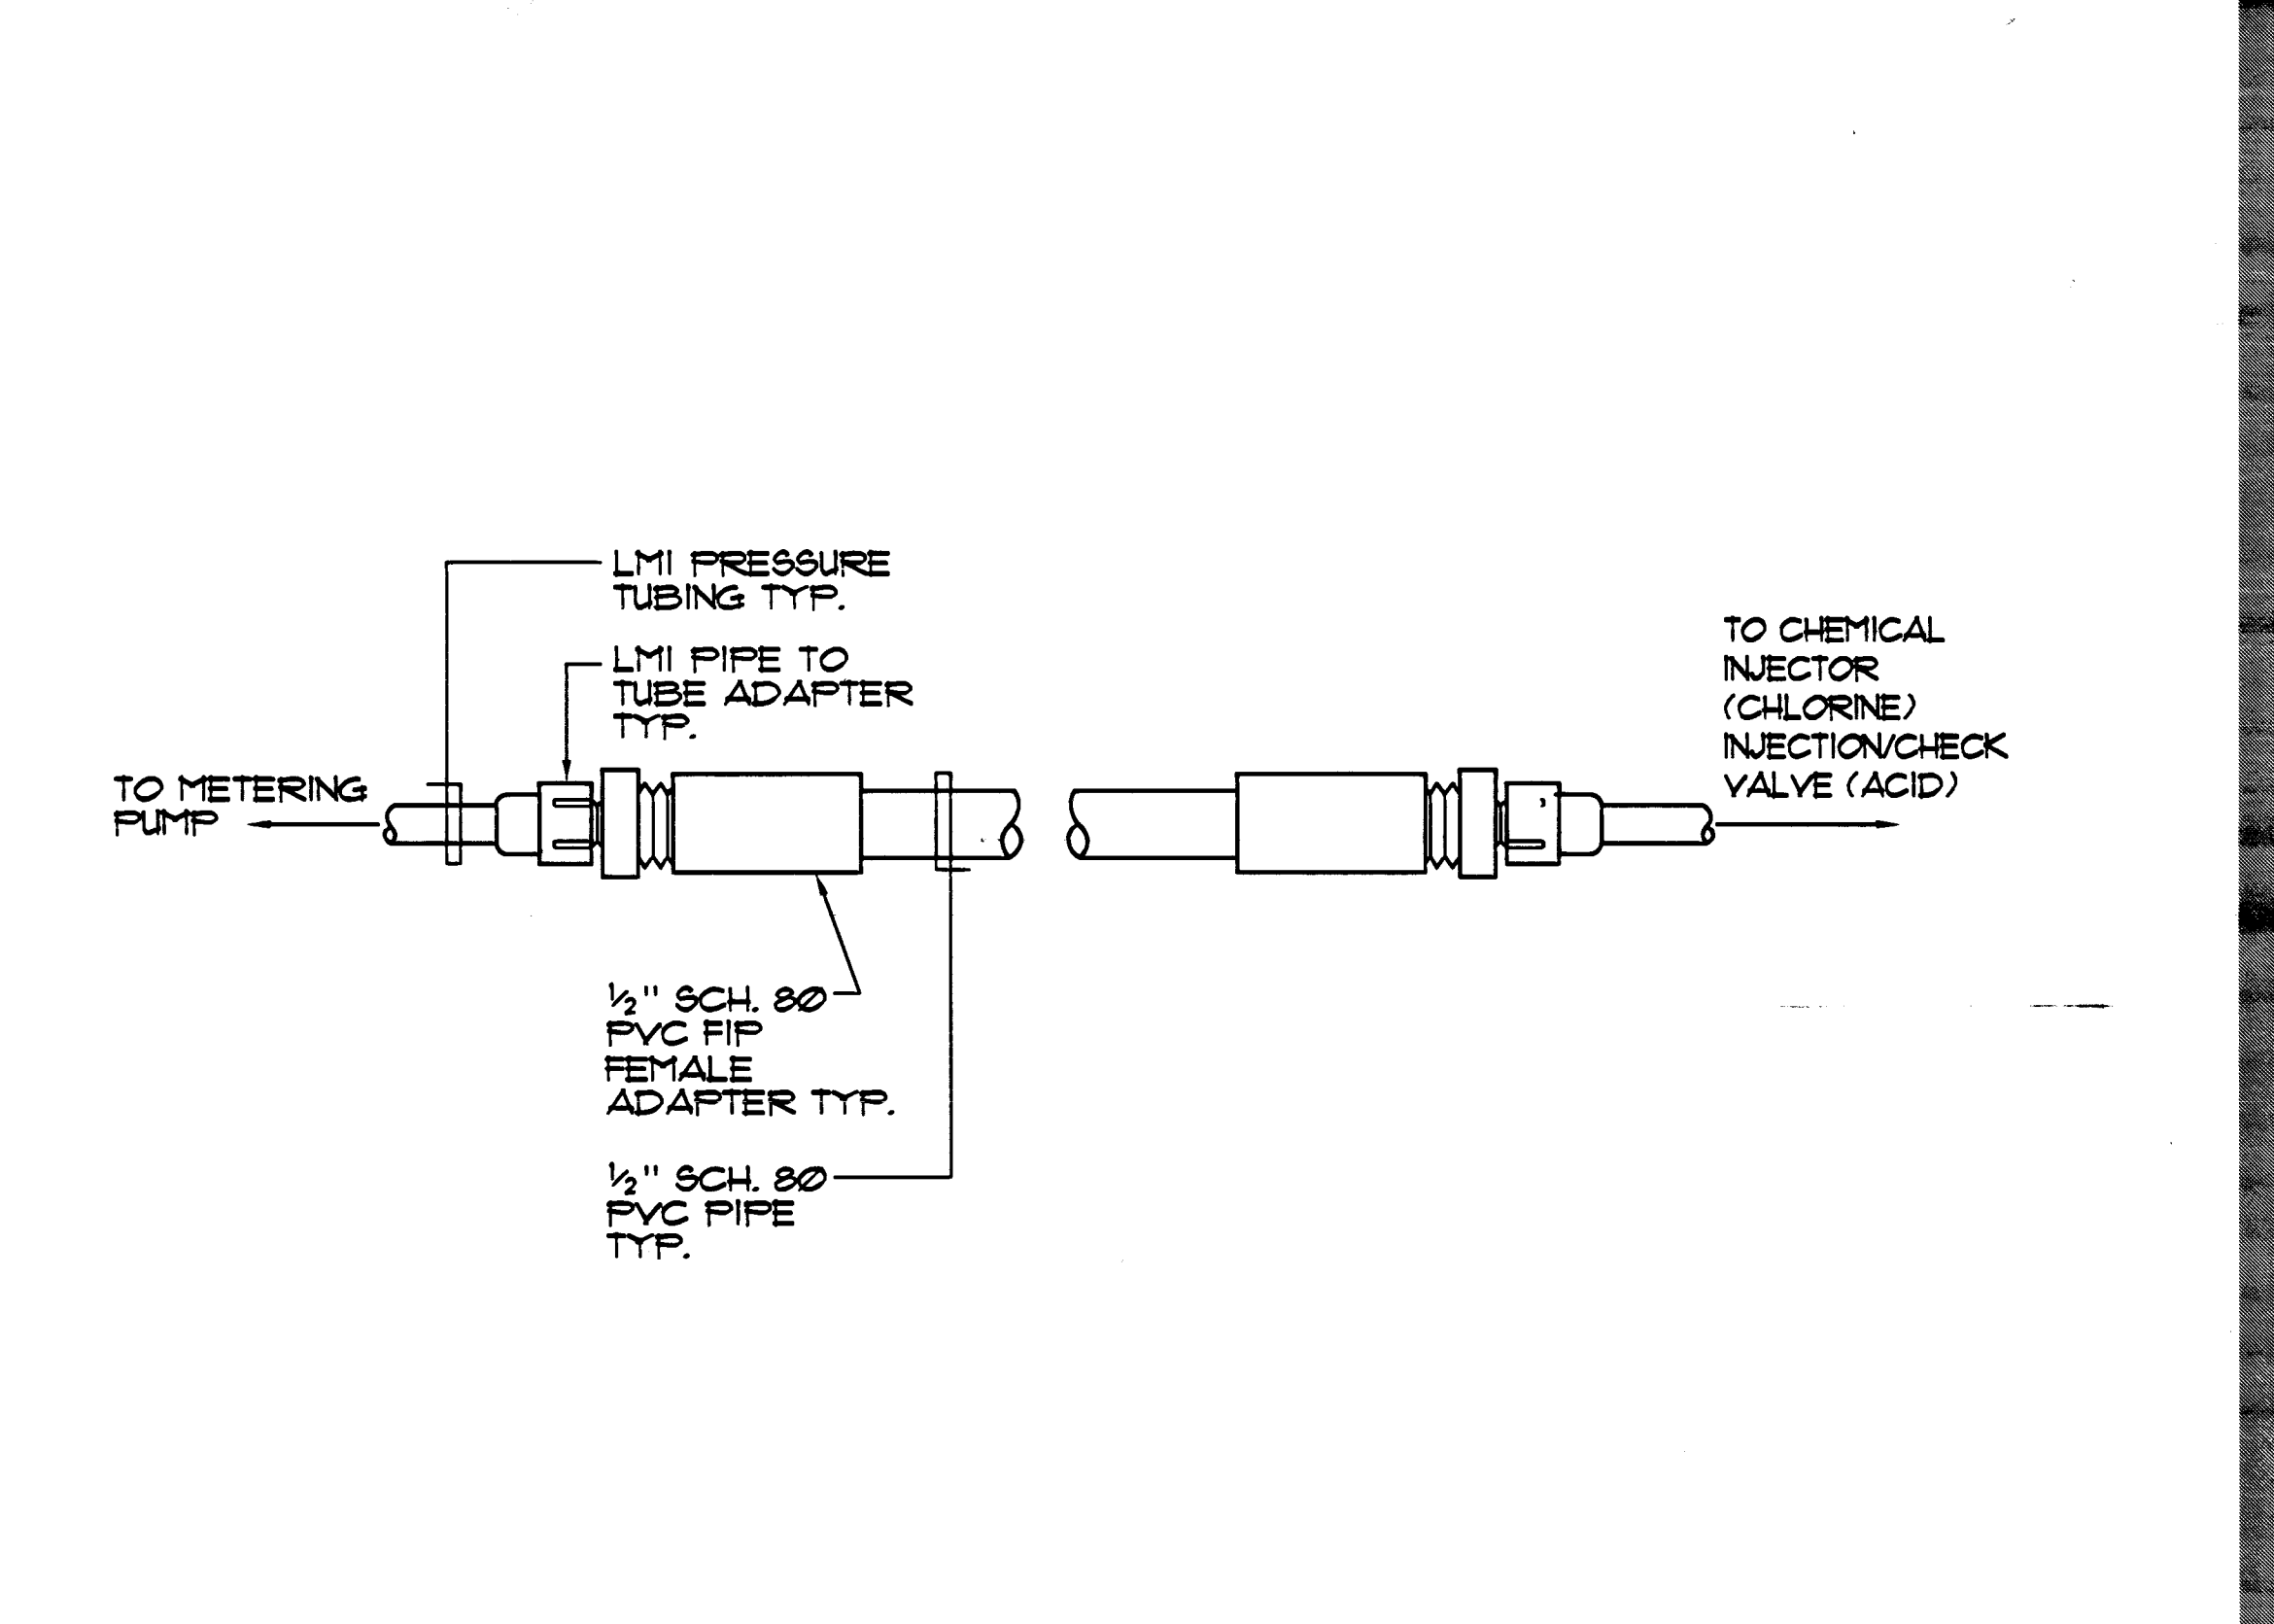


6 CHEMICAL FEED PIPING DETAIL NO SCALE

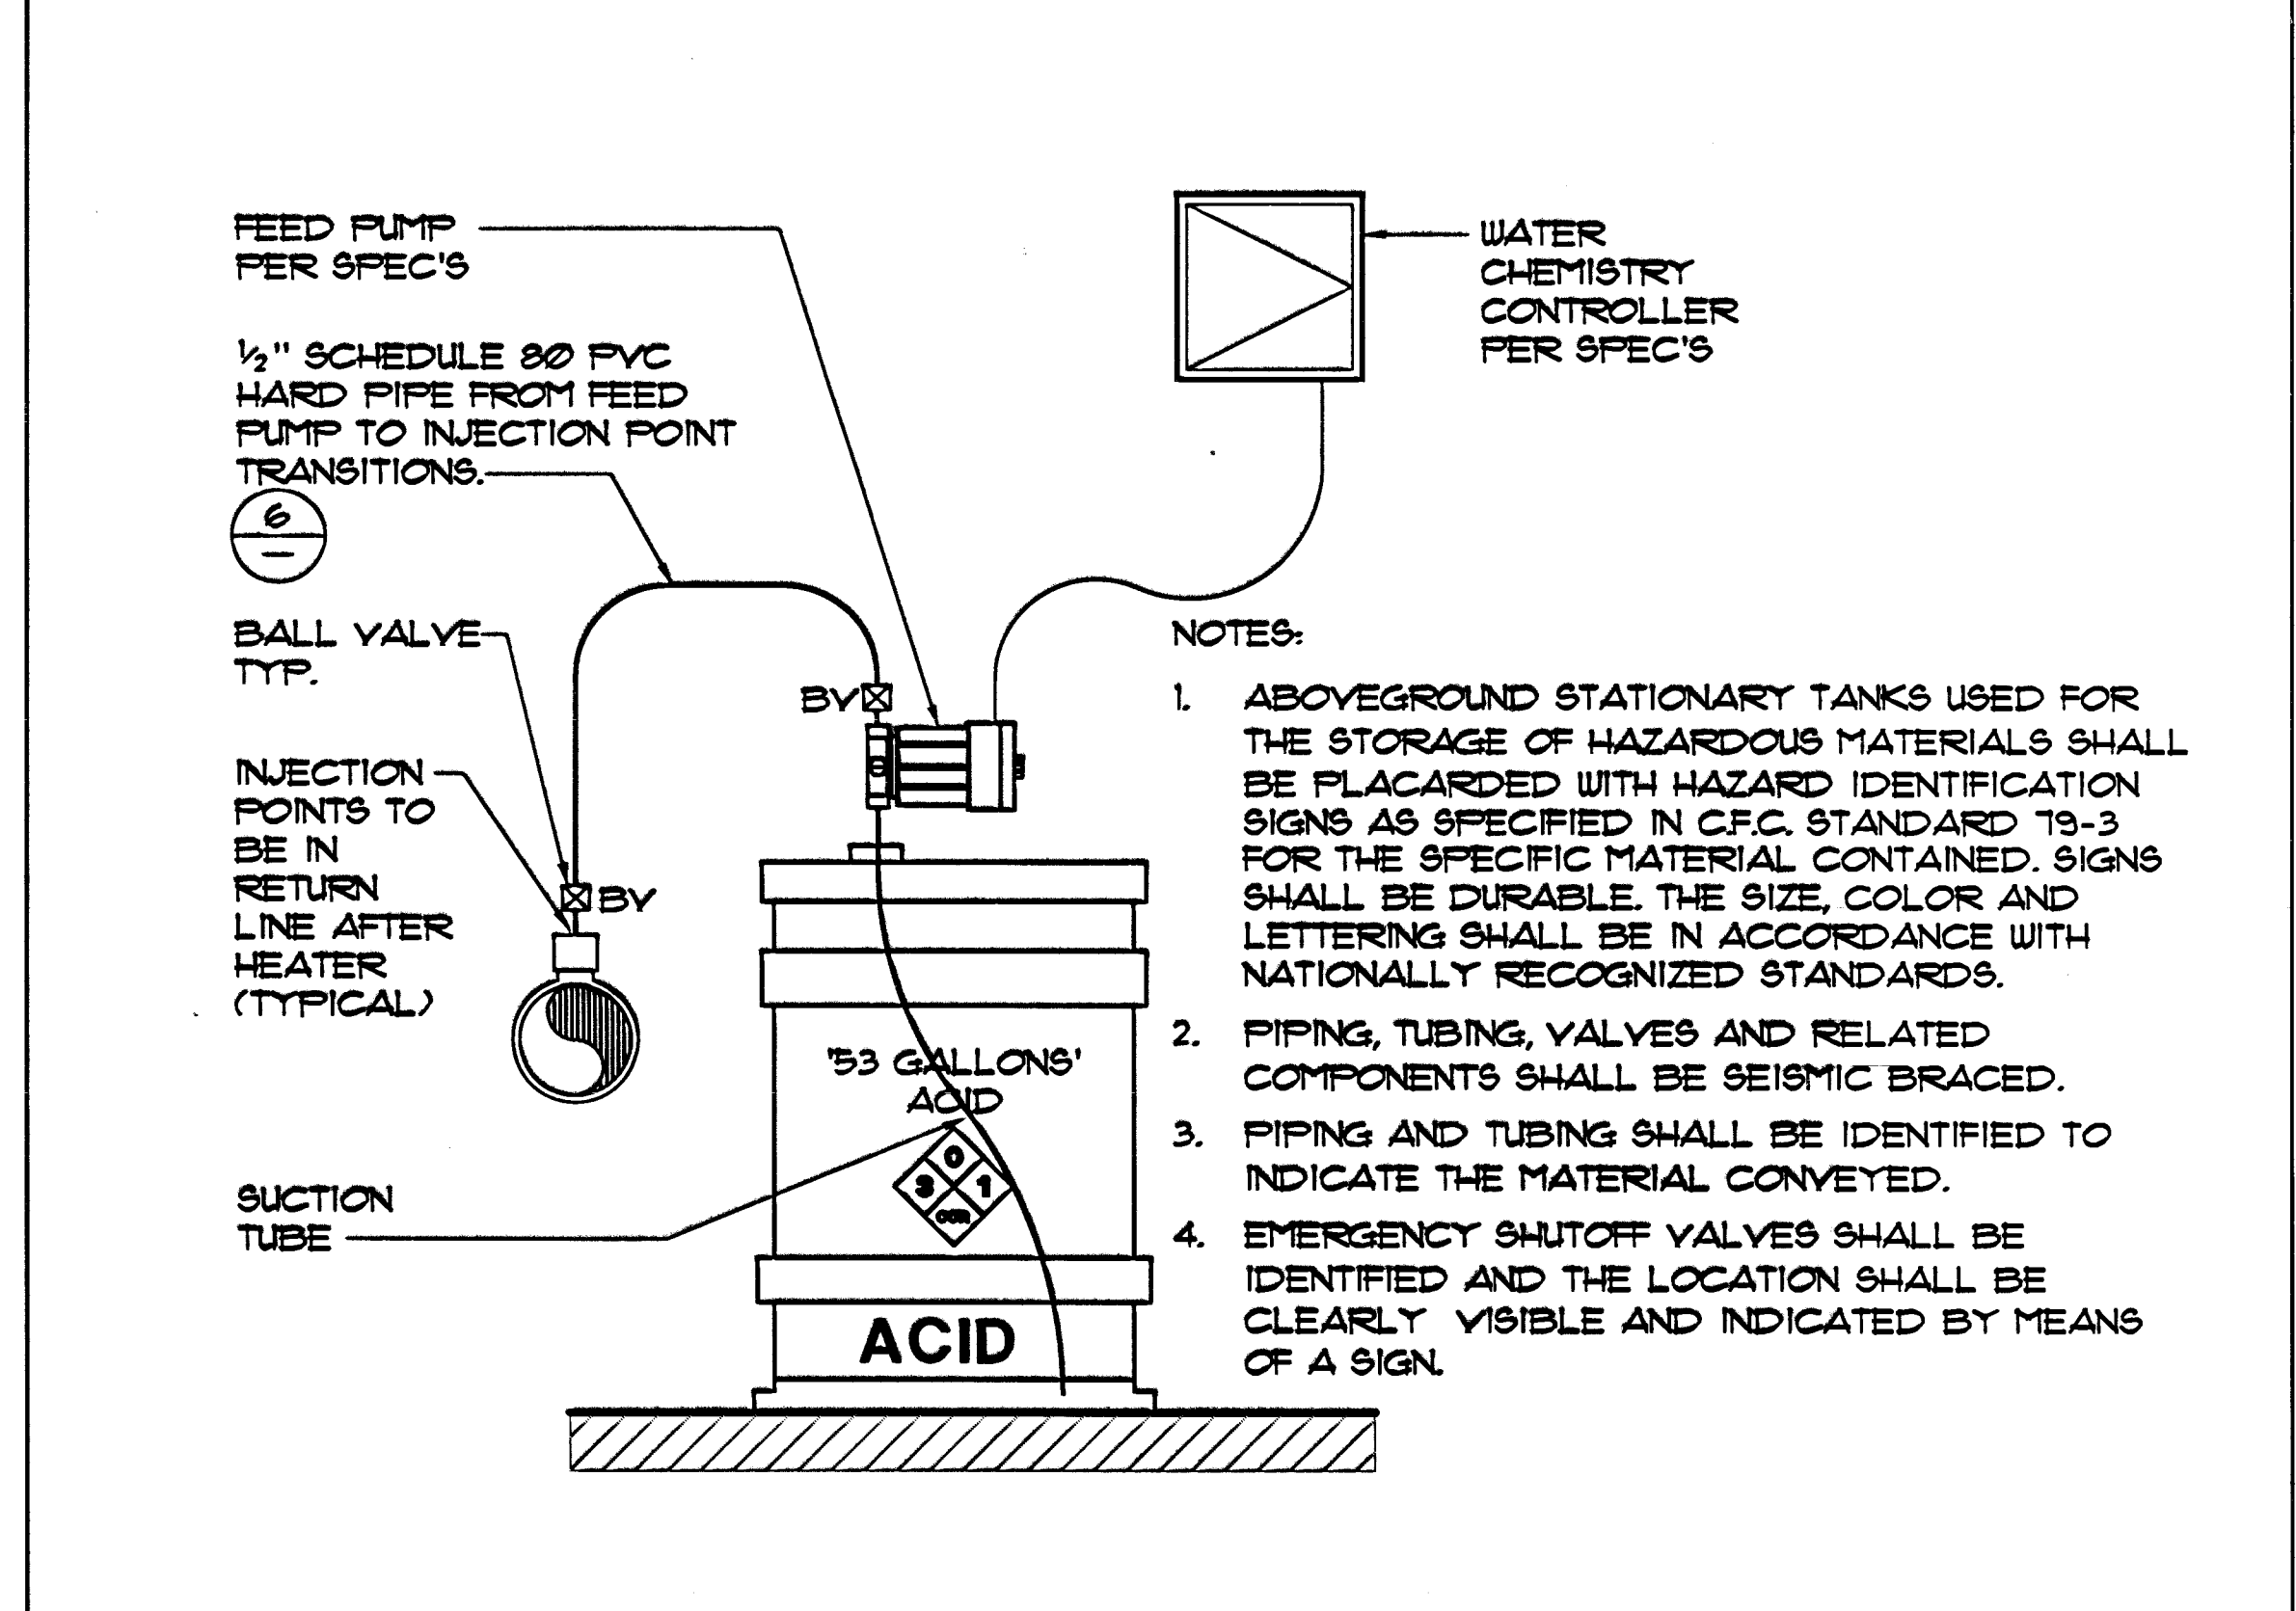


5 MURIATIC ACID FEED SCHEMATIC NO SCALE

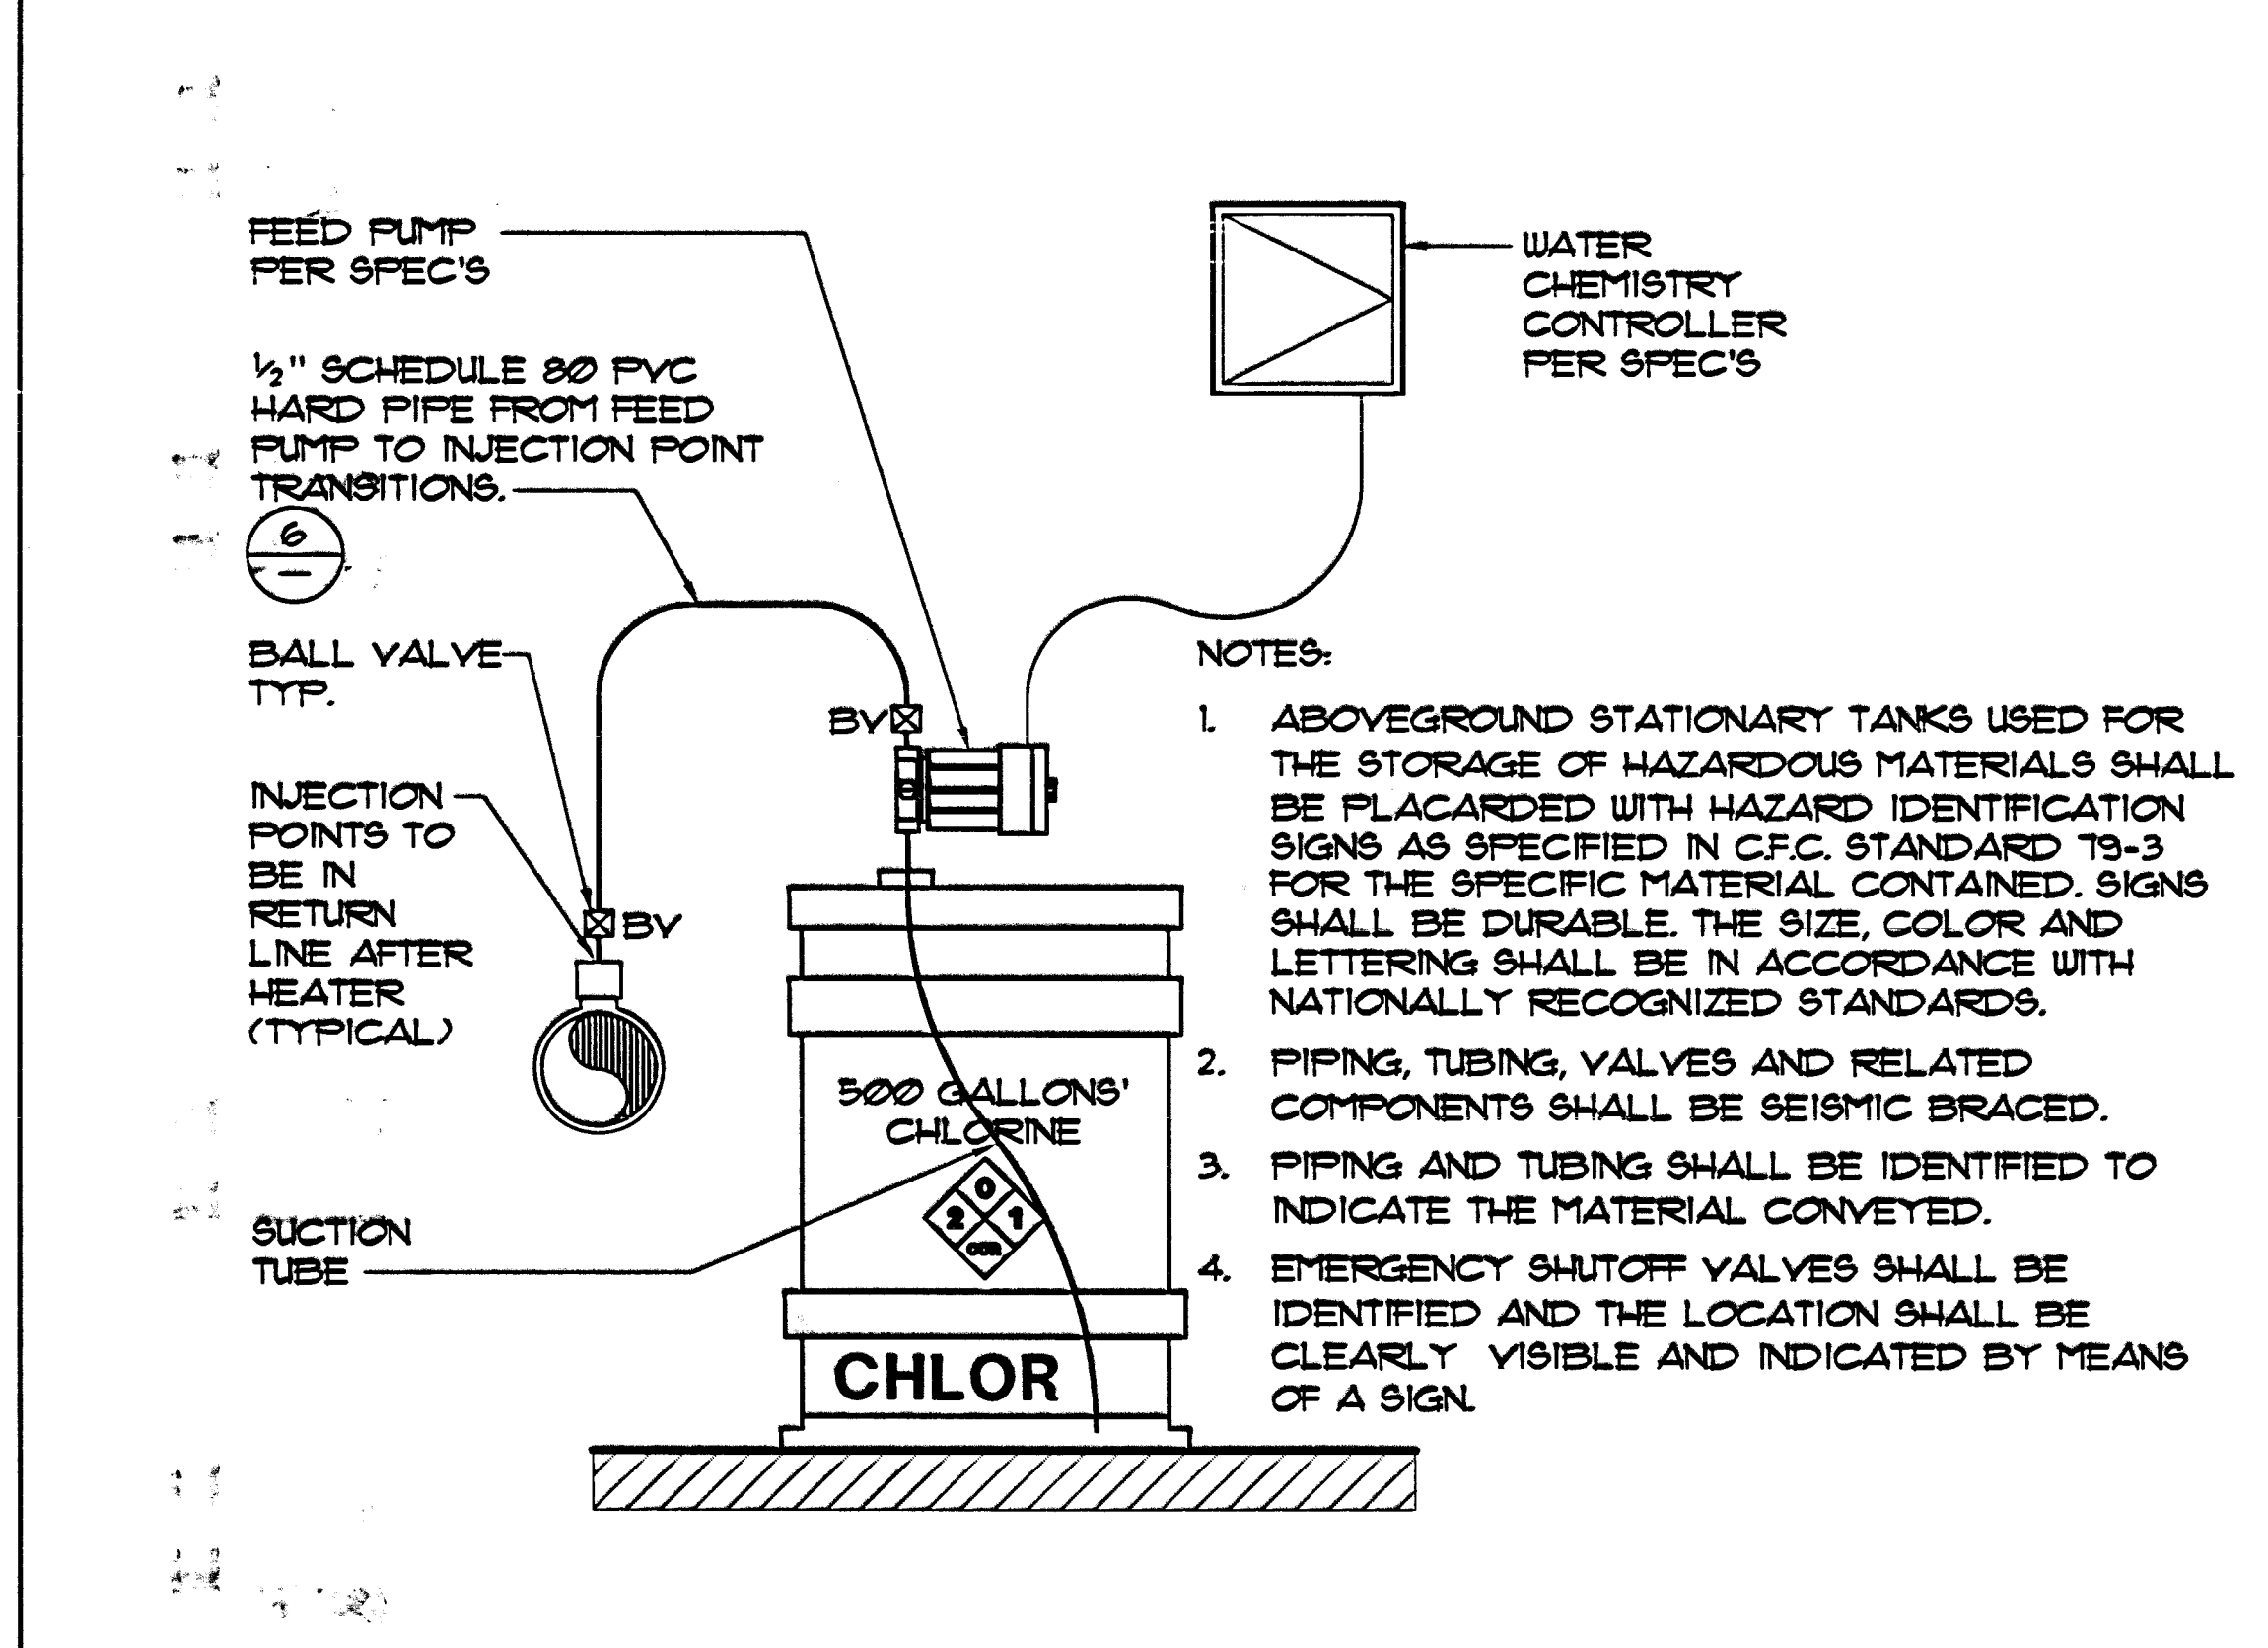


4 SODIUM HYPOCHLORITE FEED SCHEMATIC NO SCALE

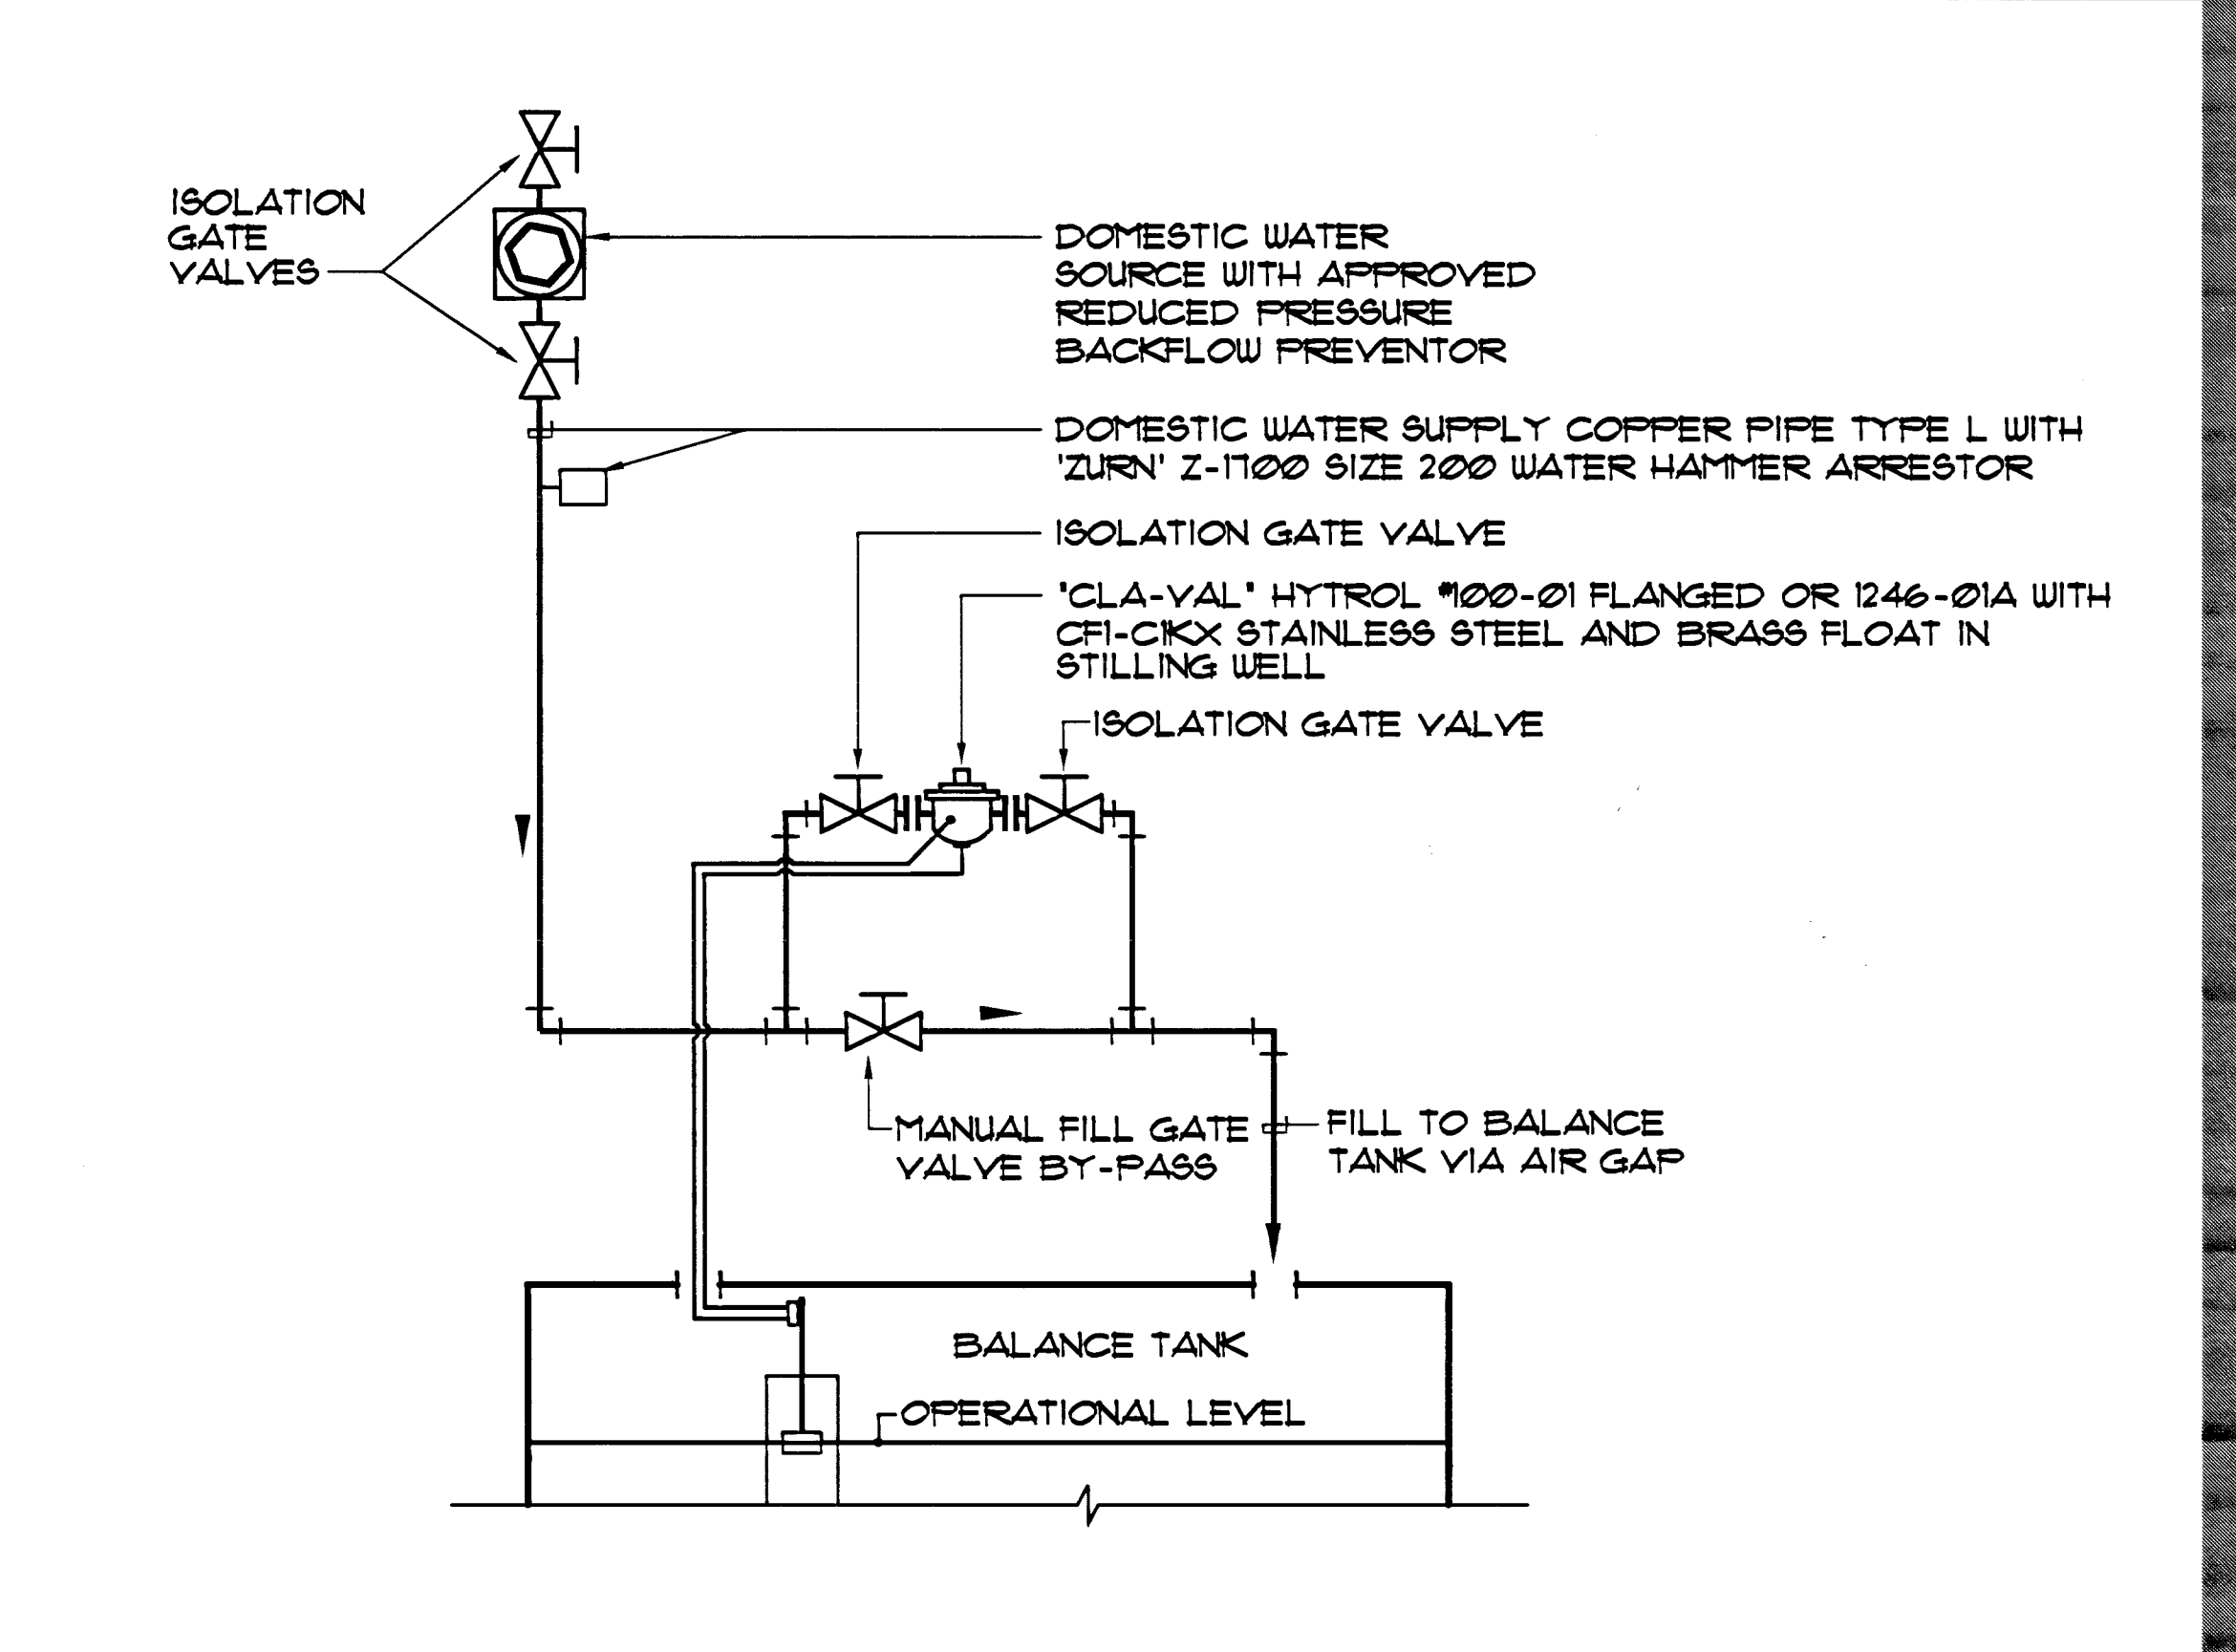

9 AUTOMATIC/MANUAL WATER MAKE-UP SCHEMATIC NO SCALE

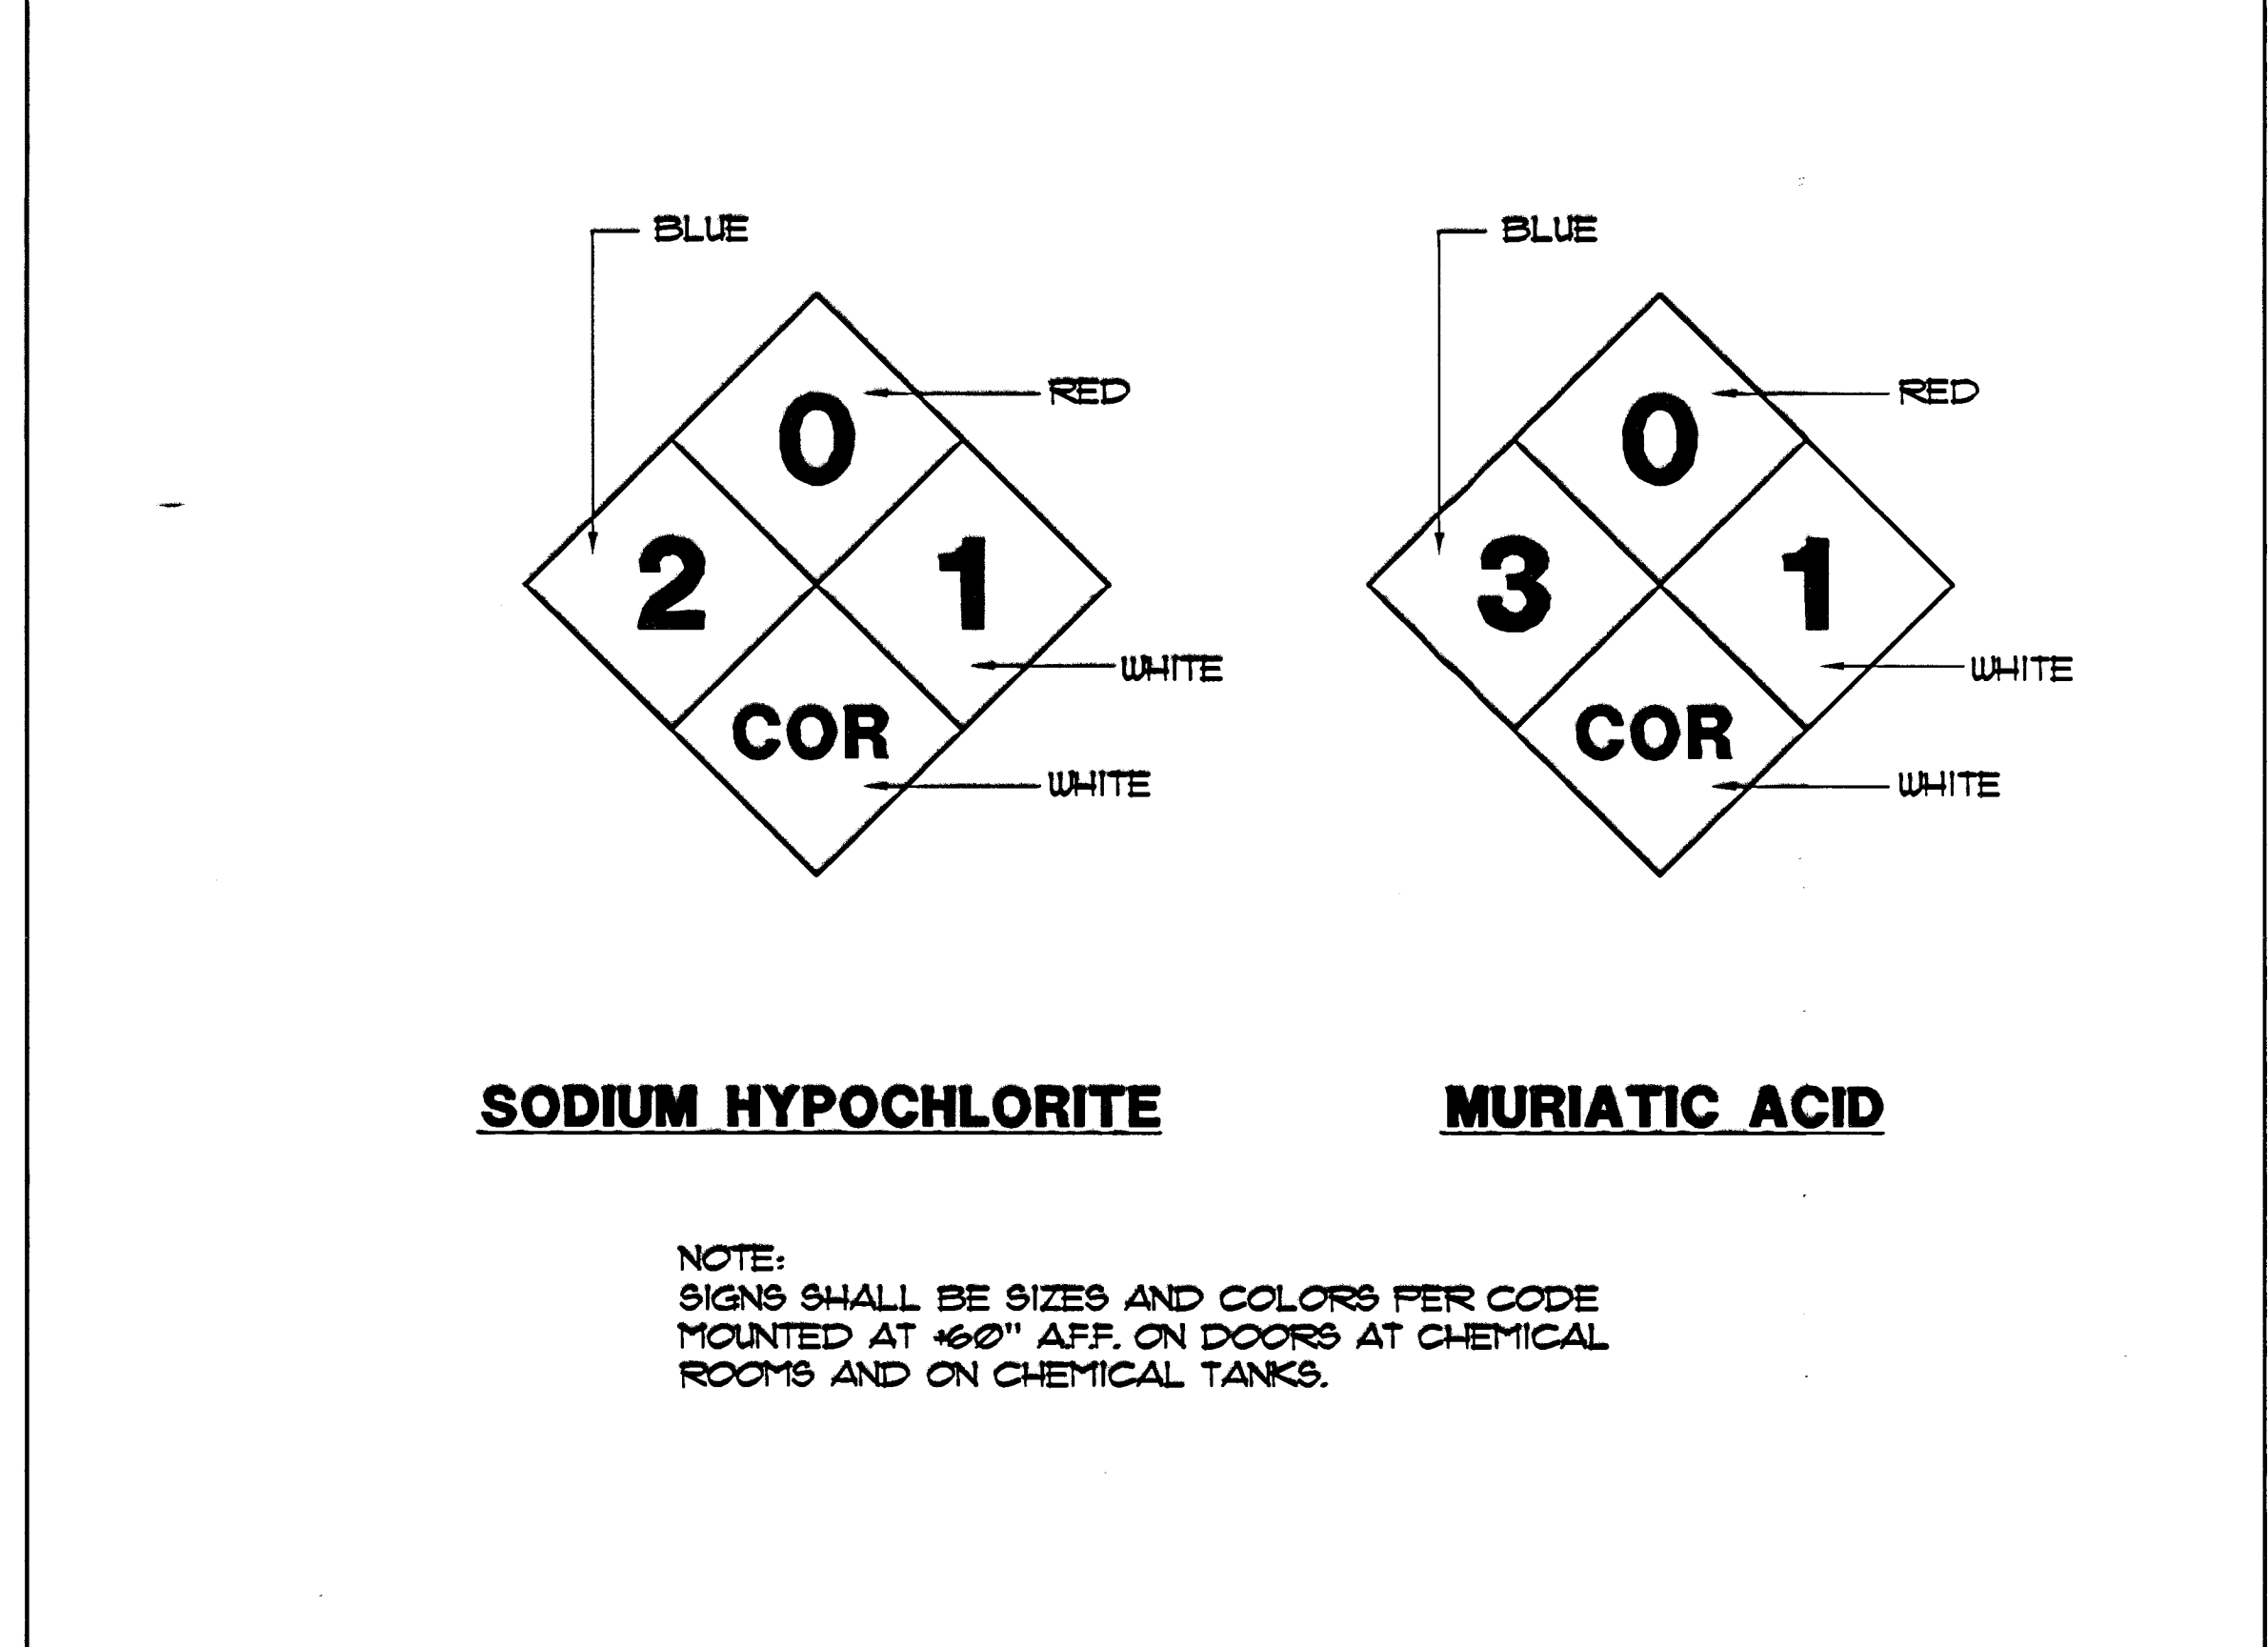

8 HAZARDOUS INFORMATION SIGNAGE NO SCALE

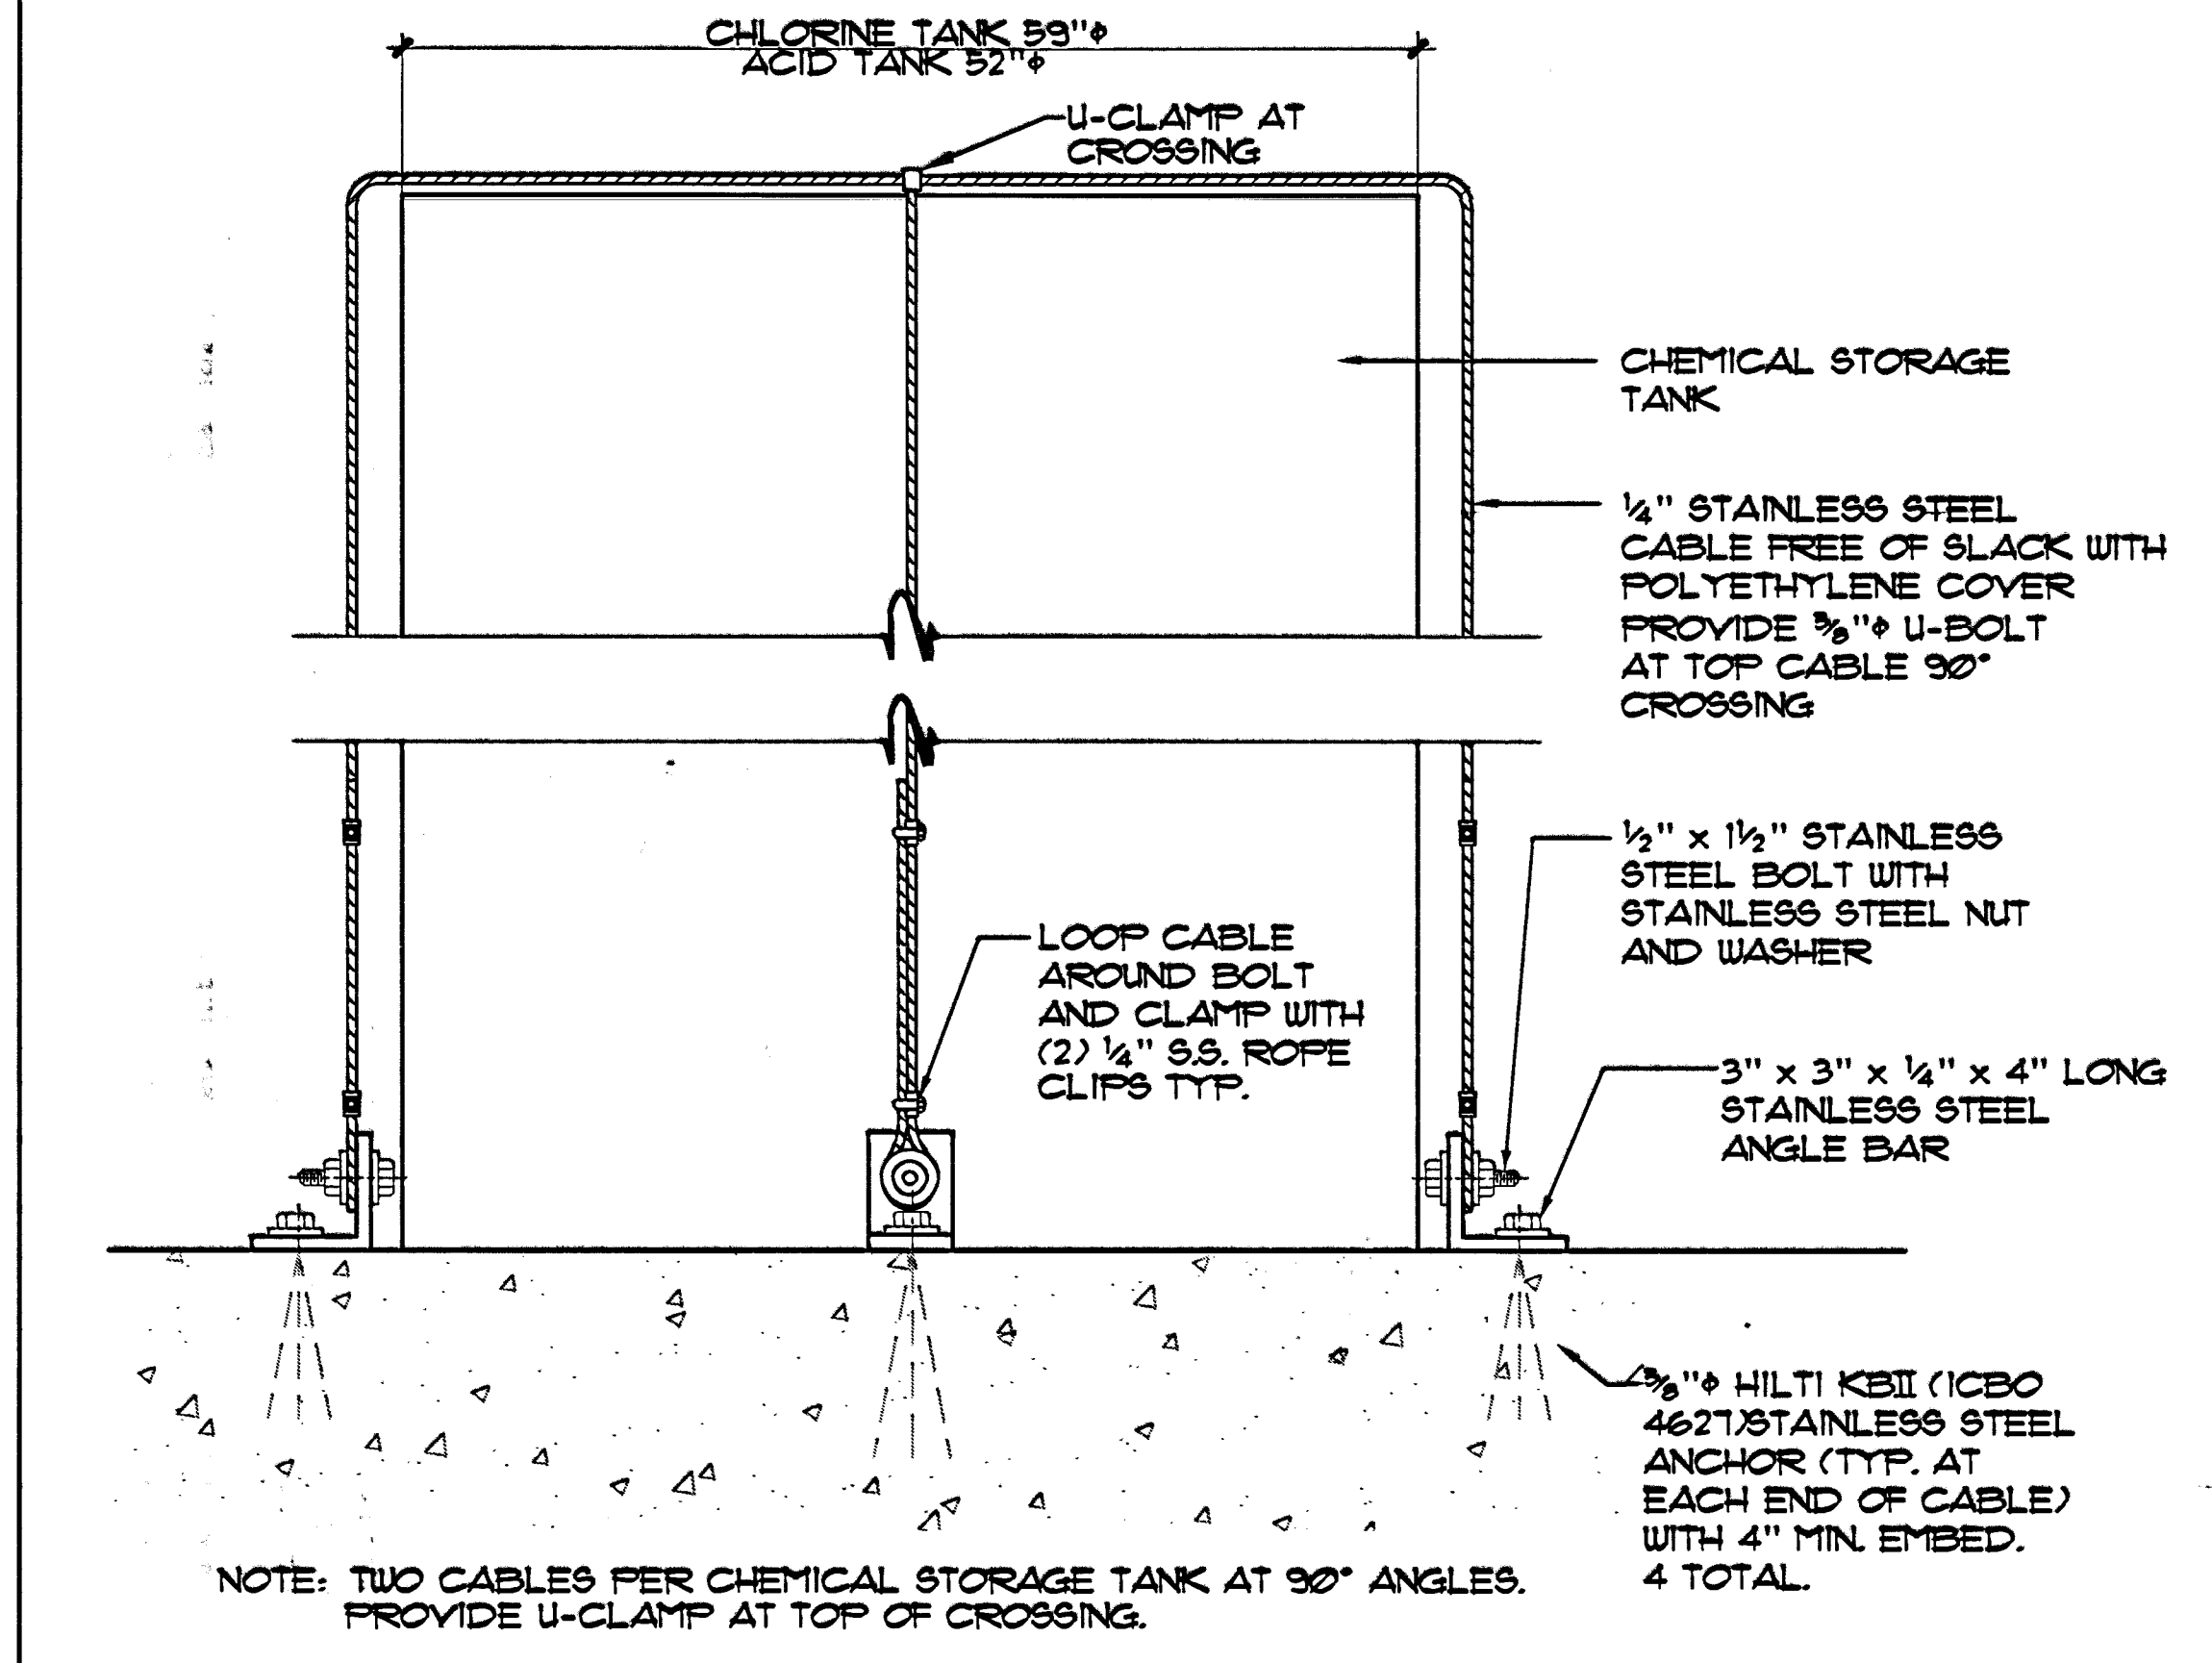

7 CHEMICAL TANK ANCHOR NO SCALE

12-157
020 MAR 21 11