


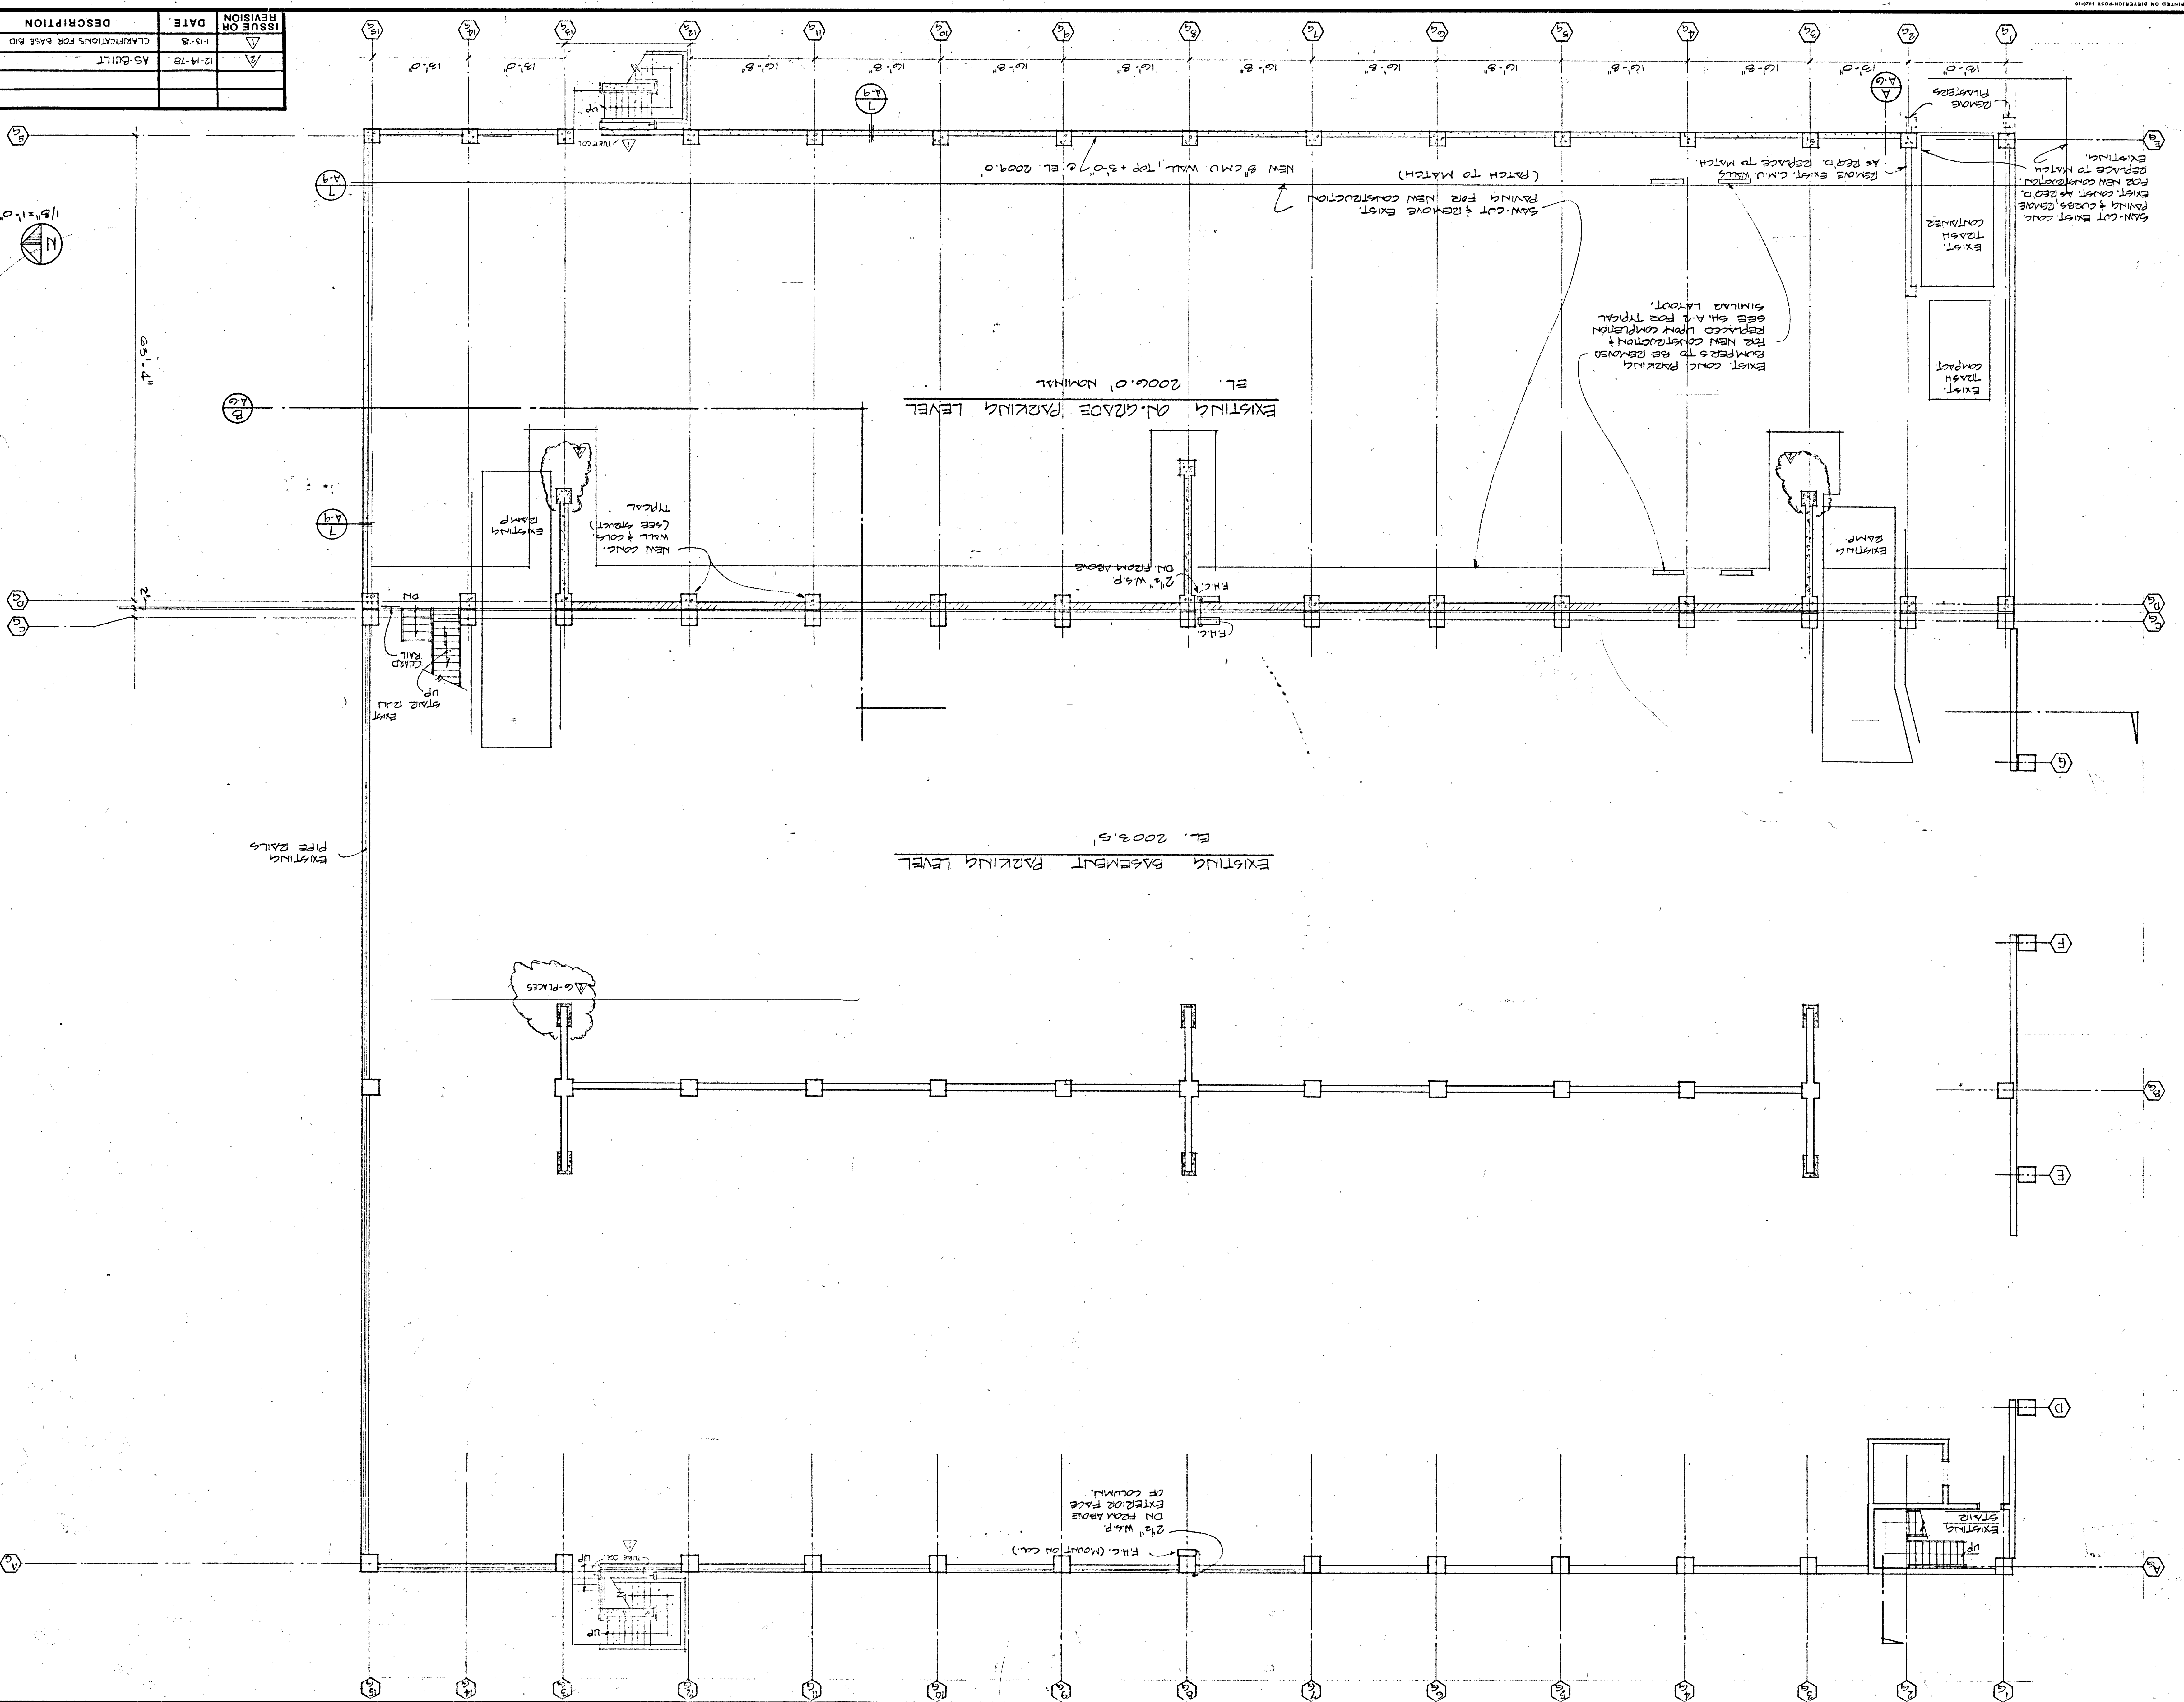

REVISION	DATE	DESCRIPTION
1-13-75	12-14-79	AS-BUILT
2-14-79		CLARIFICATIONS FOR BASE BID

A-1

SHEET NO.

CHECKED

DRAWN

ENGINEER

DATE

JOB NO.

SHEET TITLE

EXISTING BASEMENT & Q1-GRADE PARKING LEVELS

JOB TITLE

PARKING GARAGE ADDITION
LAS VEGAS CITY HALL
400 STEWART AVENUE
LAS VEGAS, NEVADA

MARTIN & CASHDAN

MARTIN & CASHDAN
STRUCTURAL ENGINEERS
844 EAST SAHARA AVENUE
LAS VEGAS NEVADA 89104
TELEPHONE (702) 735-7166

CONSULTANT