
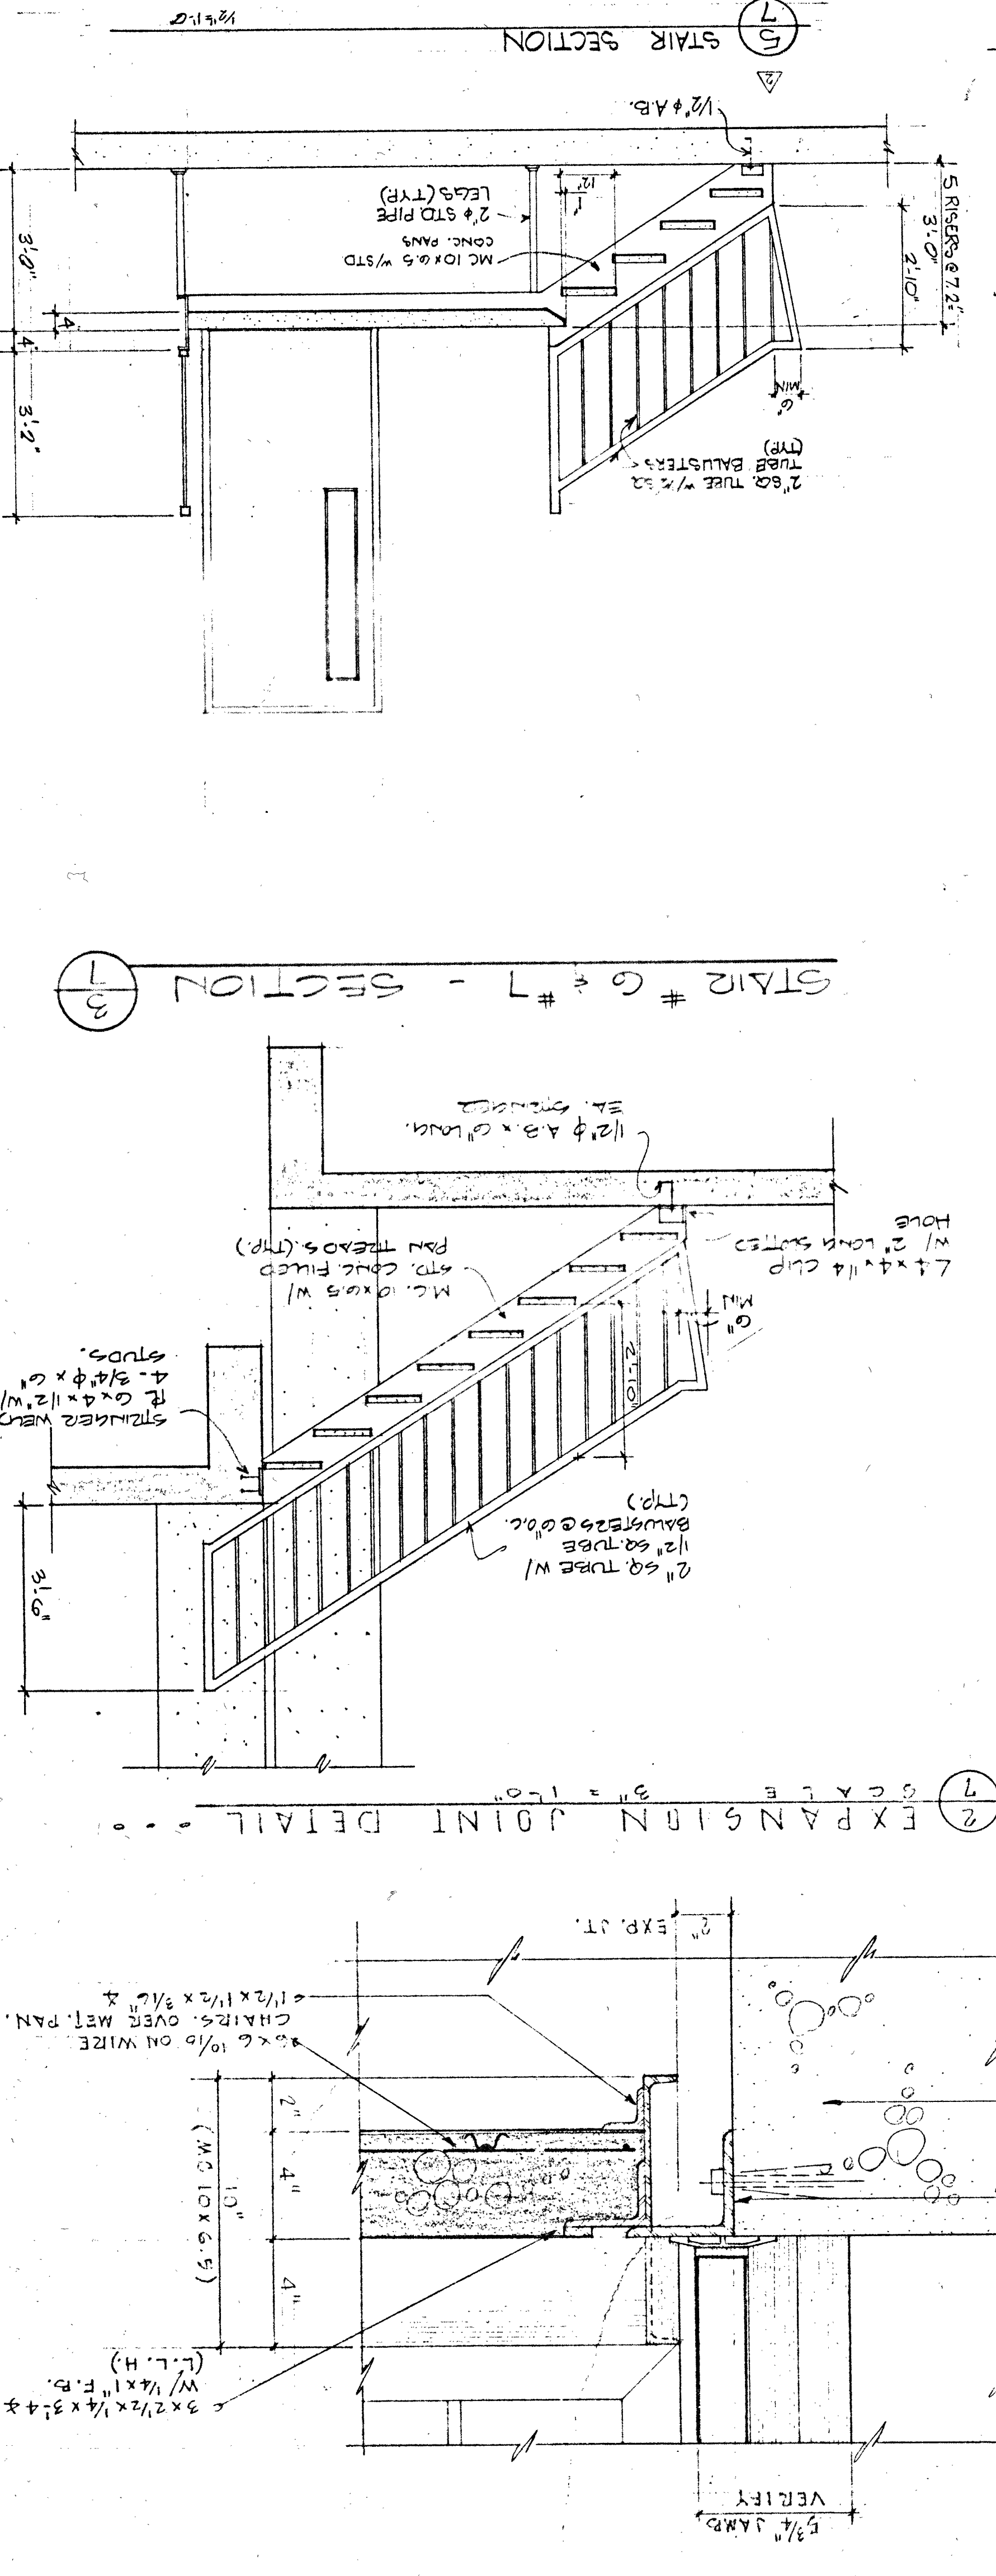
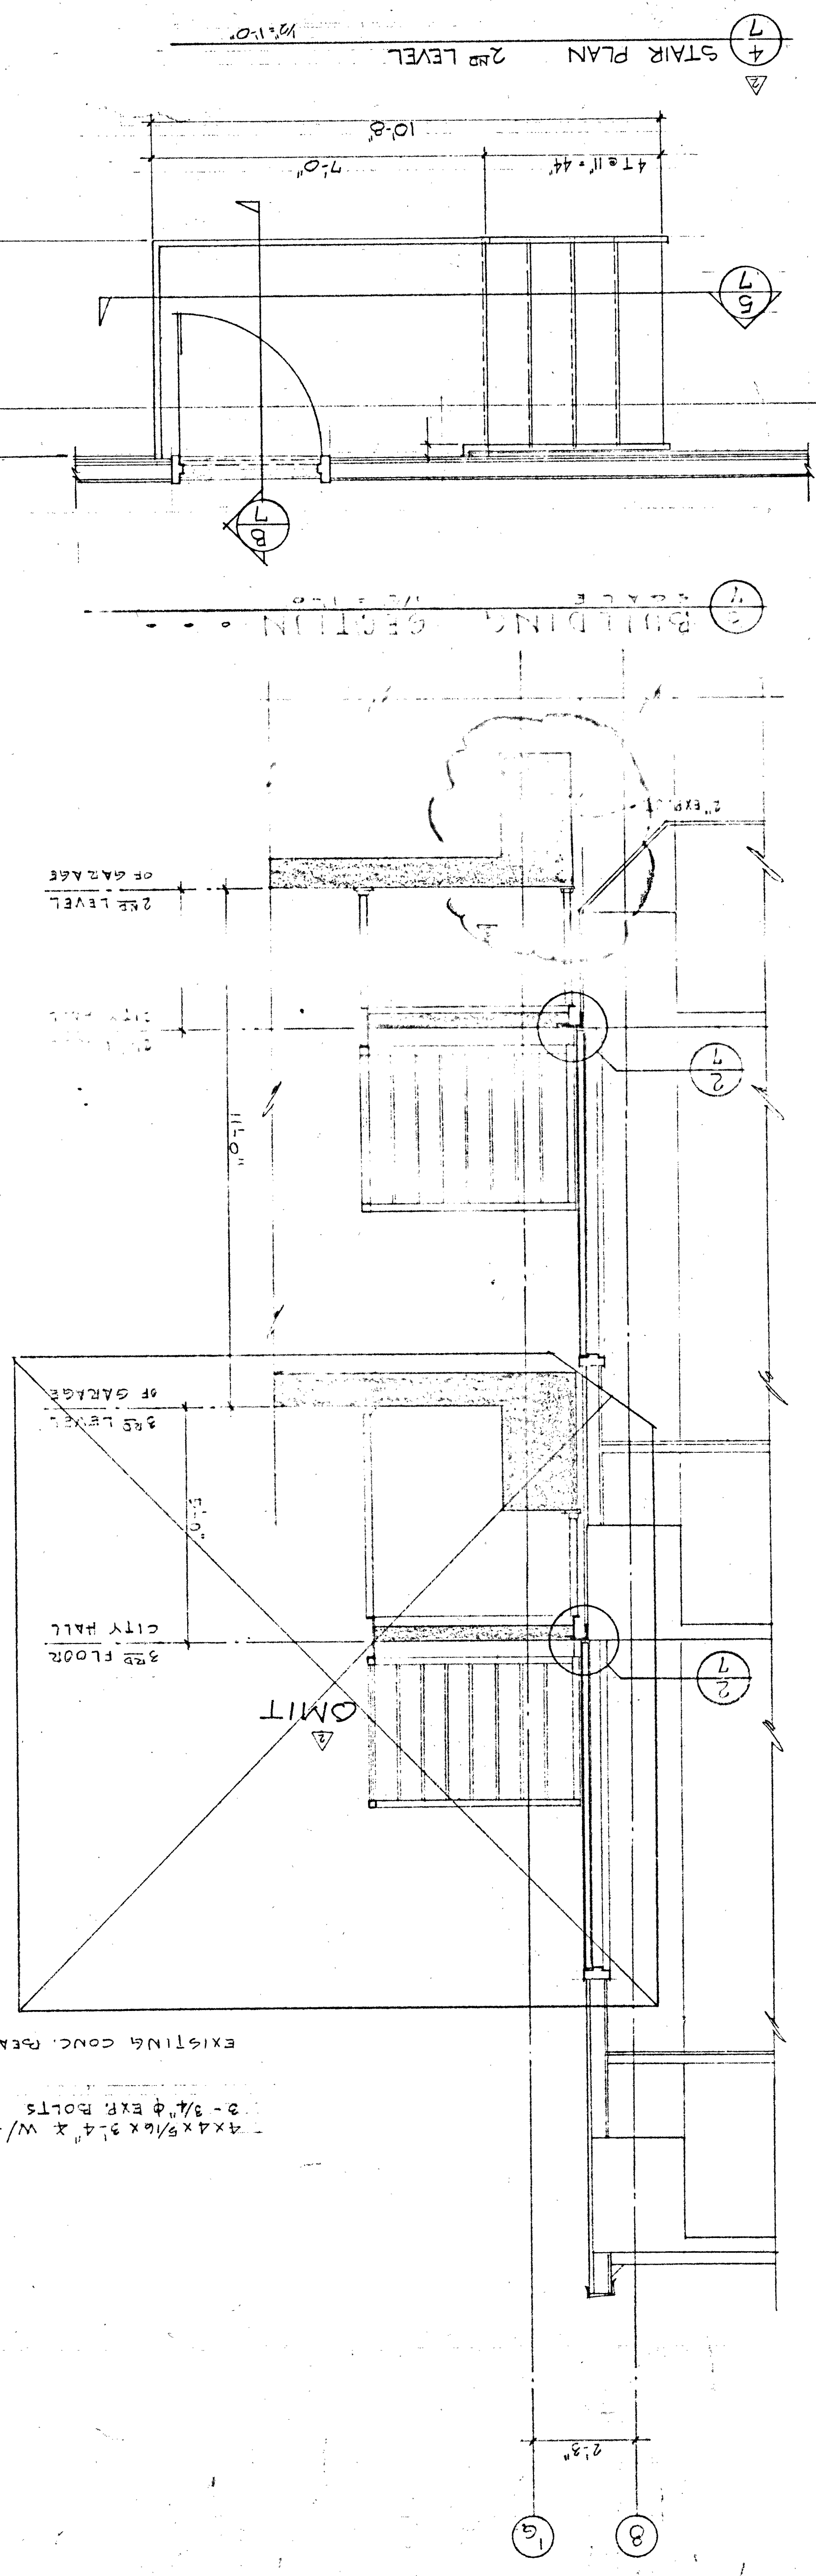


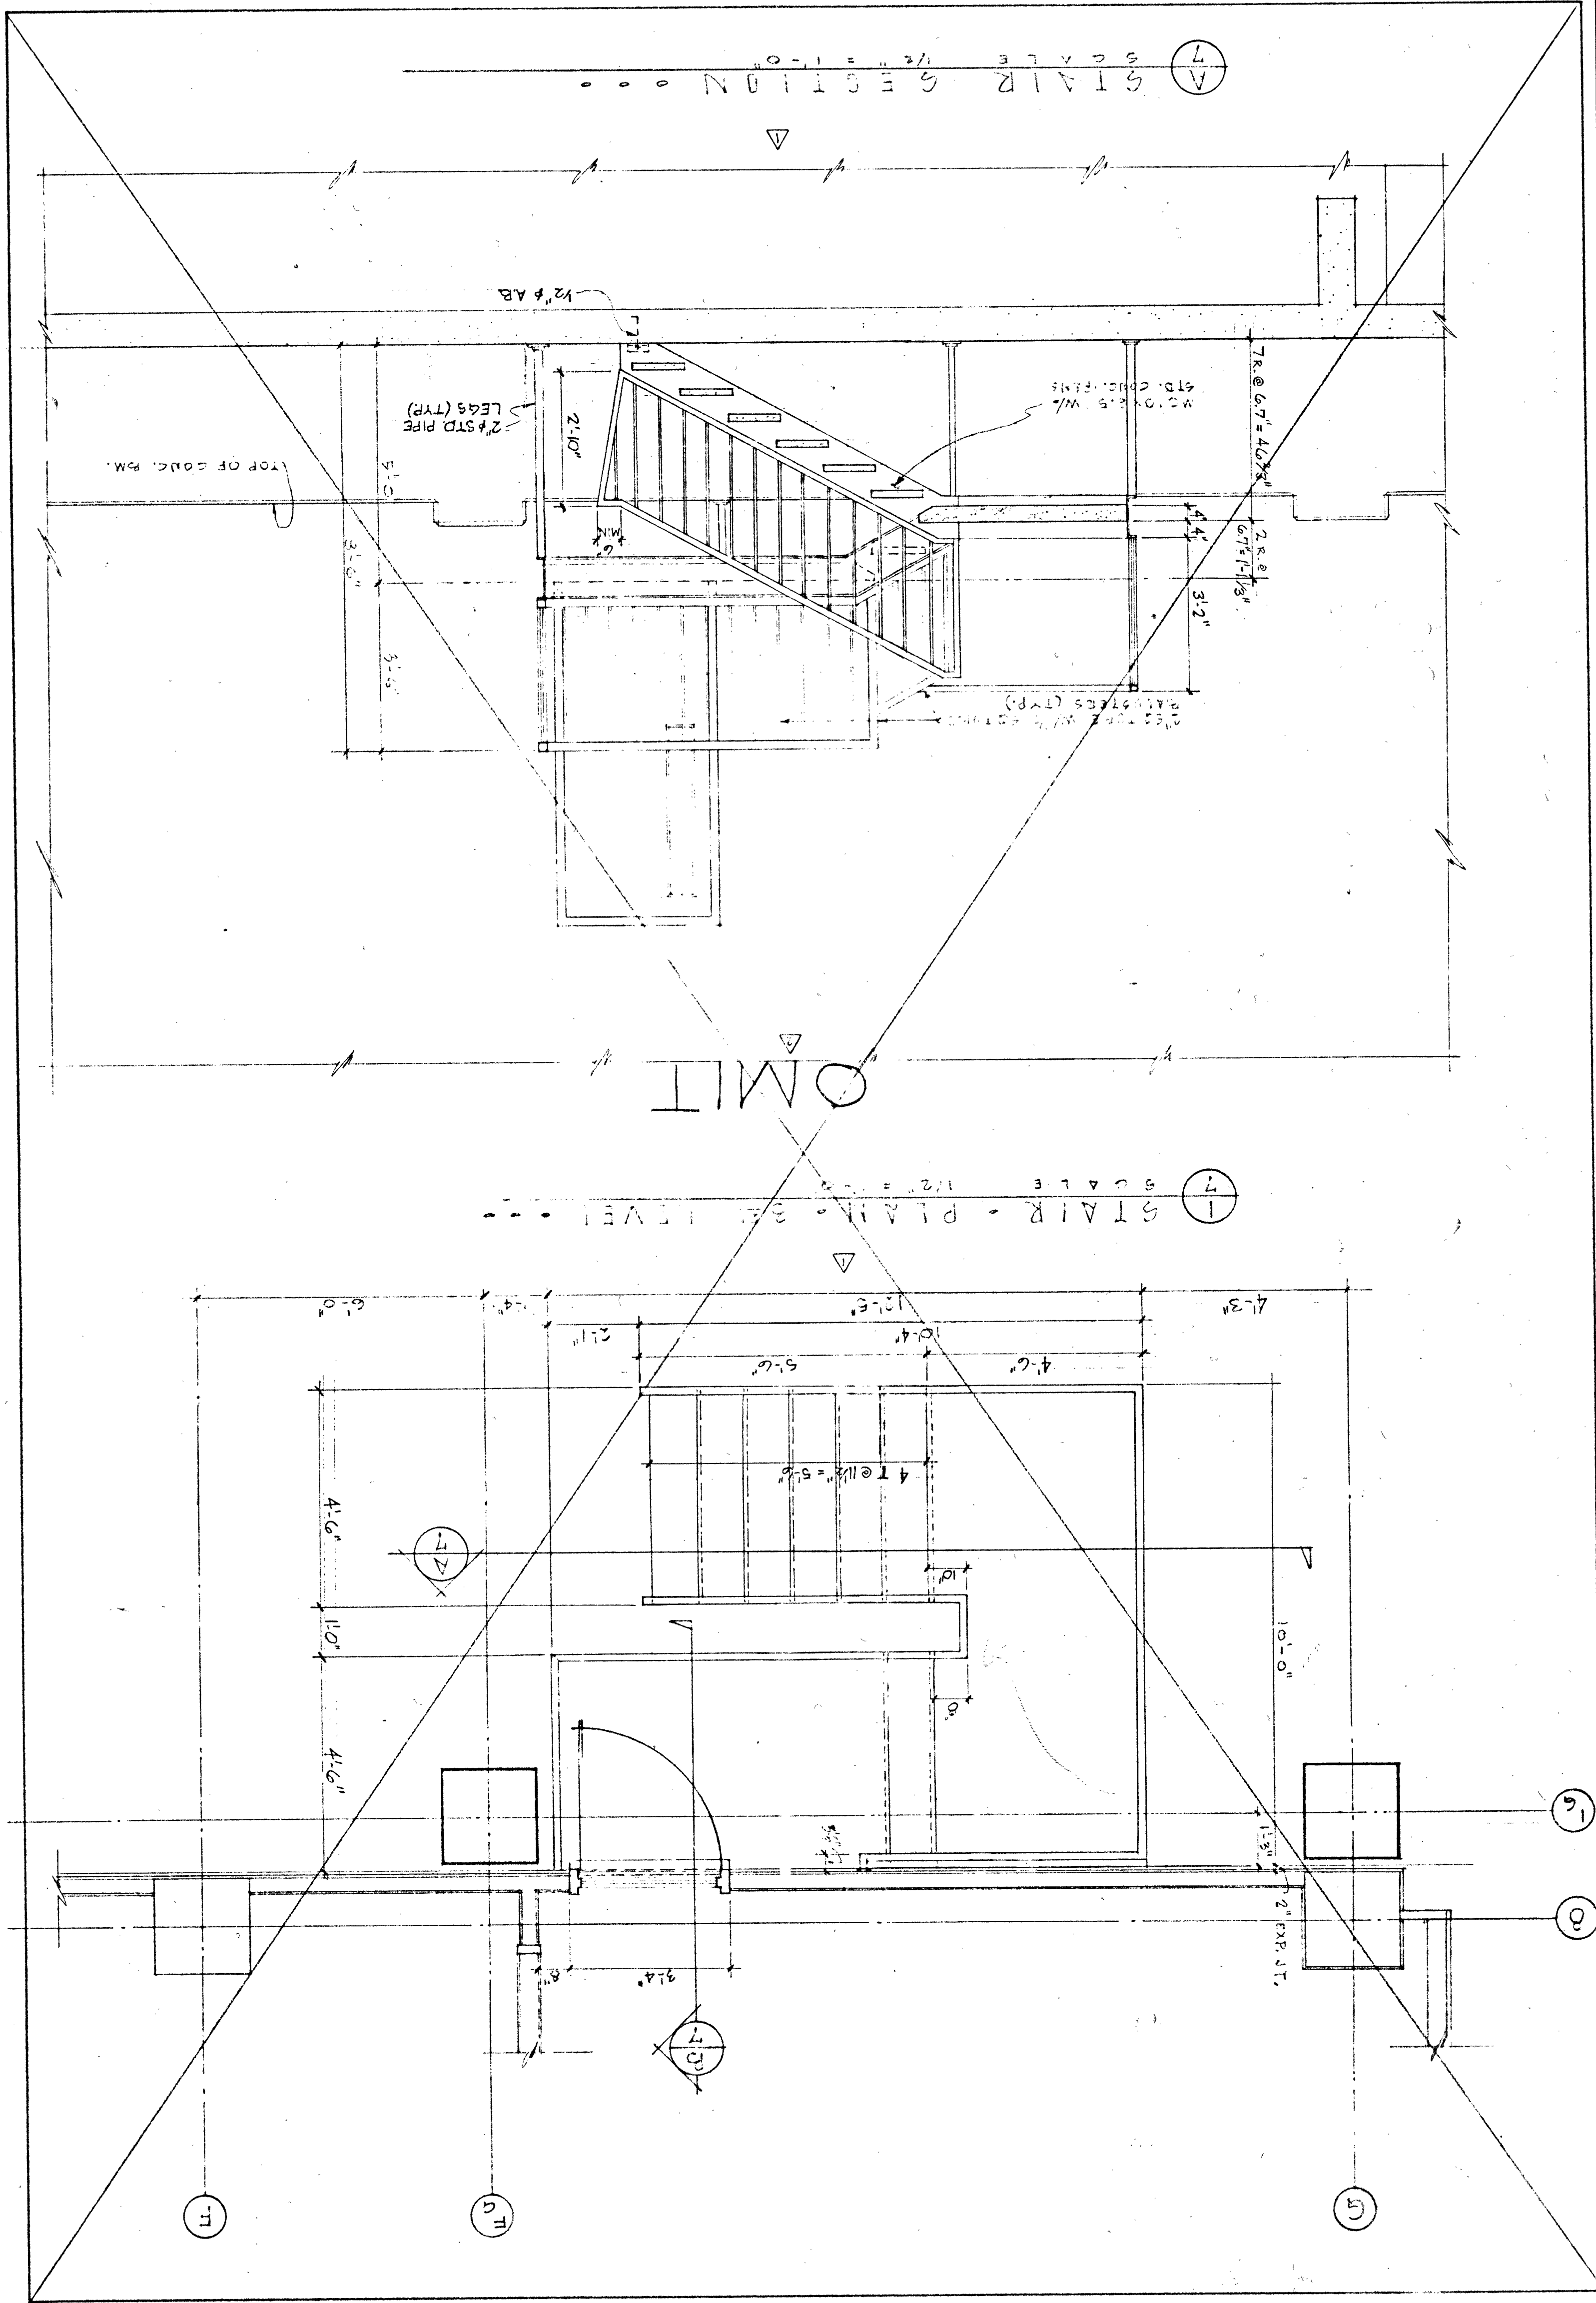

REVISION	DATE	DESCRIPTION
1	12-14-78	AS-BUILT
2	1-15-78	CLARIFICATIONS FOR EXIST. BID
3	10-23-77	STAIR REVISION ADD #2

A-7

SHEET NO.

CHECKED

DRAWN

ENGINEER

DATE 10-21-77

JOB NO. 77079

SHEET TITLE

STAIR DETAILS

STAIR # 3 & STAIR # 2

JOB TITLE

PACKING GARAGE ADDITION

LAS VEGAS CITY HALL

LAS VEGAS, NEVADA

MARTIN & CASHDAN

STRUCTURAL ENGINEERS

844 EAST SAHARA AVENUE

LAS VEGAS NEVADA 89104

TELEPHONE (702) 735-7166

CONSULTANT