
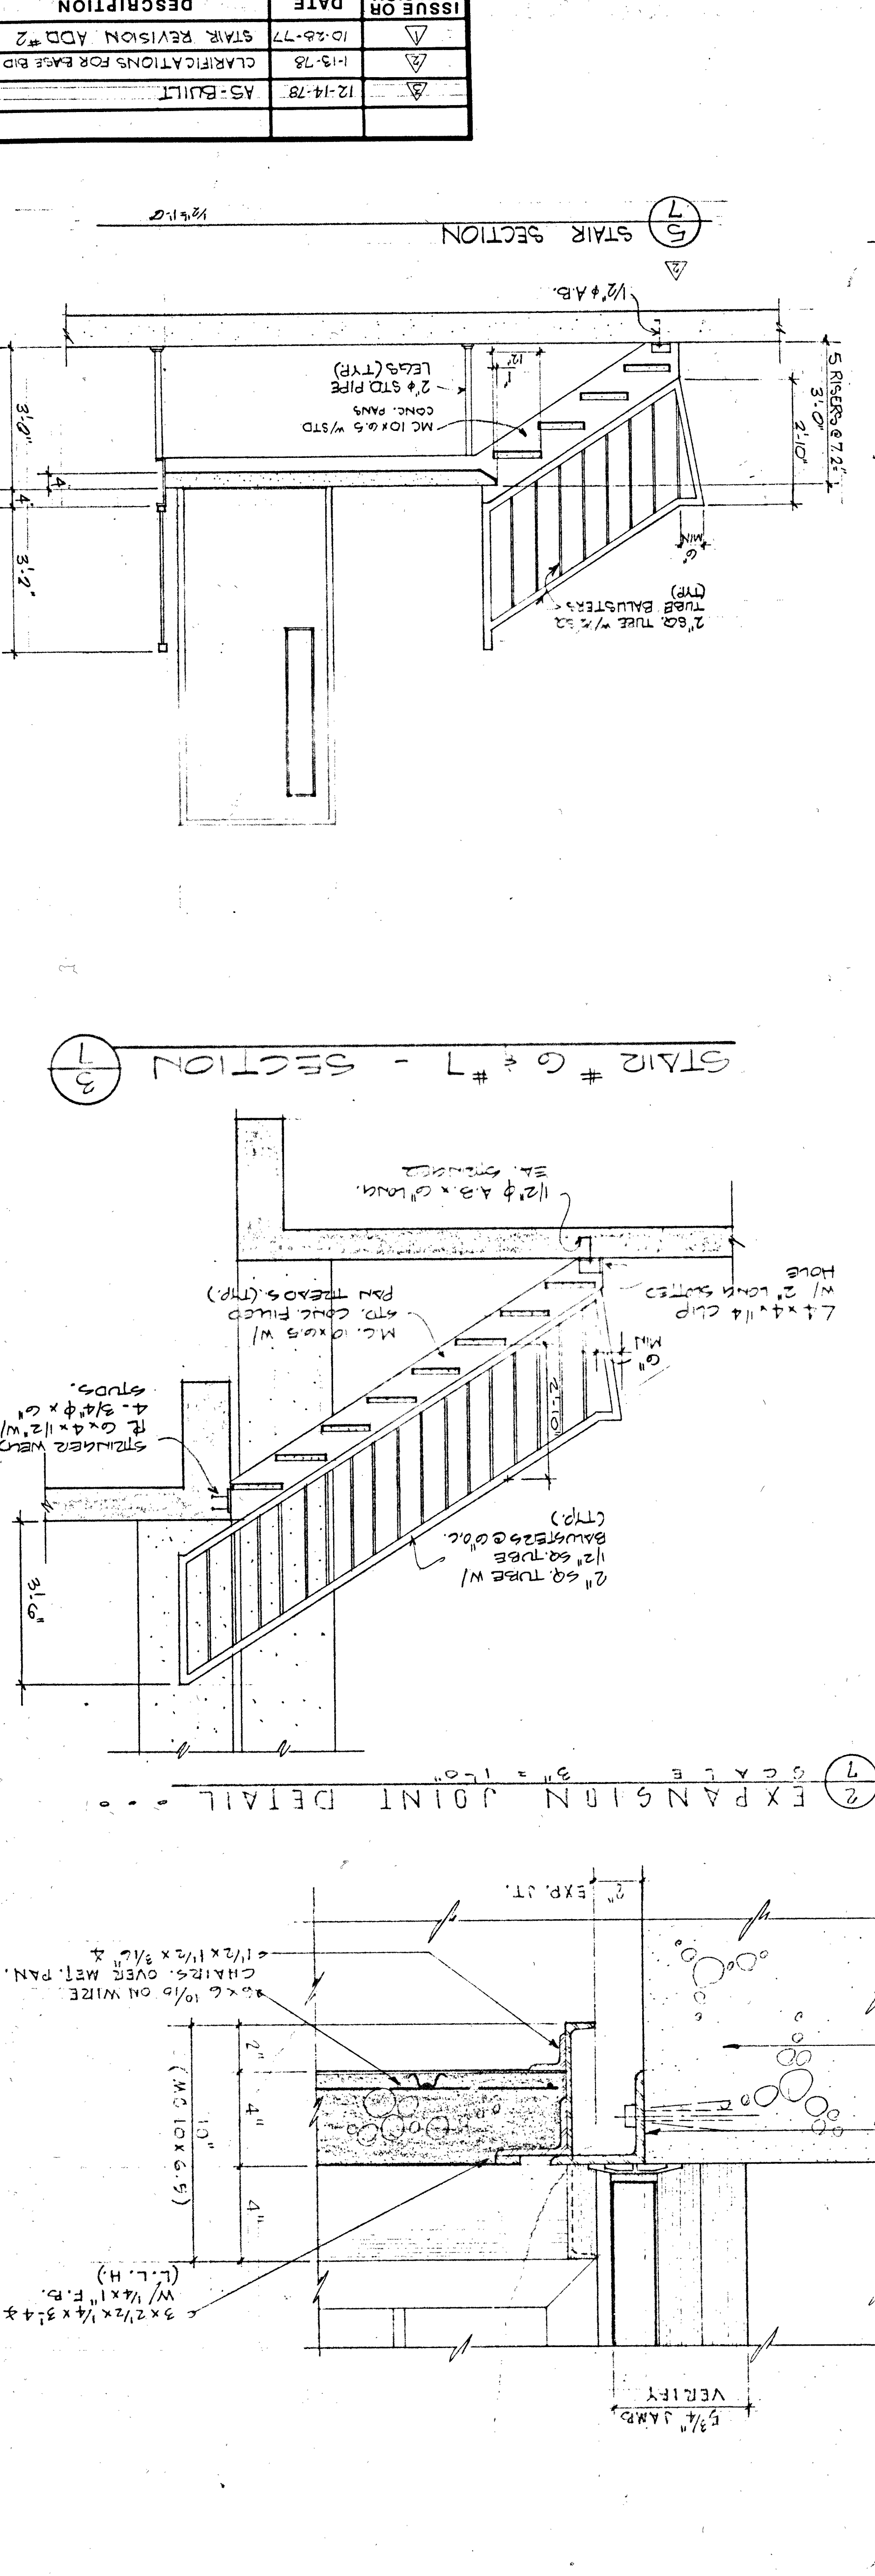
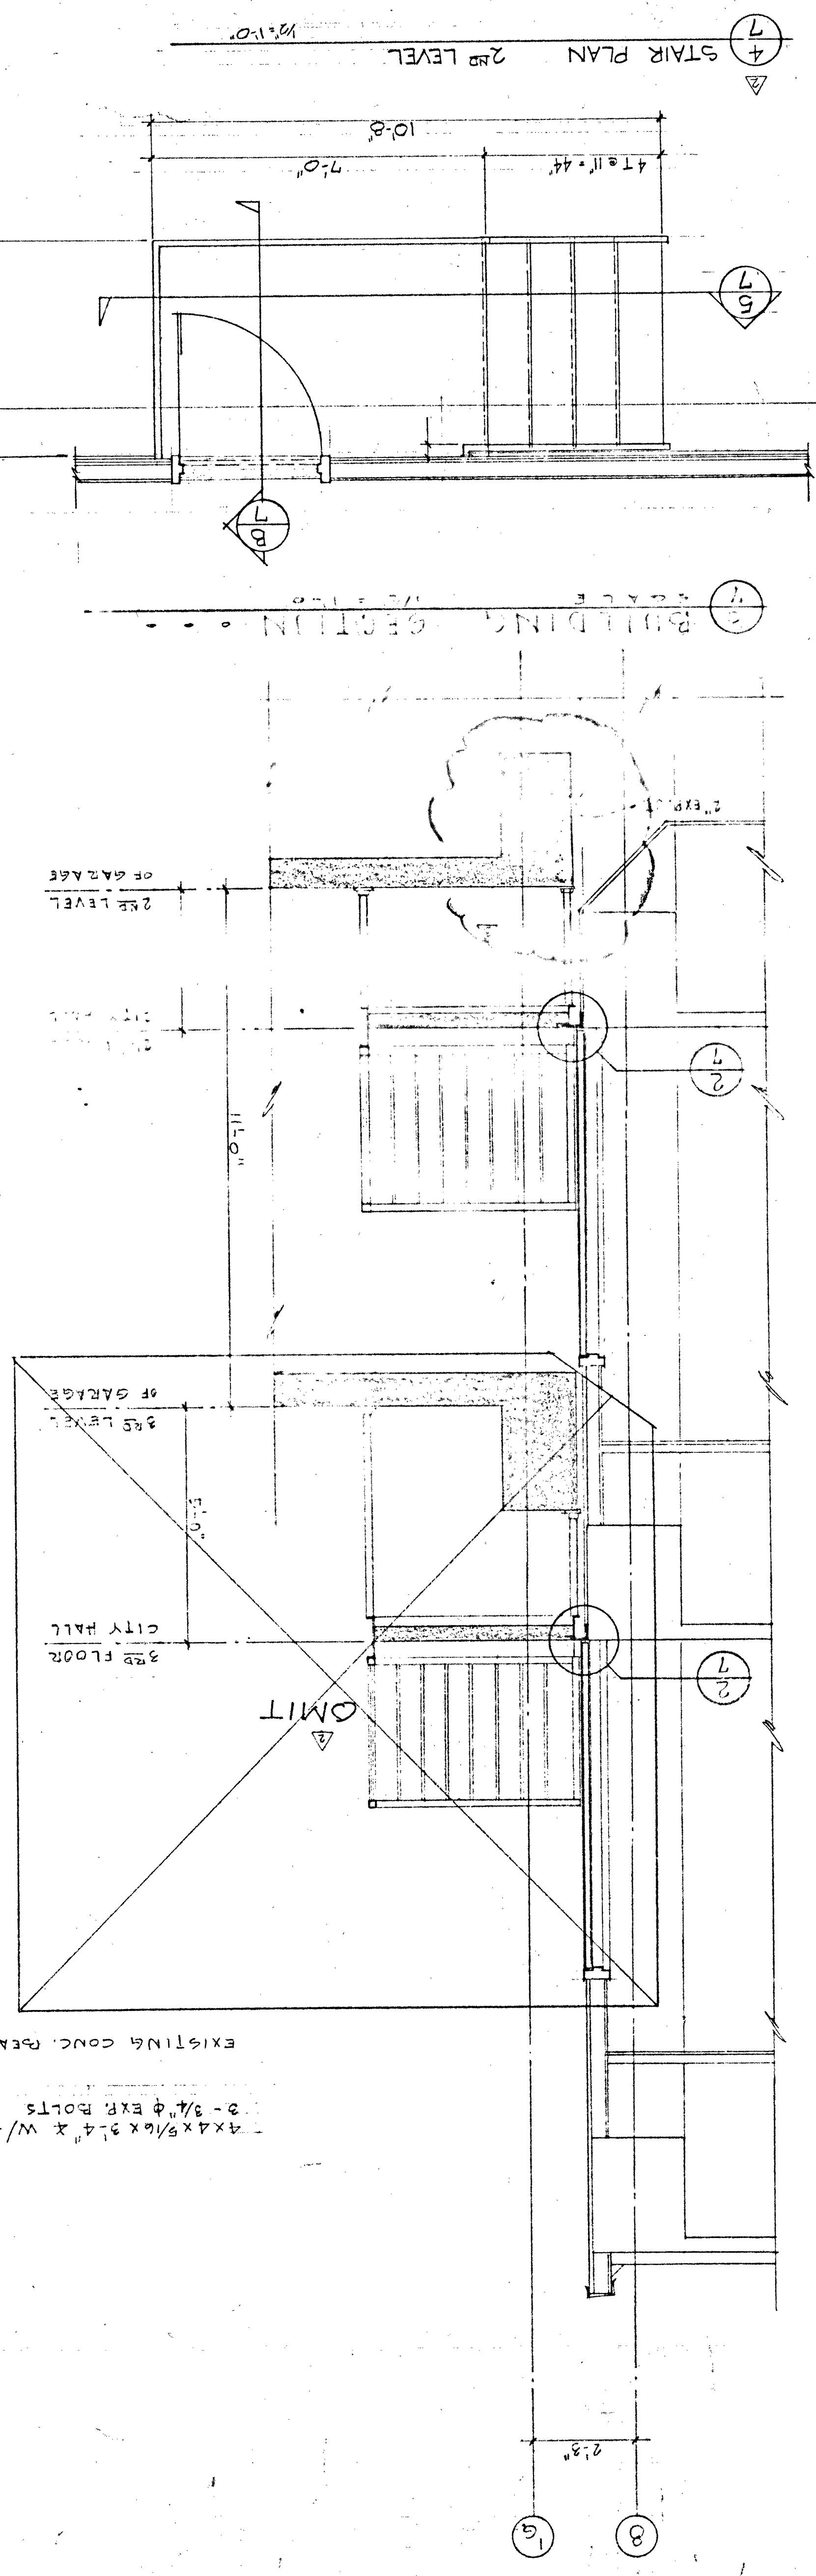


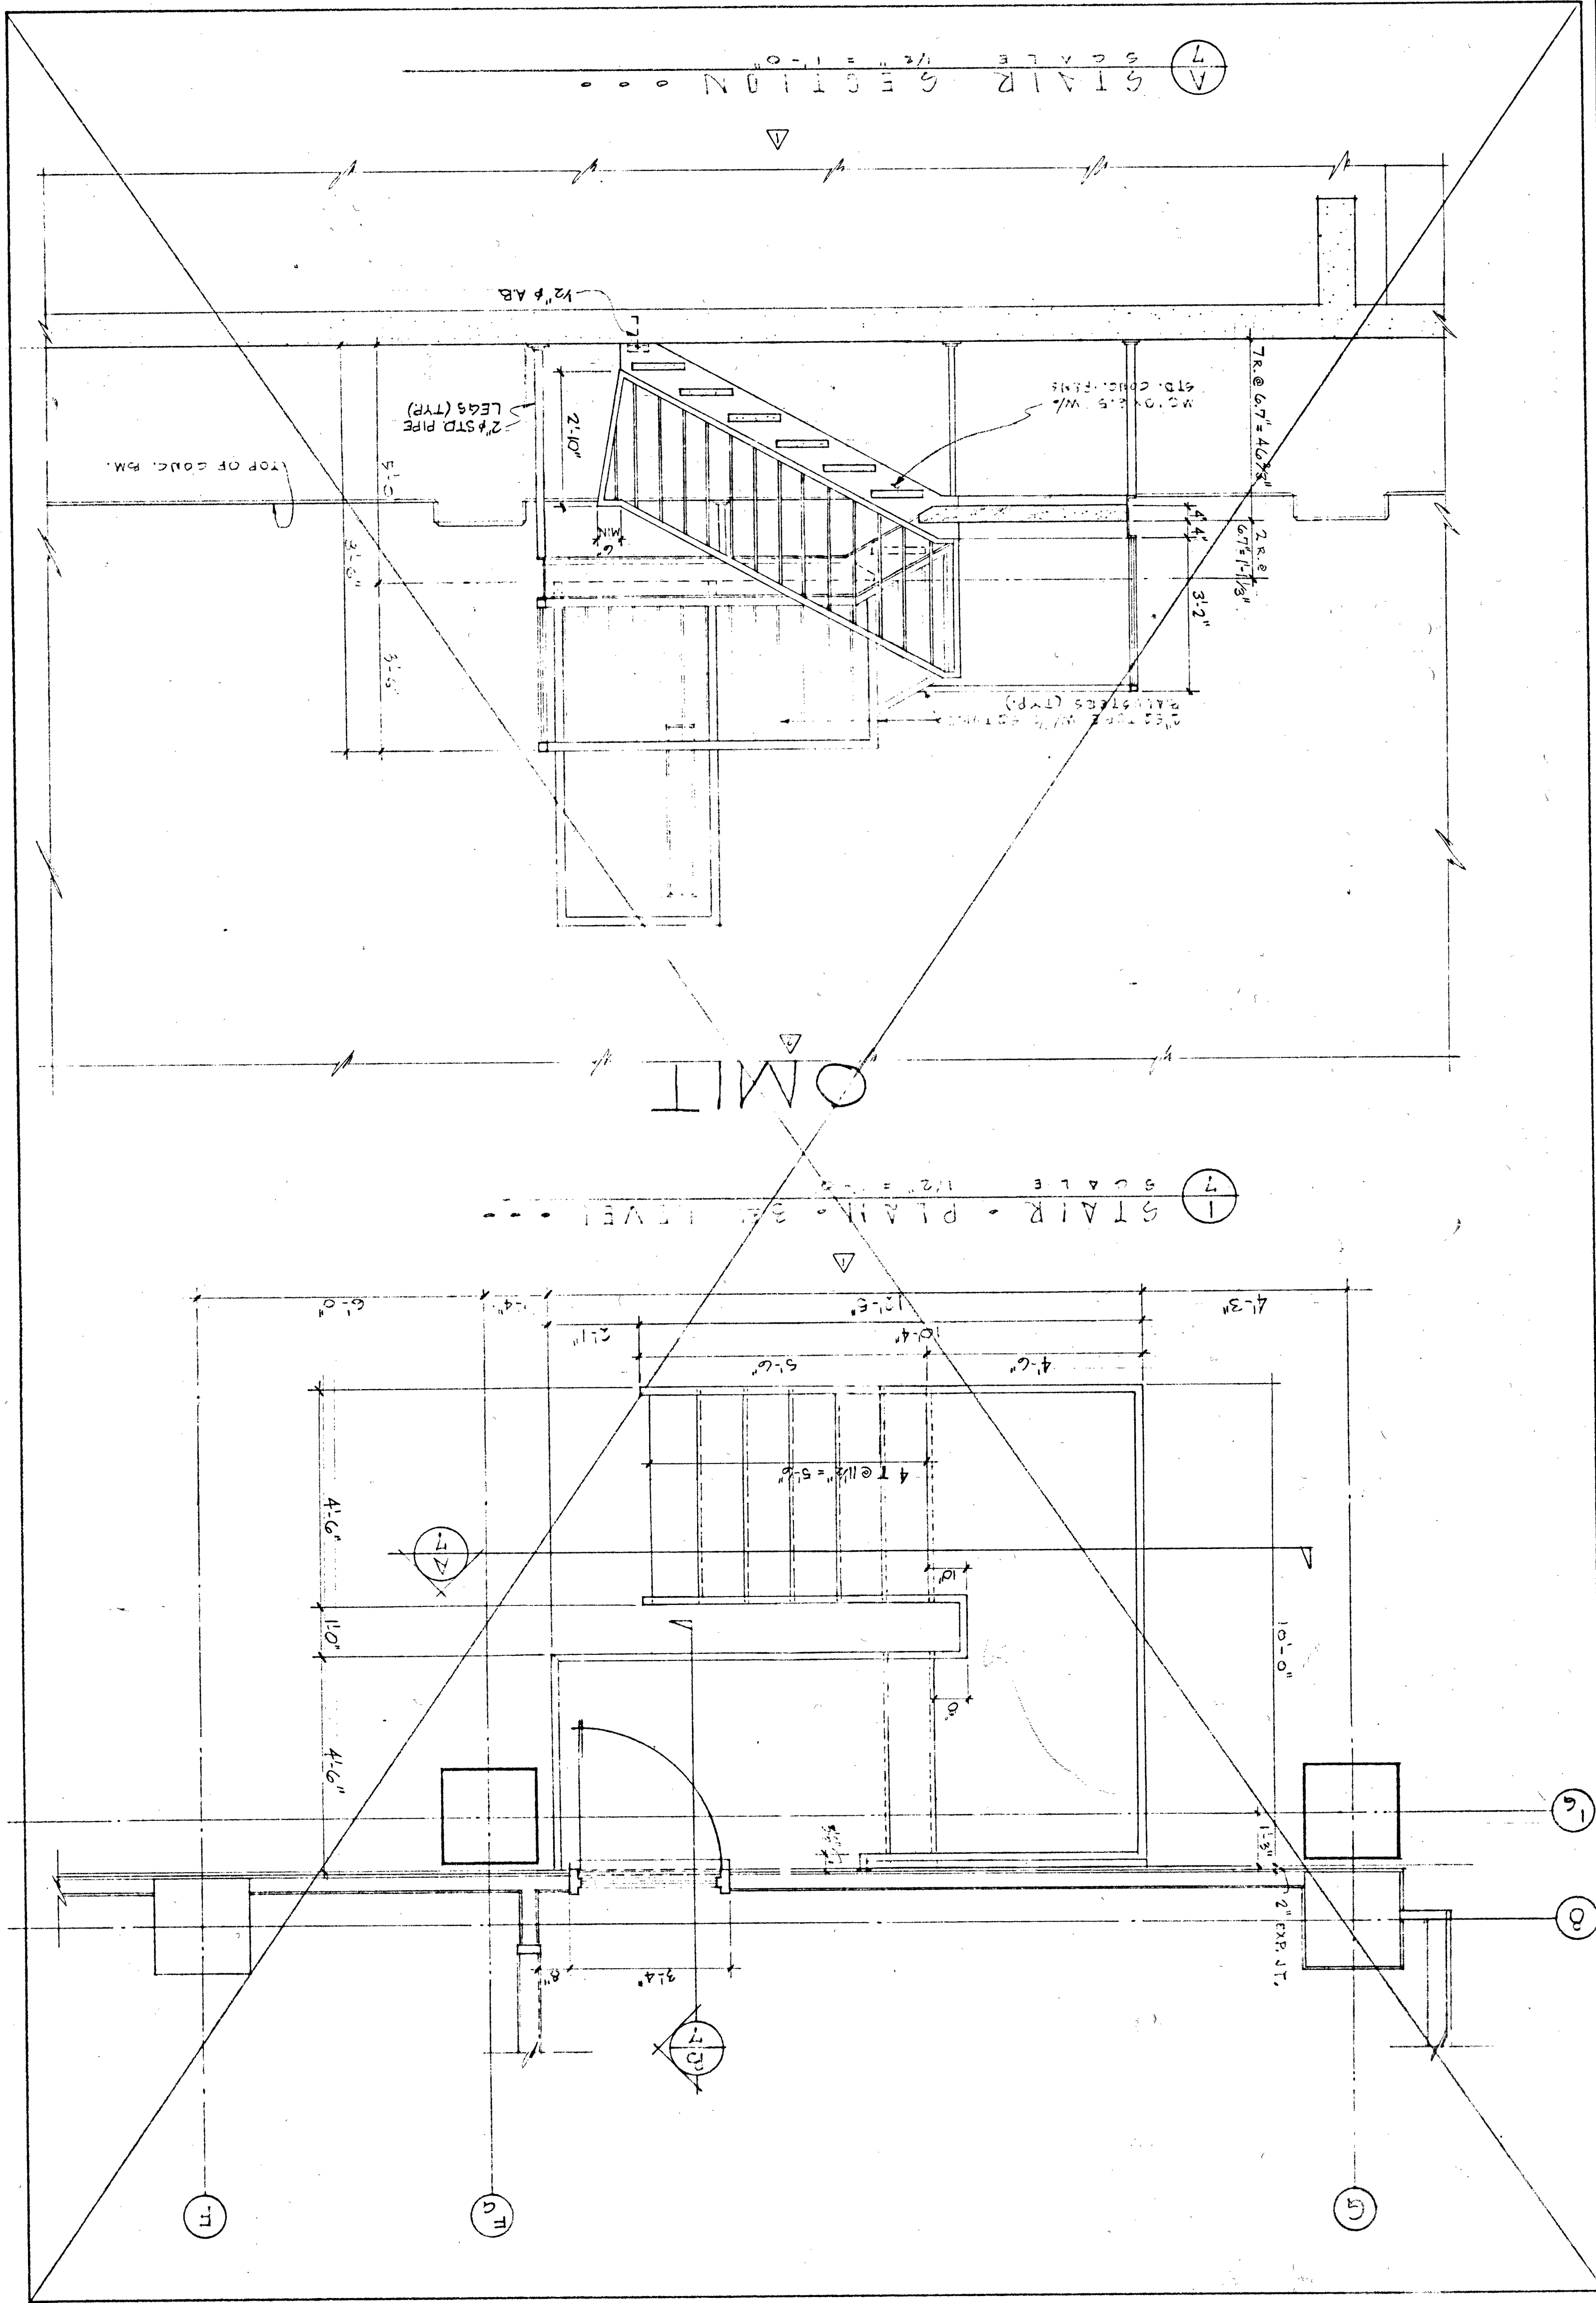

REVISION	DATE	DESCRIPTION
1	12-14-78	AS-BUILT
2	1-15-78	CLARIFICATIONS FOR EXIST. BID
3	10-23-77	STAIR REVISION ADD #2

A-7

SHEET NO. 5
CHECKED
DRAWN
ENGINEER
DATE 10-21-77
JOB NO. 77079

SHEET TITLE
STAIR DETAILS
STAIR # 3, 4 STAIR # 1

JOB TITLE
SADDLING GARAGE ADDITION
LAS VEGAS CITY HALL
AND STENOGRAPH
LAS VEGAS, NEVADA

MARTIN & CASHDAN
STRUCTURAL ENGINEERS
844 EAST SAHARA AVENUE
LAS VEGAS NEVADA 89104
TELEPHONE (702) 735-7166