
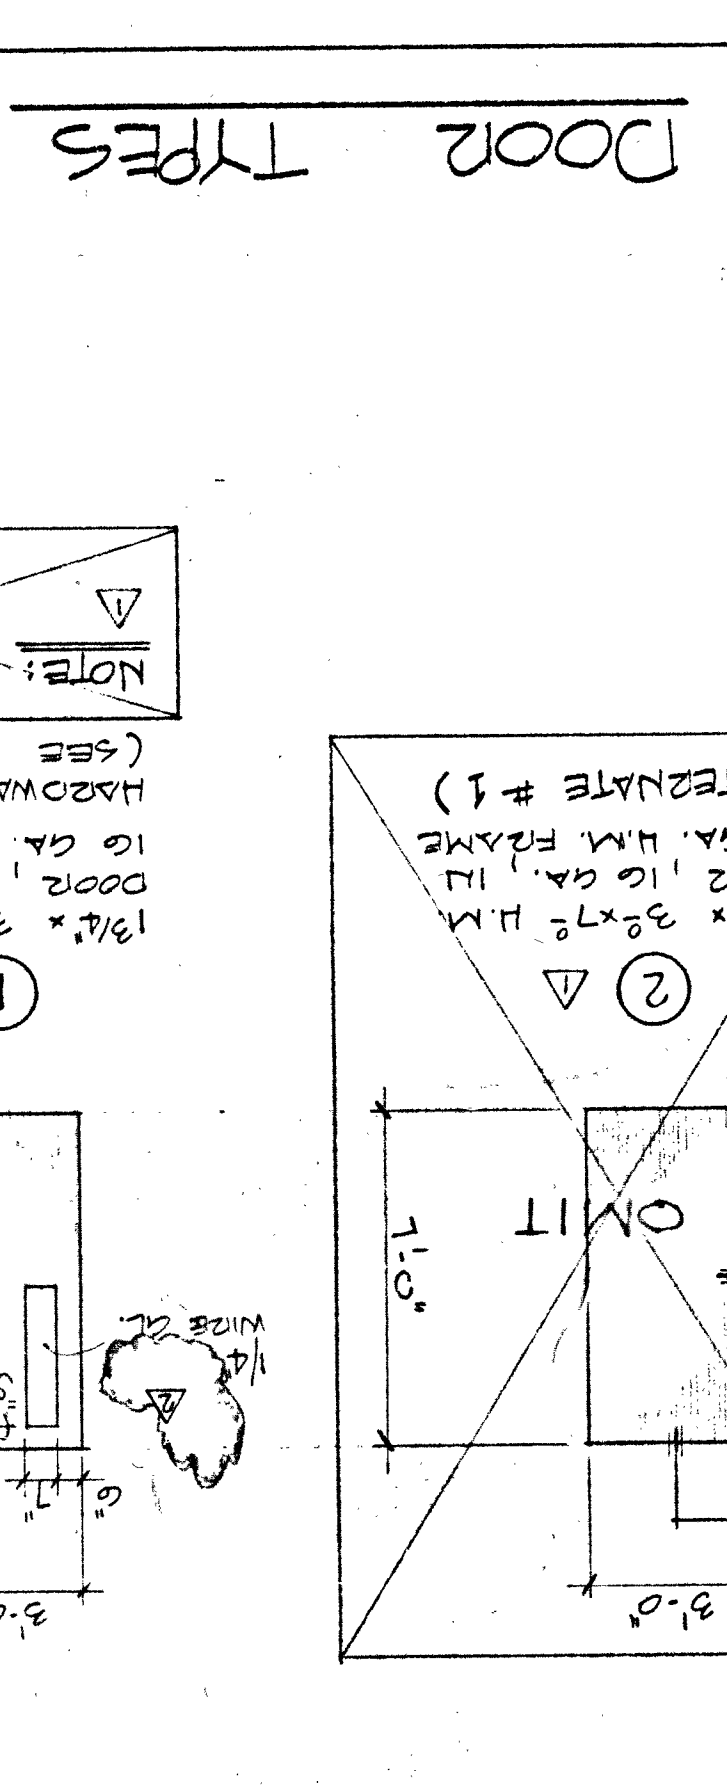
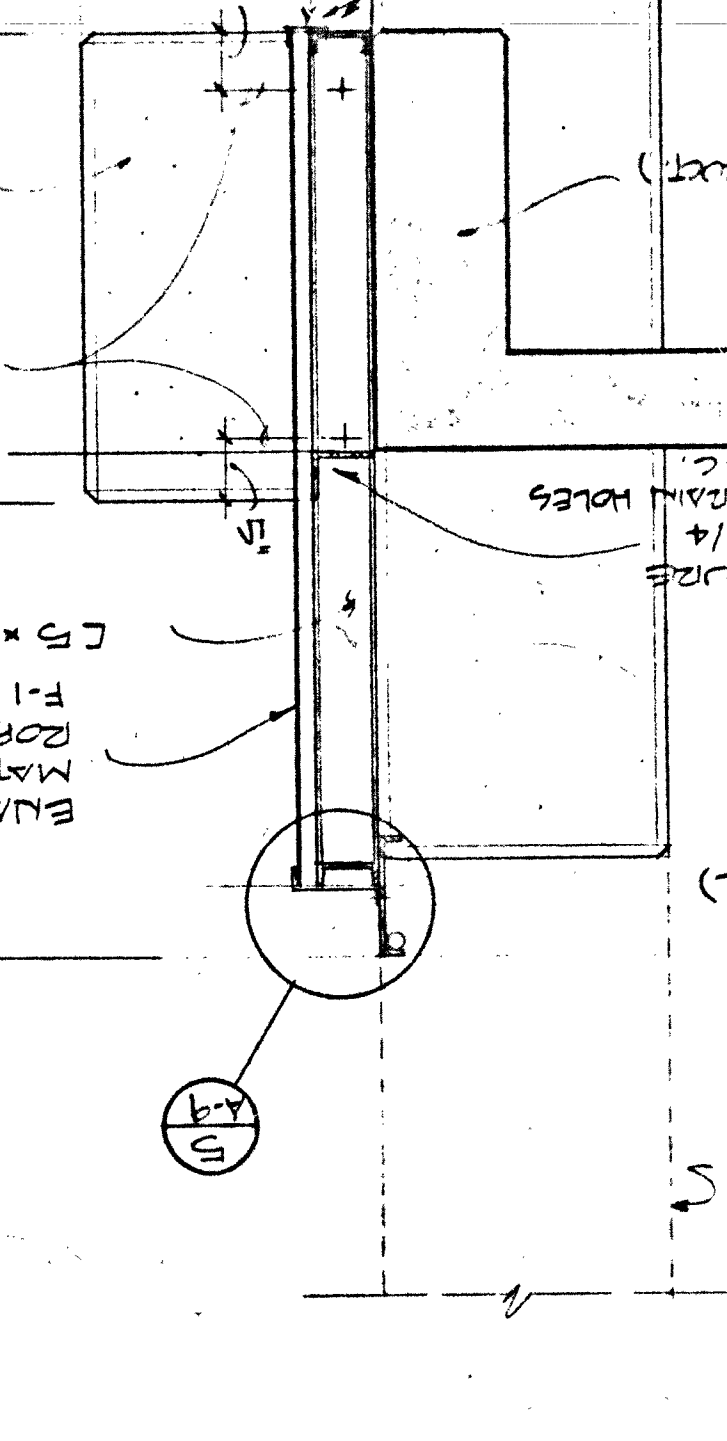
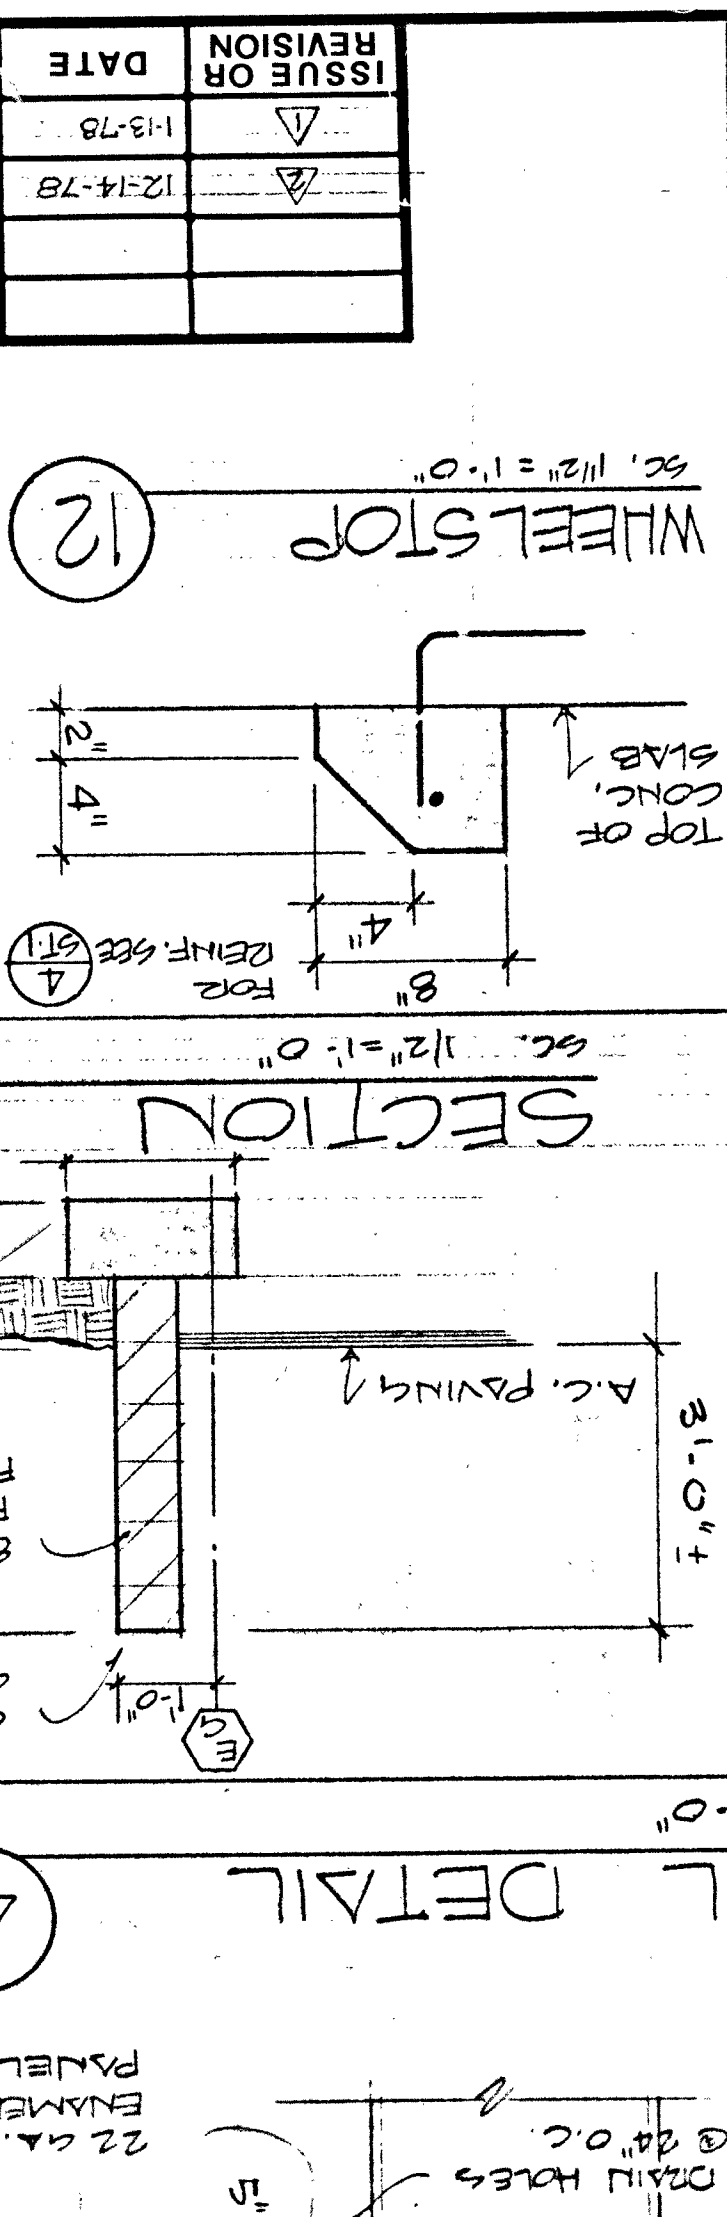
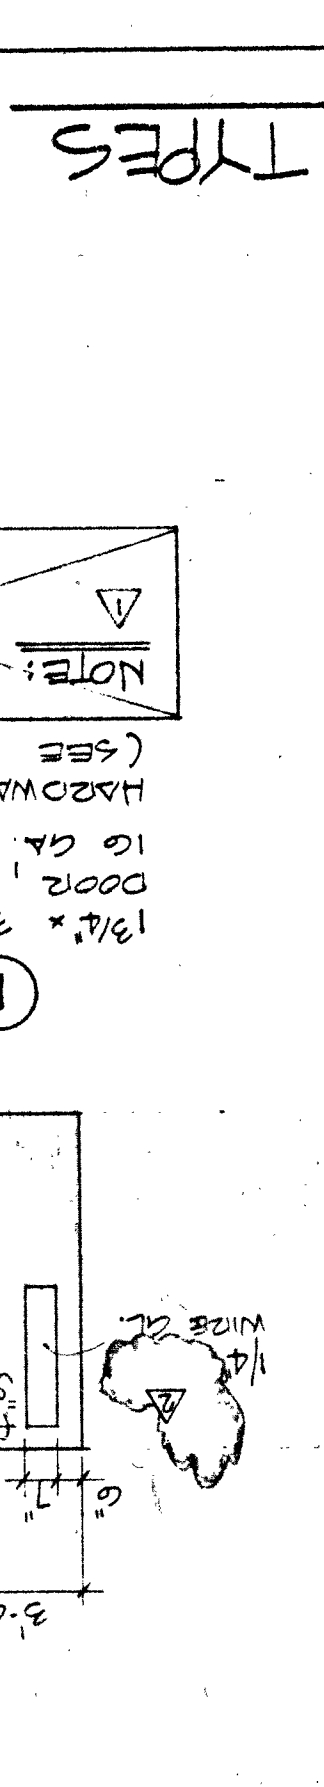
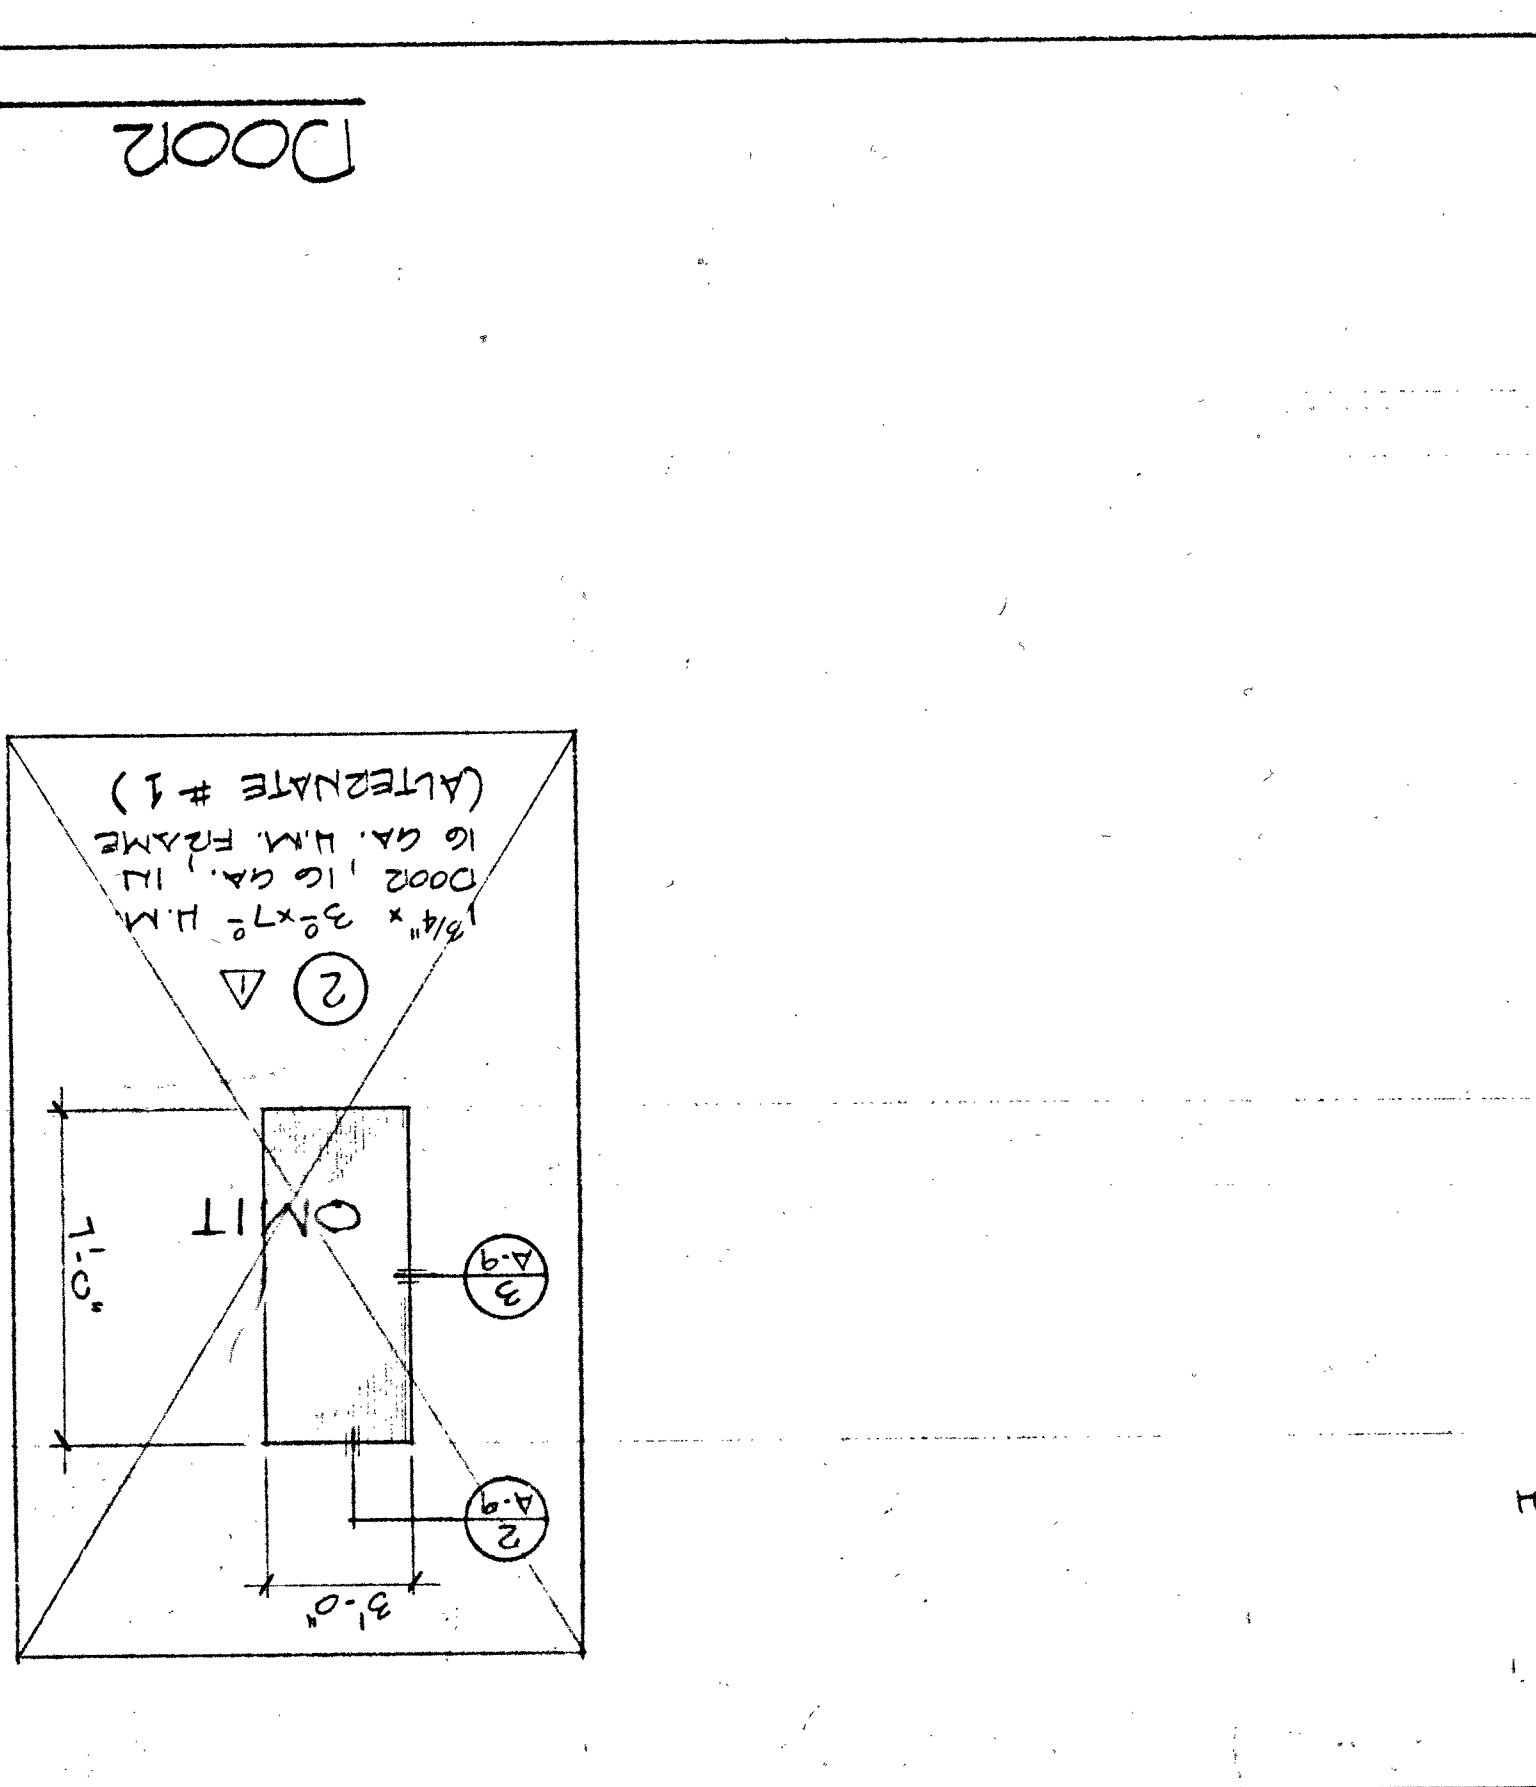
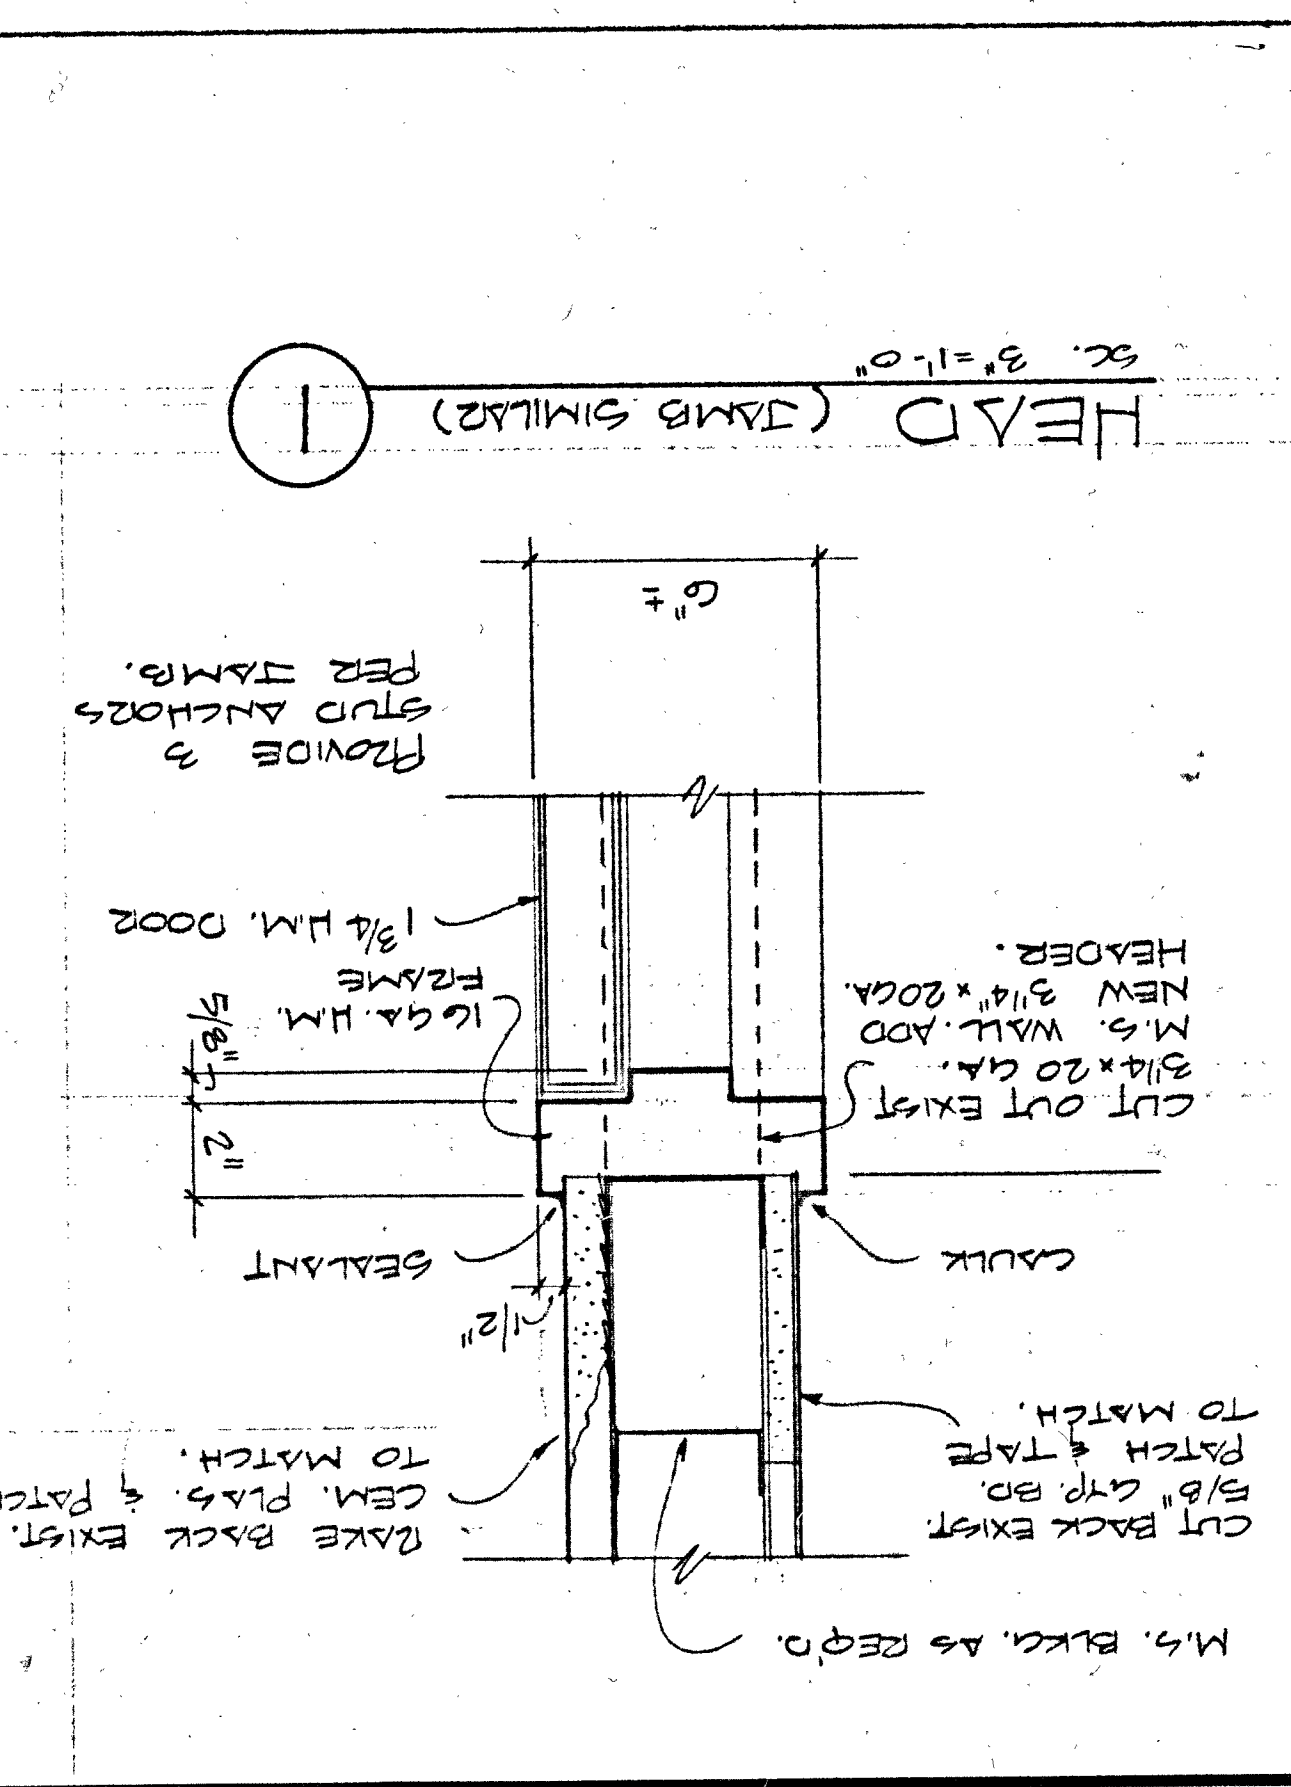
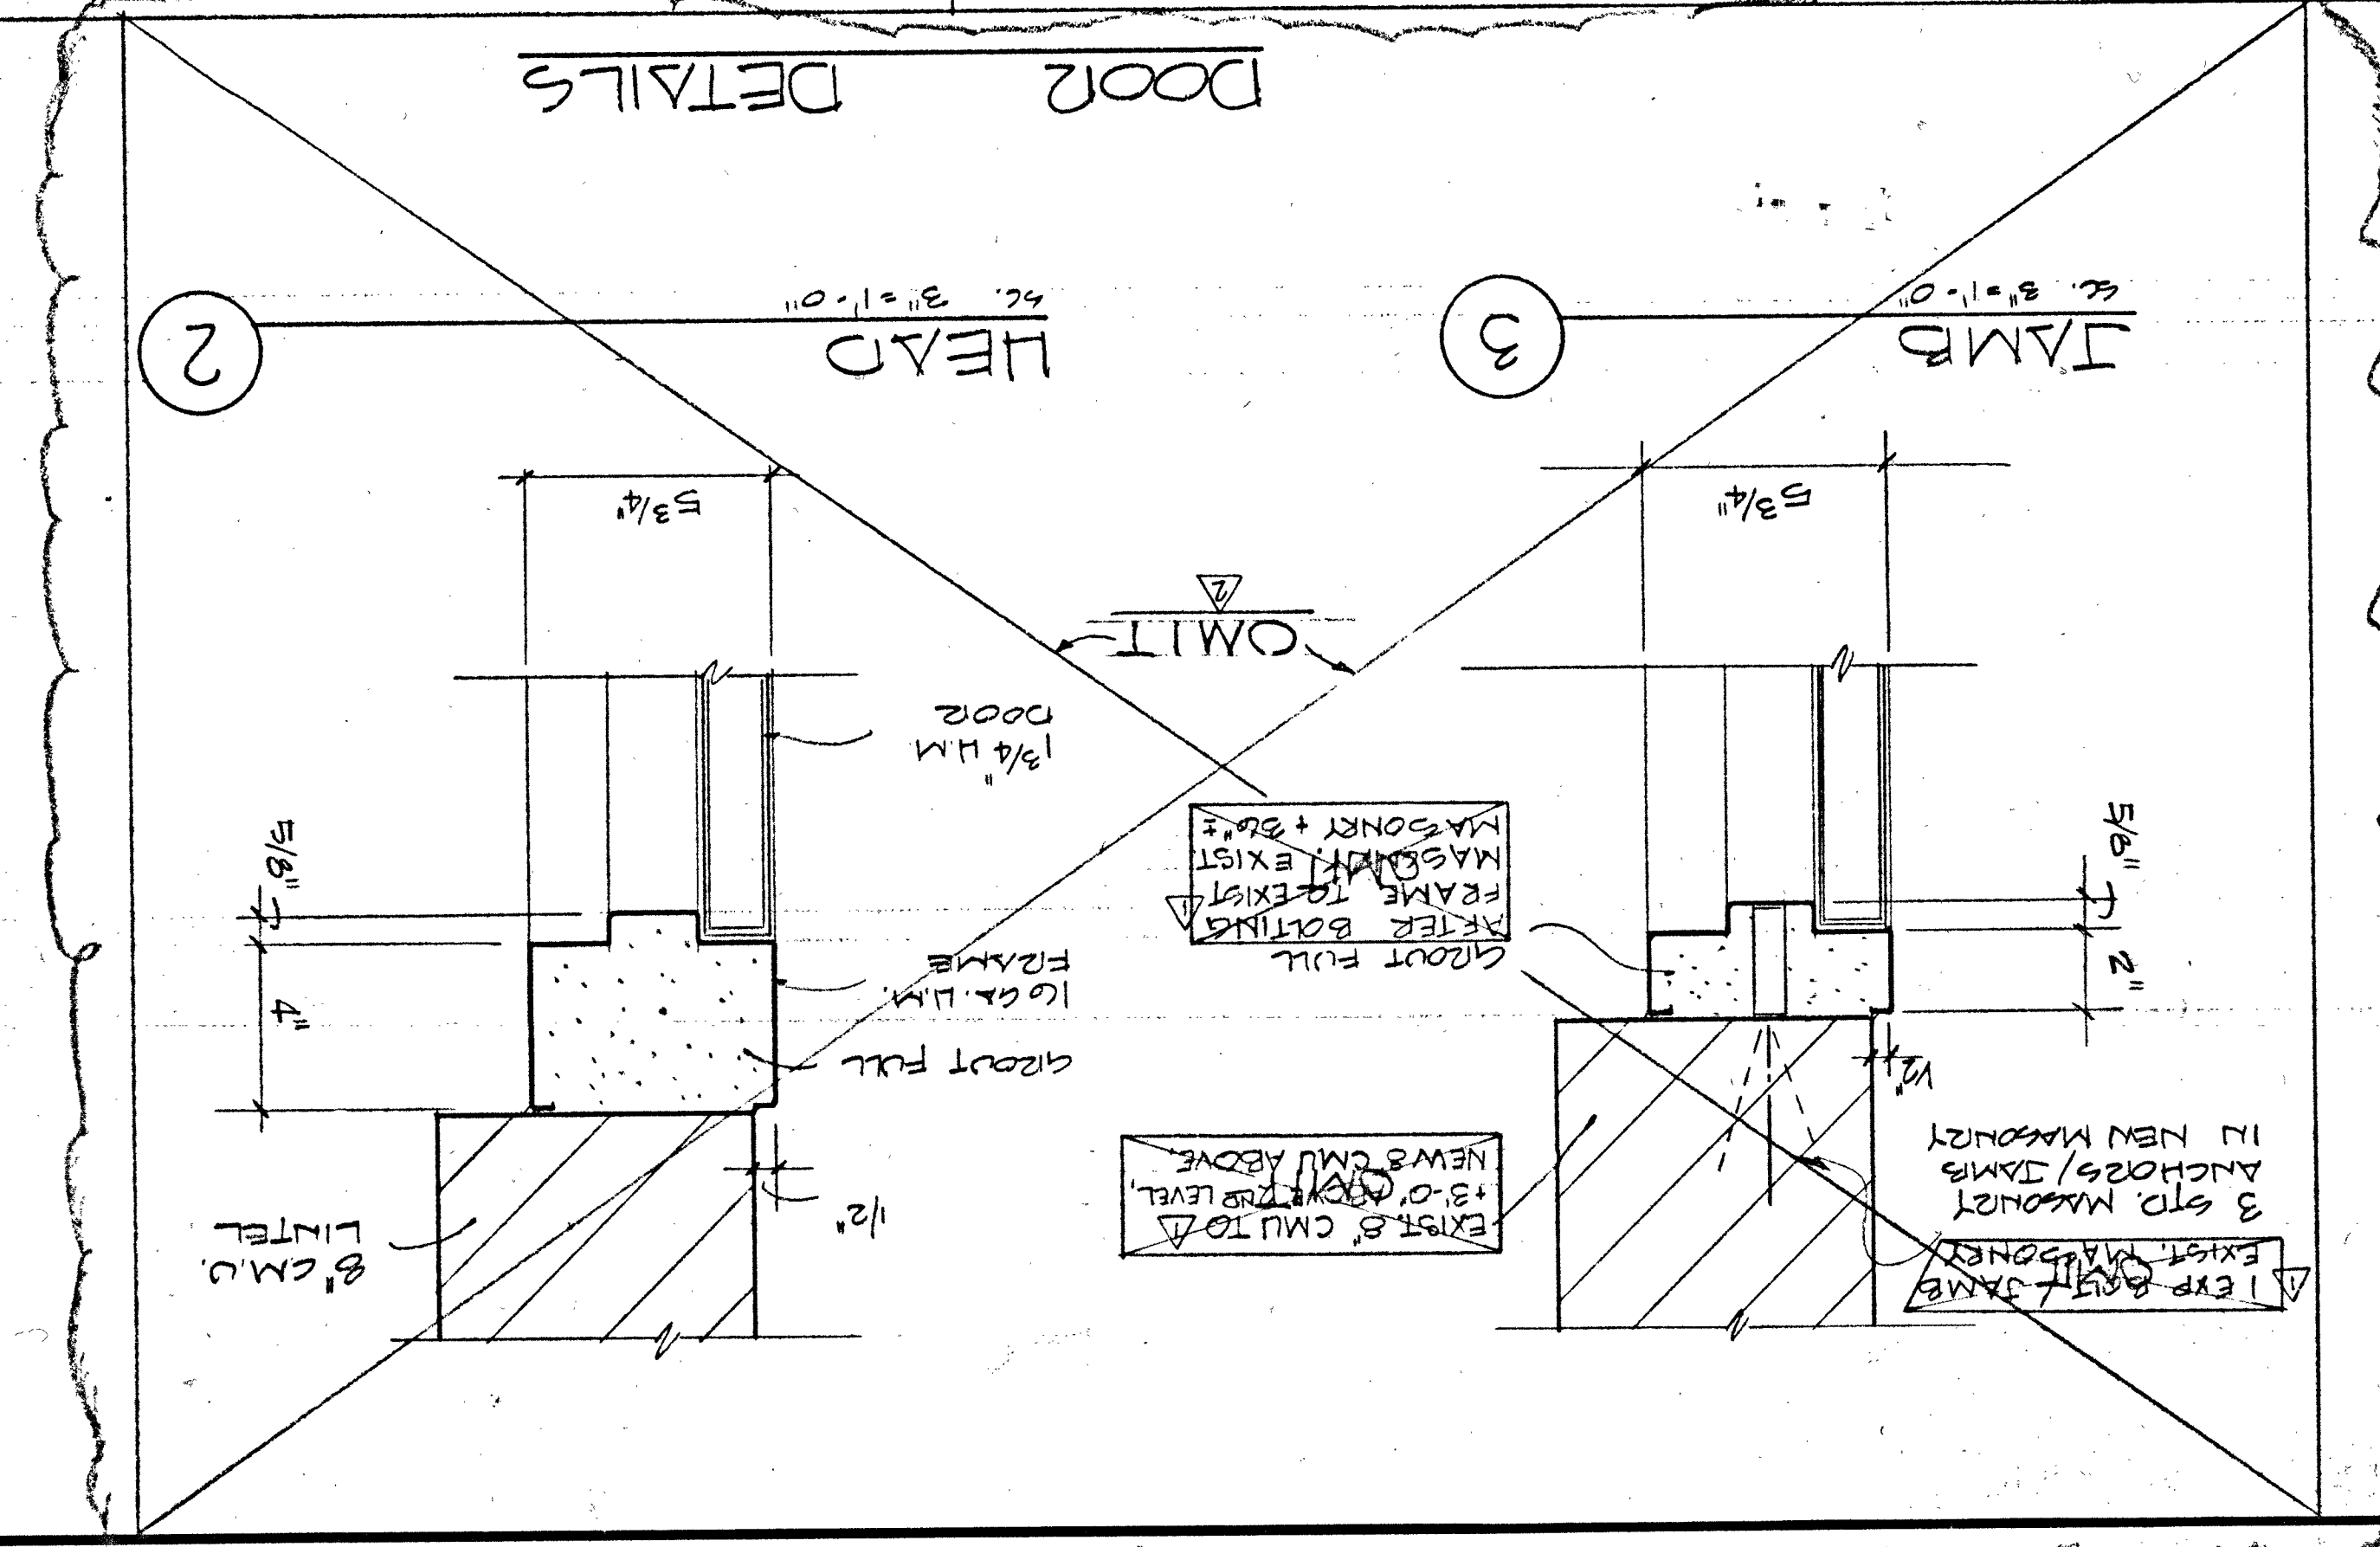
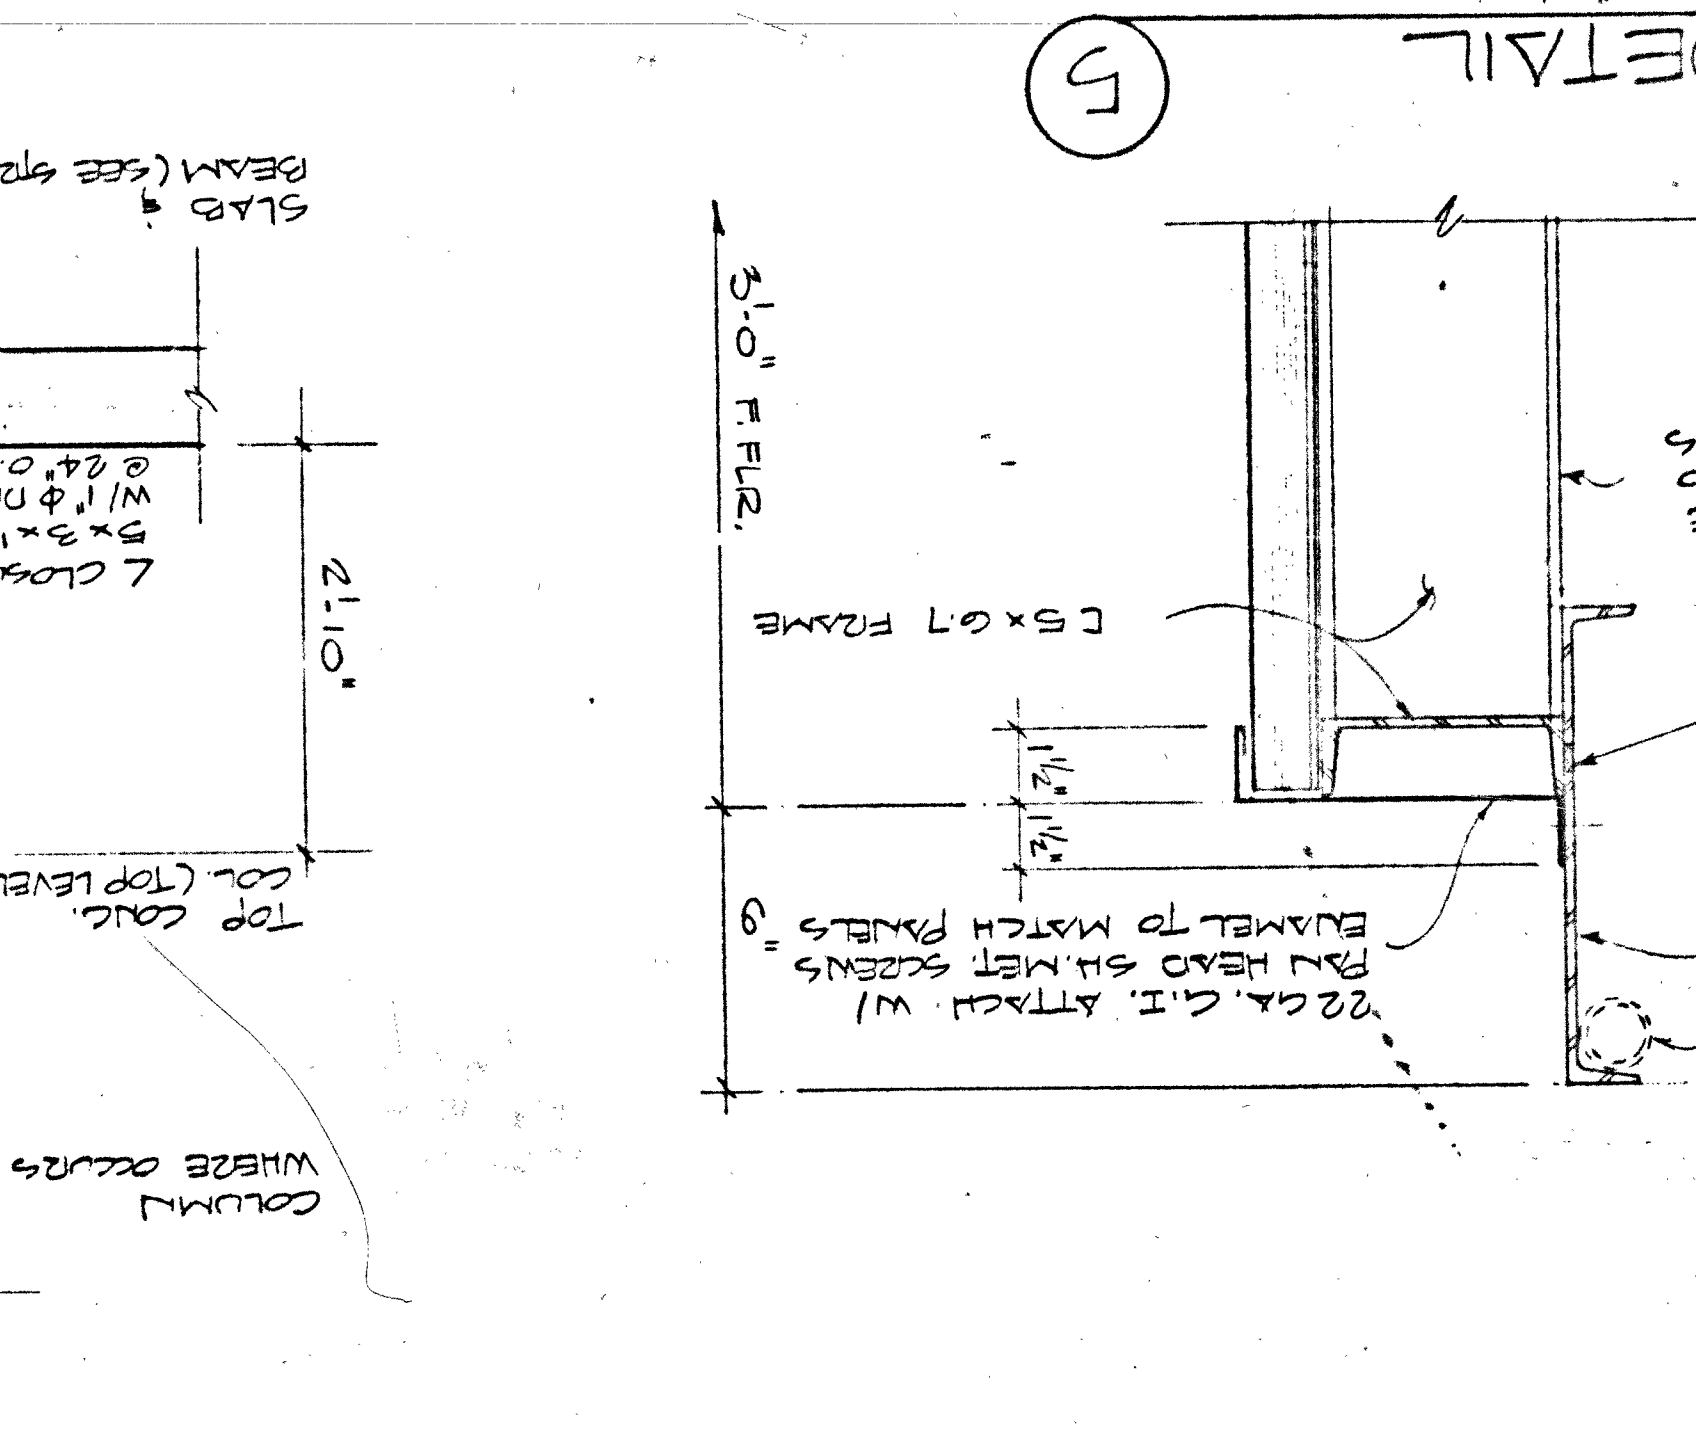
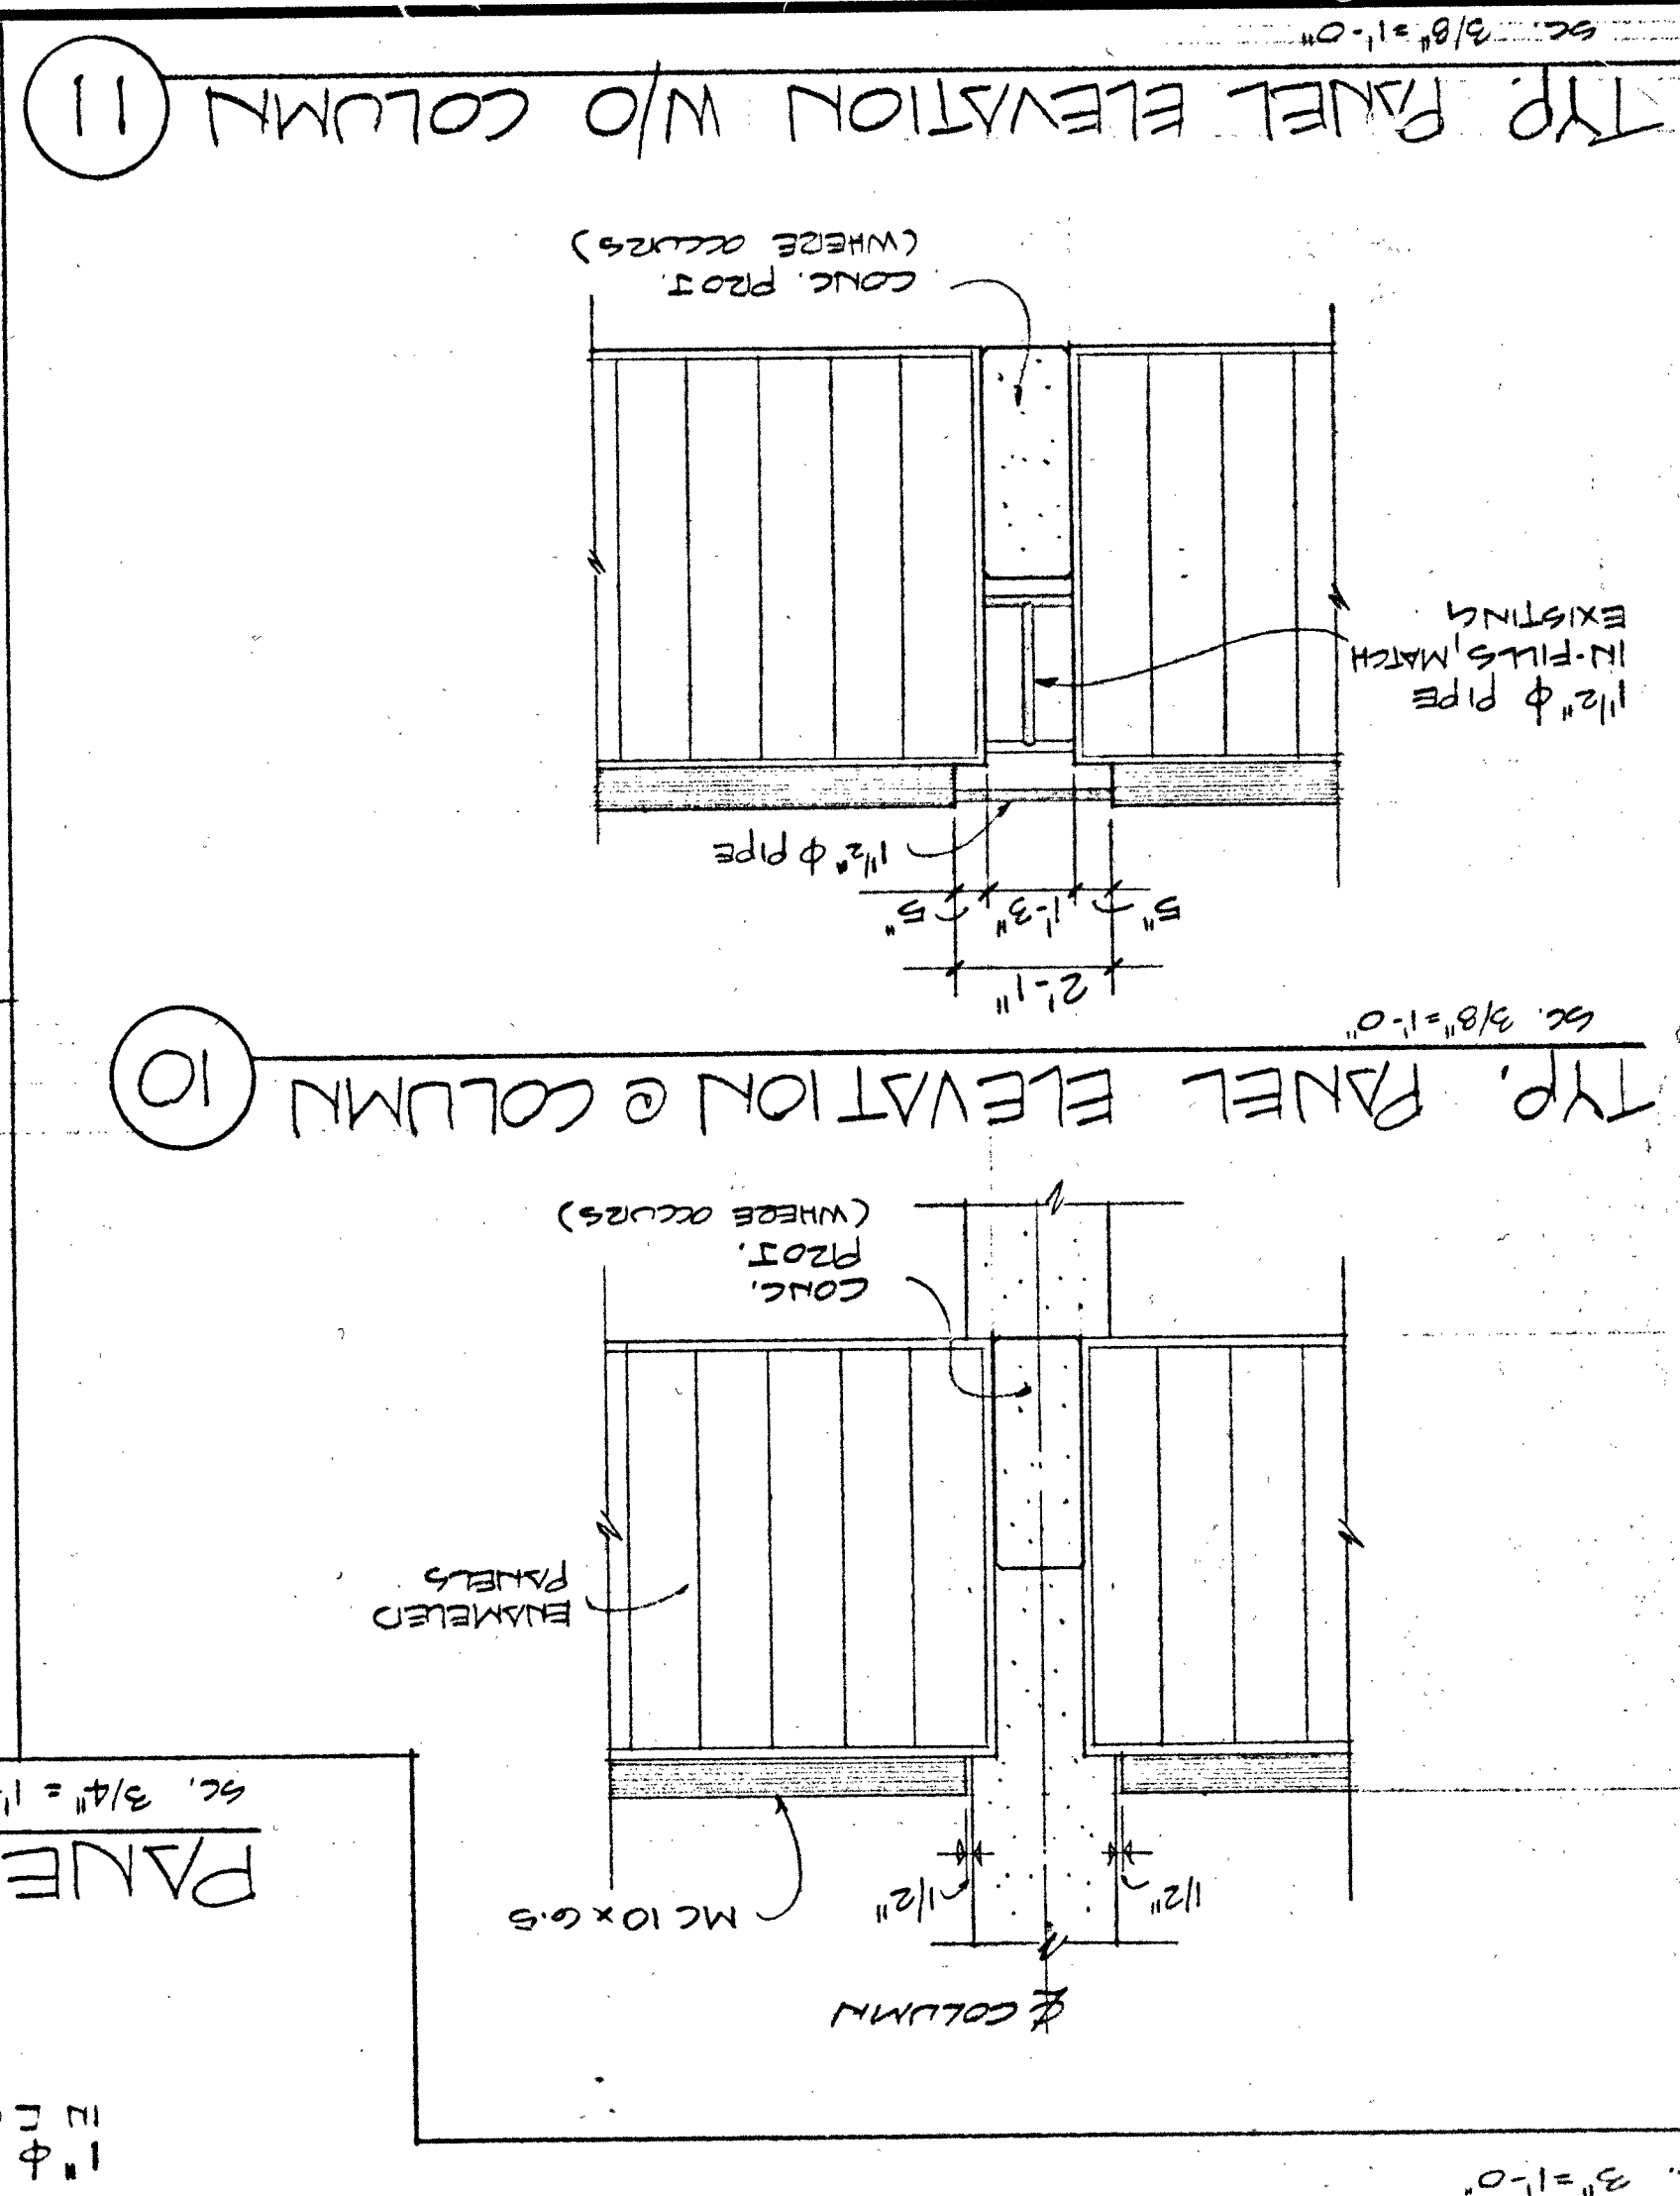
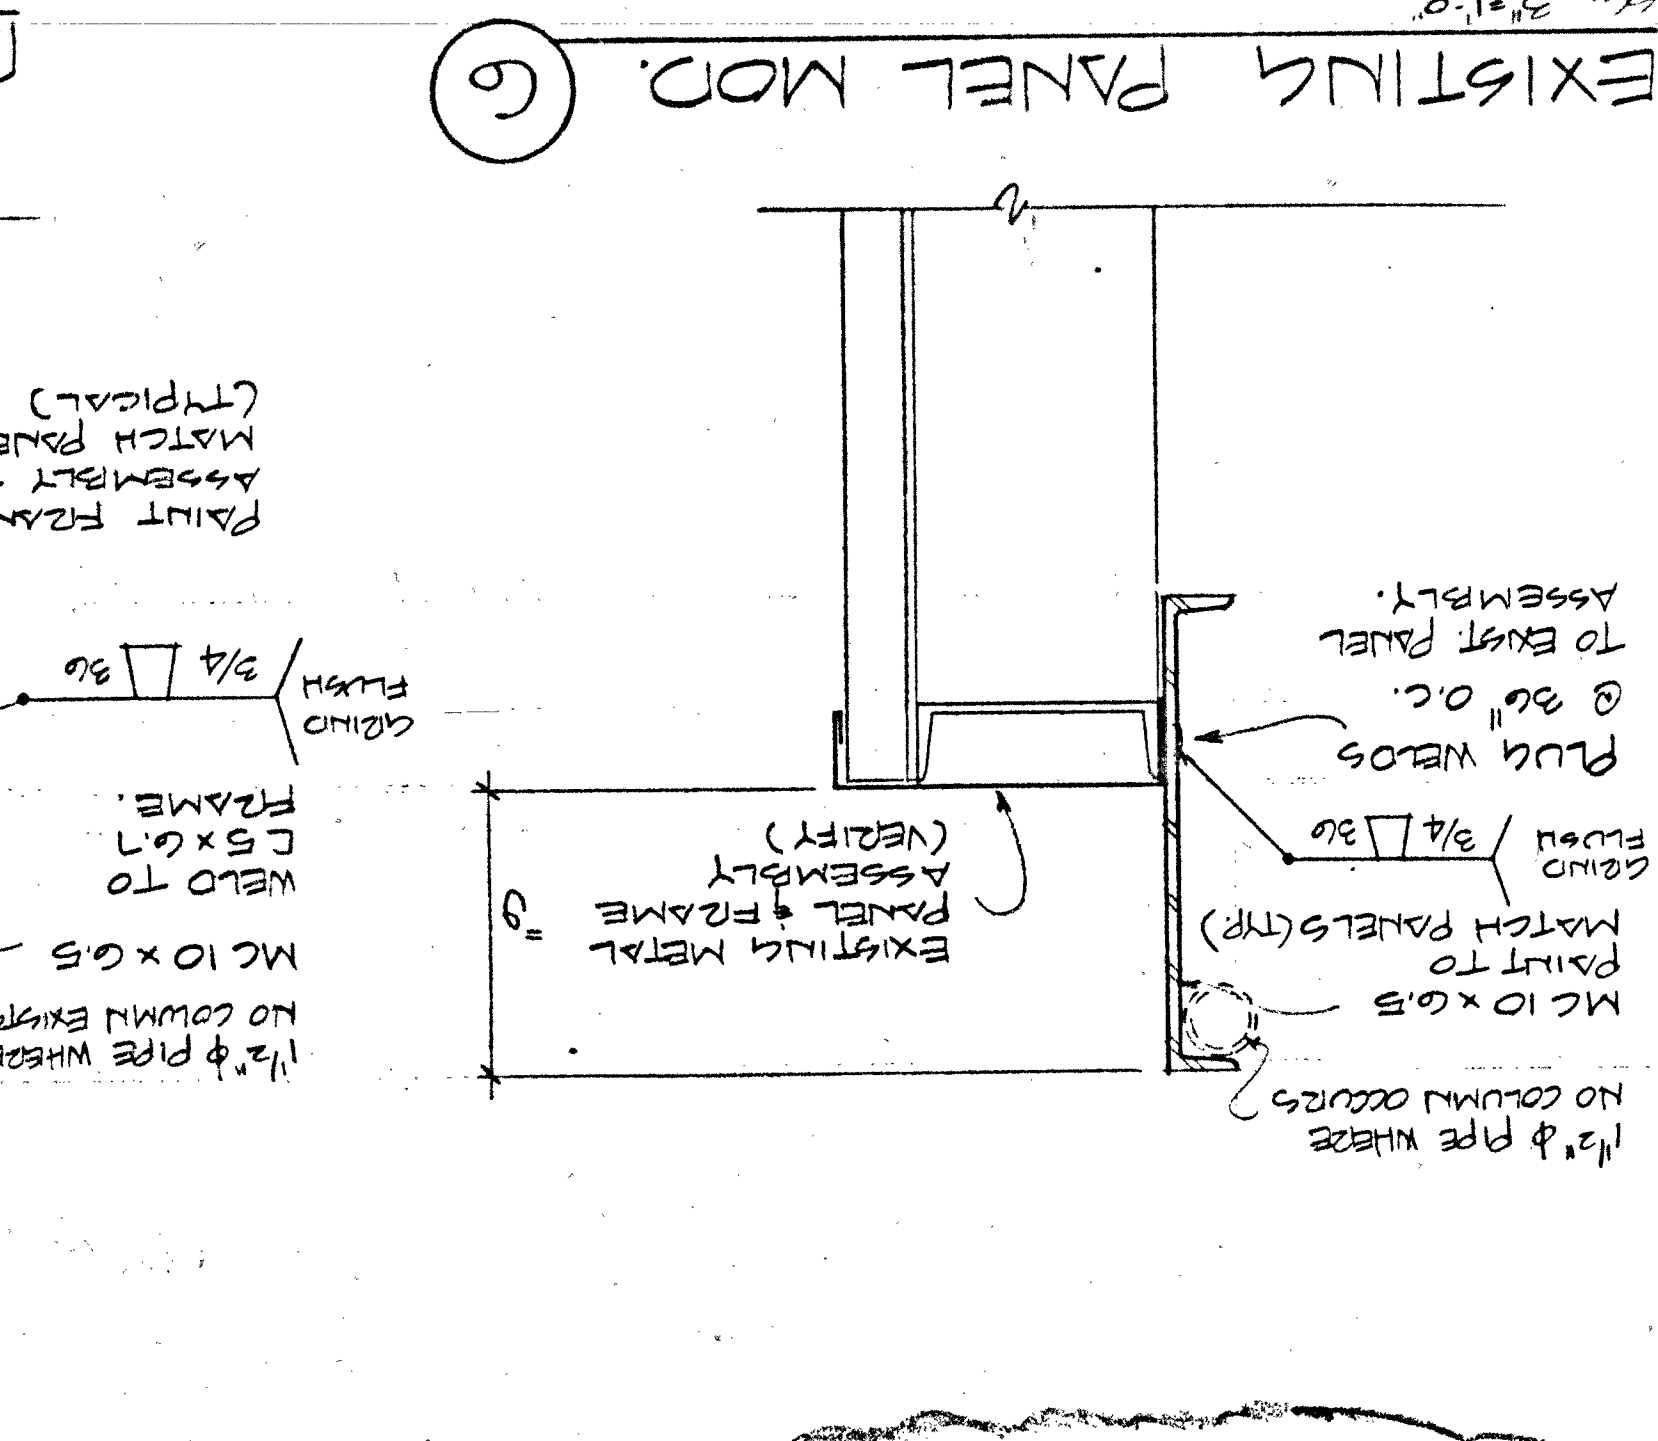
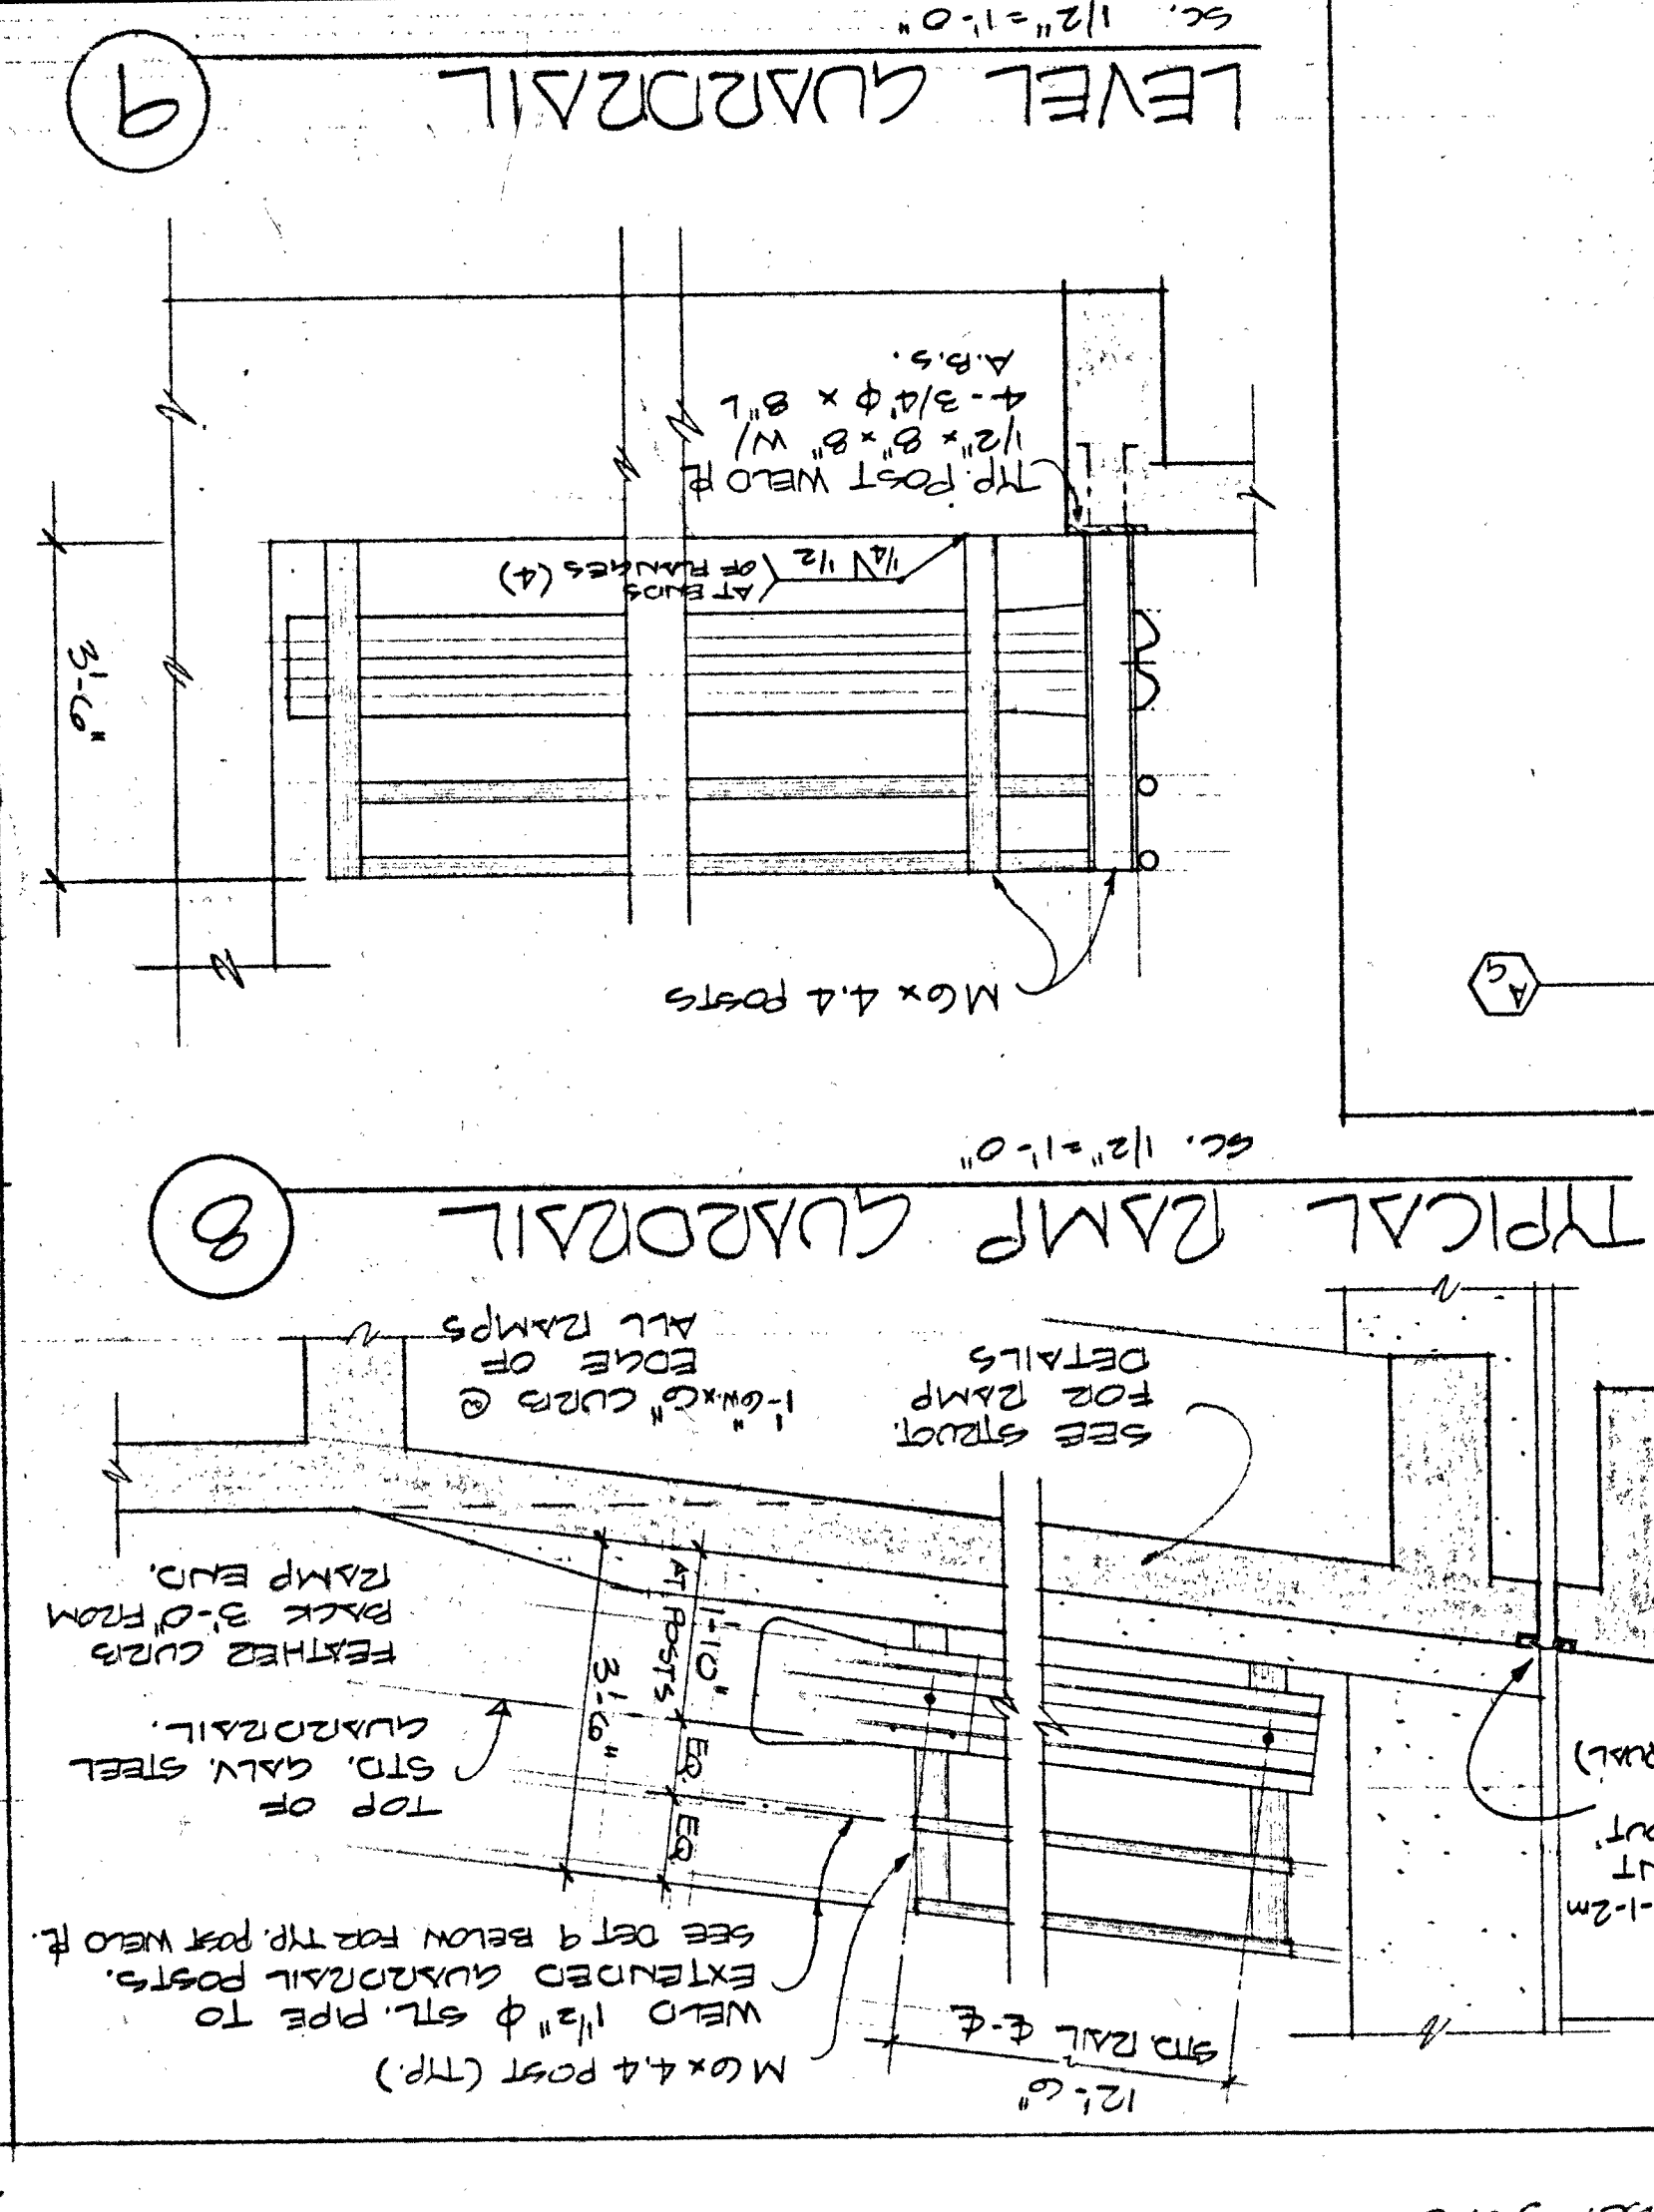
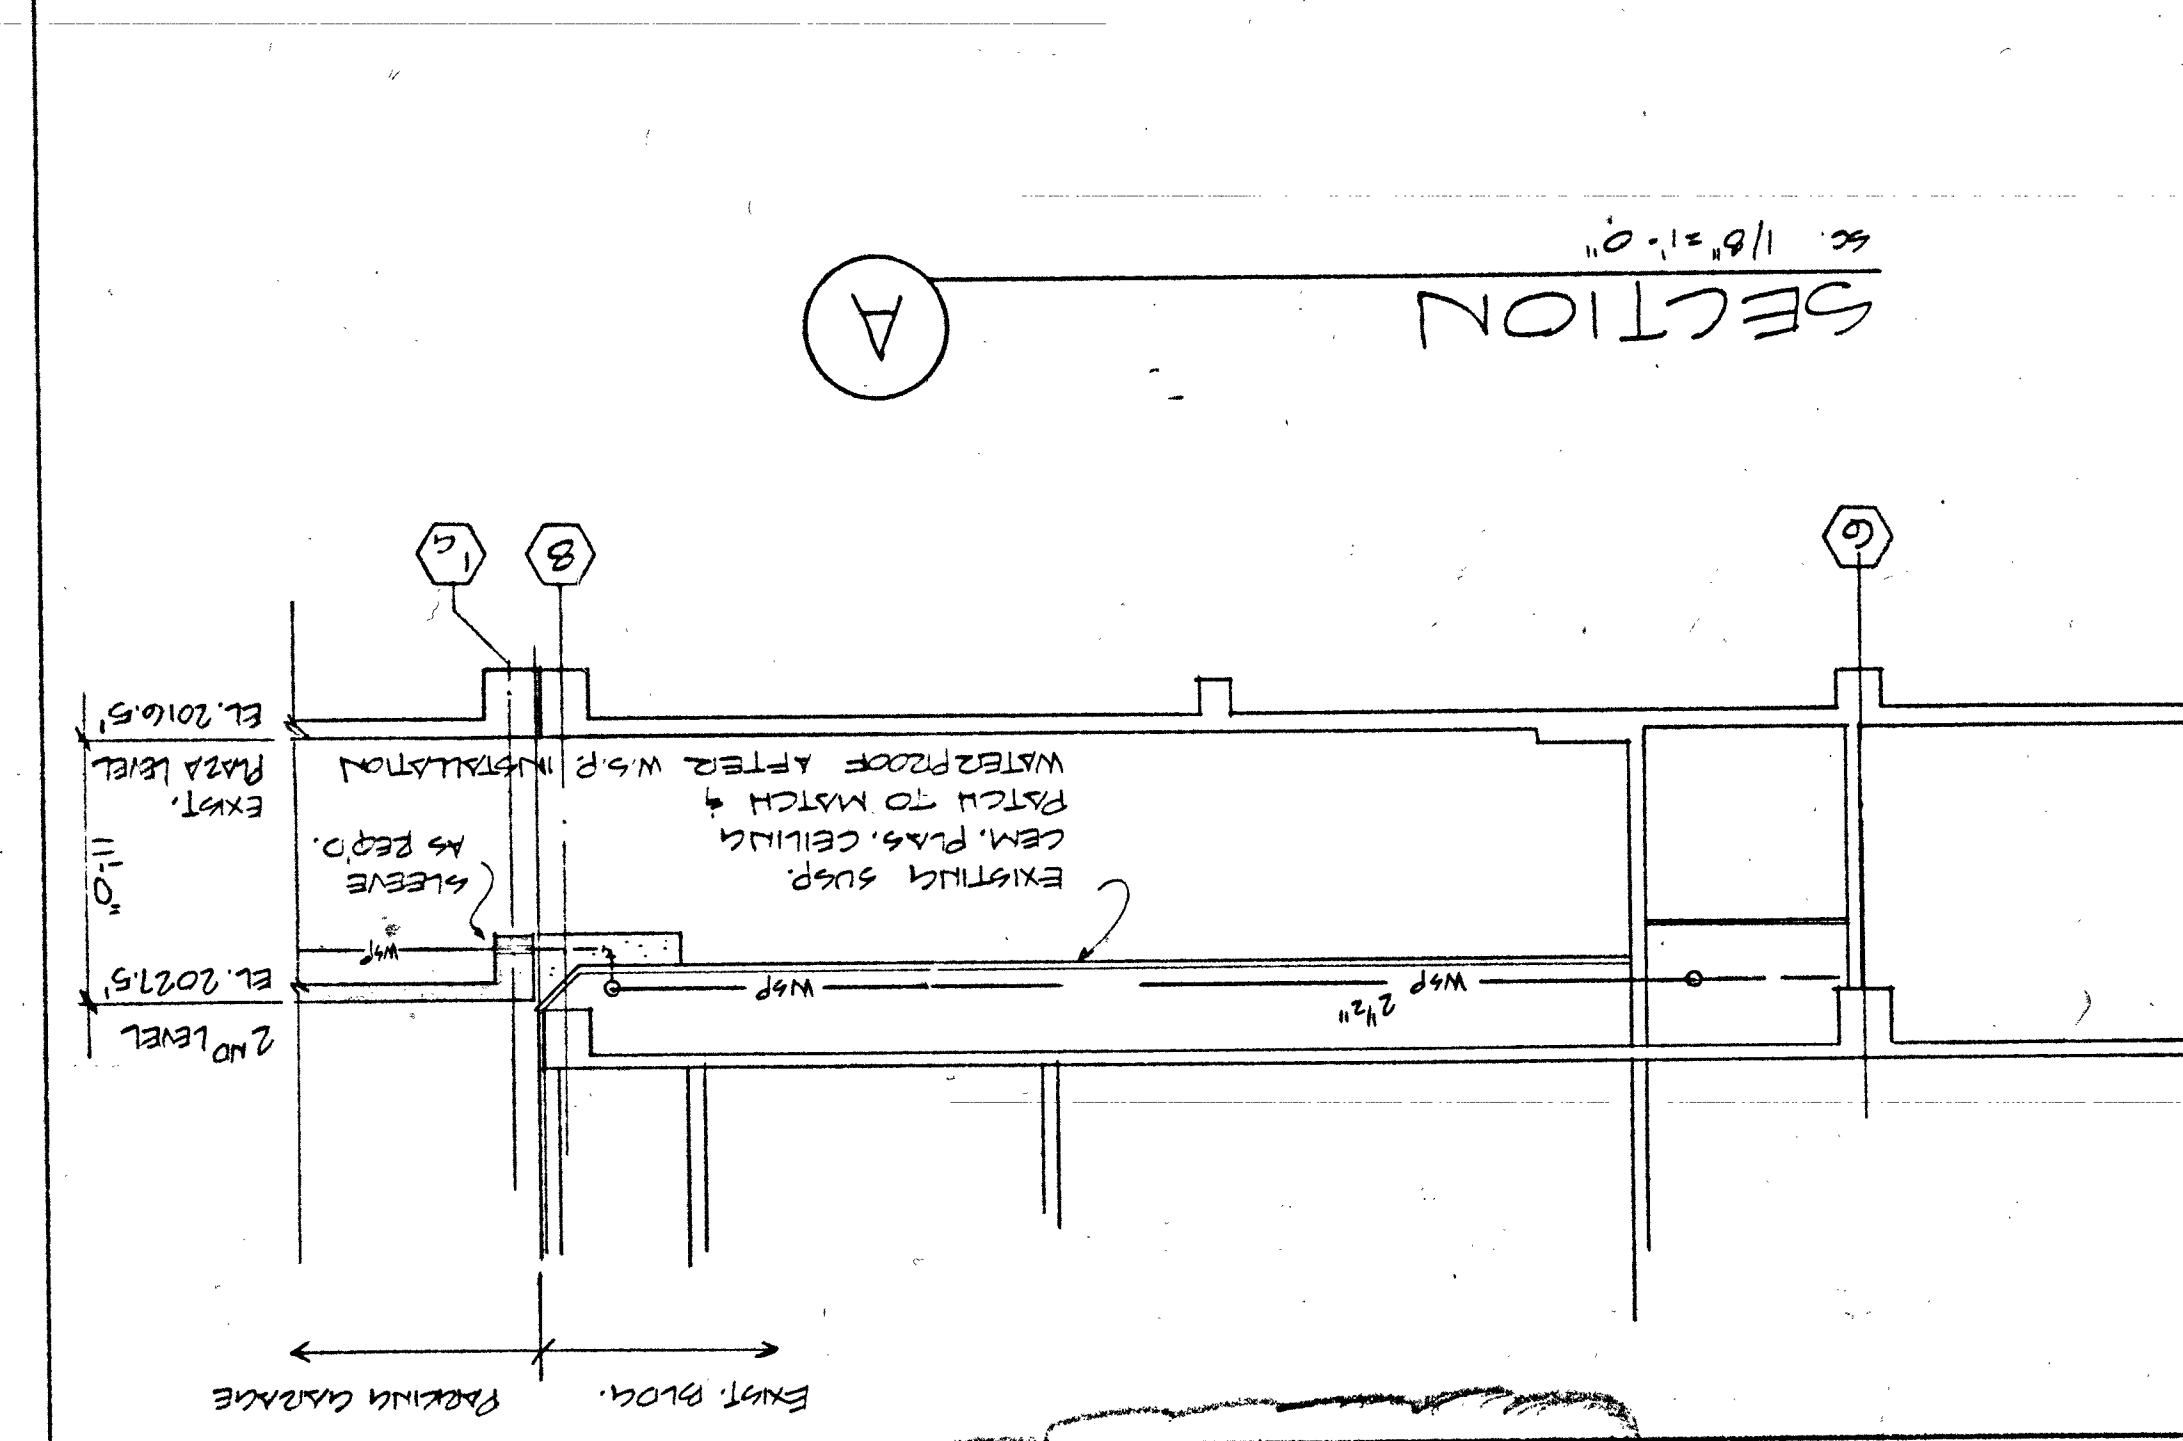


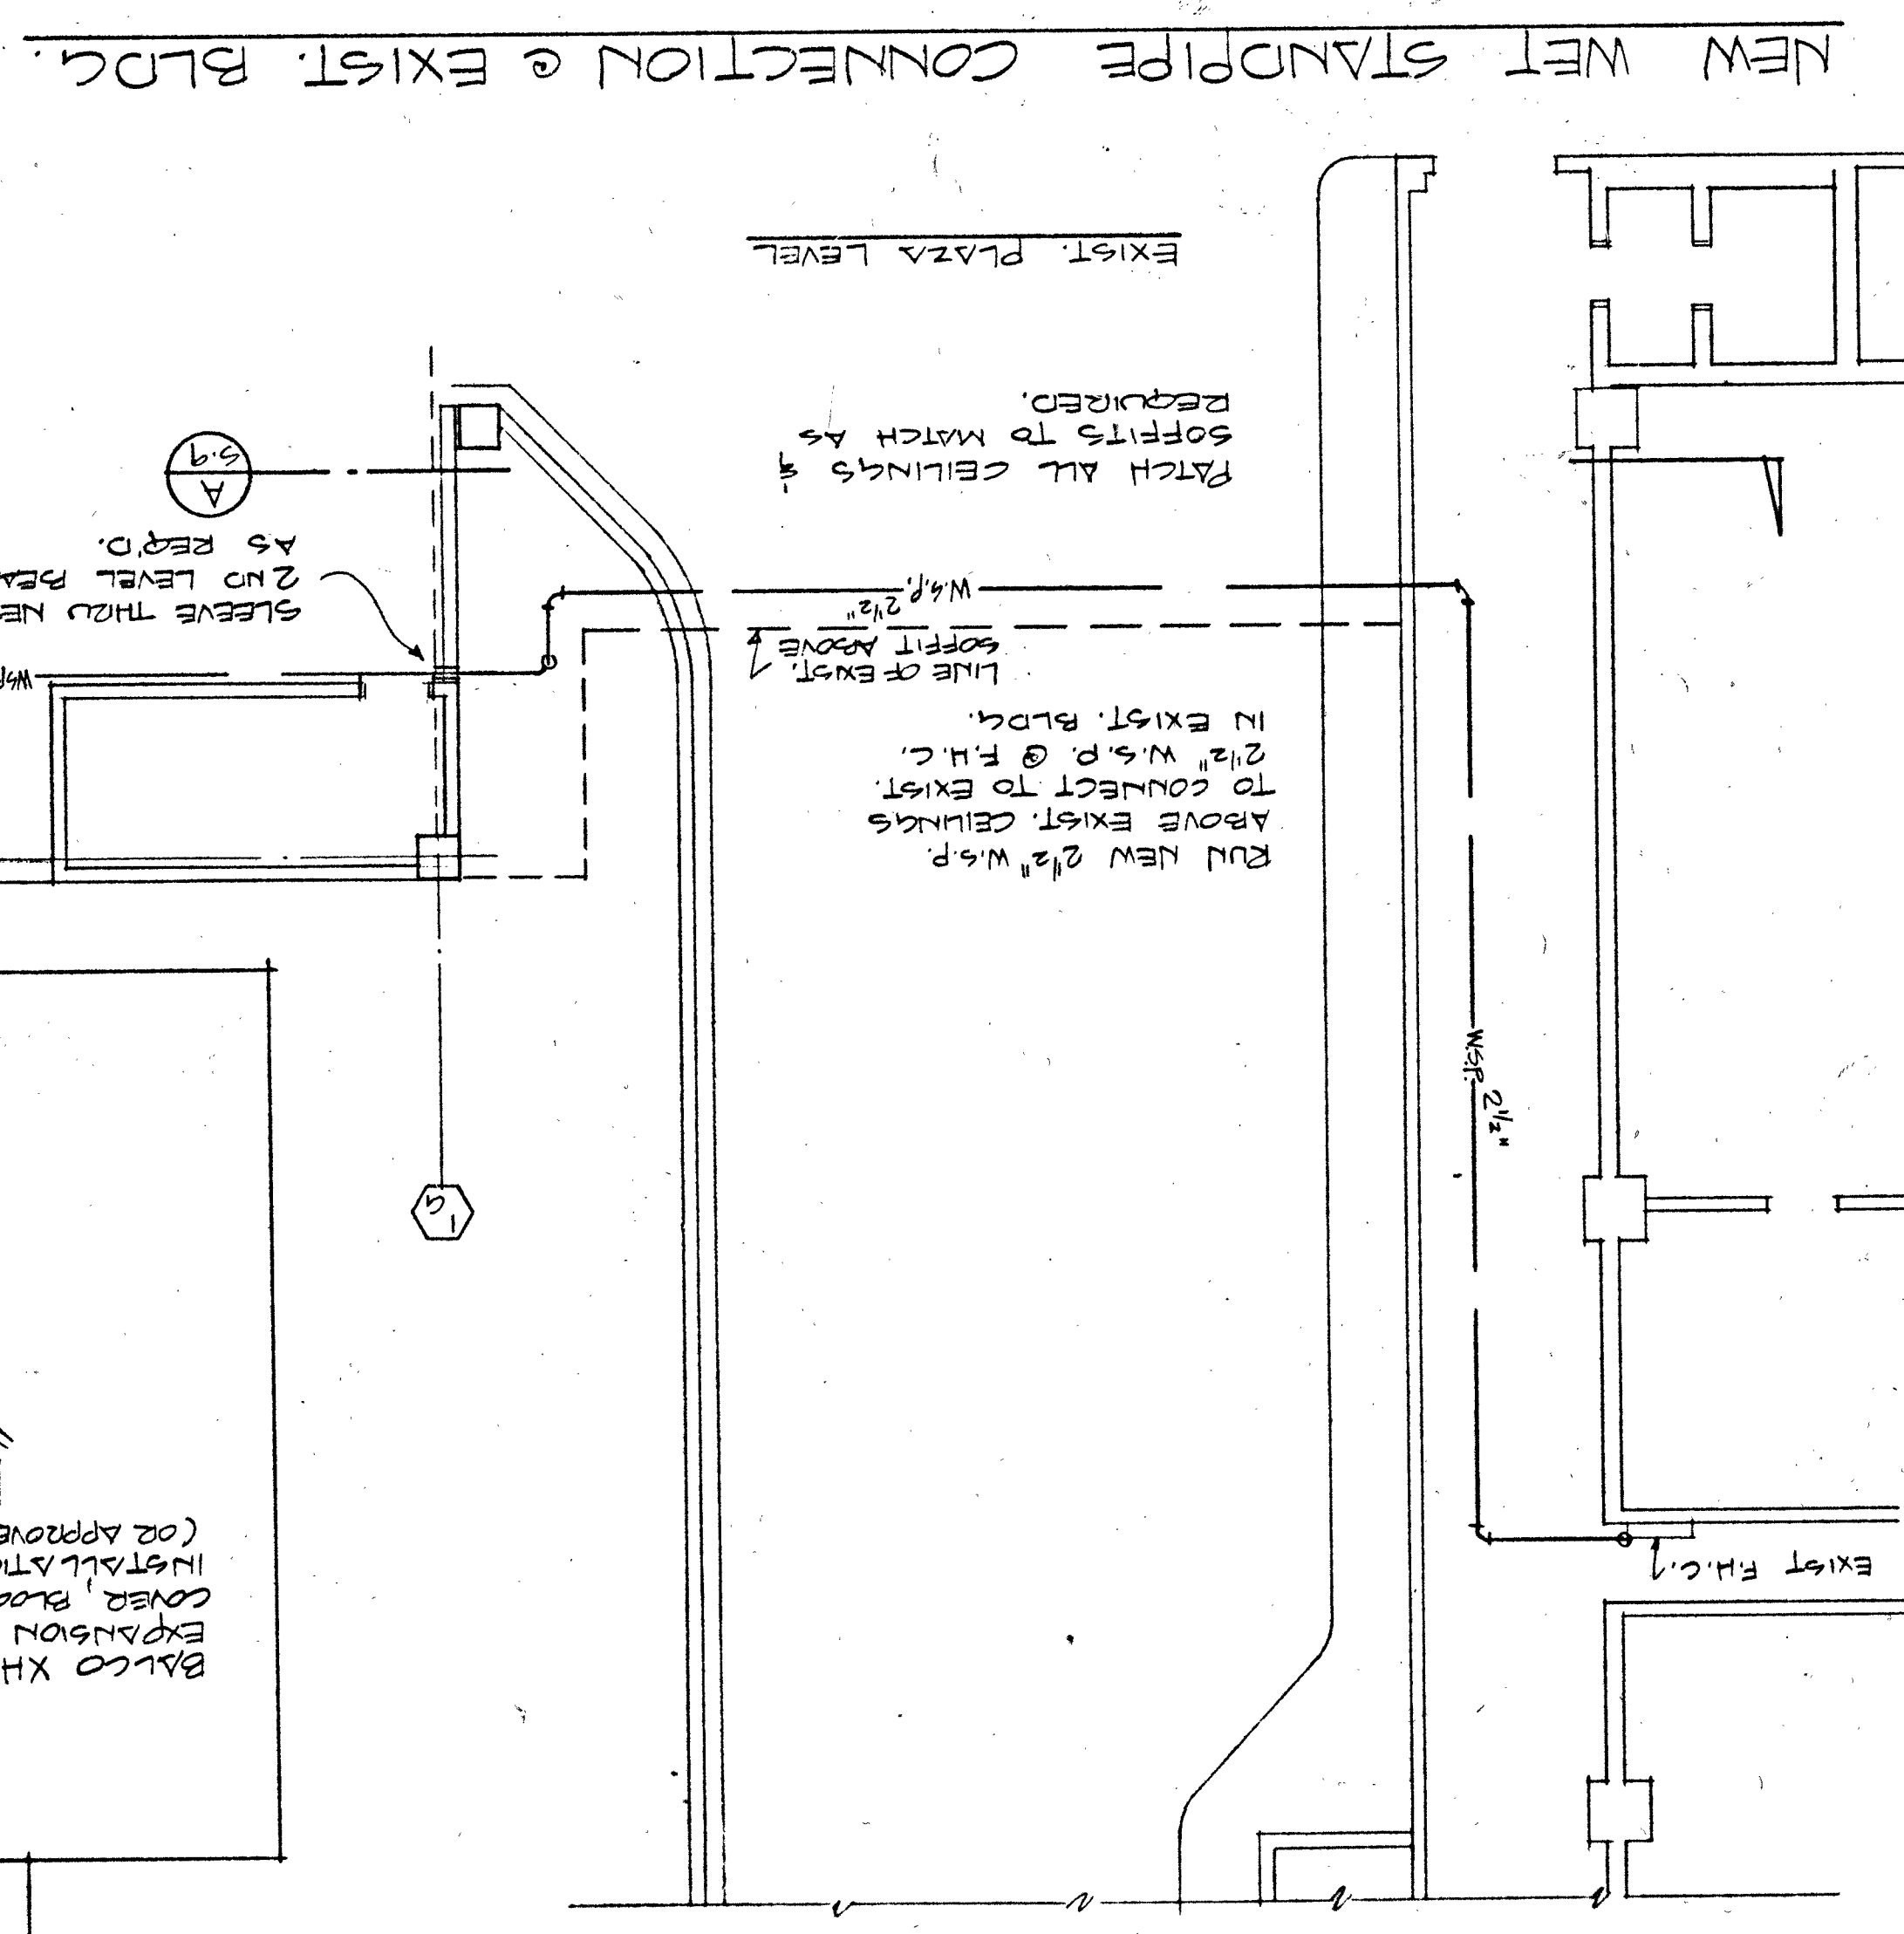

REVISION

DATE	DESCRIPTION
12-14-78	AS-BUILT
1-13-79	CLARIFICATIONS FOR BIDS

ISSUE OR

DATE

ENGINEER

DATE

JOB NO. 77079

SHEET NO.

A-9

JOB TITLE

DOOR TYPES & DETAILS

MISCELLANEOUS DETAILS

JOB TITLE

PARKING GARAGE ADDITION

LAS VEGAS CITY HALL

400 STEWART AVENUE

LAS VEGAS, NEVADA

MARTIN & CASHDAN

STRUCTURAL ENGINEERS

844 EAST SAHARA AVENUE

LAS VEGAS NEVADA 89104

TELEPHONE (702) 735-7166