


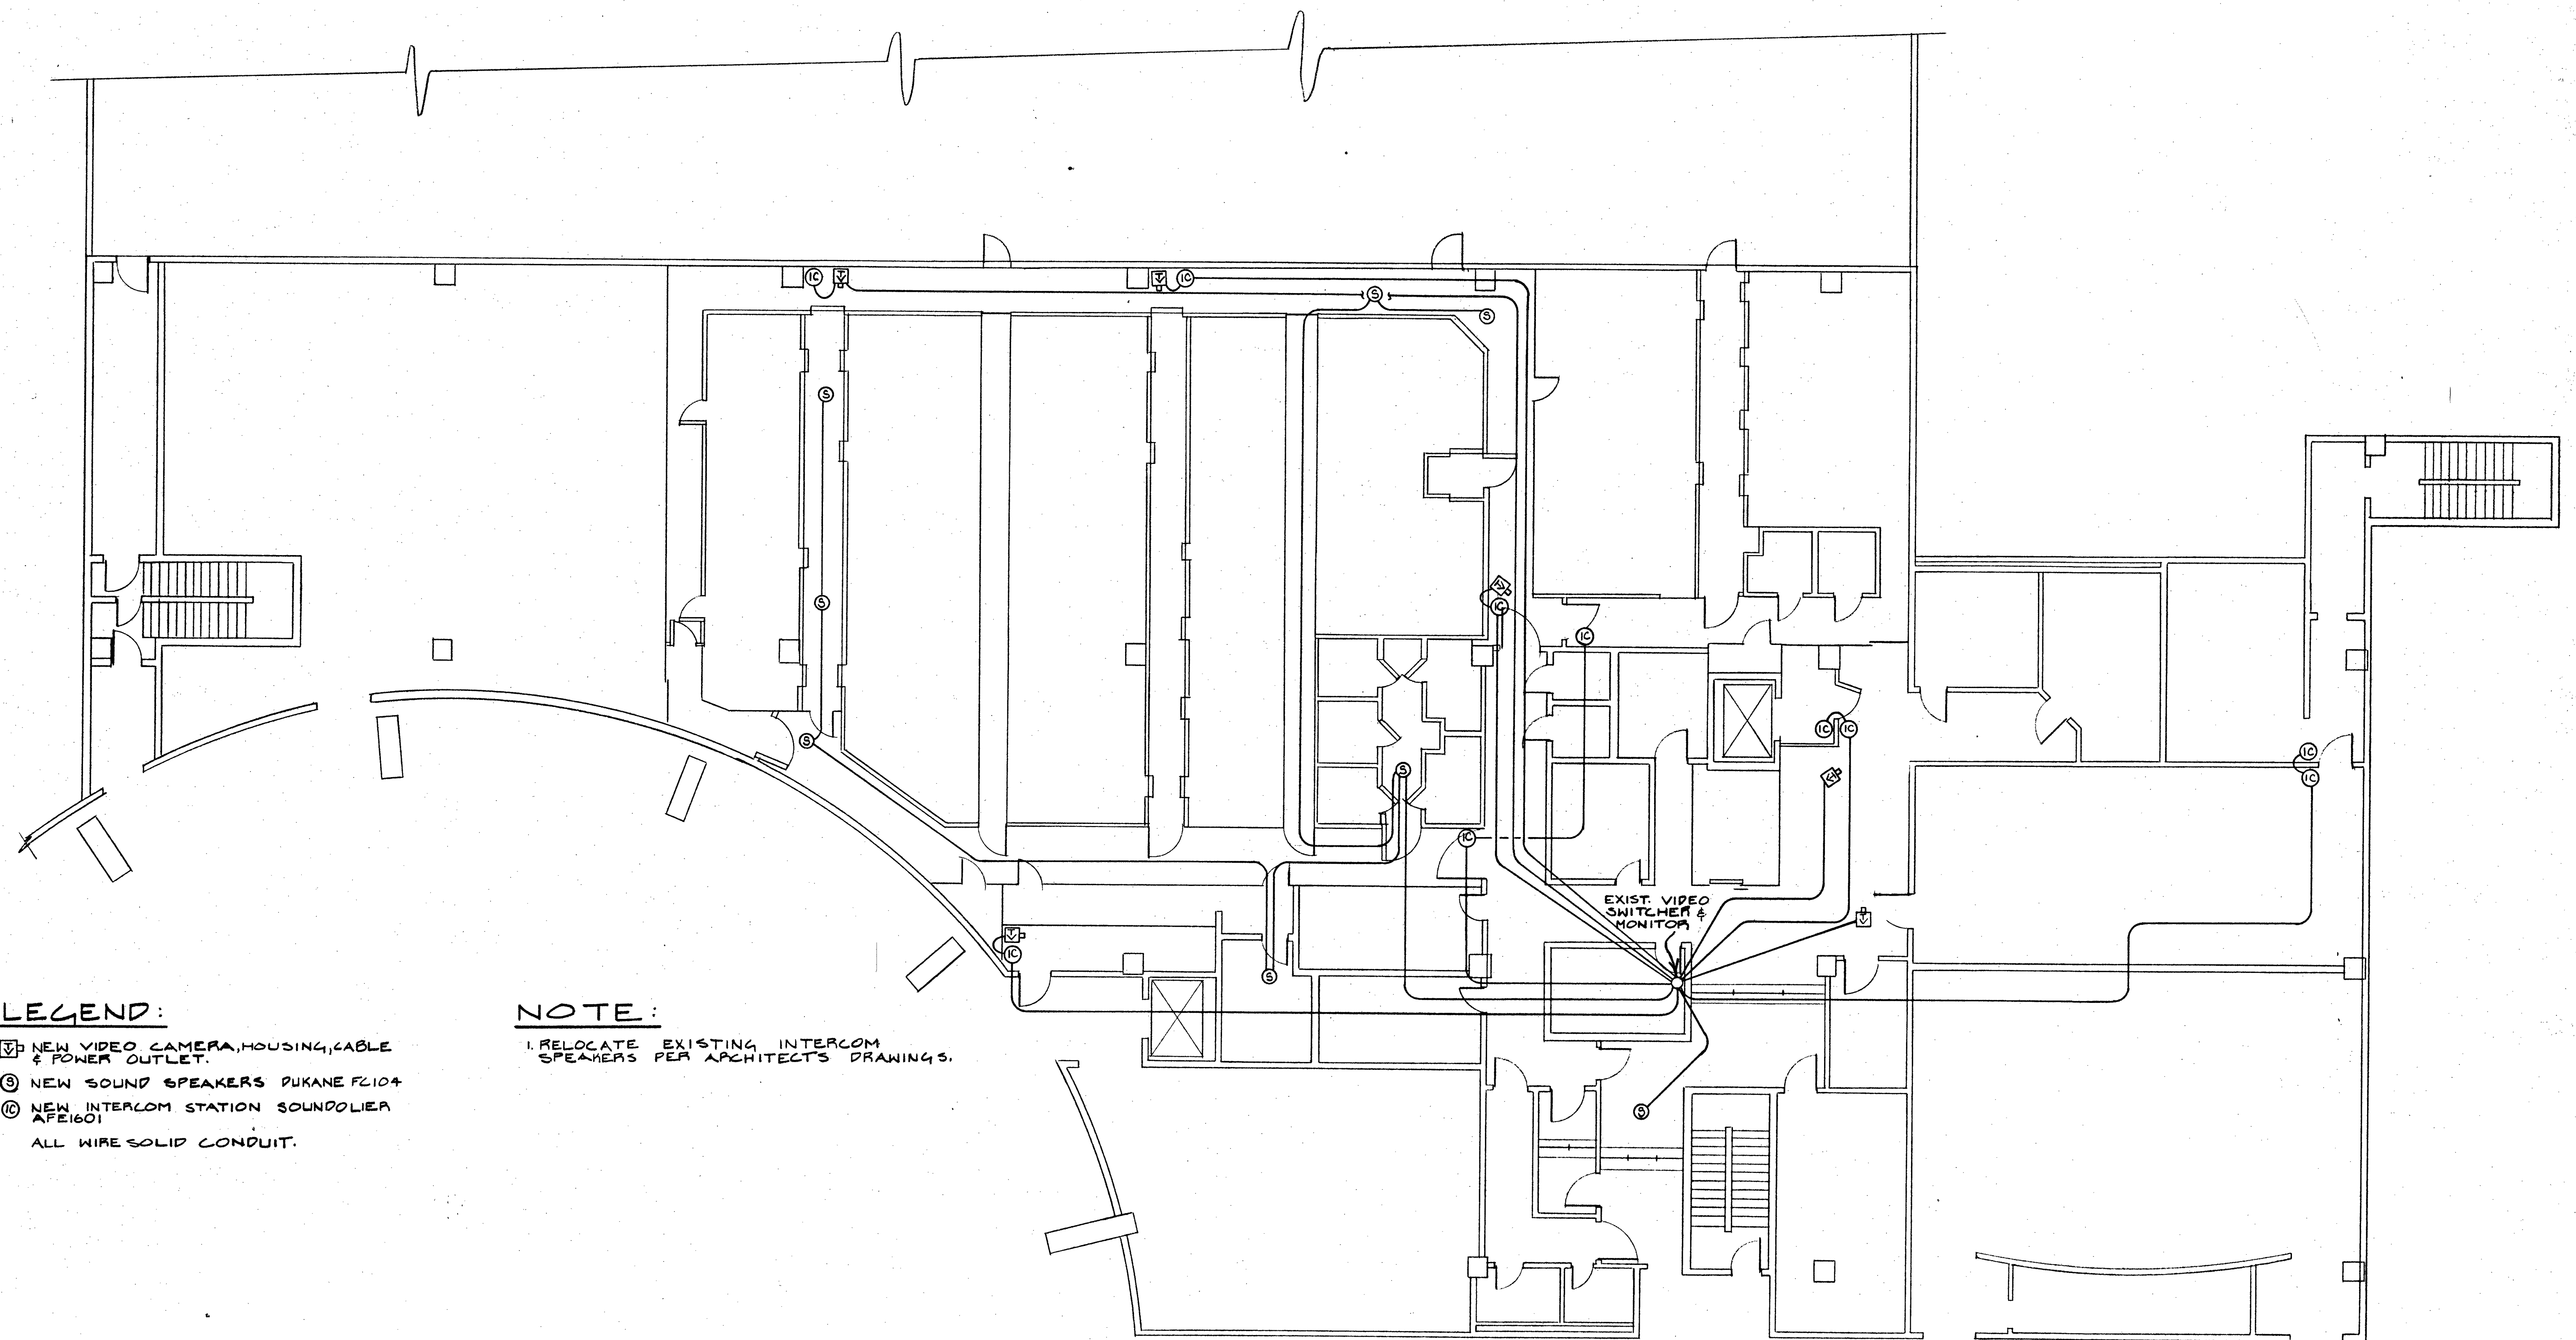

POLICE BUILDING PARTIAL VIDEO & SOUND SYSTEM.

N.T.S.

CITY JAIL			
SCALE: N.T.S.	APPROVED BY: AS BUILT.	DRAWN BY: P.A.C.	
DATE: 8-12-81	REVISED	POLICE BLDG. PART. 2 ND LEVEL VIDEO & SOUND SYS.	
ELLIS INDUSTRIAL ELECTRONICS	385-5580	DRAWING NUMBER 1 OF 4	