


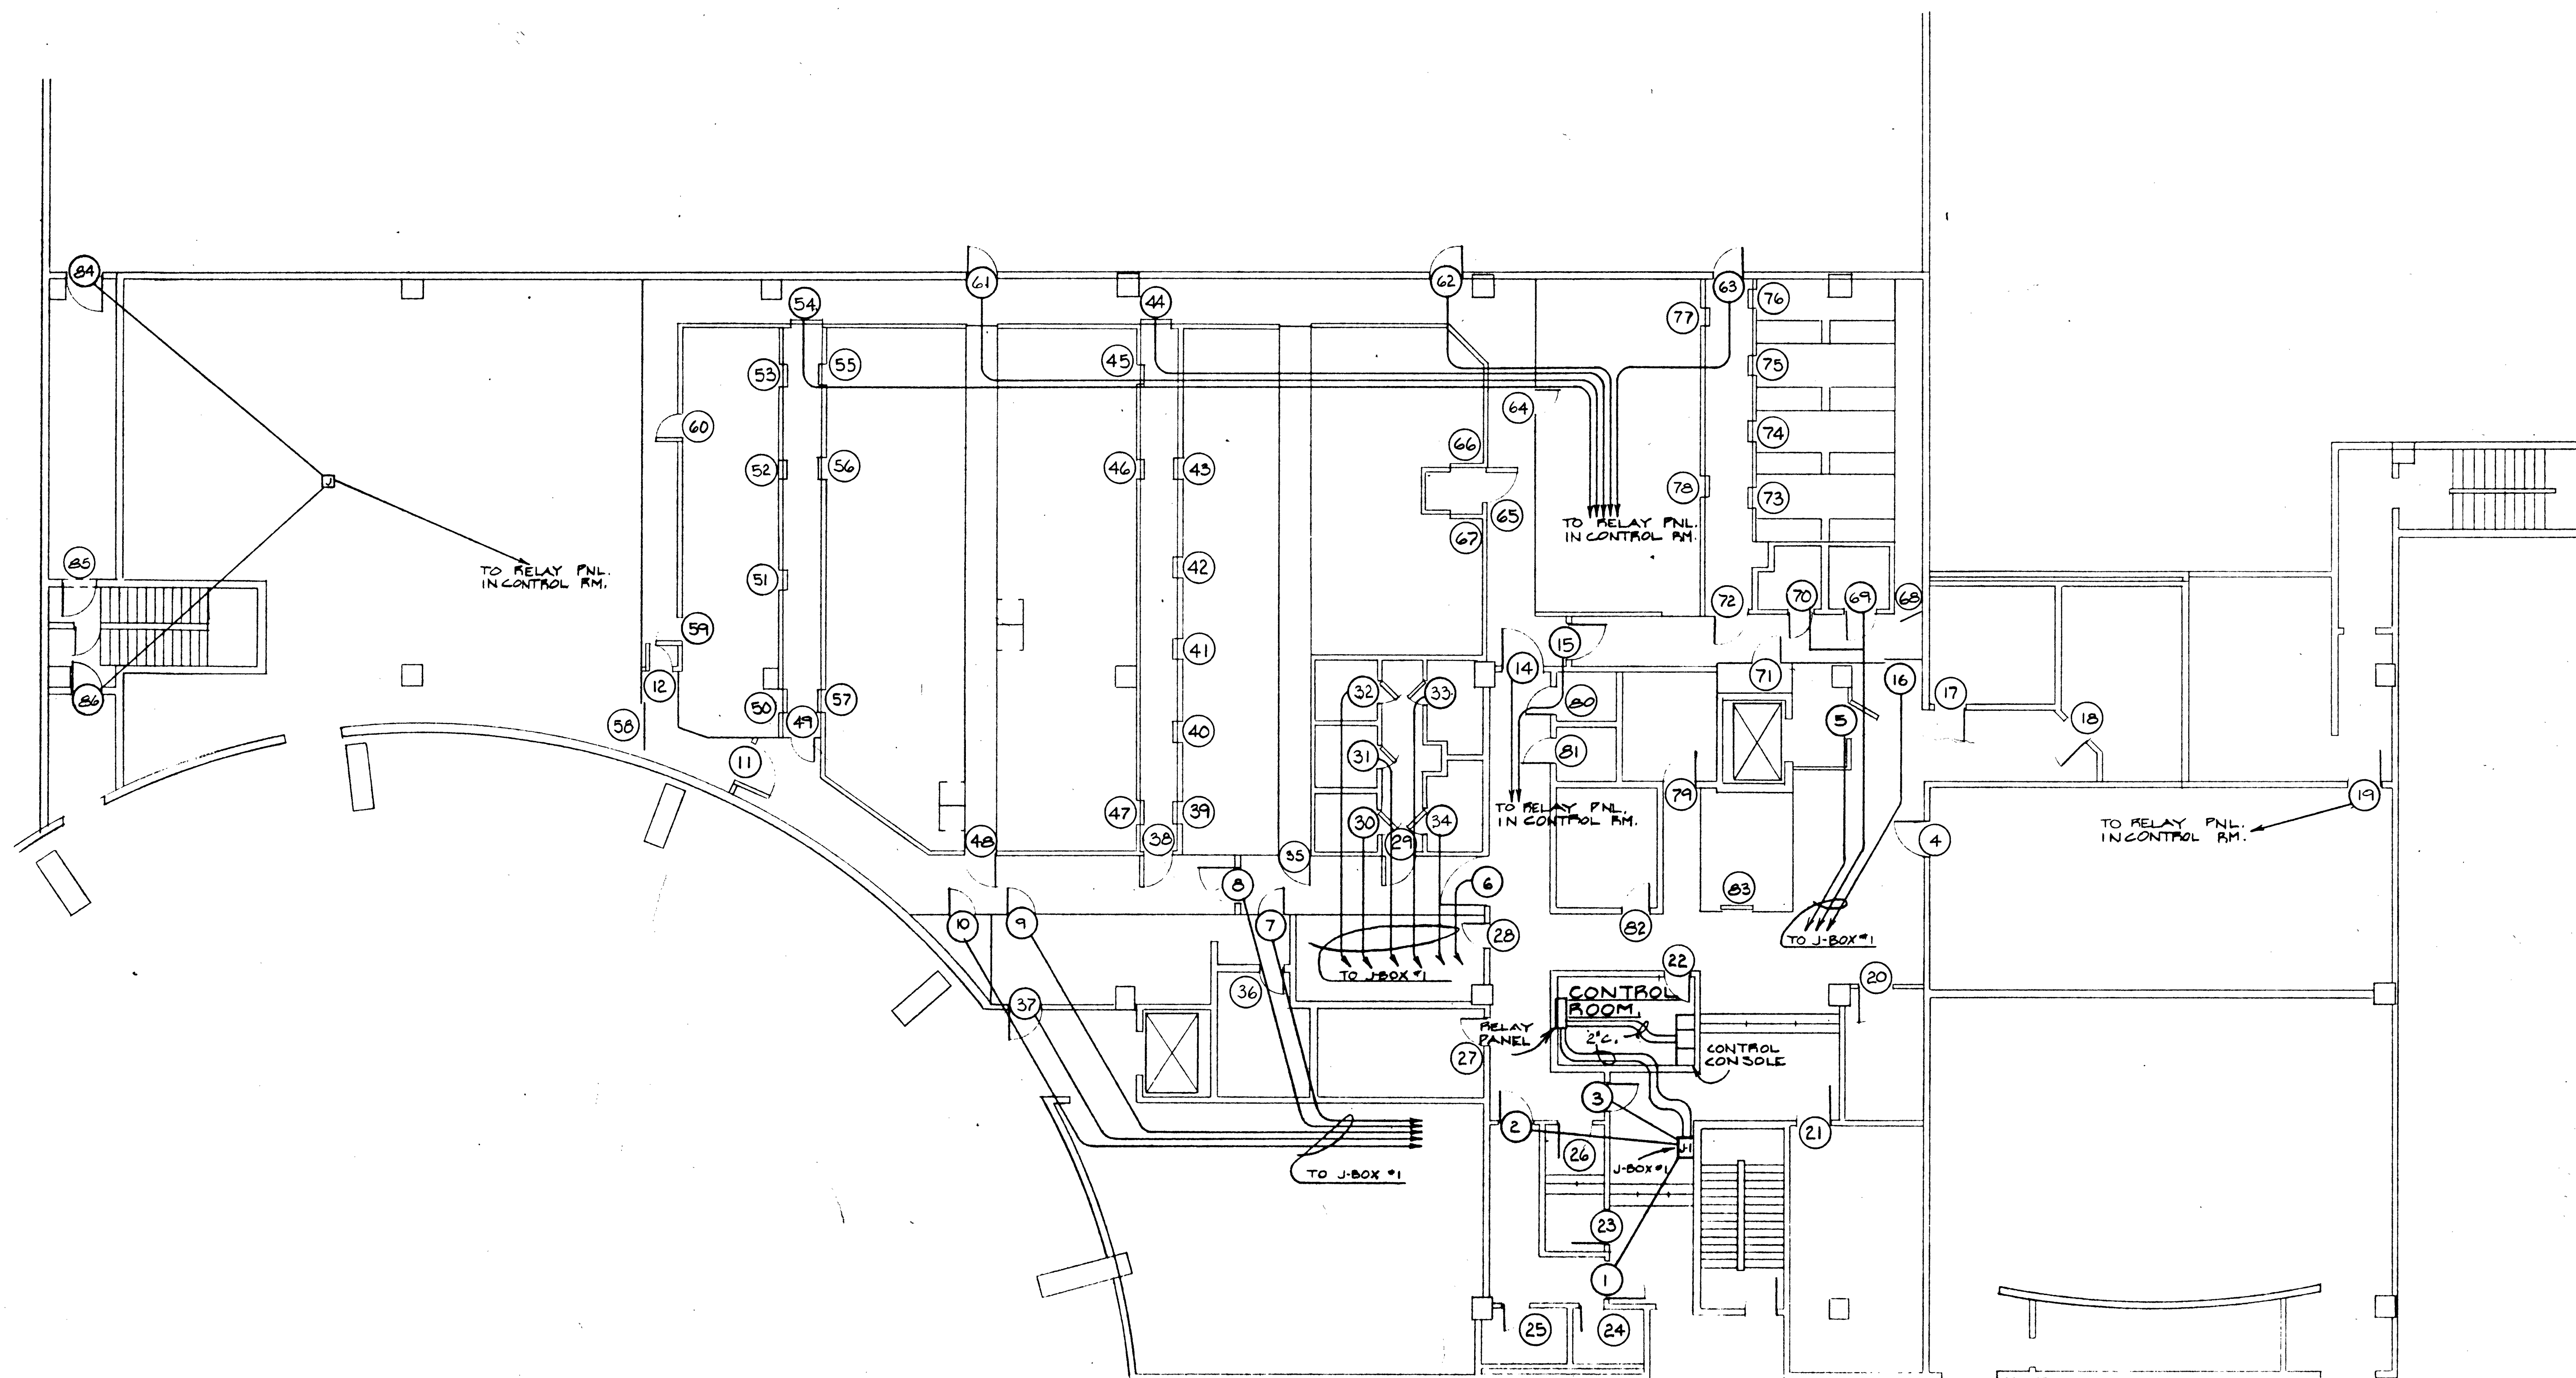

POLICE BLDG. PARTIAL DOOR CONTROL SYS.
N.T.S.

9-13-82

San Mateo
9-13-82
Rm

CITY JAIL / AS BUILT		
DATE N.T.S.	APPROVED BY	DRAWN BY
DATE	REVISED	
DOOR CONTROL SYS.		
ELECTRICAL (702) 453-6100		3