


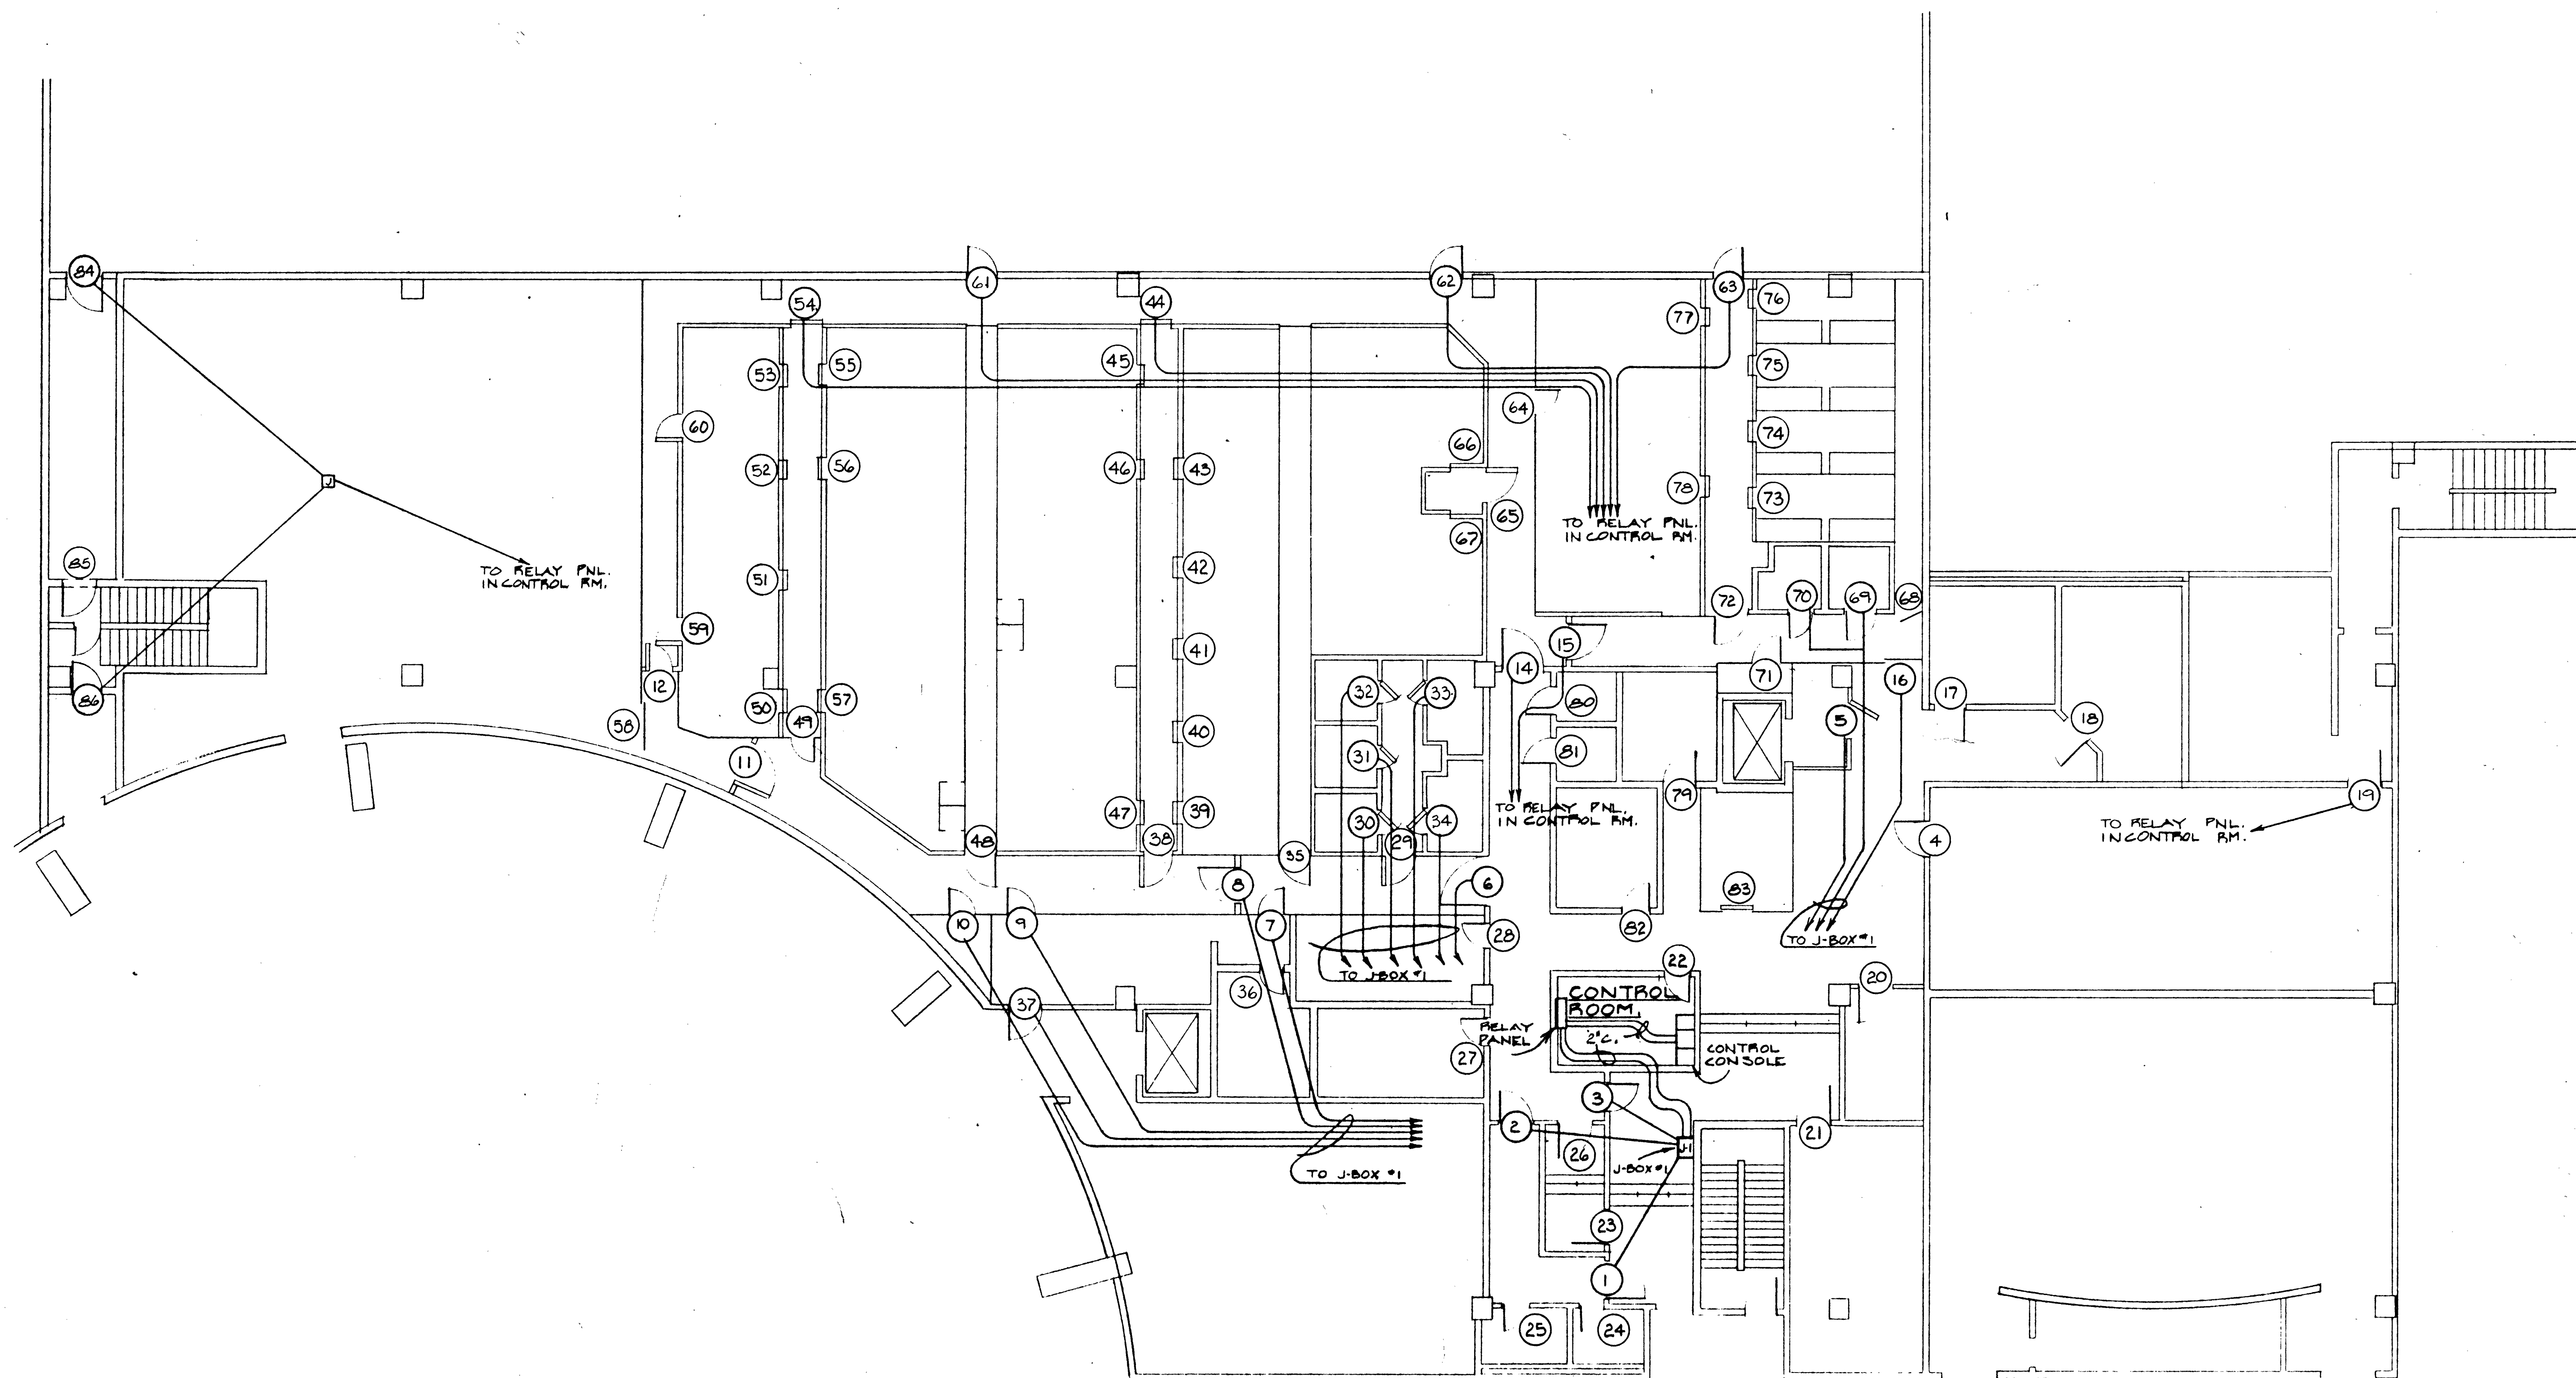

POLICE BLDG. PARTIAL DOOR CONTROL SYS.
N.T.S.

9-13-82

CITY JAIL / AS BUILT		
DATE 9-13-82	APPROVED BY [Signature]	DRAWN BY [Signature]
DOOR CONTROL SYS.		
ELECTRICAL (702) 453-6100		REVISION NUMBER 3