



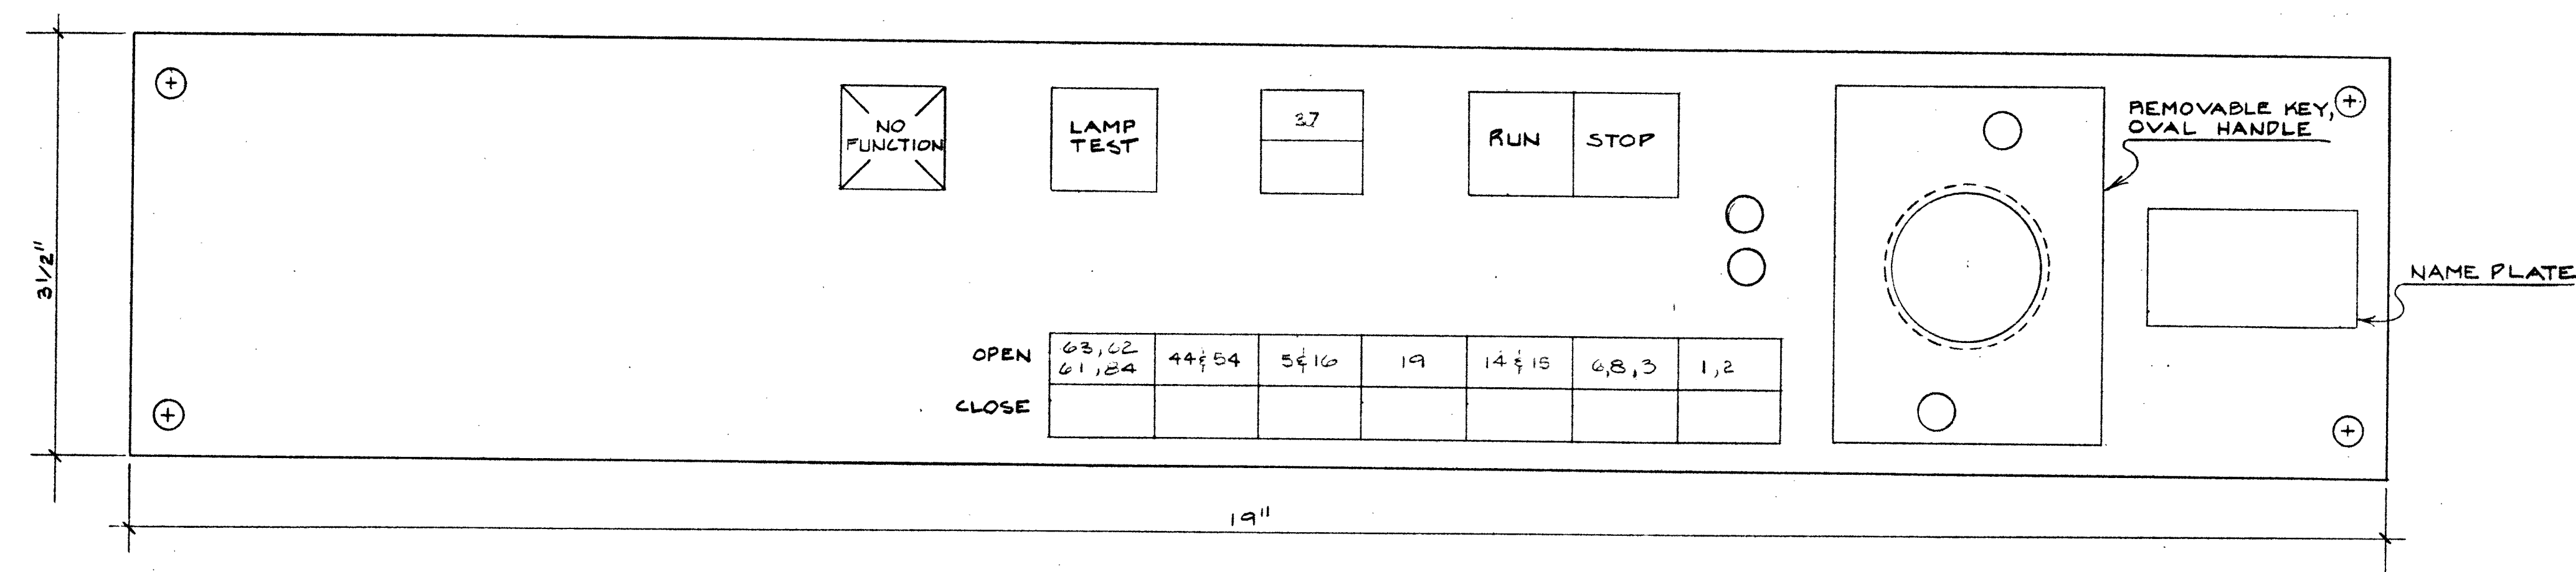

EMERGENCY PANEL - SWITCH ARRANGMENT.
SCALE: 1" = 1"

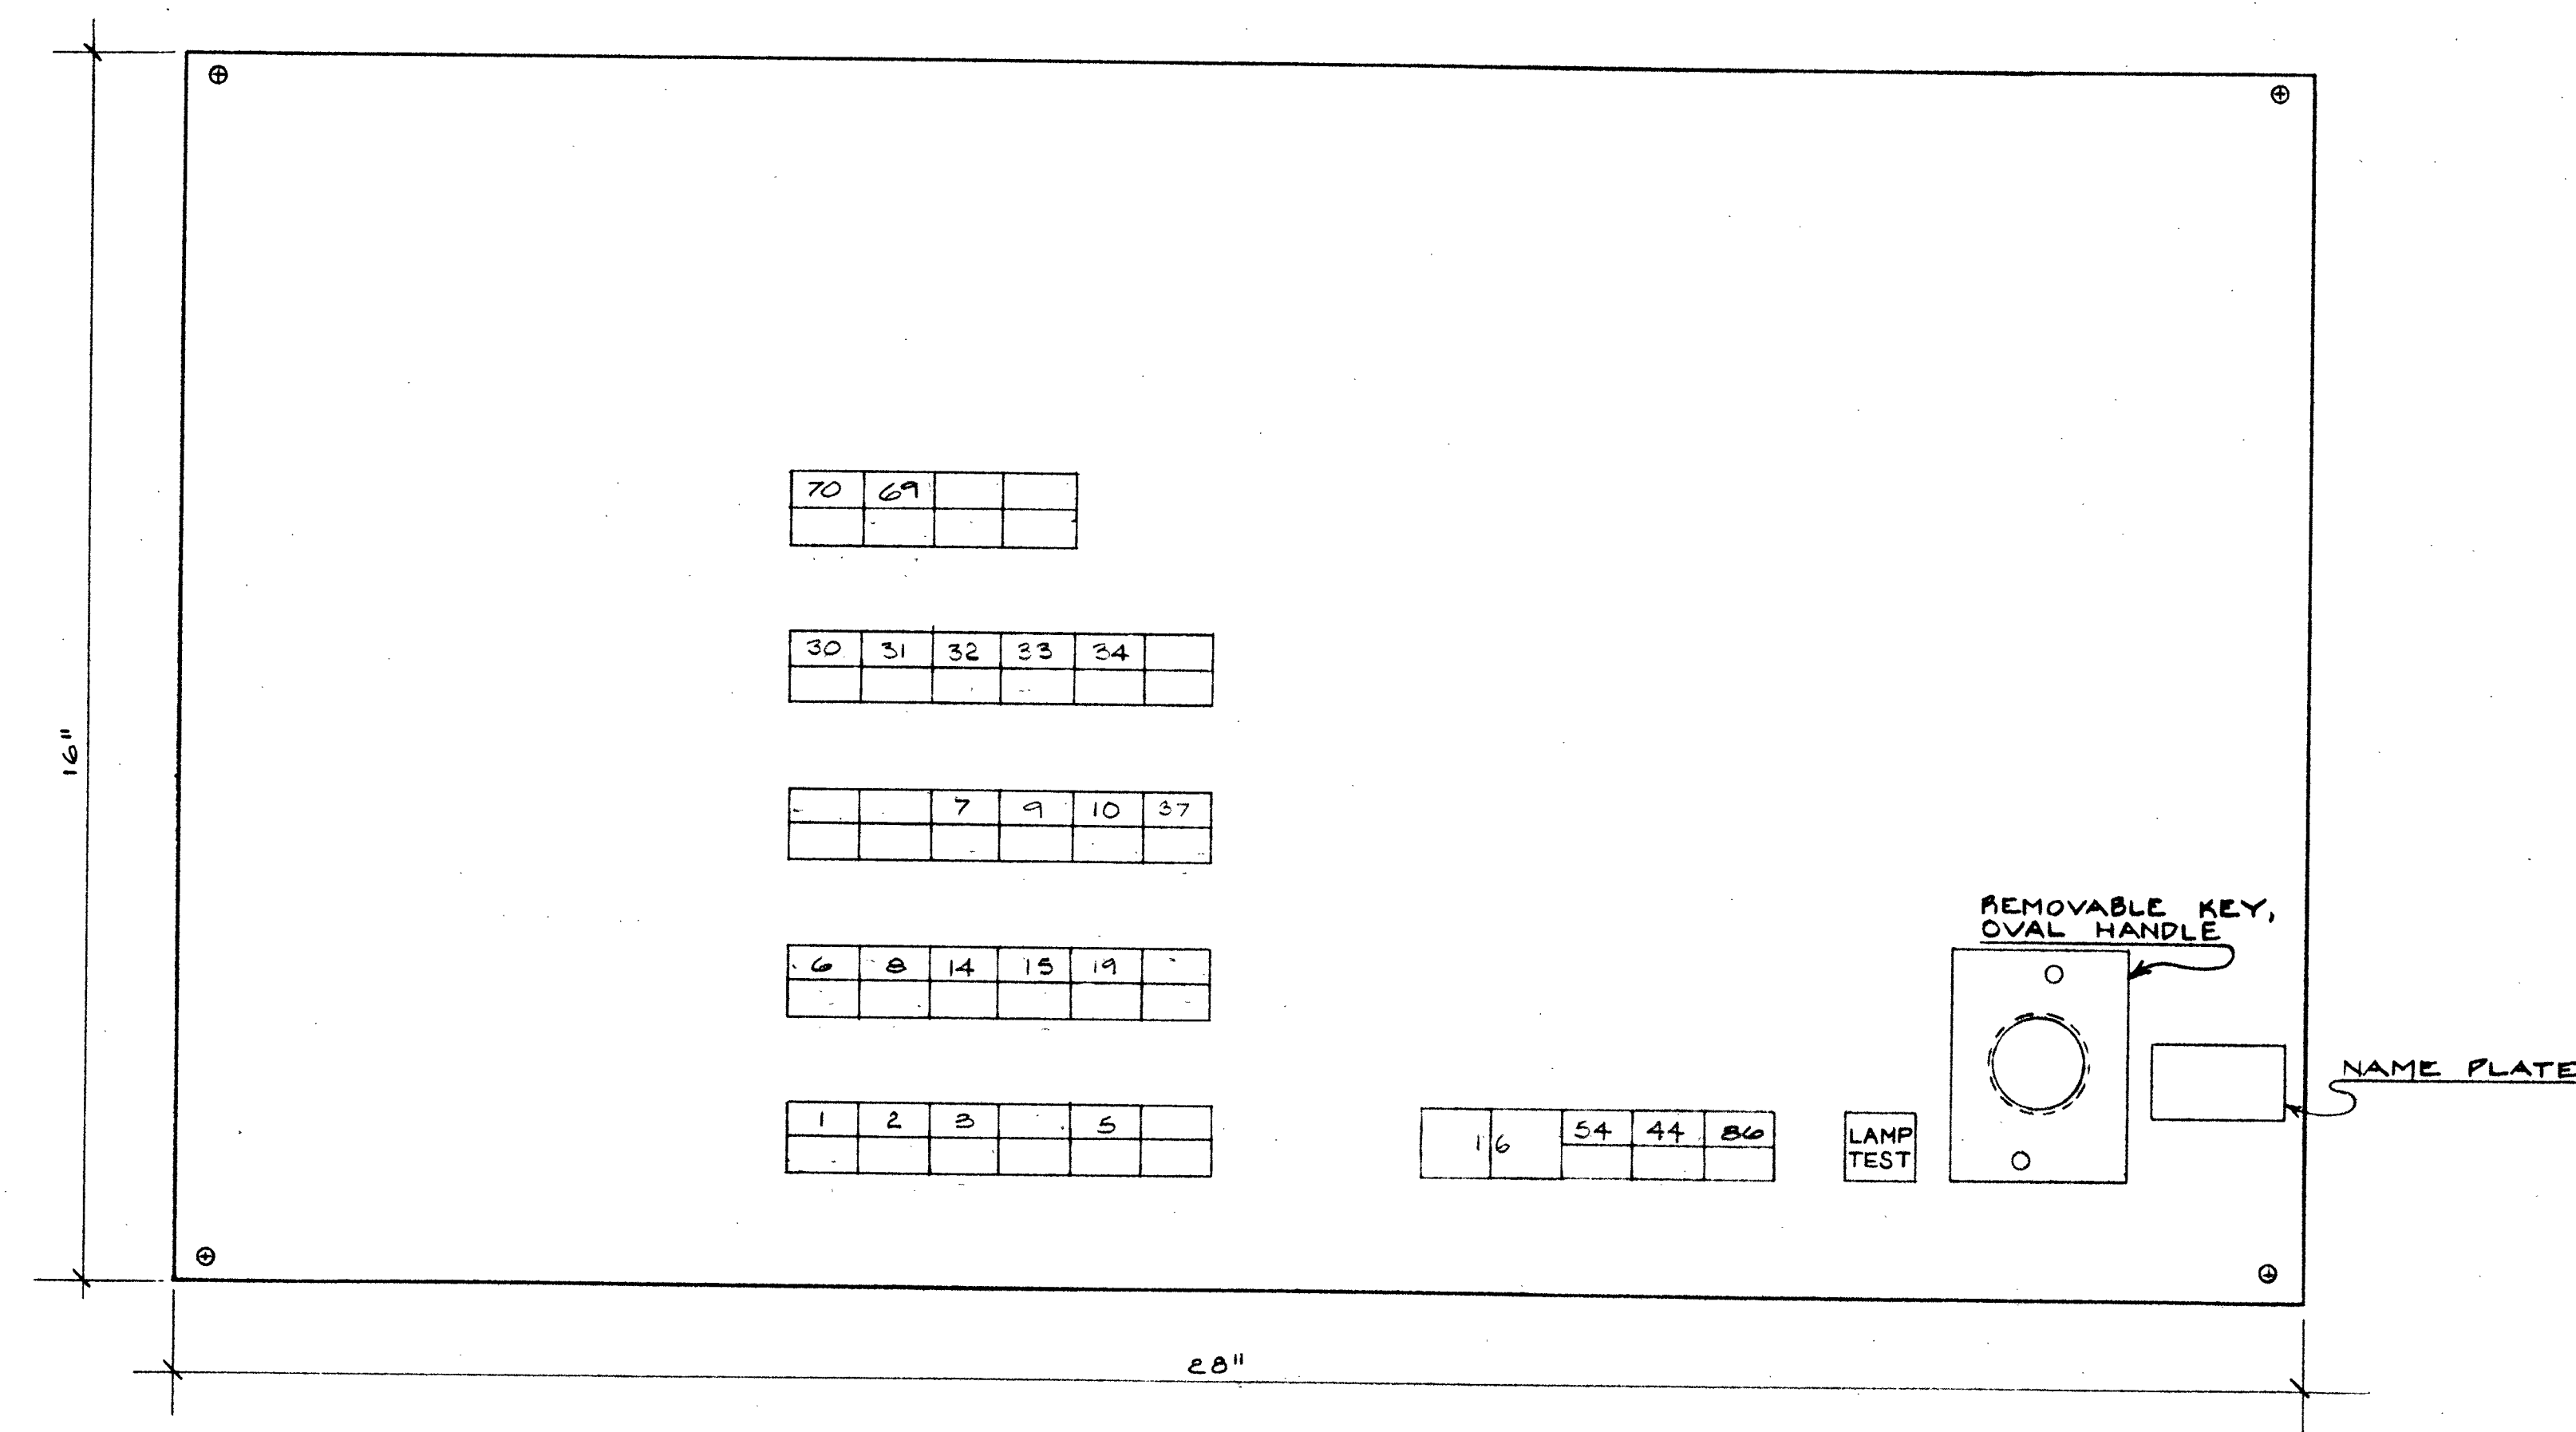

DAILY PANEL - SWITCH ARRANGMENT
SCALE: 1/2" = 1"

ASEMIT
9-13-82

CITY JAIL		
SCALE: AS SHOWN	APPROVED BY: AS BUILT.	DRAWN BY: RAY
DATE: 8-12-81		REVISED
SWITCH PANELS		
ELLIS INDUSTRIAL (700) 400-1100	DRAWING NUMBER 4 OF 4	

4080 E. LAKE MEAD BLVD.