



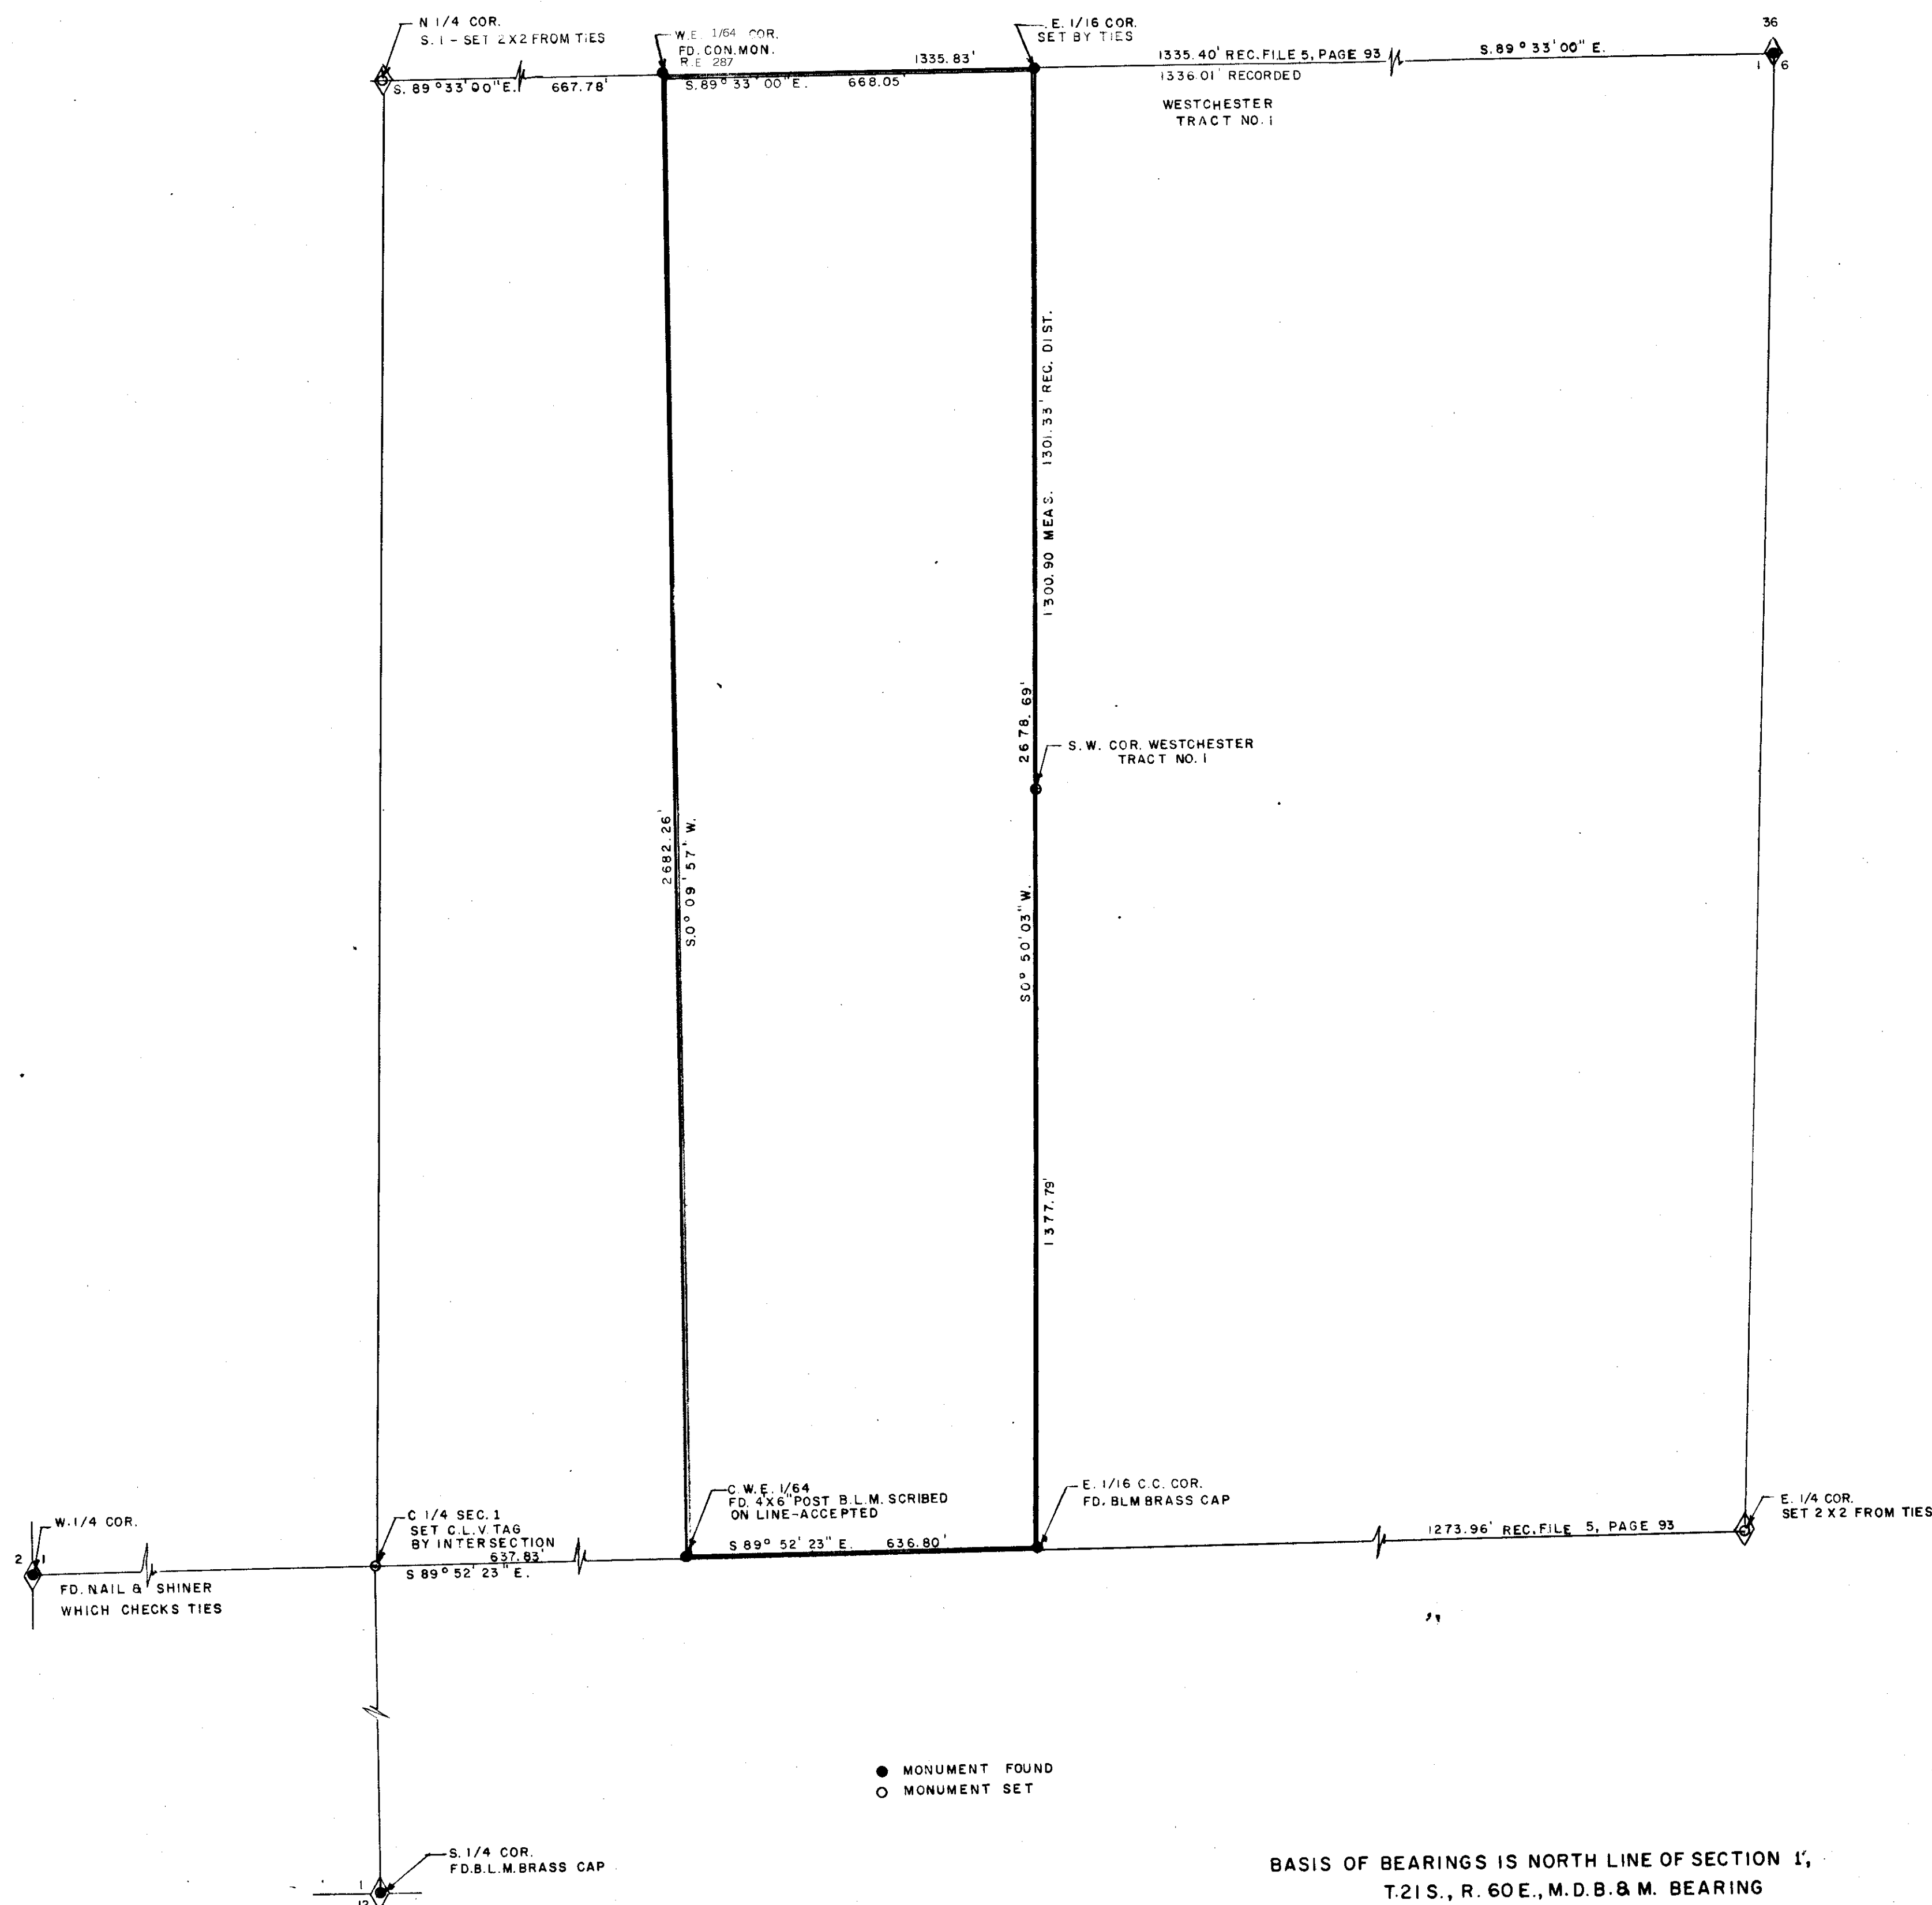


I, JAMES A. RANKIN, A DULY REGISTERED ENGINEER & LAND SURVEYOR, do hereby certify that this map truly and correctly represents the results of a survey made under my supervision and completed on the 13 day of May, 1962 of and for the City of Las Vegas, Nevada. This survey is not a subdivision as defined in Planning & Zoning Law as shown in 1943-1949 Supplement, Nevada Compiled Laws.

REGISTERED ENGINEER & LAND SURVEYOR
NEVADA R.E. NO. 1350

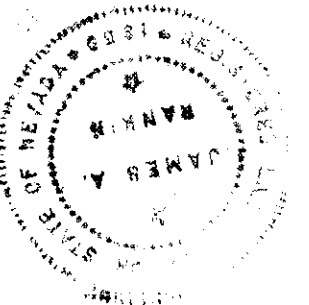


APPROVED this 20 day of May, 1962

R. C. Smith
CITY ENGINEER
NEVADA R.E. NO. 396

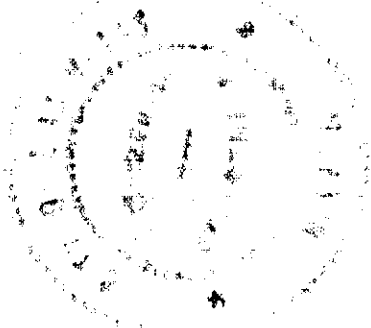

SCALE: 1" = 200'

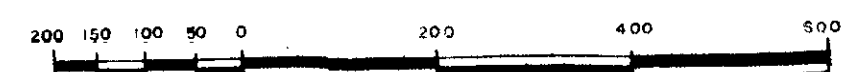

BASIS OF BEARINGS IS NORTH LINE OF SECTION 1,
T.21S., R. 60E., M.D.B. & M. BEARING
S. 89° 33' 00" E. AS RECORDED IN CLARK
COUNTY RECORDS OFFICE IN BOOK 5,
PAGE 95, OF PLATS.

NO. 294527
FILED AT THE REQUEST OF
City of Las Vegas
Date 6/5/62 at 2:23 P.M.
FILE 11 PAGE 49
OF SURVEYS
OFFICIAL RECORDS BOOK NO. 365
CLARK COUNTY, NEVADA, RECORDER
PAUL C. O'MALLEY, RECORDER
Fee \$ 1.00 J. D. Deputy

CITY OF LAS VEGAS, NEVADA
ENGINEERING DEPT.

BOUNDARY SURVEY OF A PORTION OF N.E. 1/4,
SECTION 1, T.21S., R. 60E., M.D.B. & M. ANNEXED
TO THE CITY OF LAS VEGAS, NEVADA UNDER
ORDINANCE NO. 945

DRAWN BY: L.H.	CKD. BY:	APPROVED:	FIELD REF.
DATE 5-14-62	DATE 5-15-62		60 7 X