


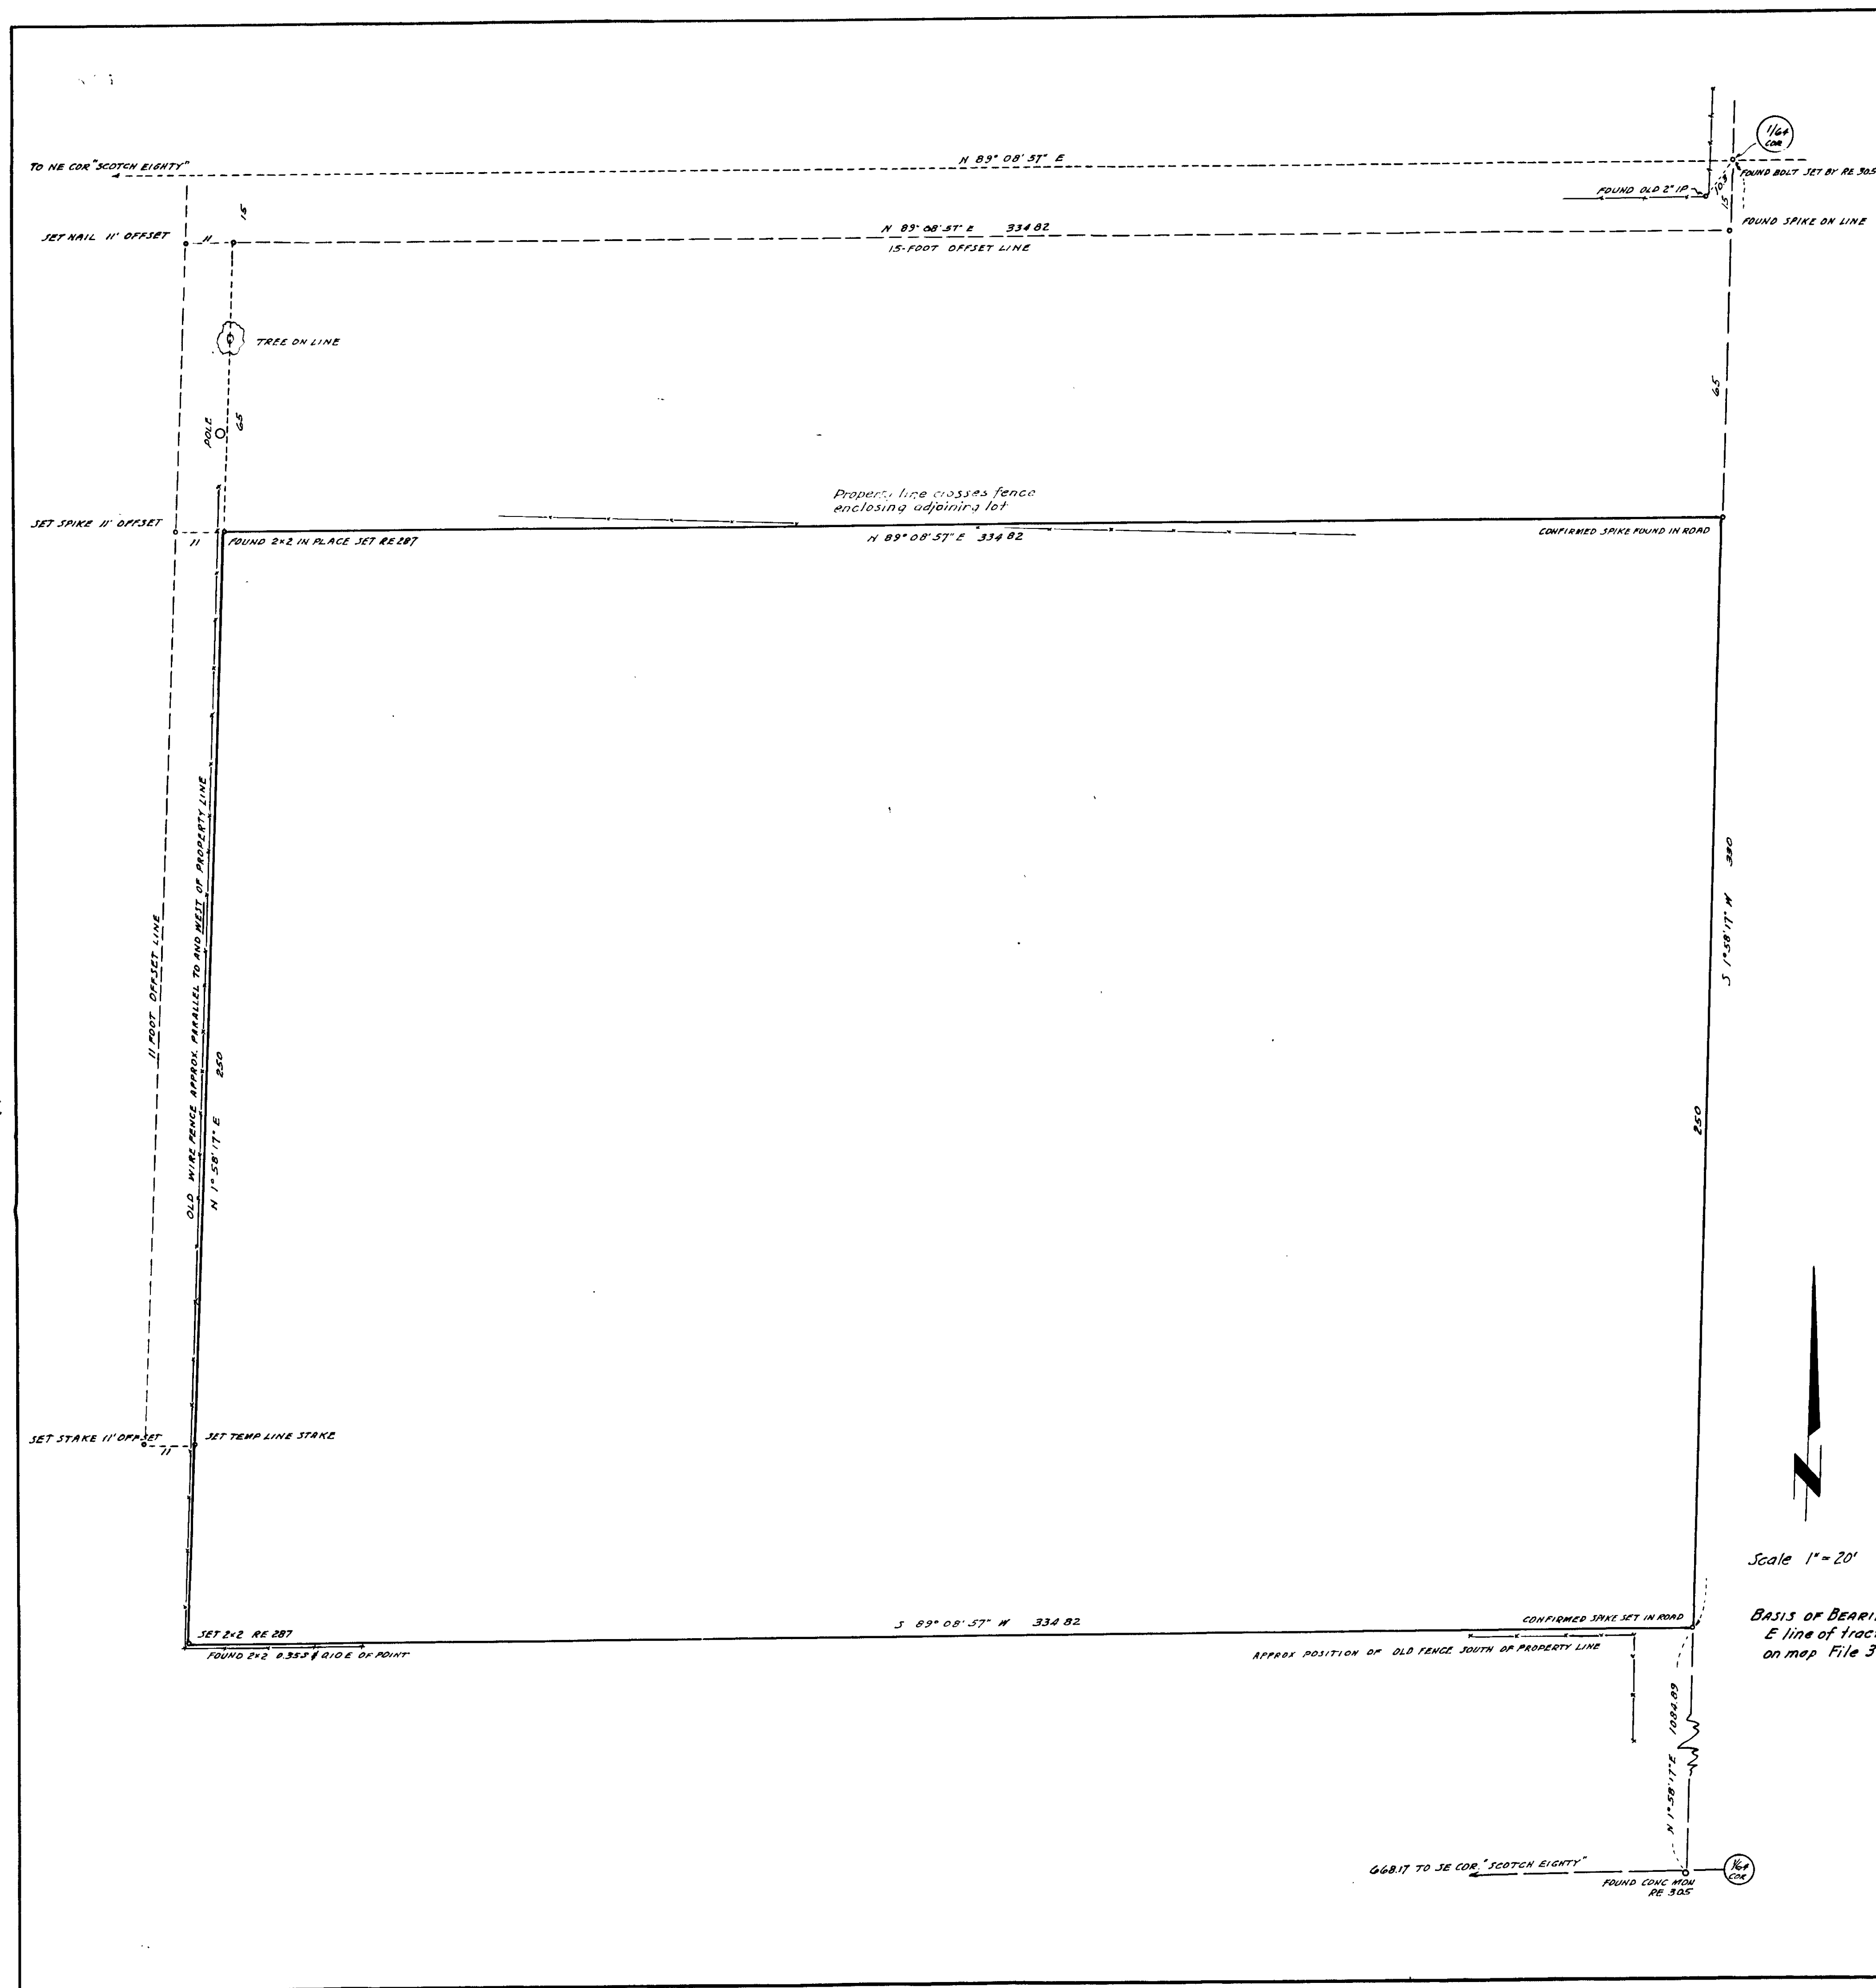

ENGINEER'S CERTIFICATE

This Amended Map supplants an earlier map representing a survey of the same area recorded in File 5, Page 65, Clark County, Nevada, records. The purpose of this Amended Map is to correct the location of the fence adjoining the West border of the tract, it having been shown as lying East of the property line, whereas said fence actually lies West of said line. No changes in the dimensions or shape of the tract from those given on the earlier map have been made. I hereby certify that the above statements are true, and are made as a result of a resurvey made by me and completed on the 24th day of December, 1956.

J. M. Eaton

REGISTERED CIVIL ENGINEER & LAND SURVEYOR - NEVADA 287

Scale 1" = 20'

BASIS OF BEARINGS:
E line of tract S 1° 58' 17" W
on map File 3 Page 6

96420

J. M. Eaton

12-31-56 11:17 A
6 74

J. M. Eaton

12: 6

12: 6

AMENDED MAP OF SURVEY OF
S 250 FEET OF N 330 FEET OF
E 2 OF W 2 OF SW 4 OF NE 4 SEC. 4
T. 21 S. R. 61 E. MDB & M
GEORGE L. LYNCH
LAS VEGAS - NEVADA

File 6 page 74