
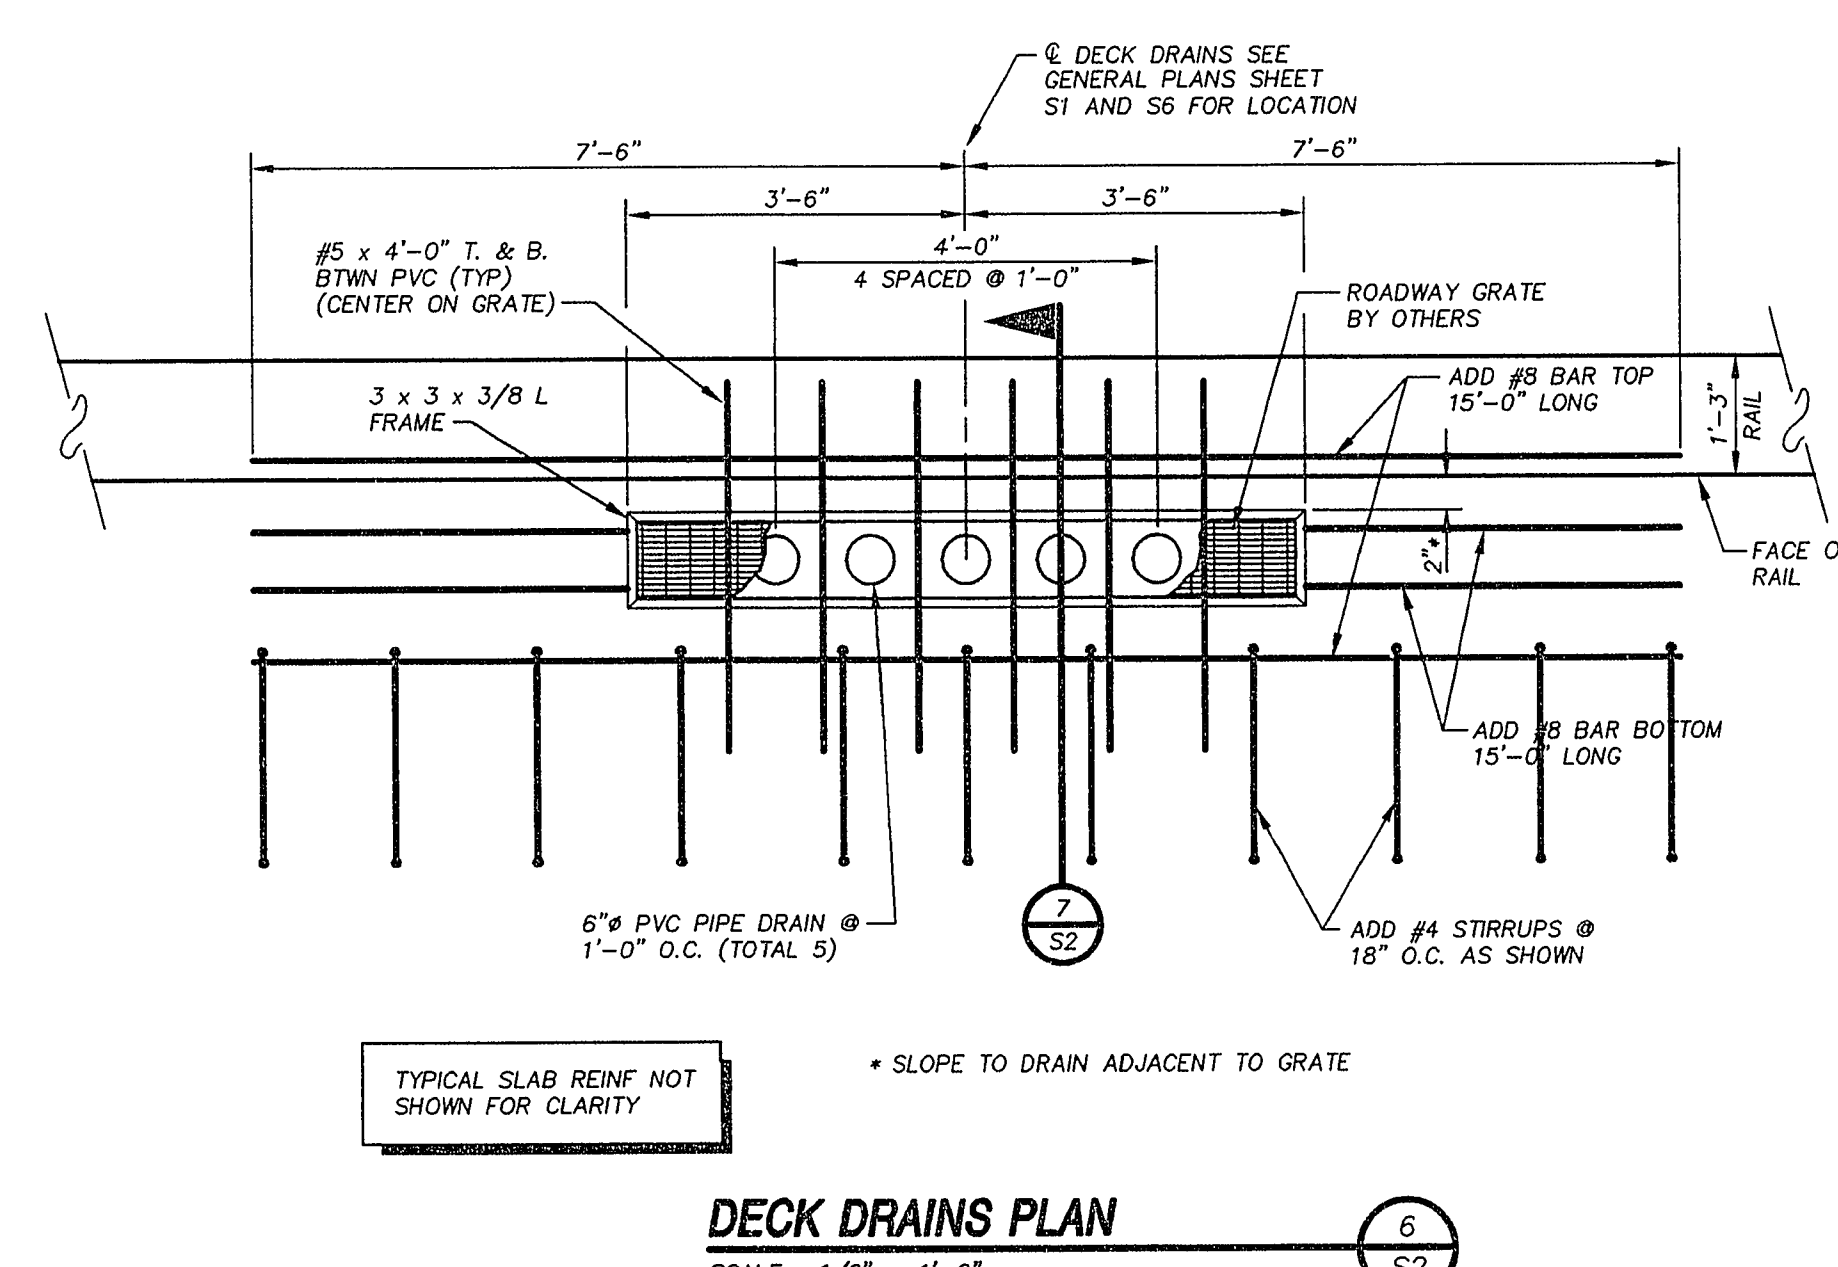
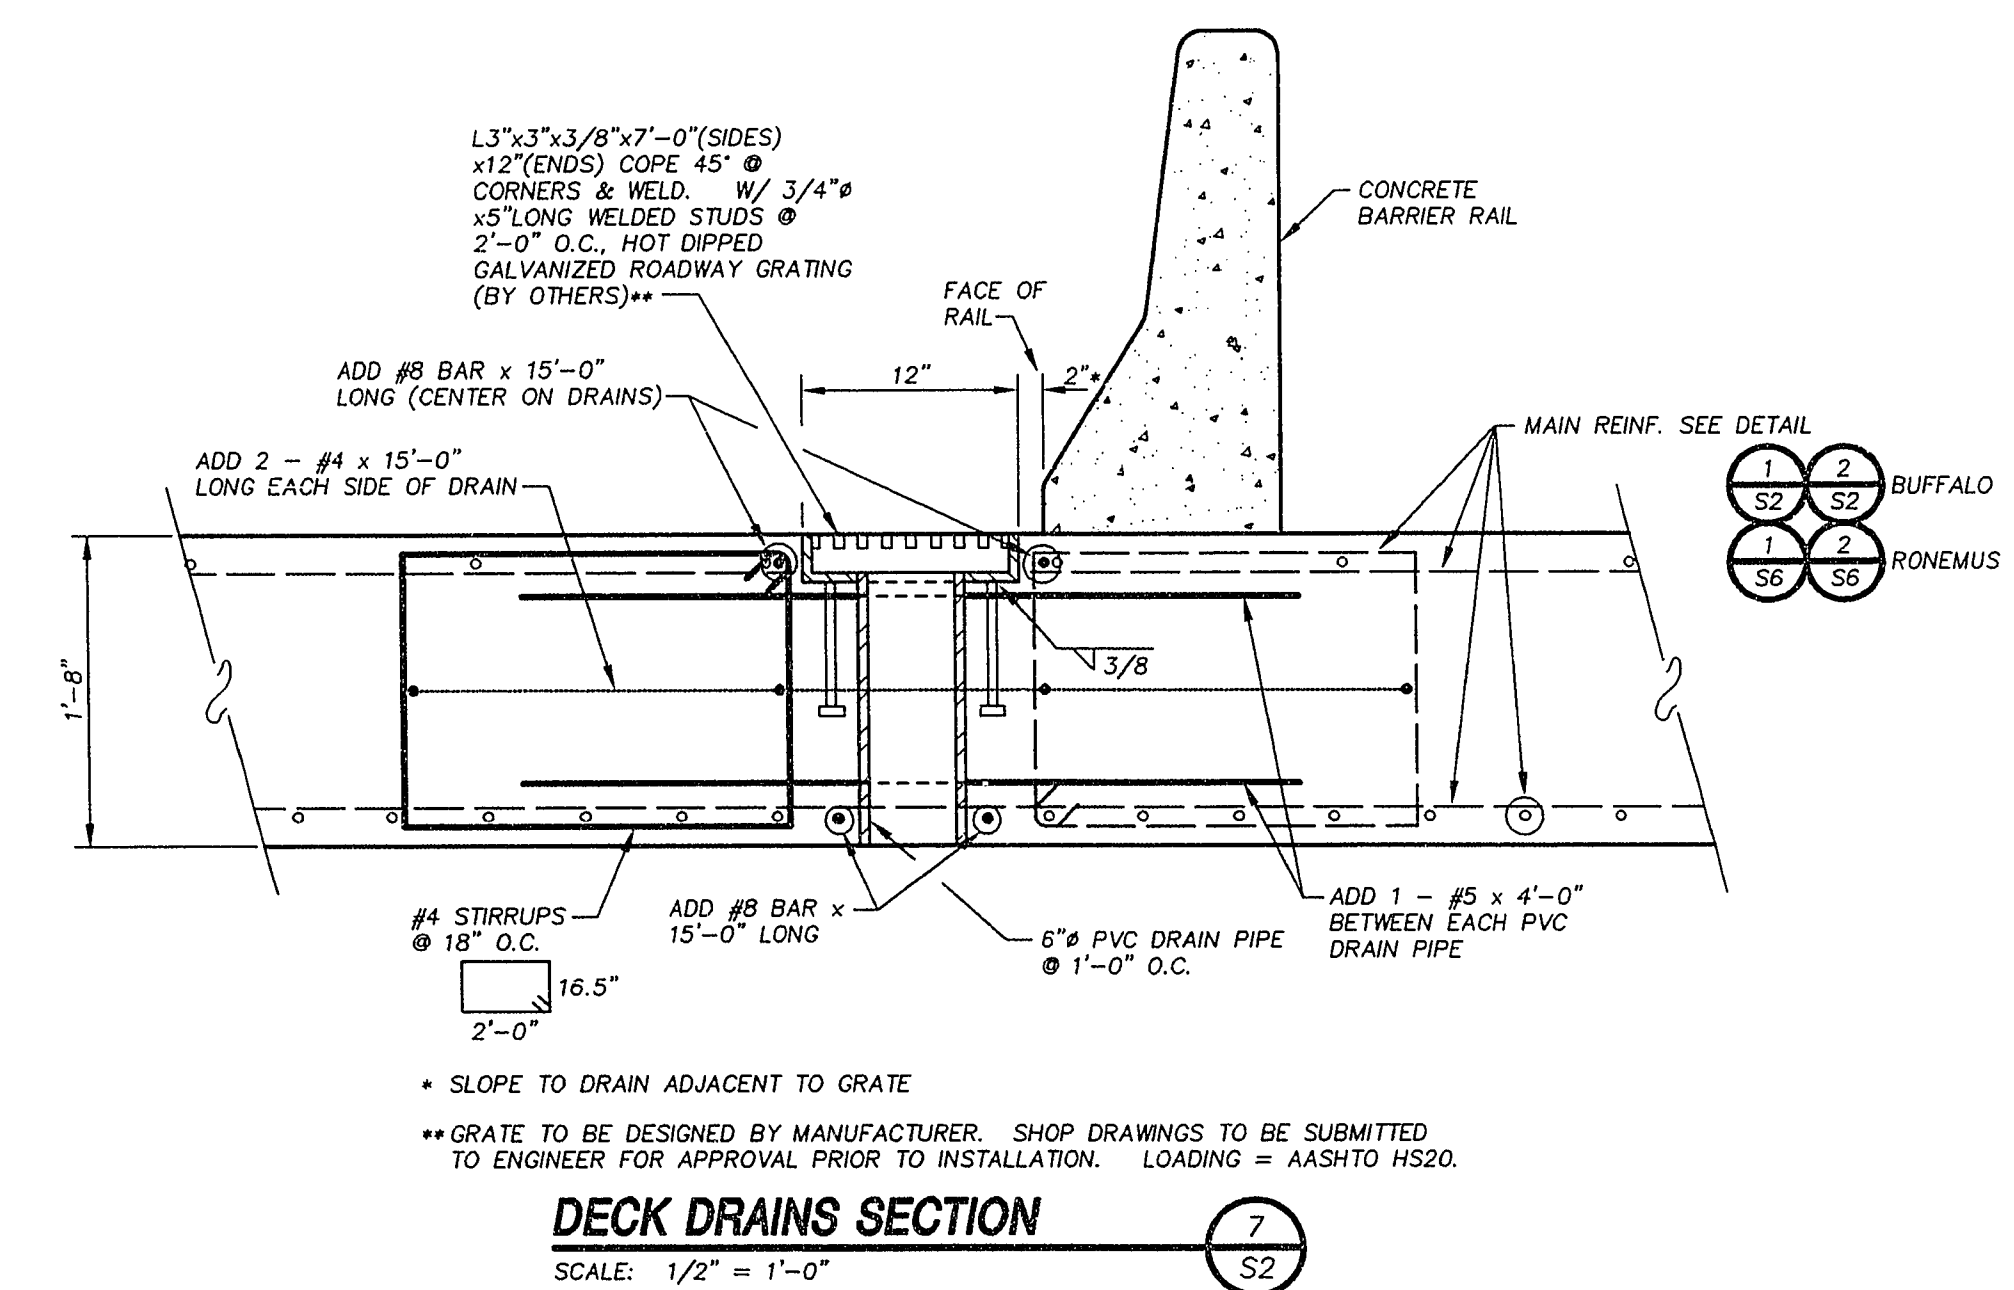
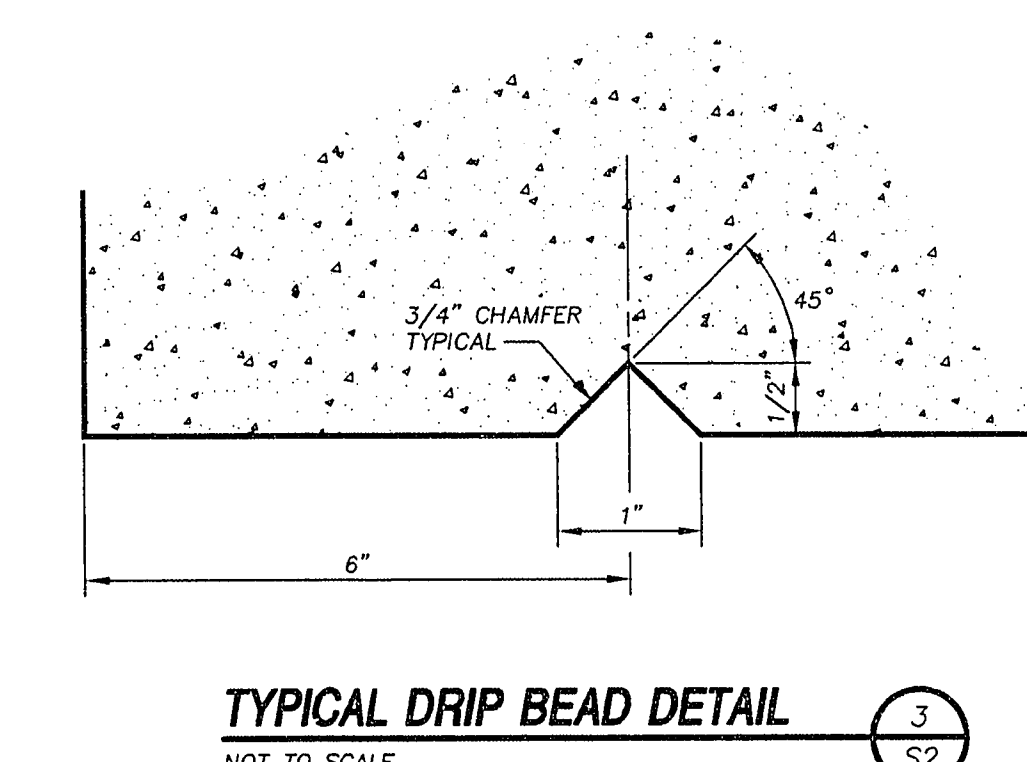
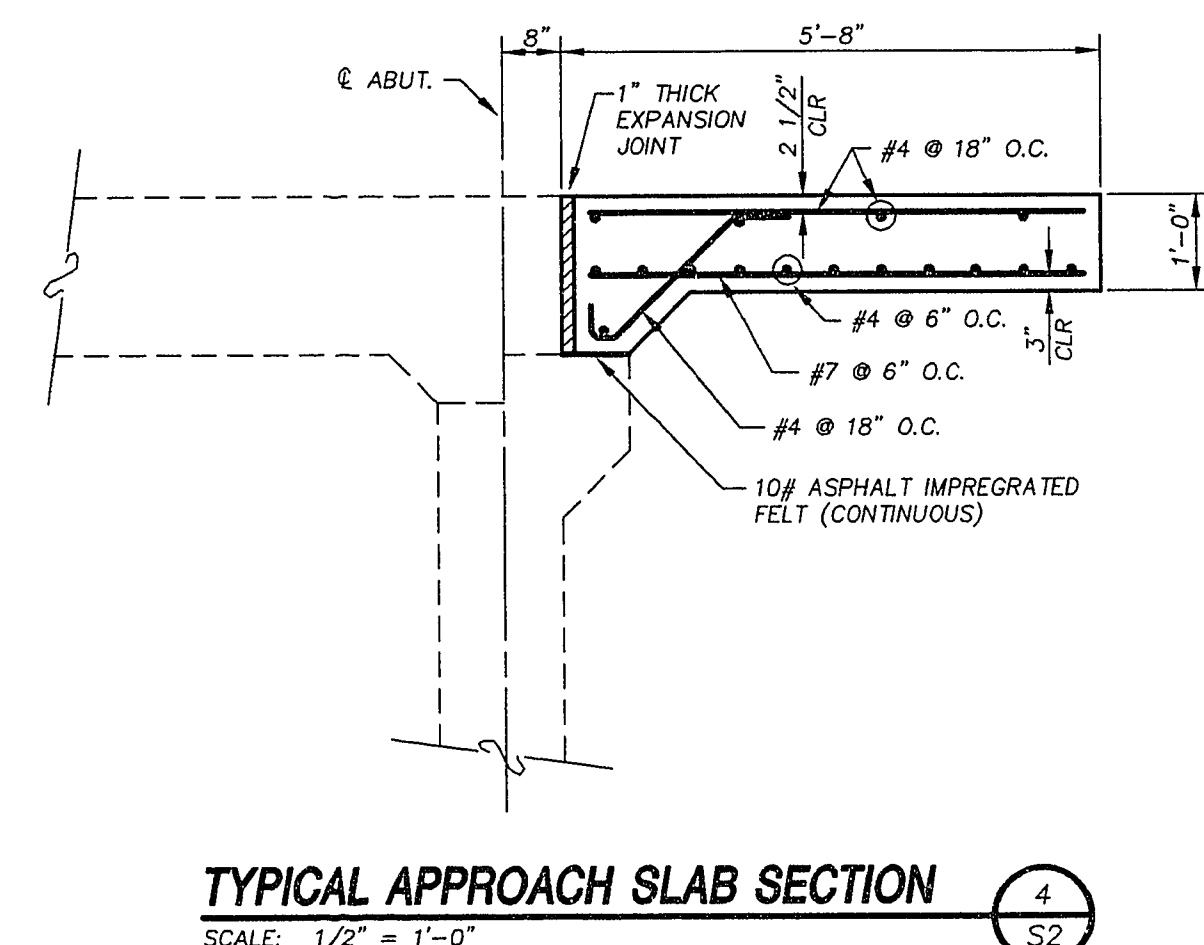
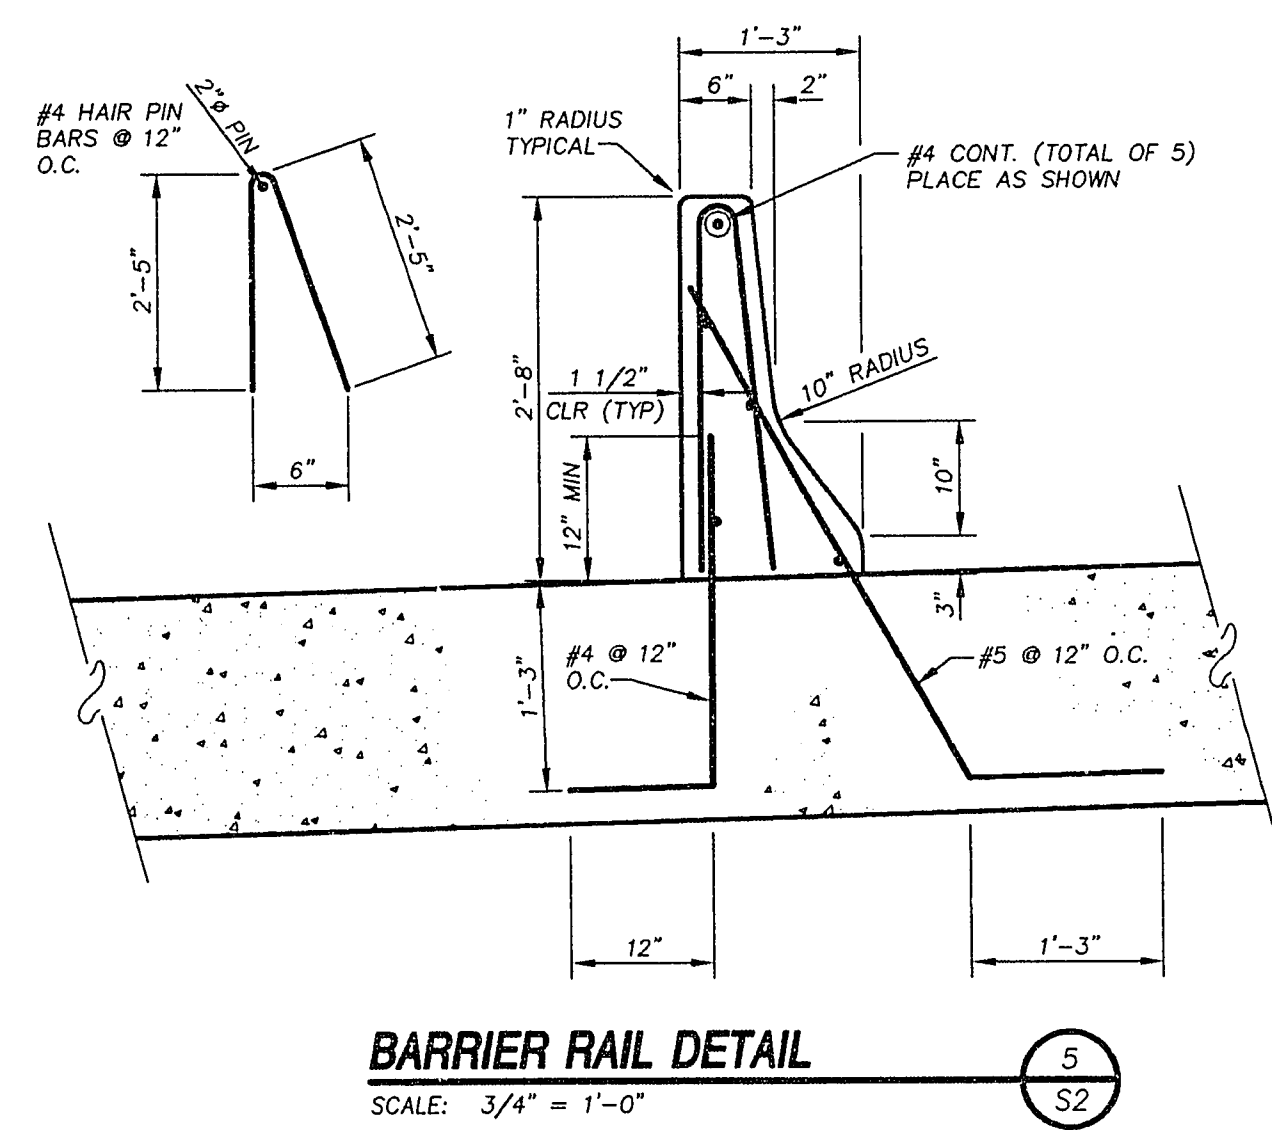
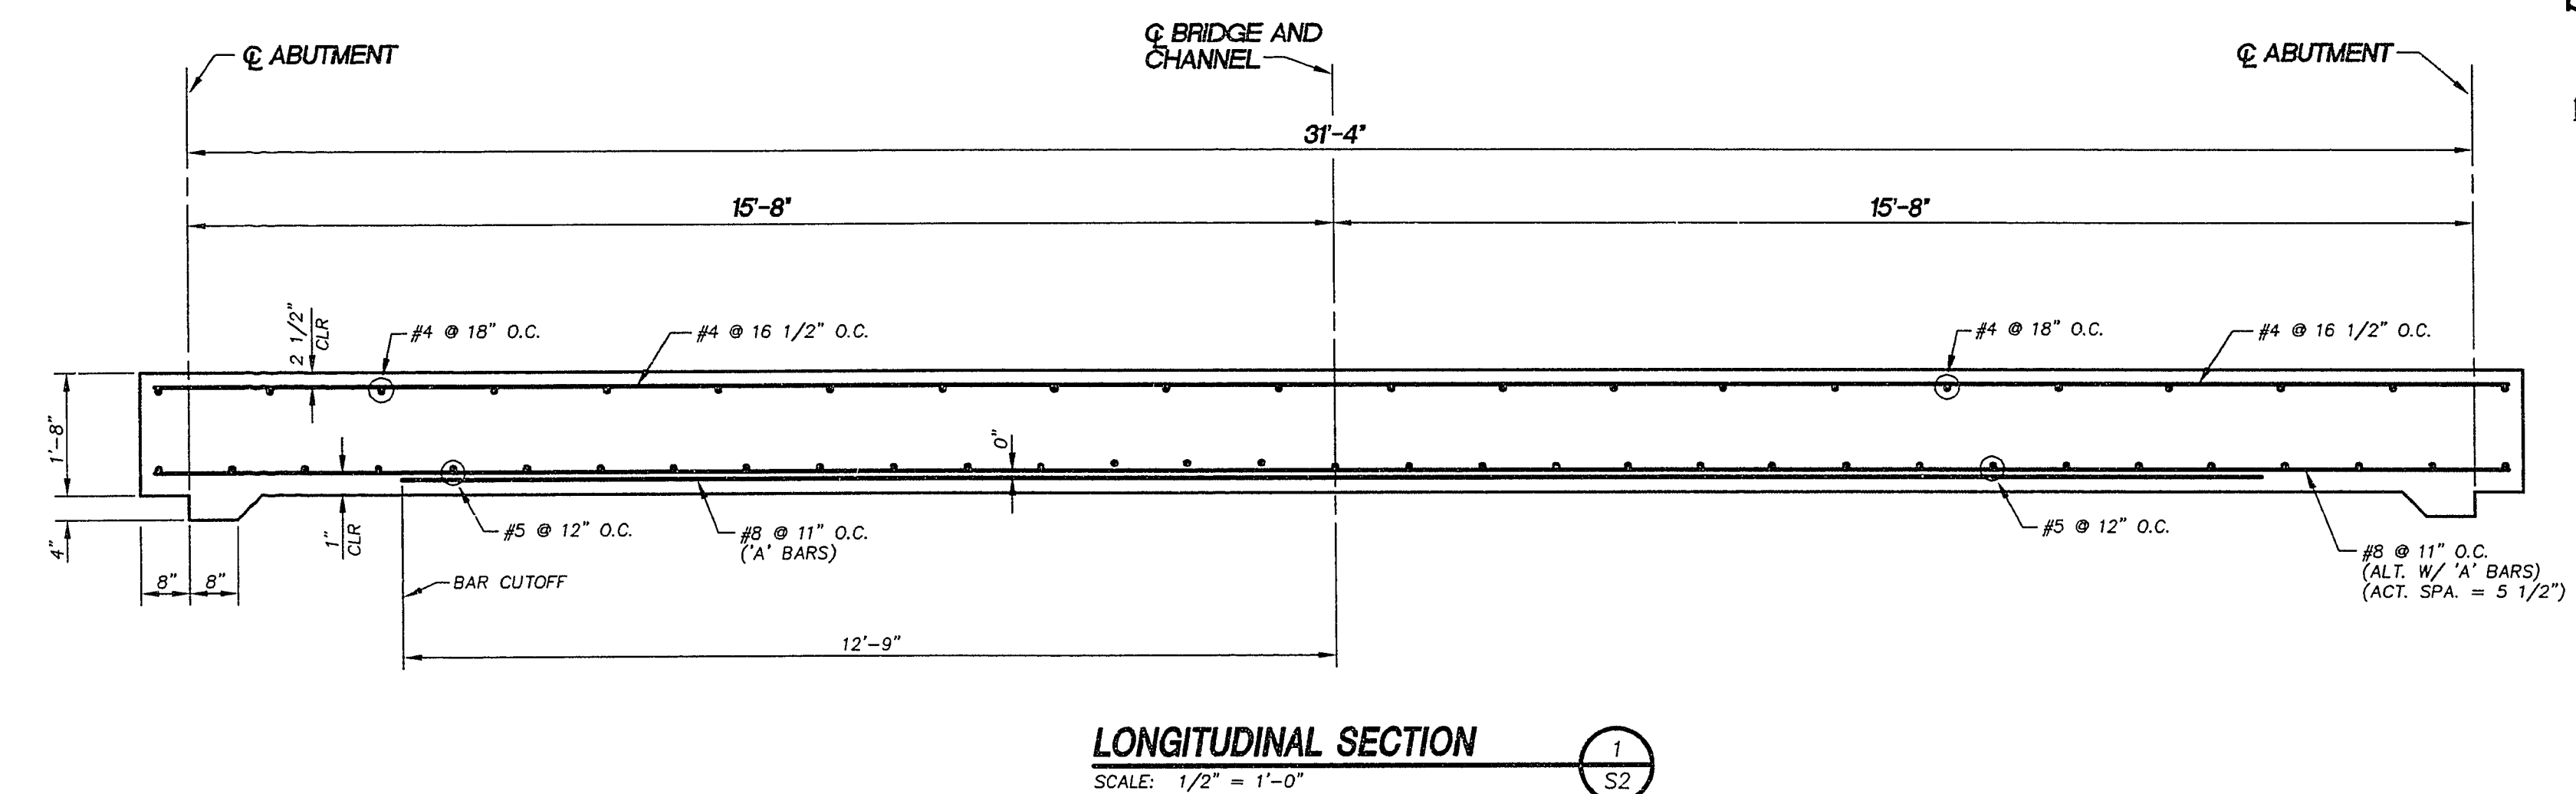


Call before you Dig
1-800-227-2600

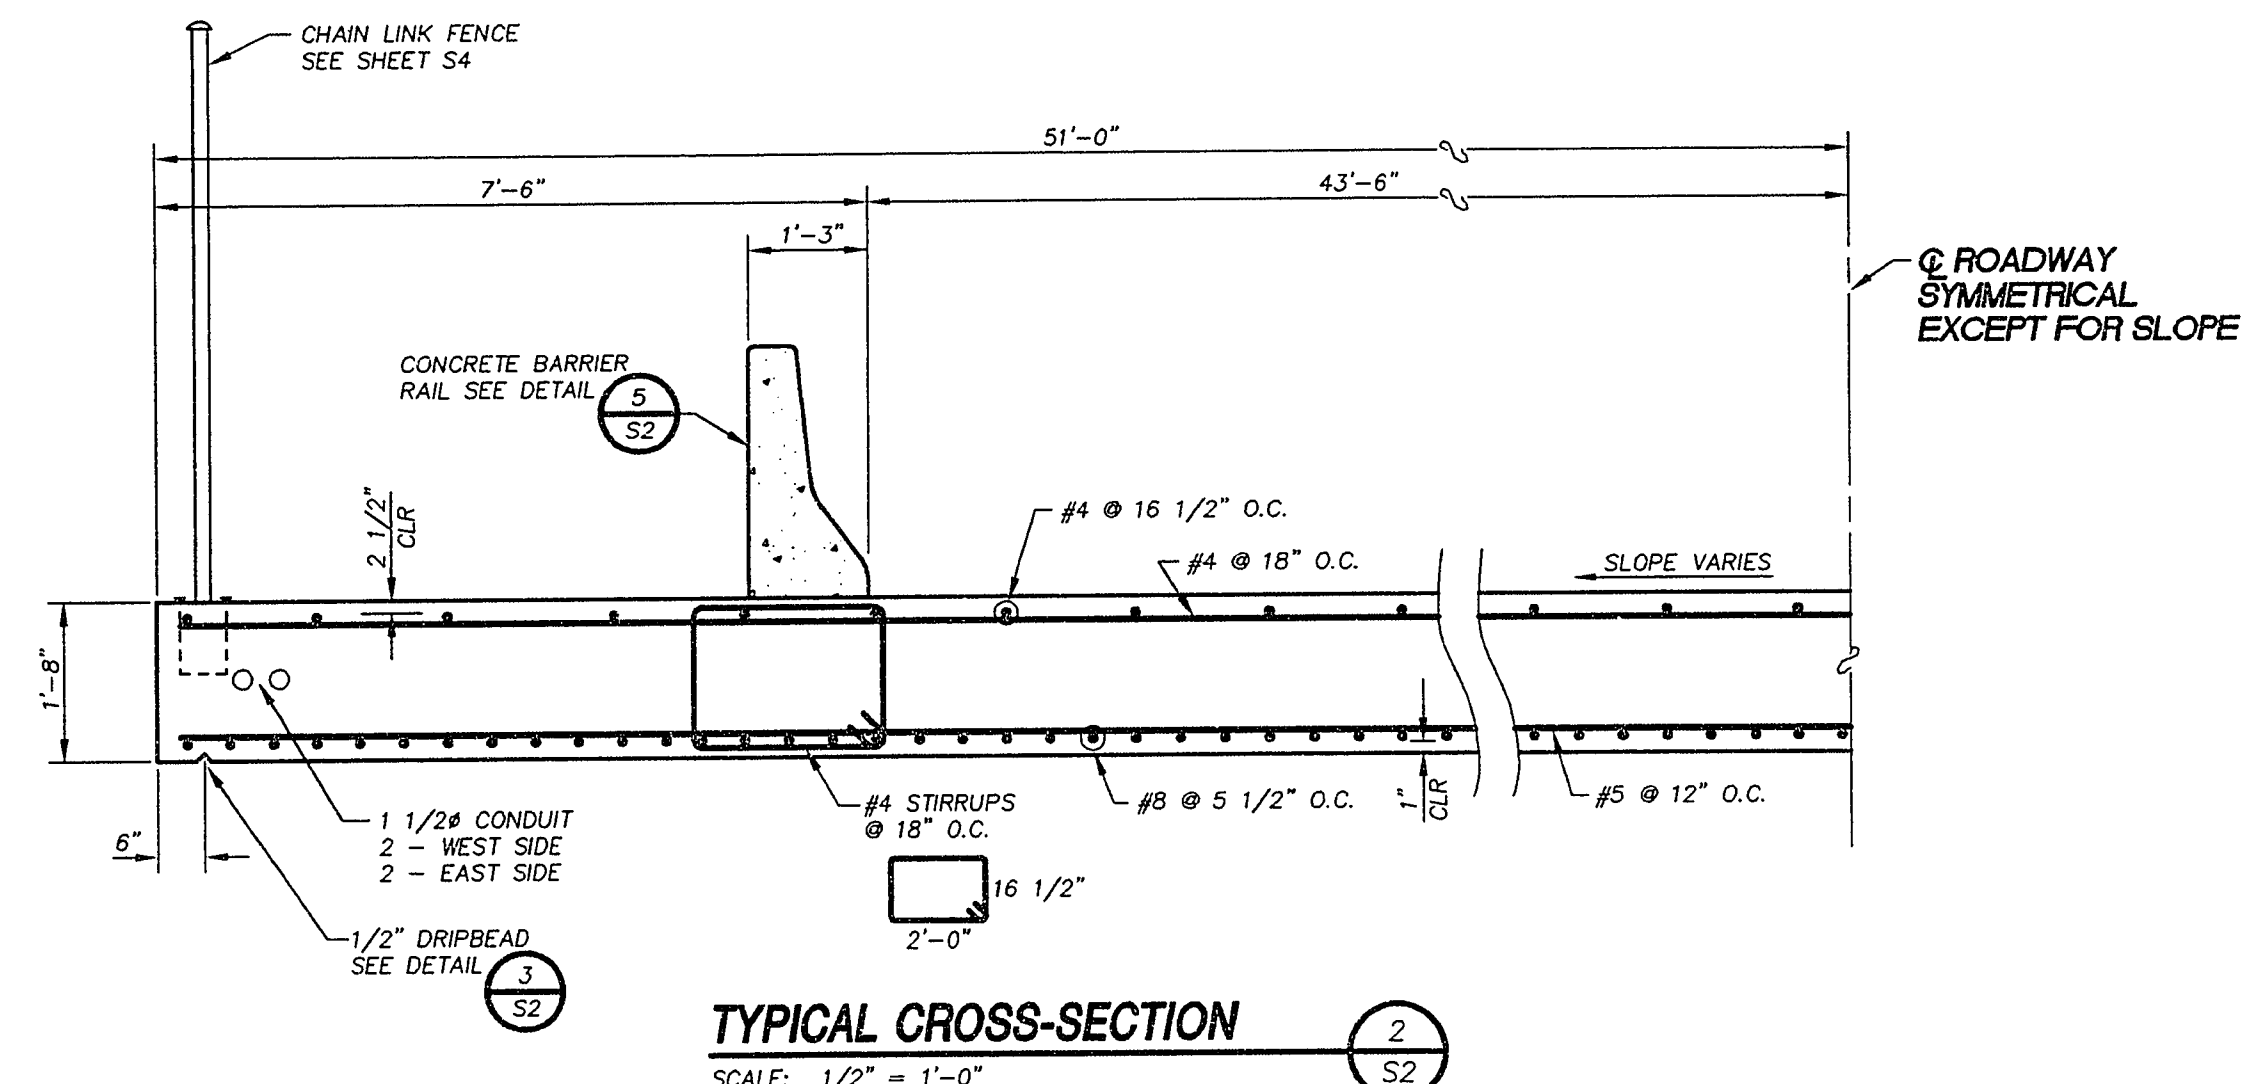


RECORD DRAWINGS

DRAFTED BY: JMA DATE 2-2-95

CHECKED BY: DTA DATE 2-2-95

REVISIONS				
REV.	DESCRIPTION	BY	DATE	APPROVAL

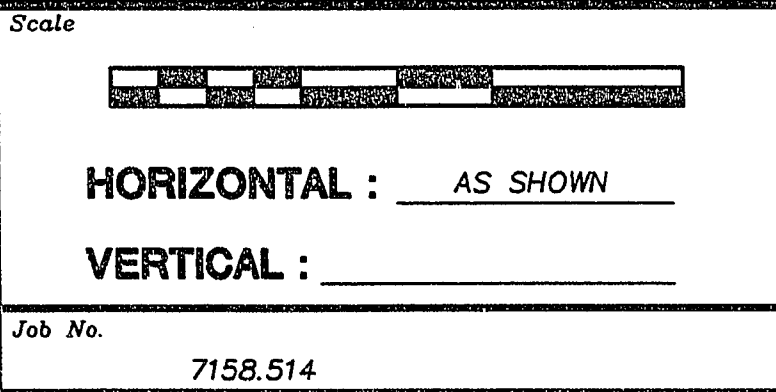

Church Engineering

A Division of

POST, BUCKLEY, SCHUH & BRINMAN

6600 West Charleston Blvd. Suite 140 Las Vegas, Nevada 89102 Telephone: 702/878-6244 Fax: 702/878-7758

ENGINEERING • PLANNING • SURVEYING • CONSTRUCTION SERVICES

Designed by : PLK Date : 12/21/93

Drawn by : AAS Date : 12/21/93

Checked by : PAA Date : 12/21/93

File No. : 514IMP Dwg No. : 514-S2

City of Las Vegas

CHEYENNE CHANNEL IMPROVEMENTS

BID No. 94.1730.12

STRUCTURAL DETAILS (BUFFALO)

CITY OF LAS VEGAS DRAWING No. 731-58

SHEET S2

C:\DWG5\514\514-S2.Fri Feb 3 07:23:40 1995 PDSJ - JDDY