
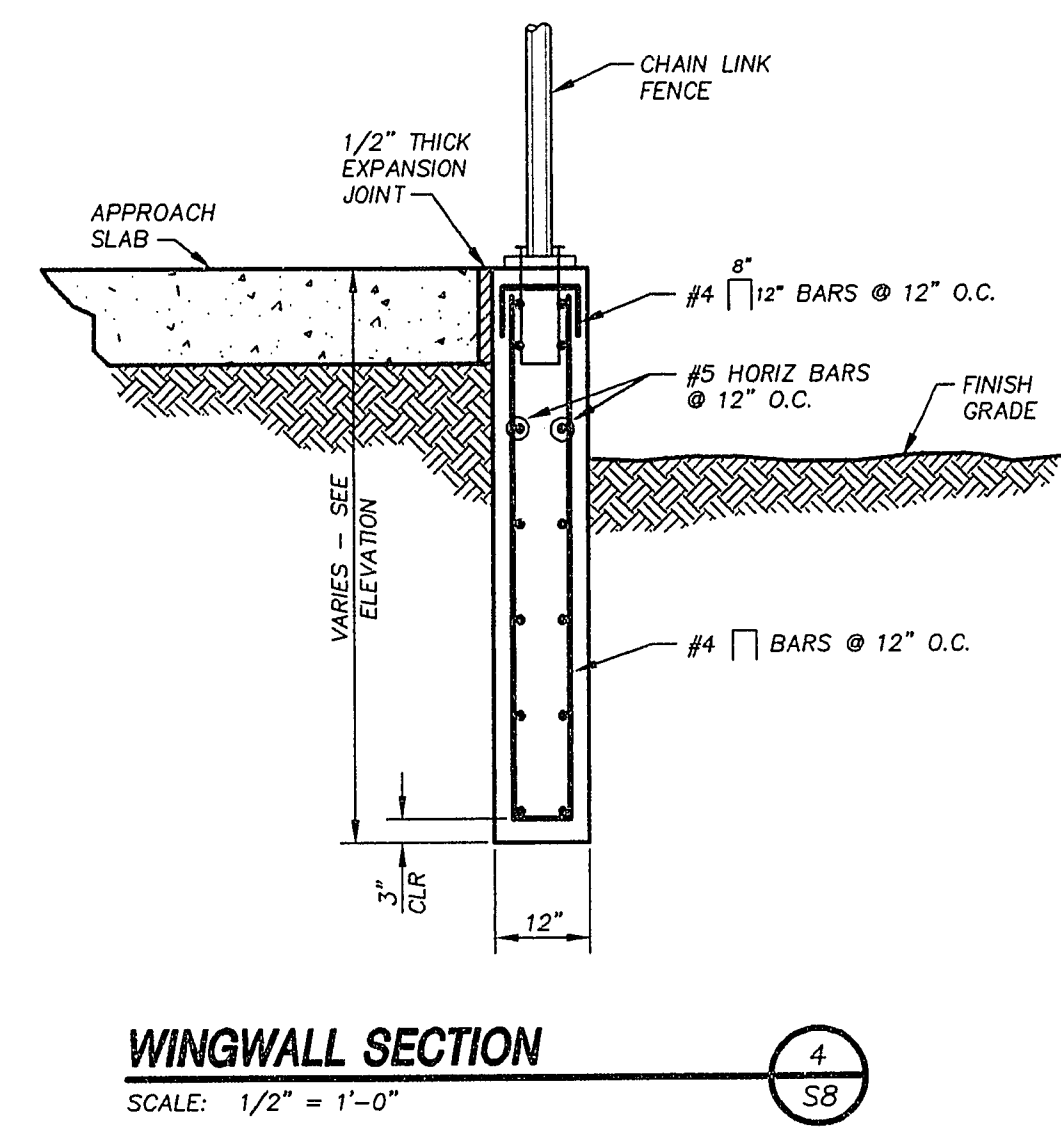
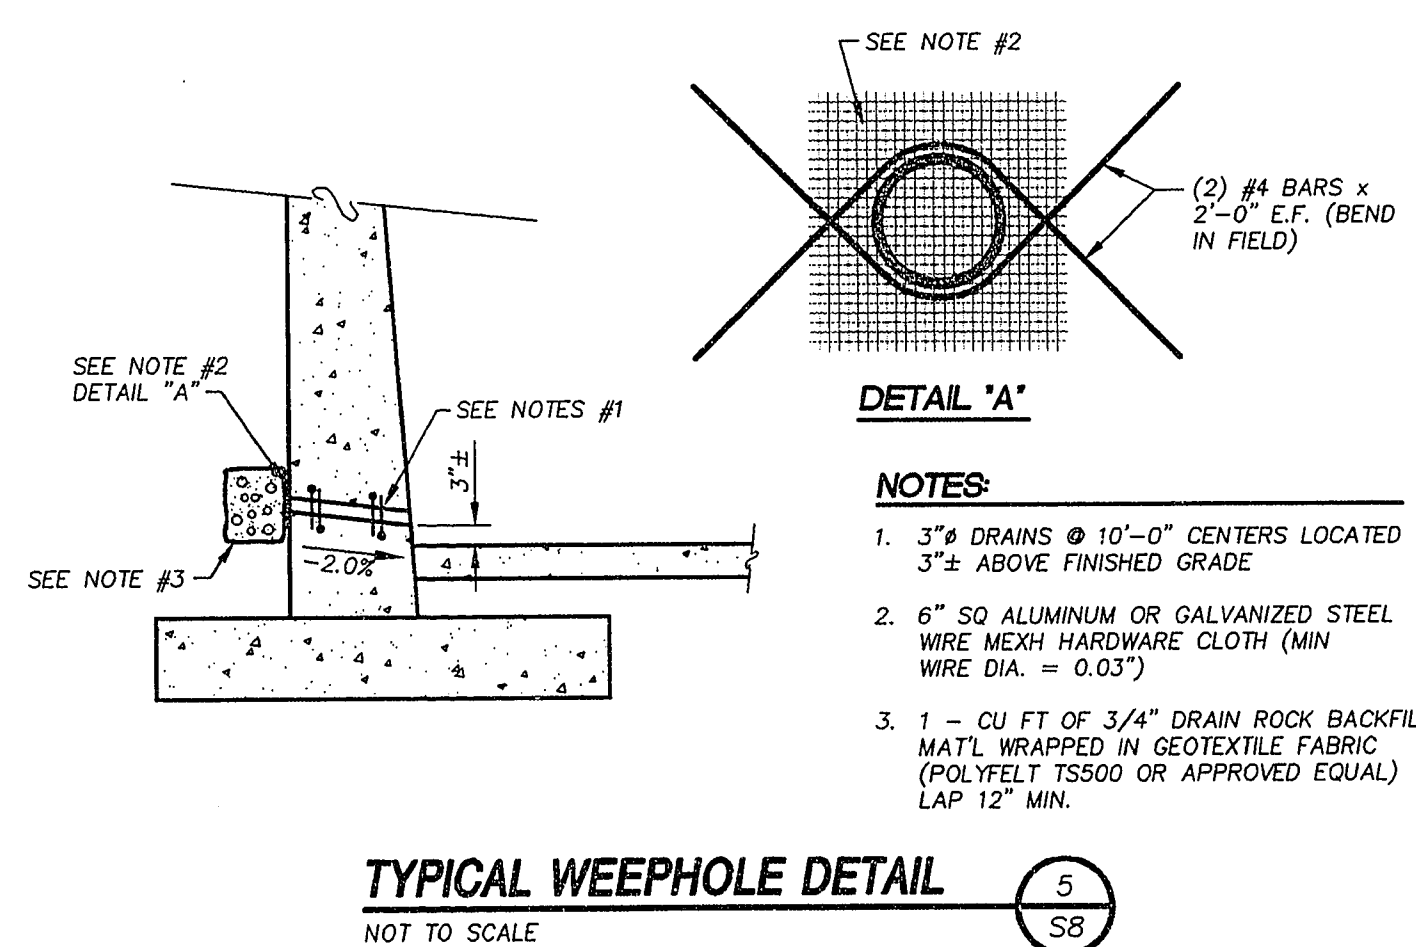
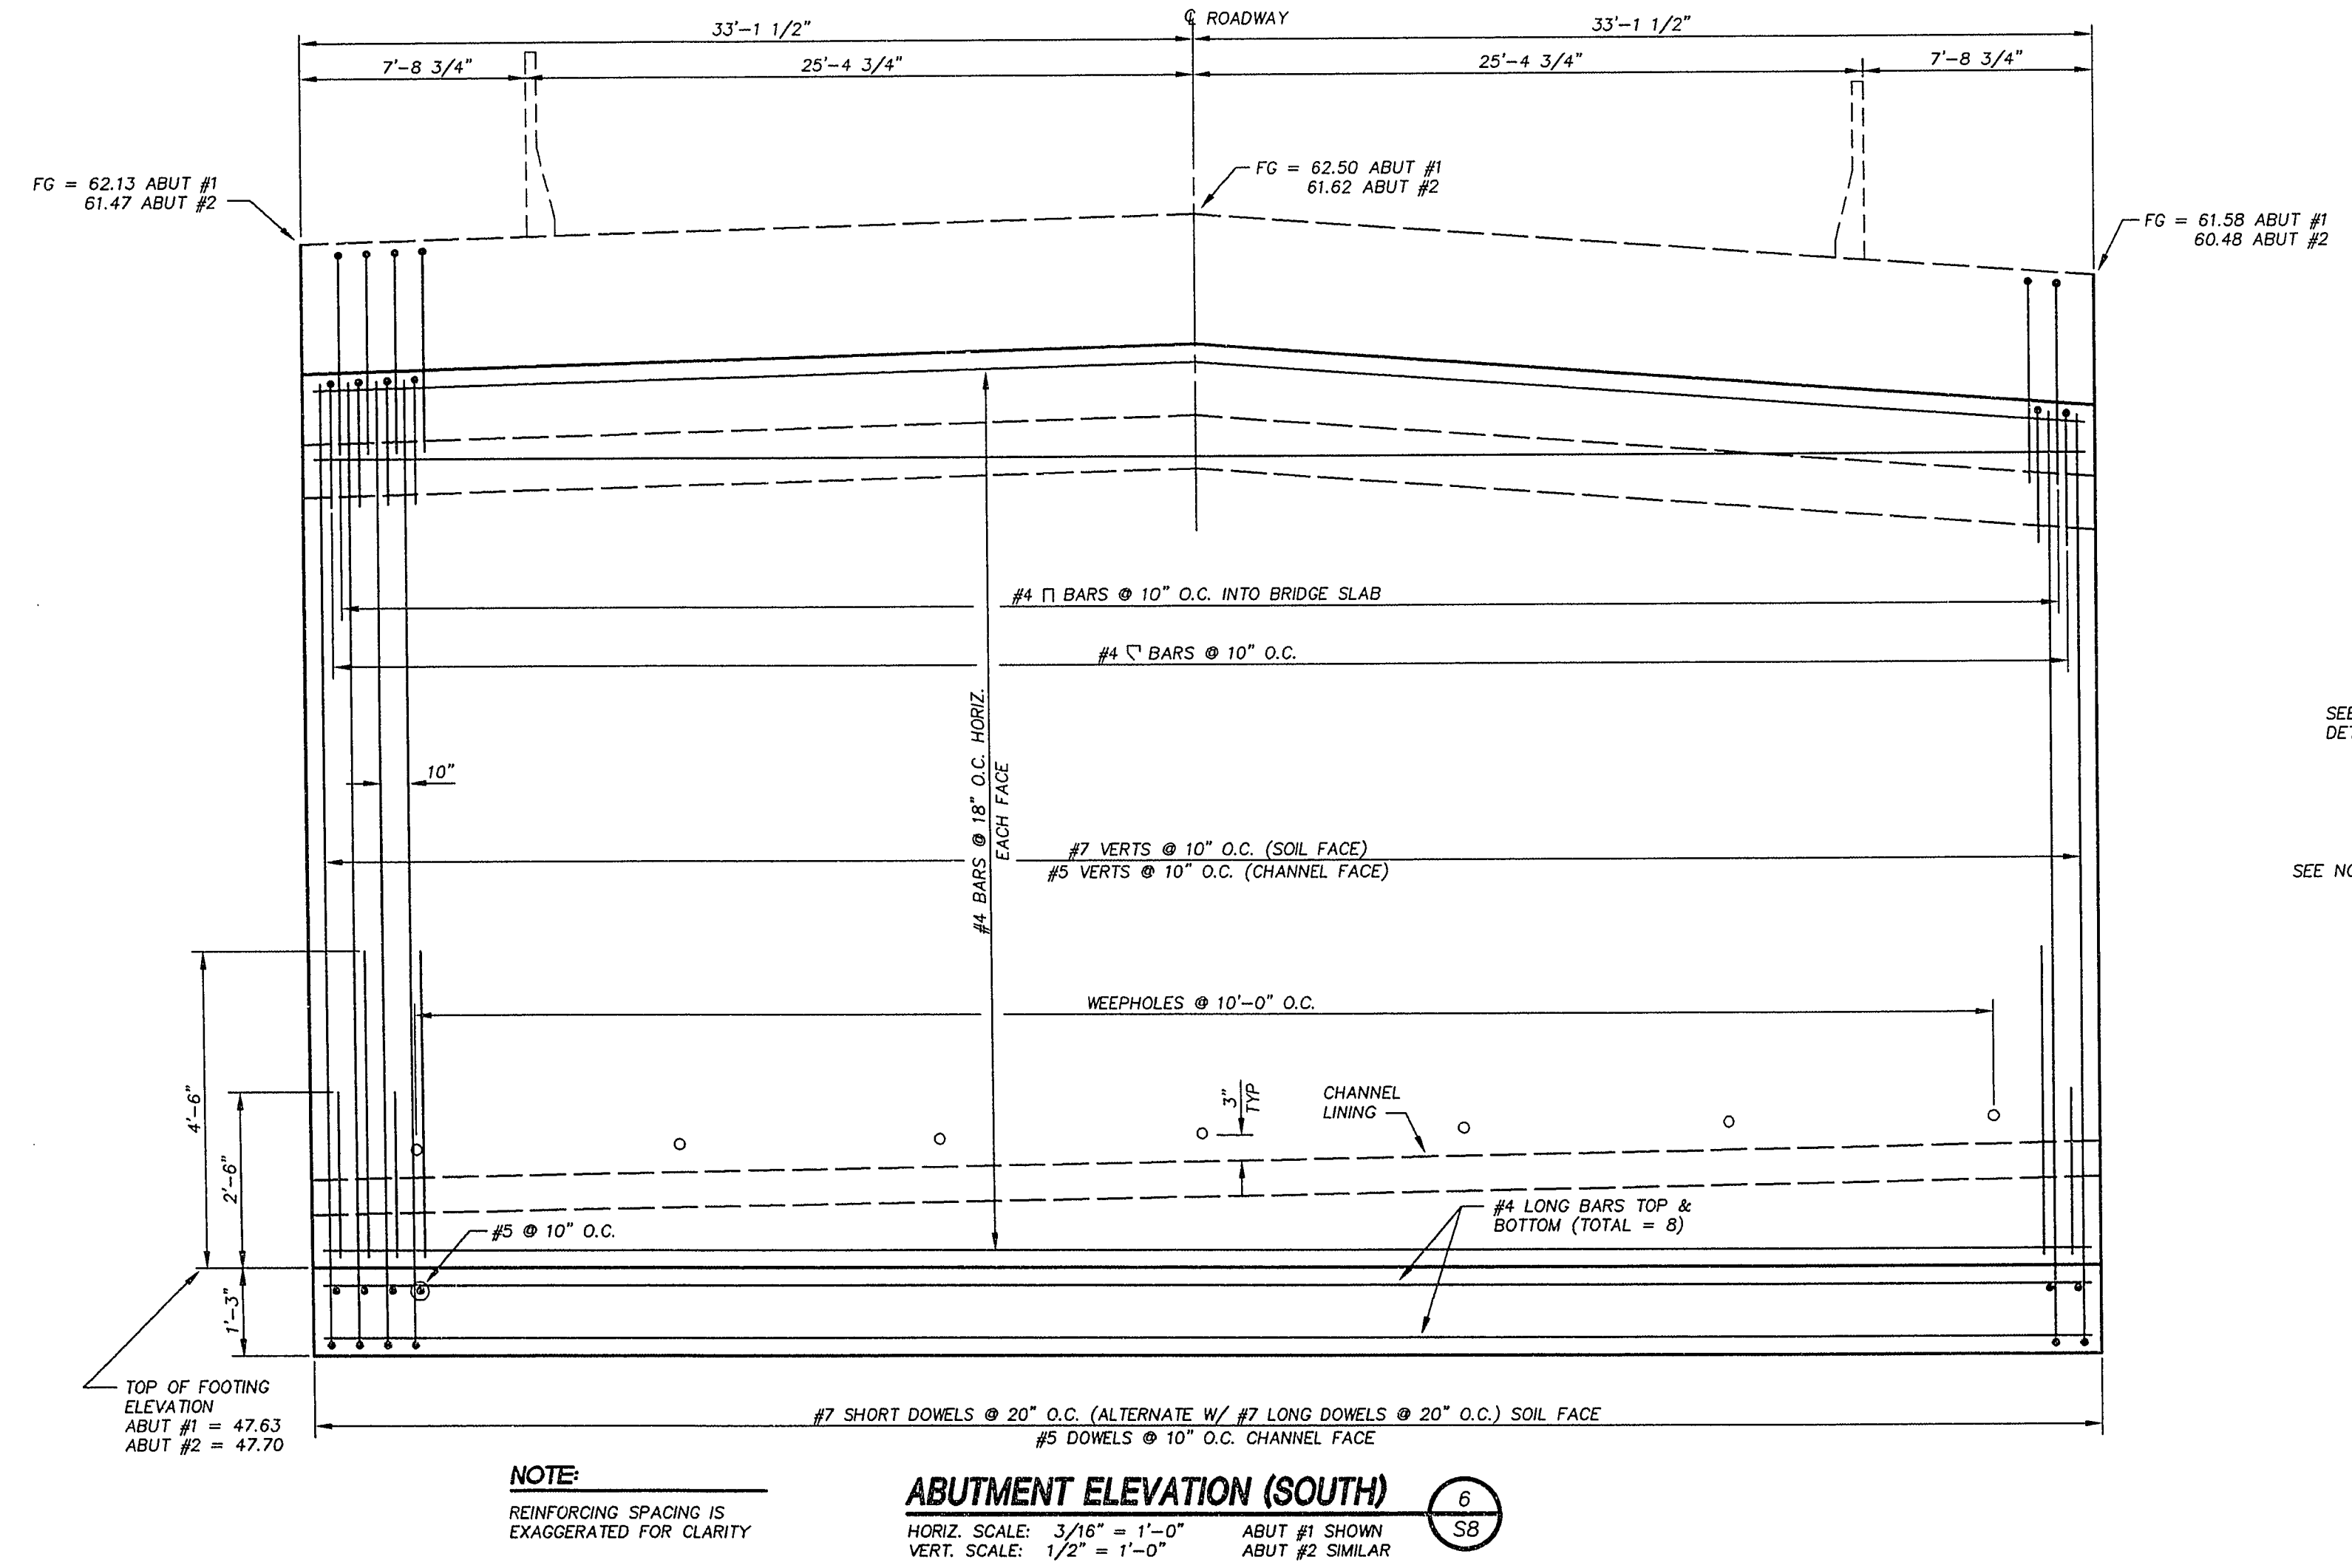
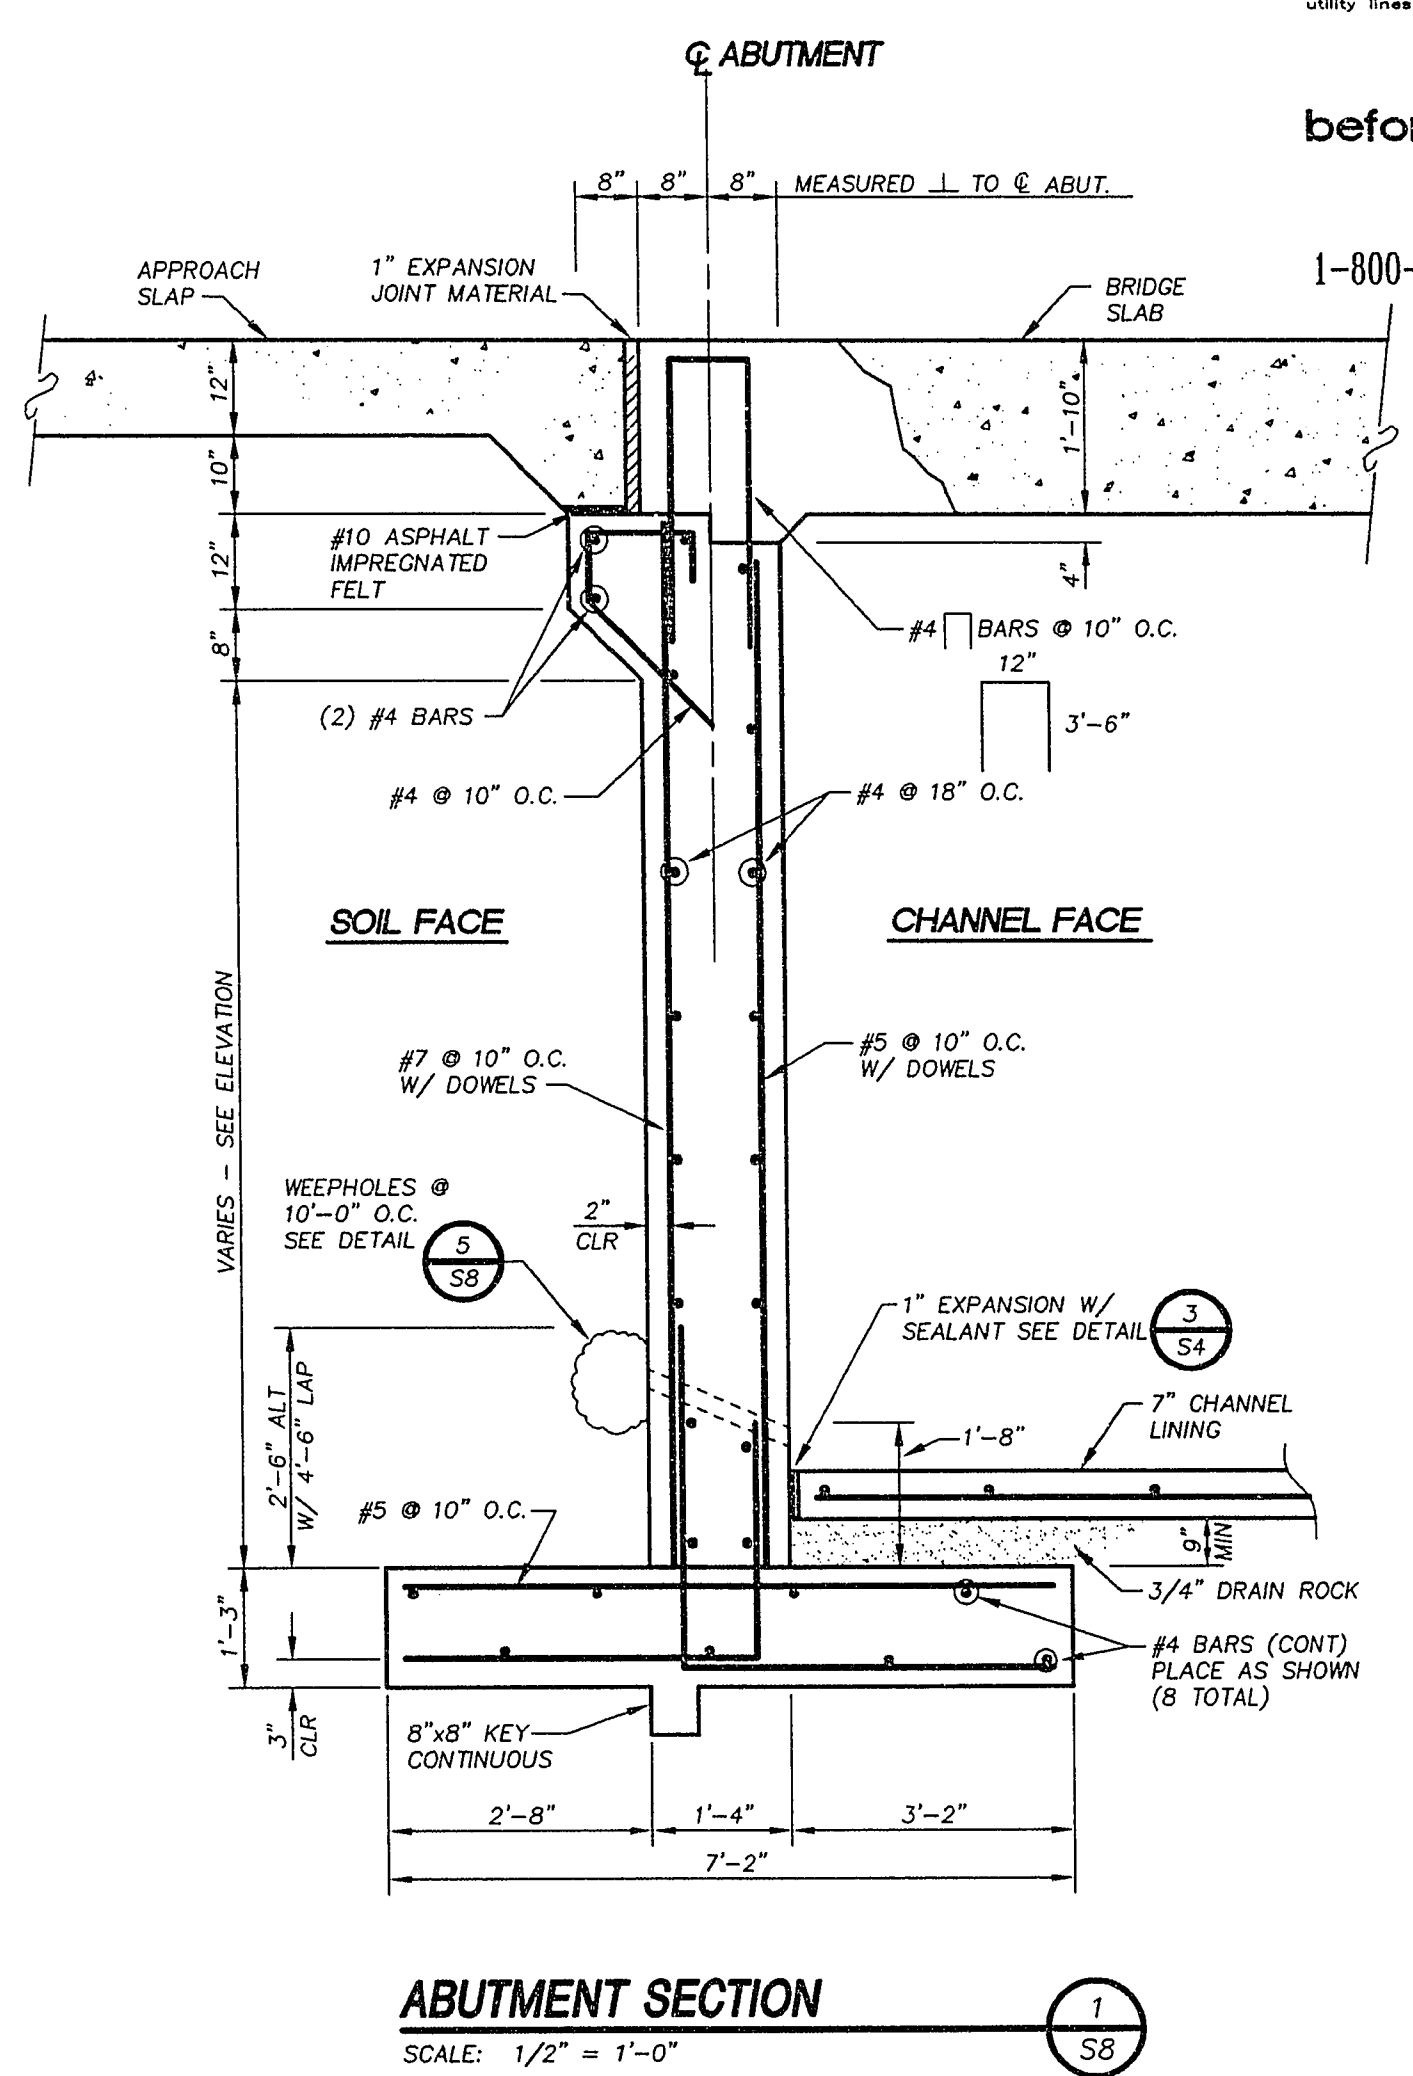
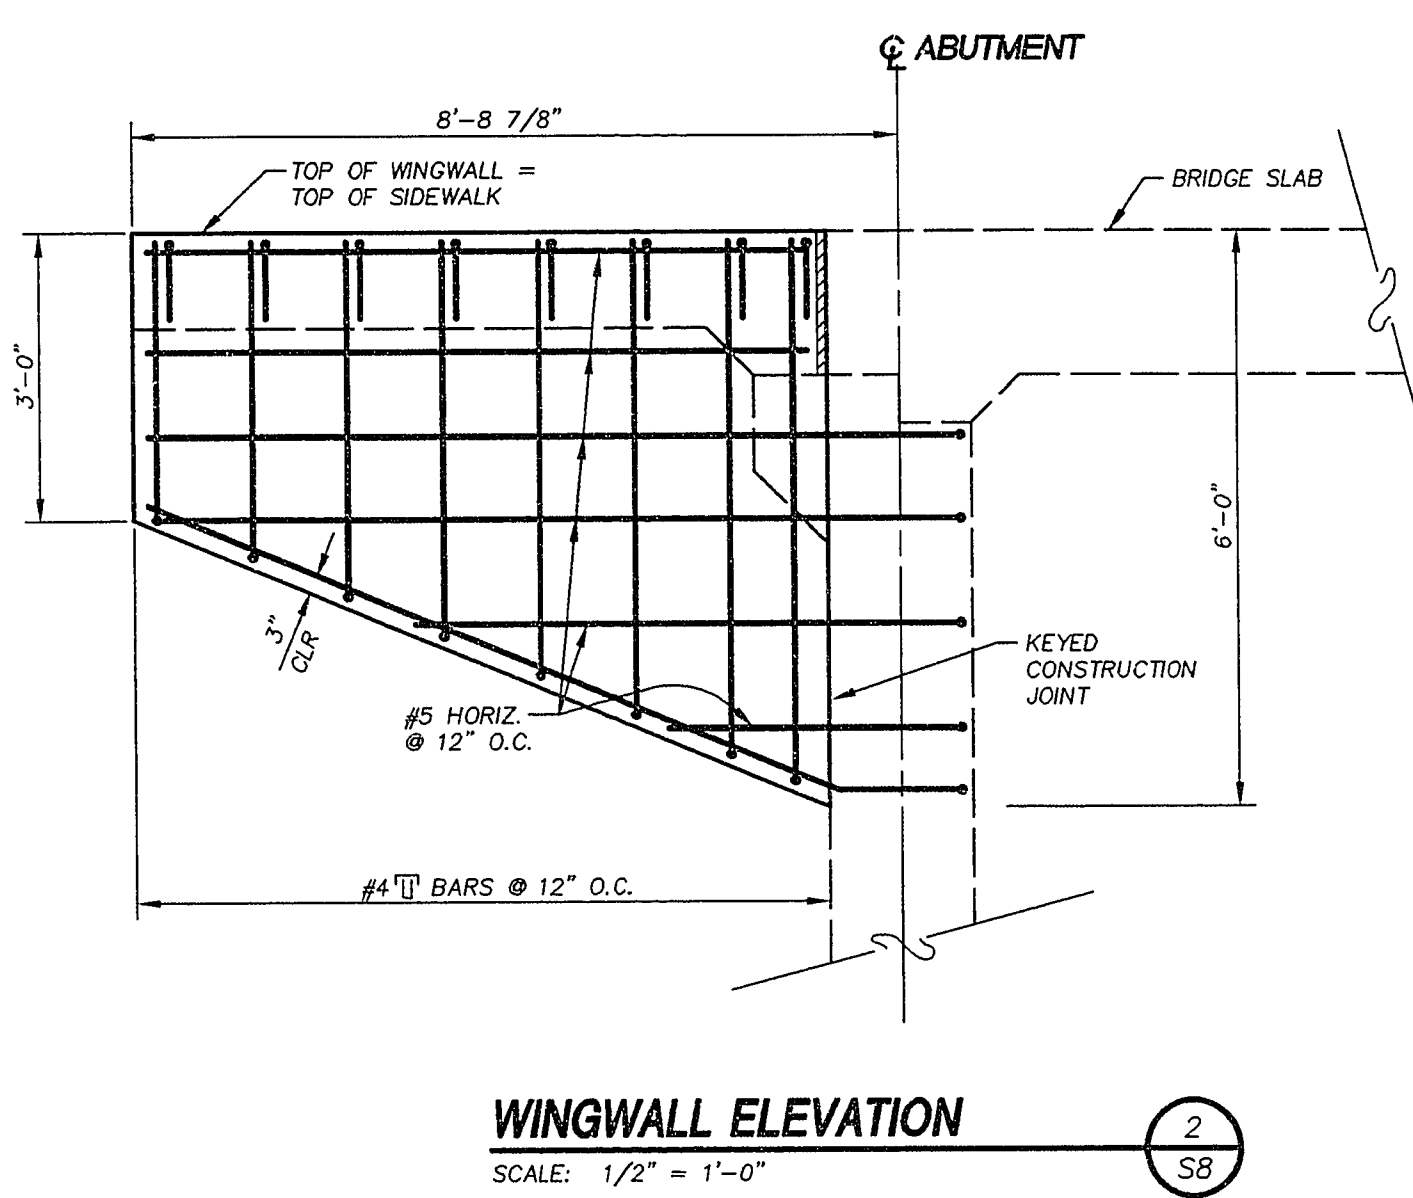


Call before you Dig
1-800-227-2600

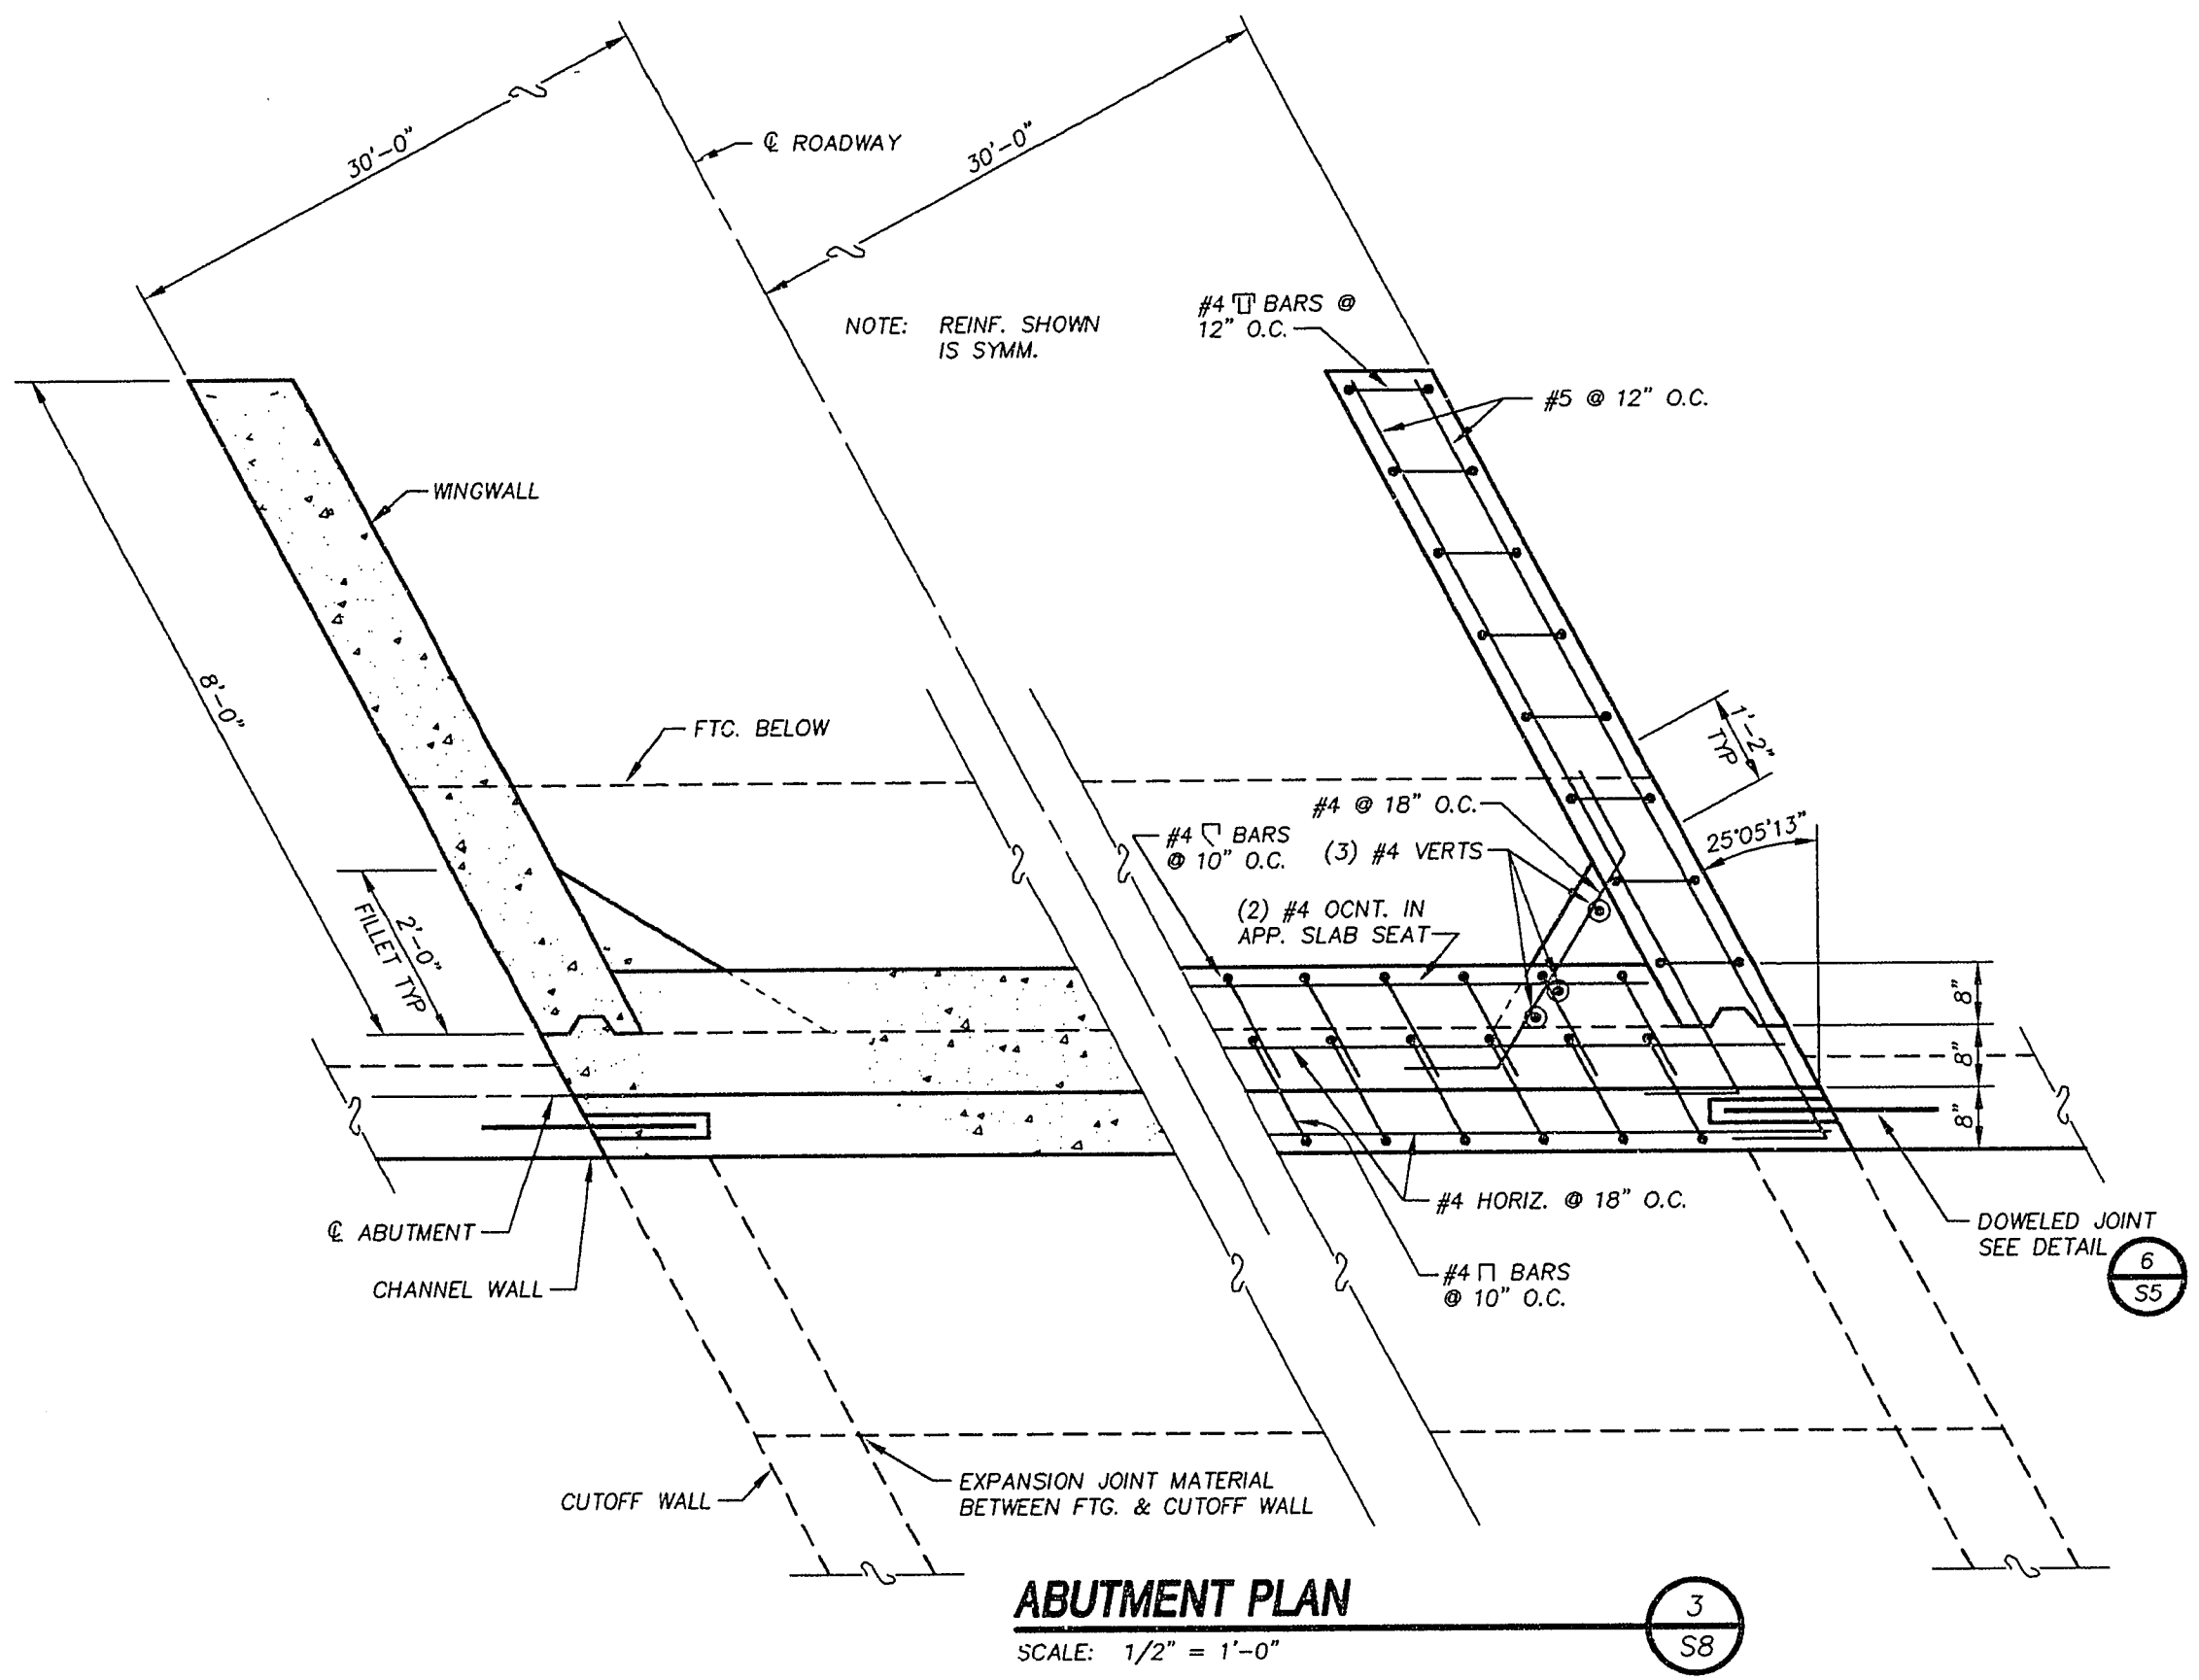

RECORD DRAWINGS
DRAFTED BY: JMA DATE 2-2-95
CHECKED BY: DTA DATE 2-2-95

REVISIONS				
REV.	DESCRIPTION	BY	DATE	APPROVAL

Scale	Horizontal : AS SHOWN
Vertical :	
Job No.	7158.514

Church Engineering
A Division of
PBSJ
POST, BUCKLEY, SCHULZ & JENNIGAN
ENGINEERING • PLANNING • SURVEYING • CONSTRUCTION SERVICES
6600 West Charleston Blvd.
Suite 140
Las Vegas, Nevada 89102
Telephone: 702/879-6244
Fax: 702/879-7758

Designed by :	PLK	Date :	11/18/93
Drawn by :	AAS	Date :	11/18/93
Checked by :	PAA	Date :	11/18/93
File No. :	514IMP	Dwg No. :	514-S8

City of Las Vegas
CHEYENNE CHANNEL IMPROVEMENTS
BID No. 94.1730.12
STRUCTURAL DETAILS (RONEMUS)
CITY OF LAS VEGAS DRAWING No. 731-58
SHEET S8