


12-5-74



- INFORMATION COMPILED FROM:
1. CLV CITY HALL "AS BUILT" ARCHITECTURAL PLANS
 2. CITY HALL COMPLEX WATER MAIN & FIRE SERVICE WATER LINES, FILE NO. 565-108
 3. CITY HALL "AS BUILT" SURVEY, FIELD BK NO. 73-2XA

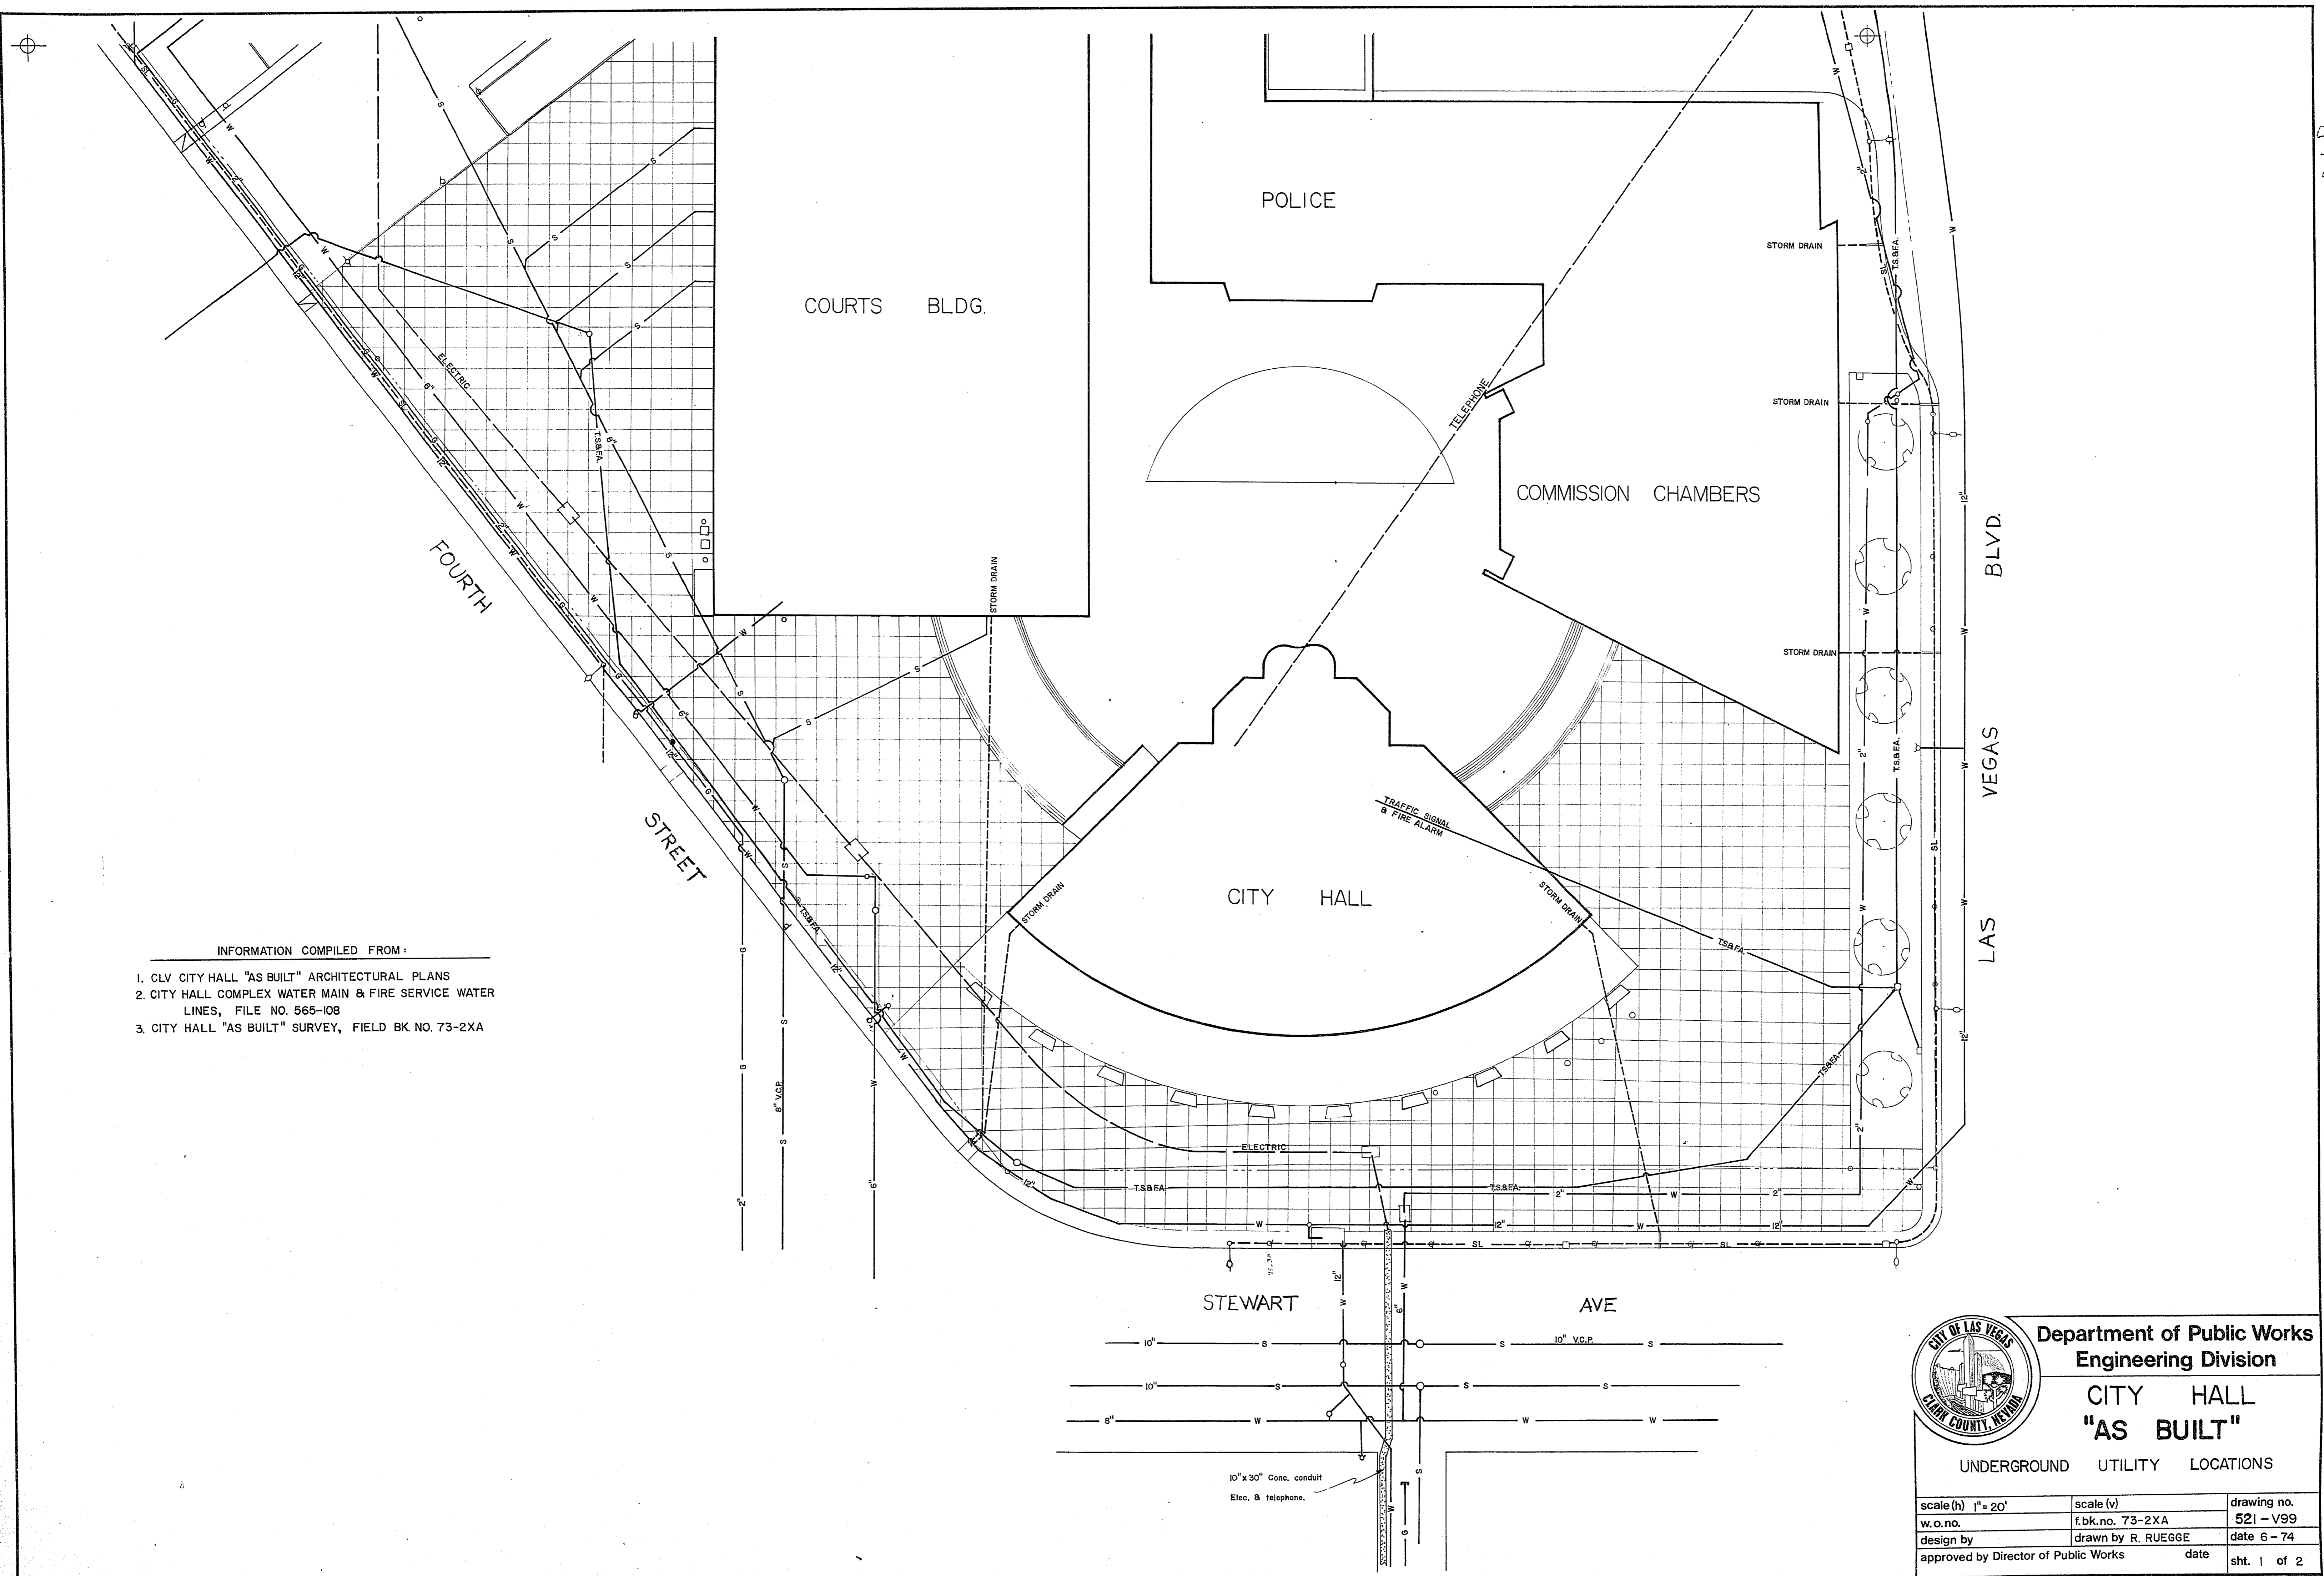

Department of Public Works
Engineering Division

CITY HALL
"AS BUILT"

UNDERGROUND UTILITY LOCATIONS

scale (h) 1" = 20'	scale (v)	drawing no.
w.o.no.	f.bk.no. 73-2XA	521-V99
design by	drawn by R. RUEGGE	date 6-74
approved by Director of Public Works	date	sht. 1 of 2