


12-6-8



REVISED SHAPE OF LIBRARY 8-7-89
 REVISED BY F. TEUPRAND

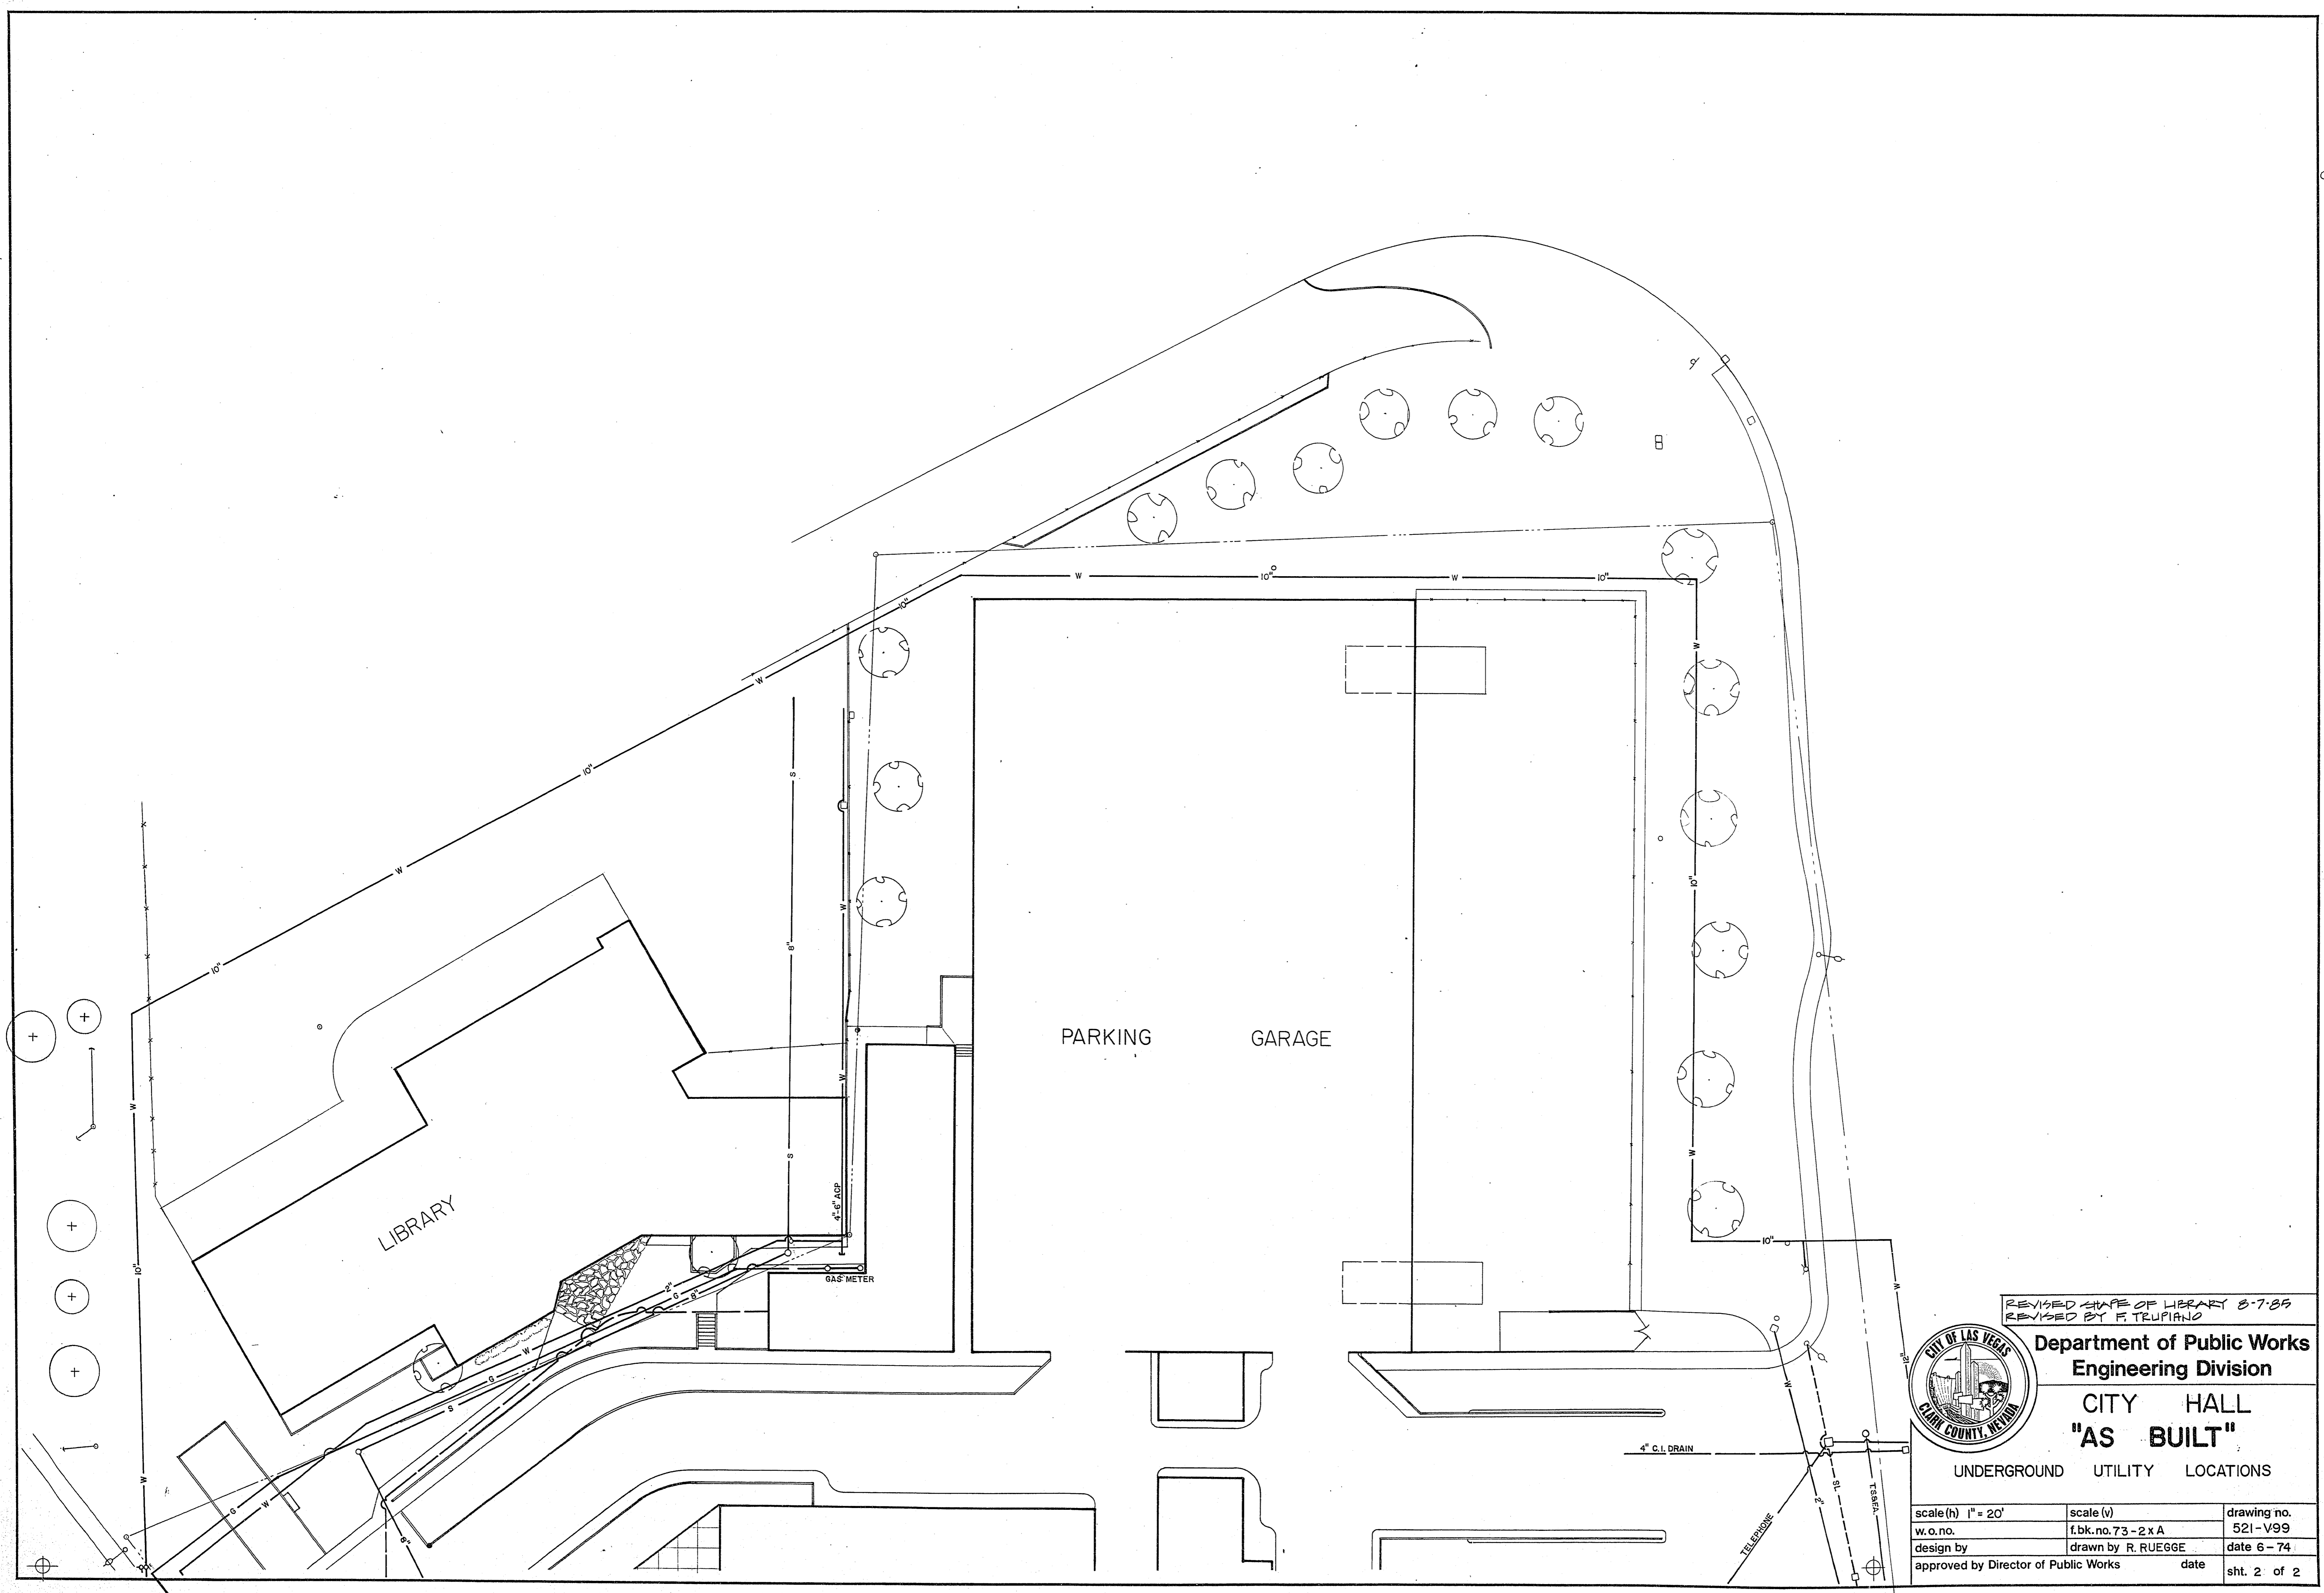

Department of Public Works
 Engineering Division

CITY HALL
 "AS BUILT"

UNDERGROUND UTILITY LOCATIONS

scale(h) 1" = 20'	scale(v)	drawing no.
w.o.no.	f.bk.no. 73-2x A	521-V99
design by	drawn by R. RUEGGE	date 6-74
approved by Director of Public Works	date	sht. 2 of 2