

CITY HALL RETROFIT
9TH & 10TH FLOOR FIRE ALARM


Scale: 1/8" = 1'-0"
Date: 10-10-82

Drawn BY: M. STUDEA

REVISED 3/4/83
AS BUILT 8/1/83


Drawing No.
4084-009

1340

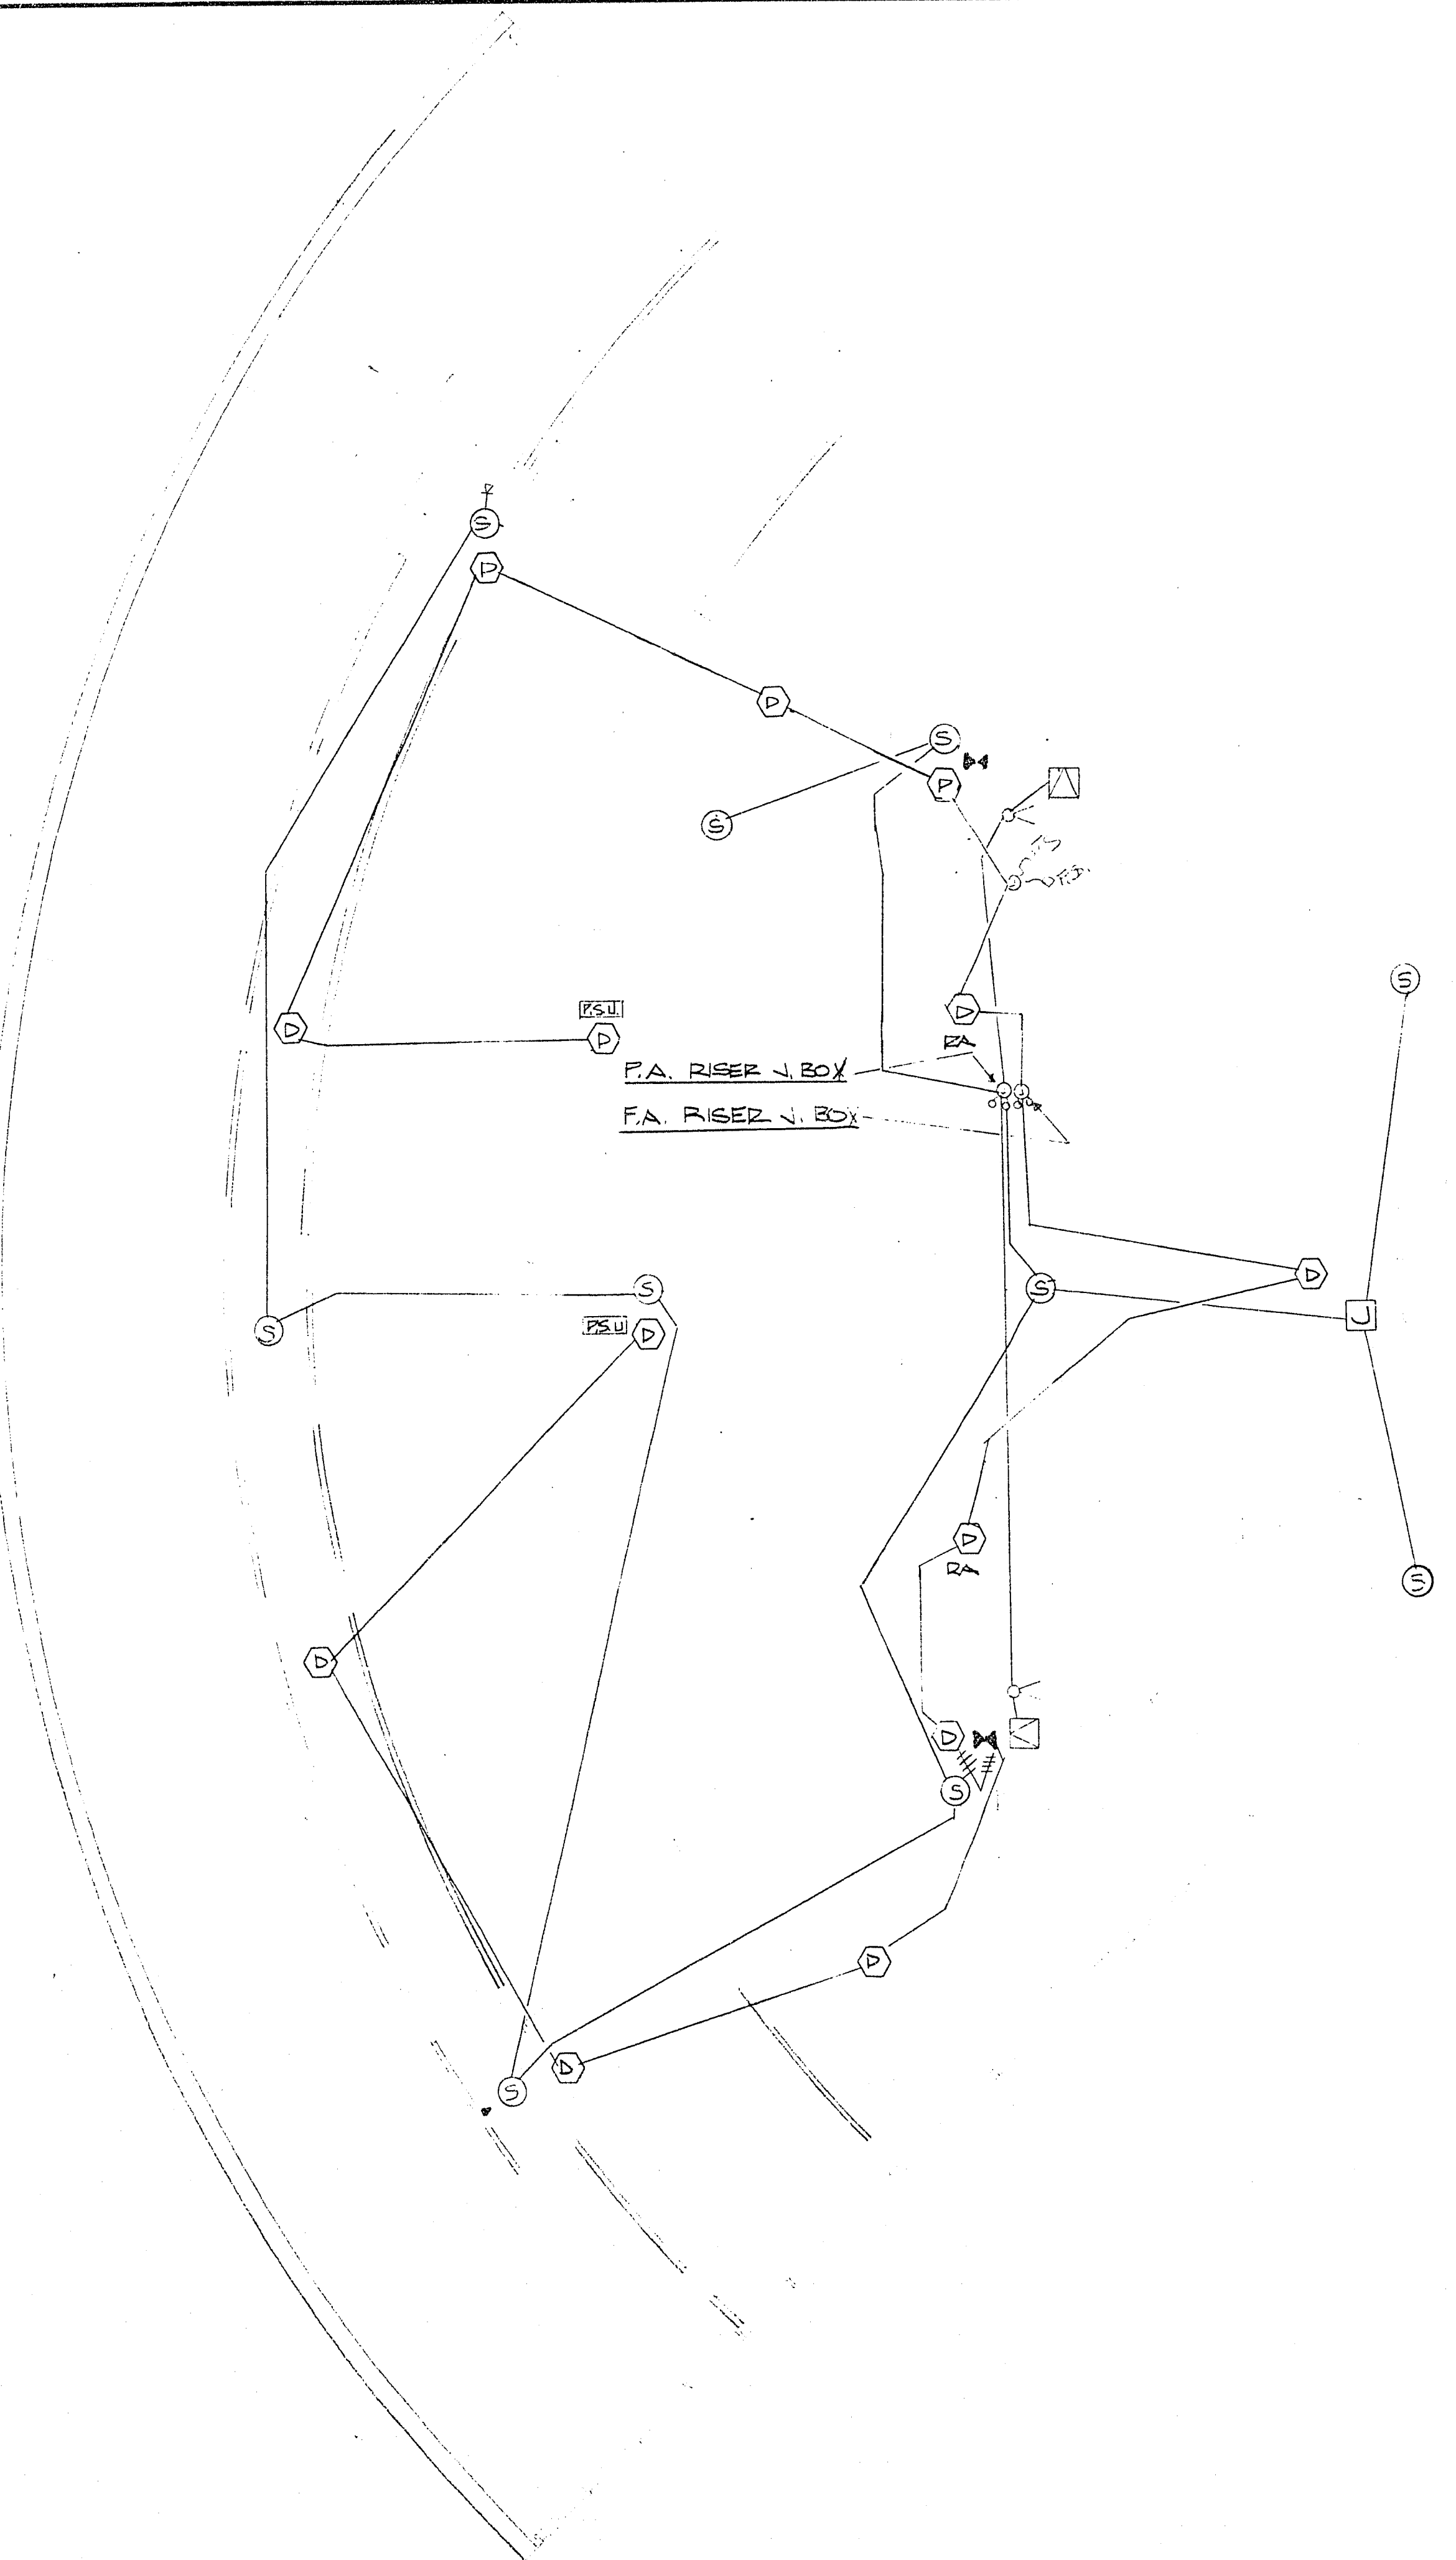

10TH FLOOR FIRE ALARM

SCALE: 1/8" = 1'-0"

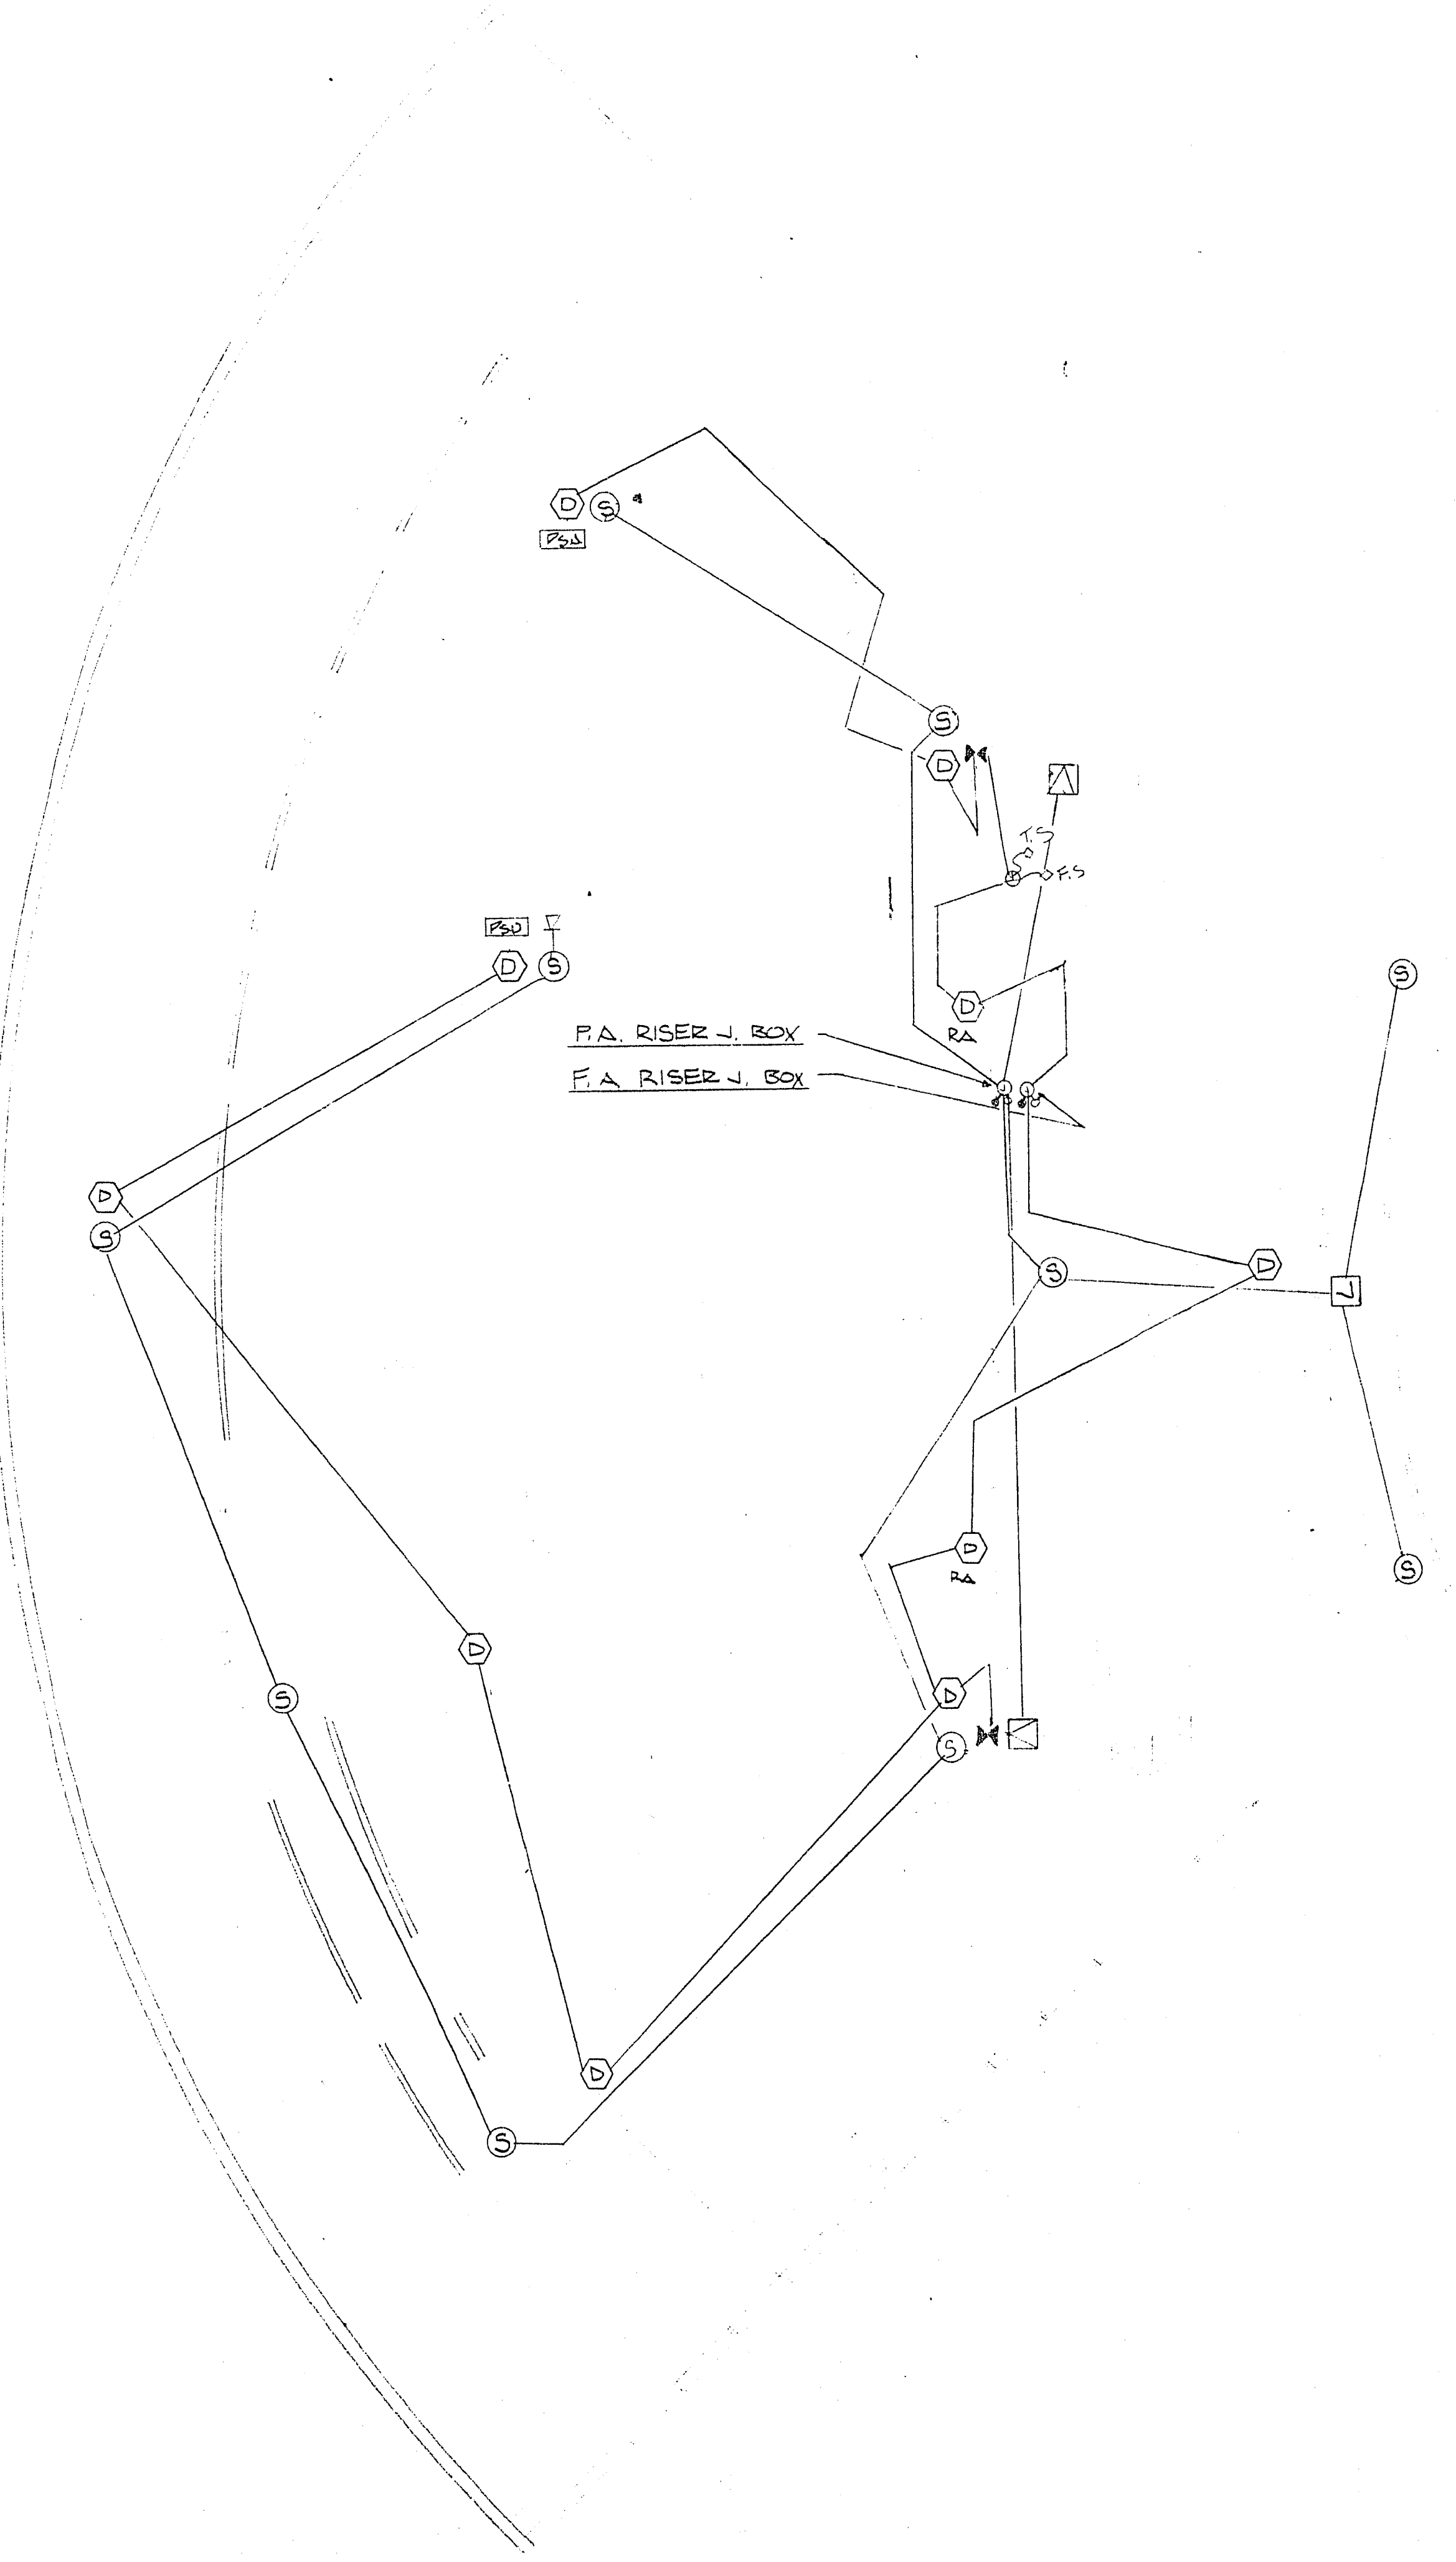

9TH FLOOR FIRE ALARM

SCALE: 1/8" = 1'-0"