

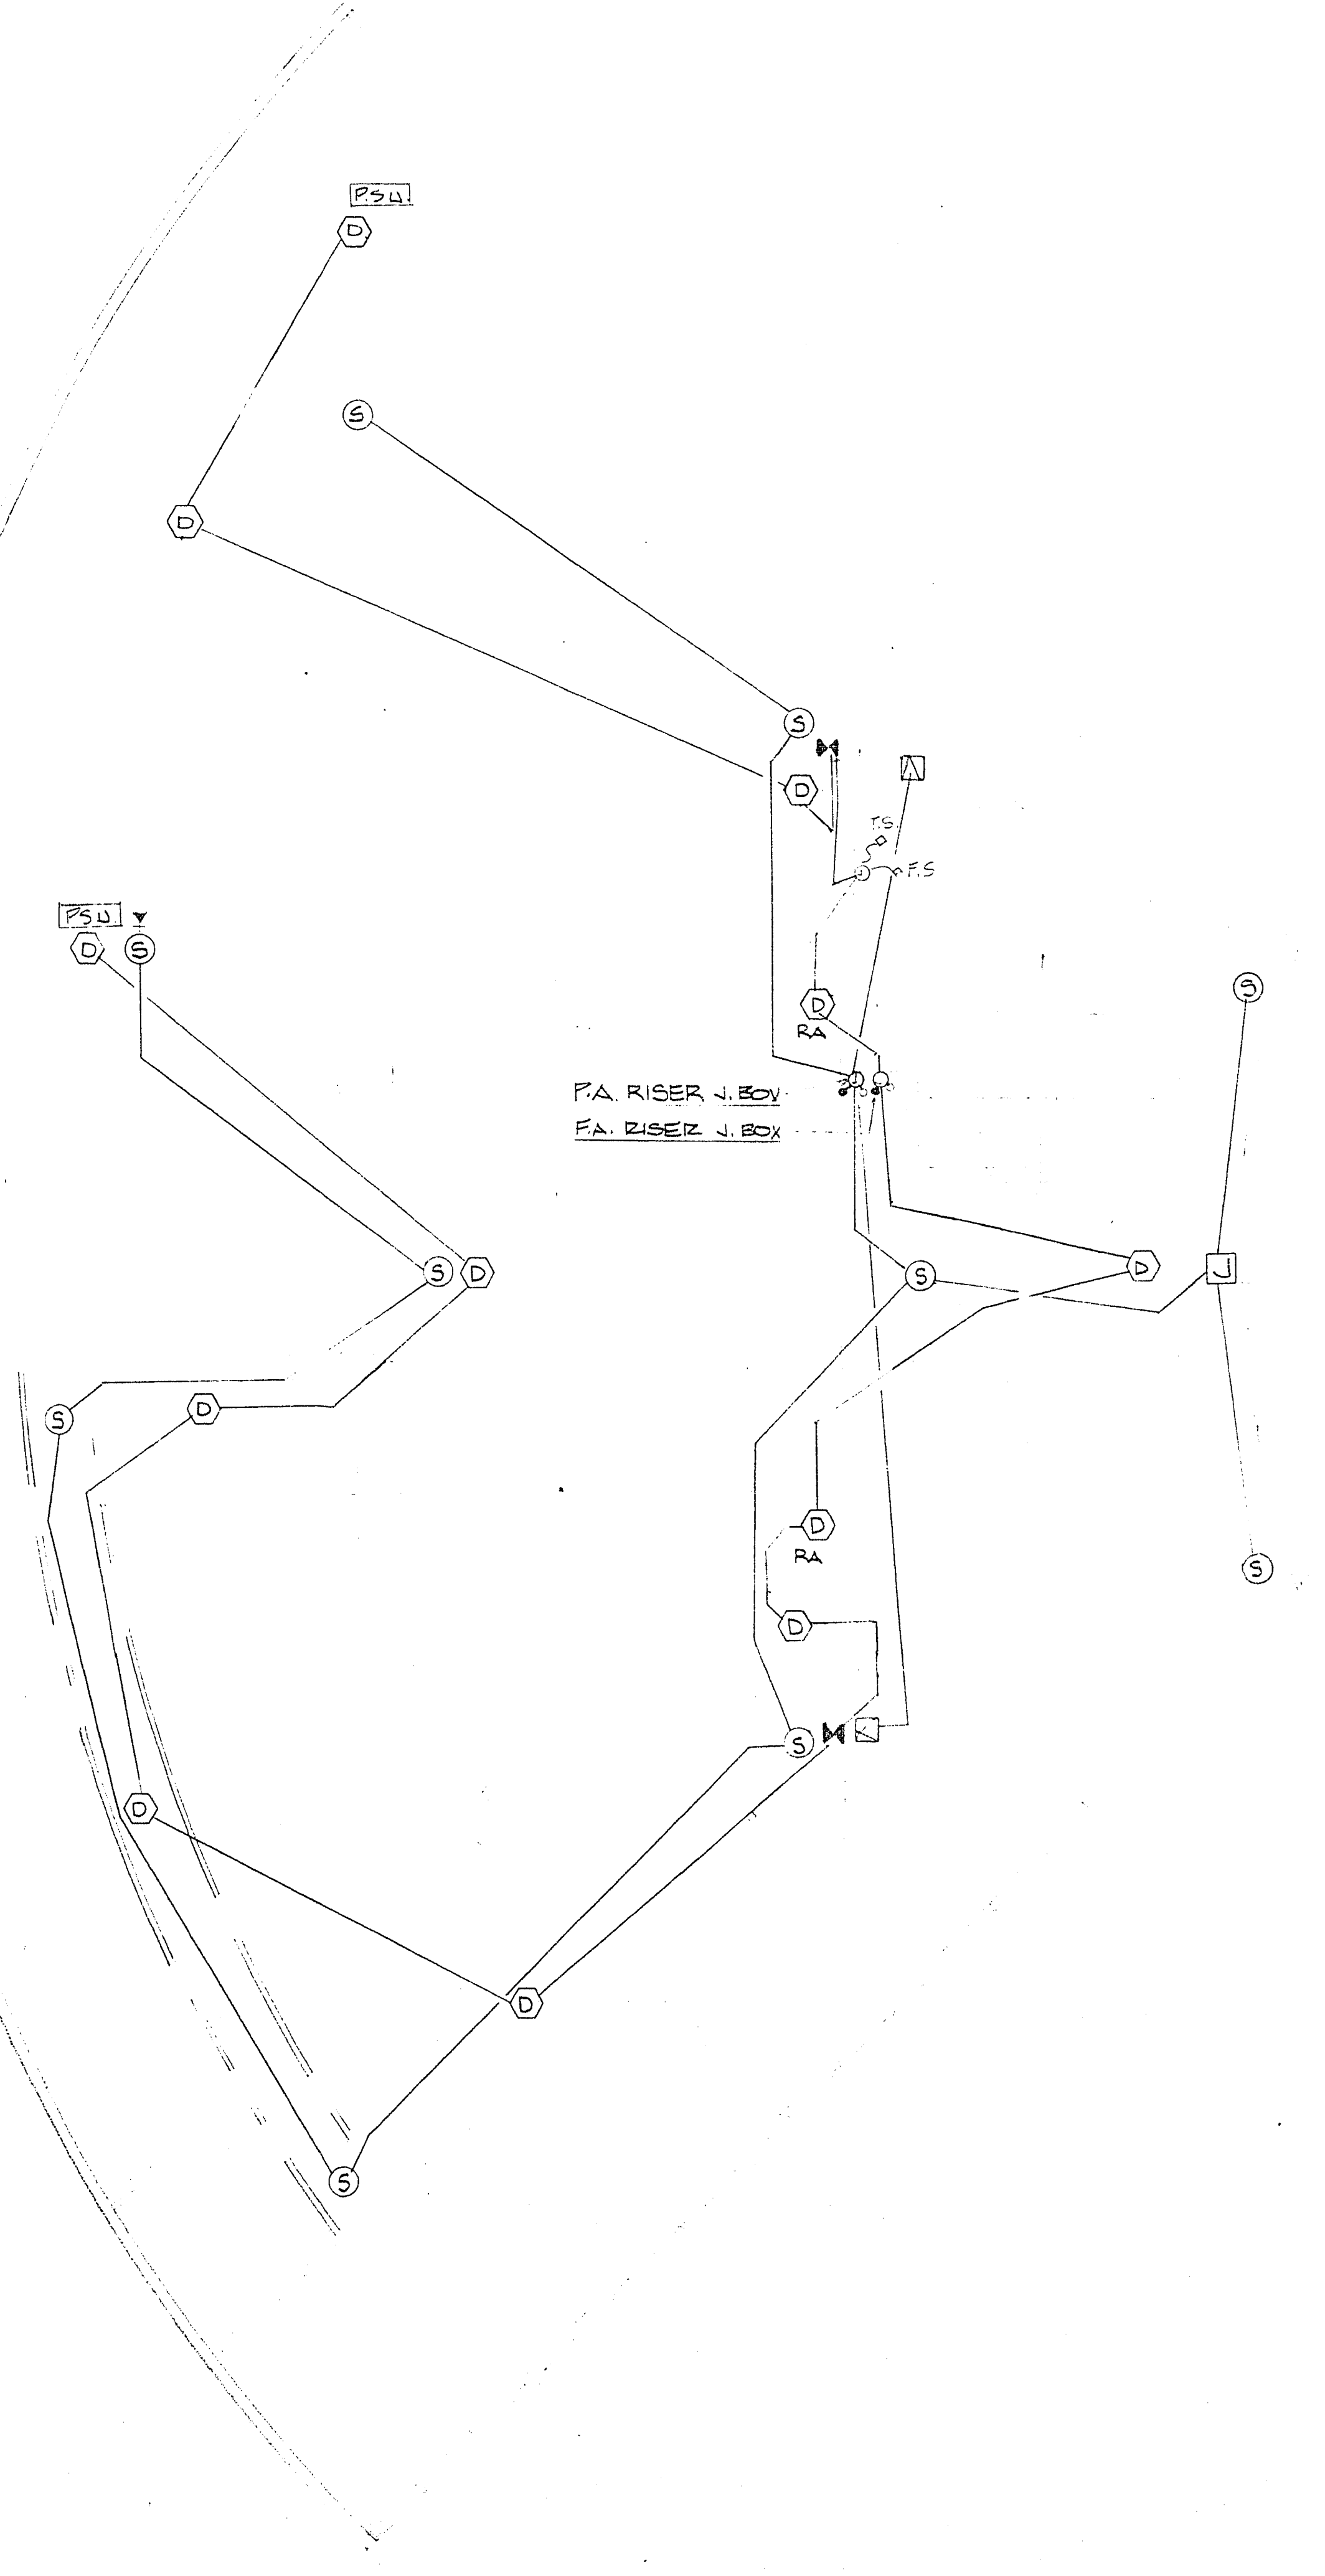


8TH FLOOR FIRE ALARM
SCALE: 1/8" = 1'-0"

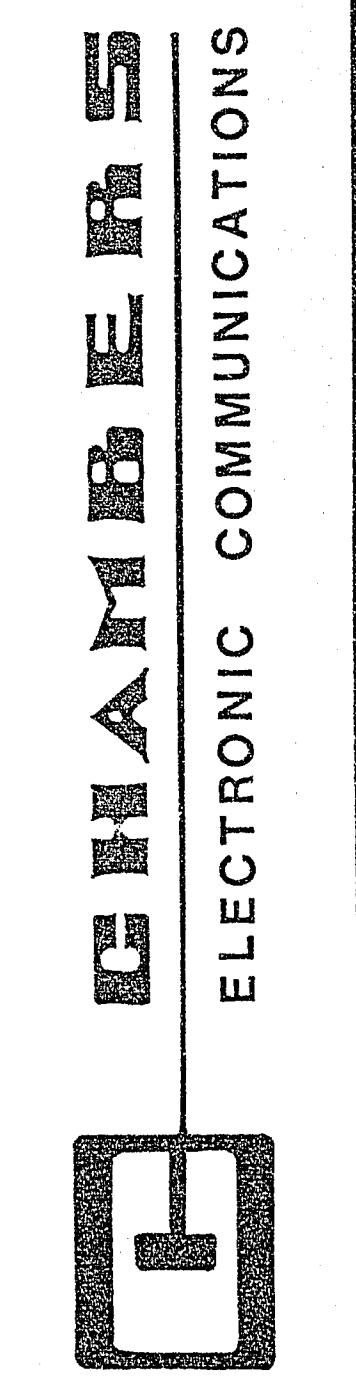

7TH FLOOR FIRE ALARM
SCALE: 1/8" = 1'-0"

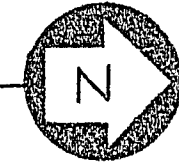

CITY HALL RETROFIT
7TH & 8TH FLOOR FIRE ALARM

Scale: 1/8" = 1'-0"
Date: 10-10-82
Drawn By: M. STUBER

AS BUILT 8/1/83
Drawing No.
4084-008

1357