



6TH FLOOR FIRE ALARM  
SCALE: 1/8" = 1'-0"

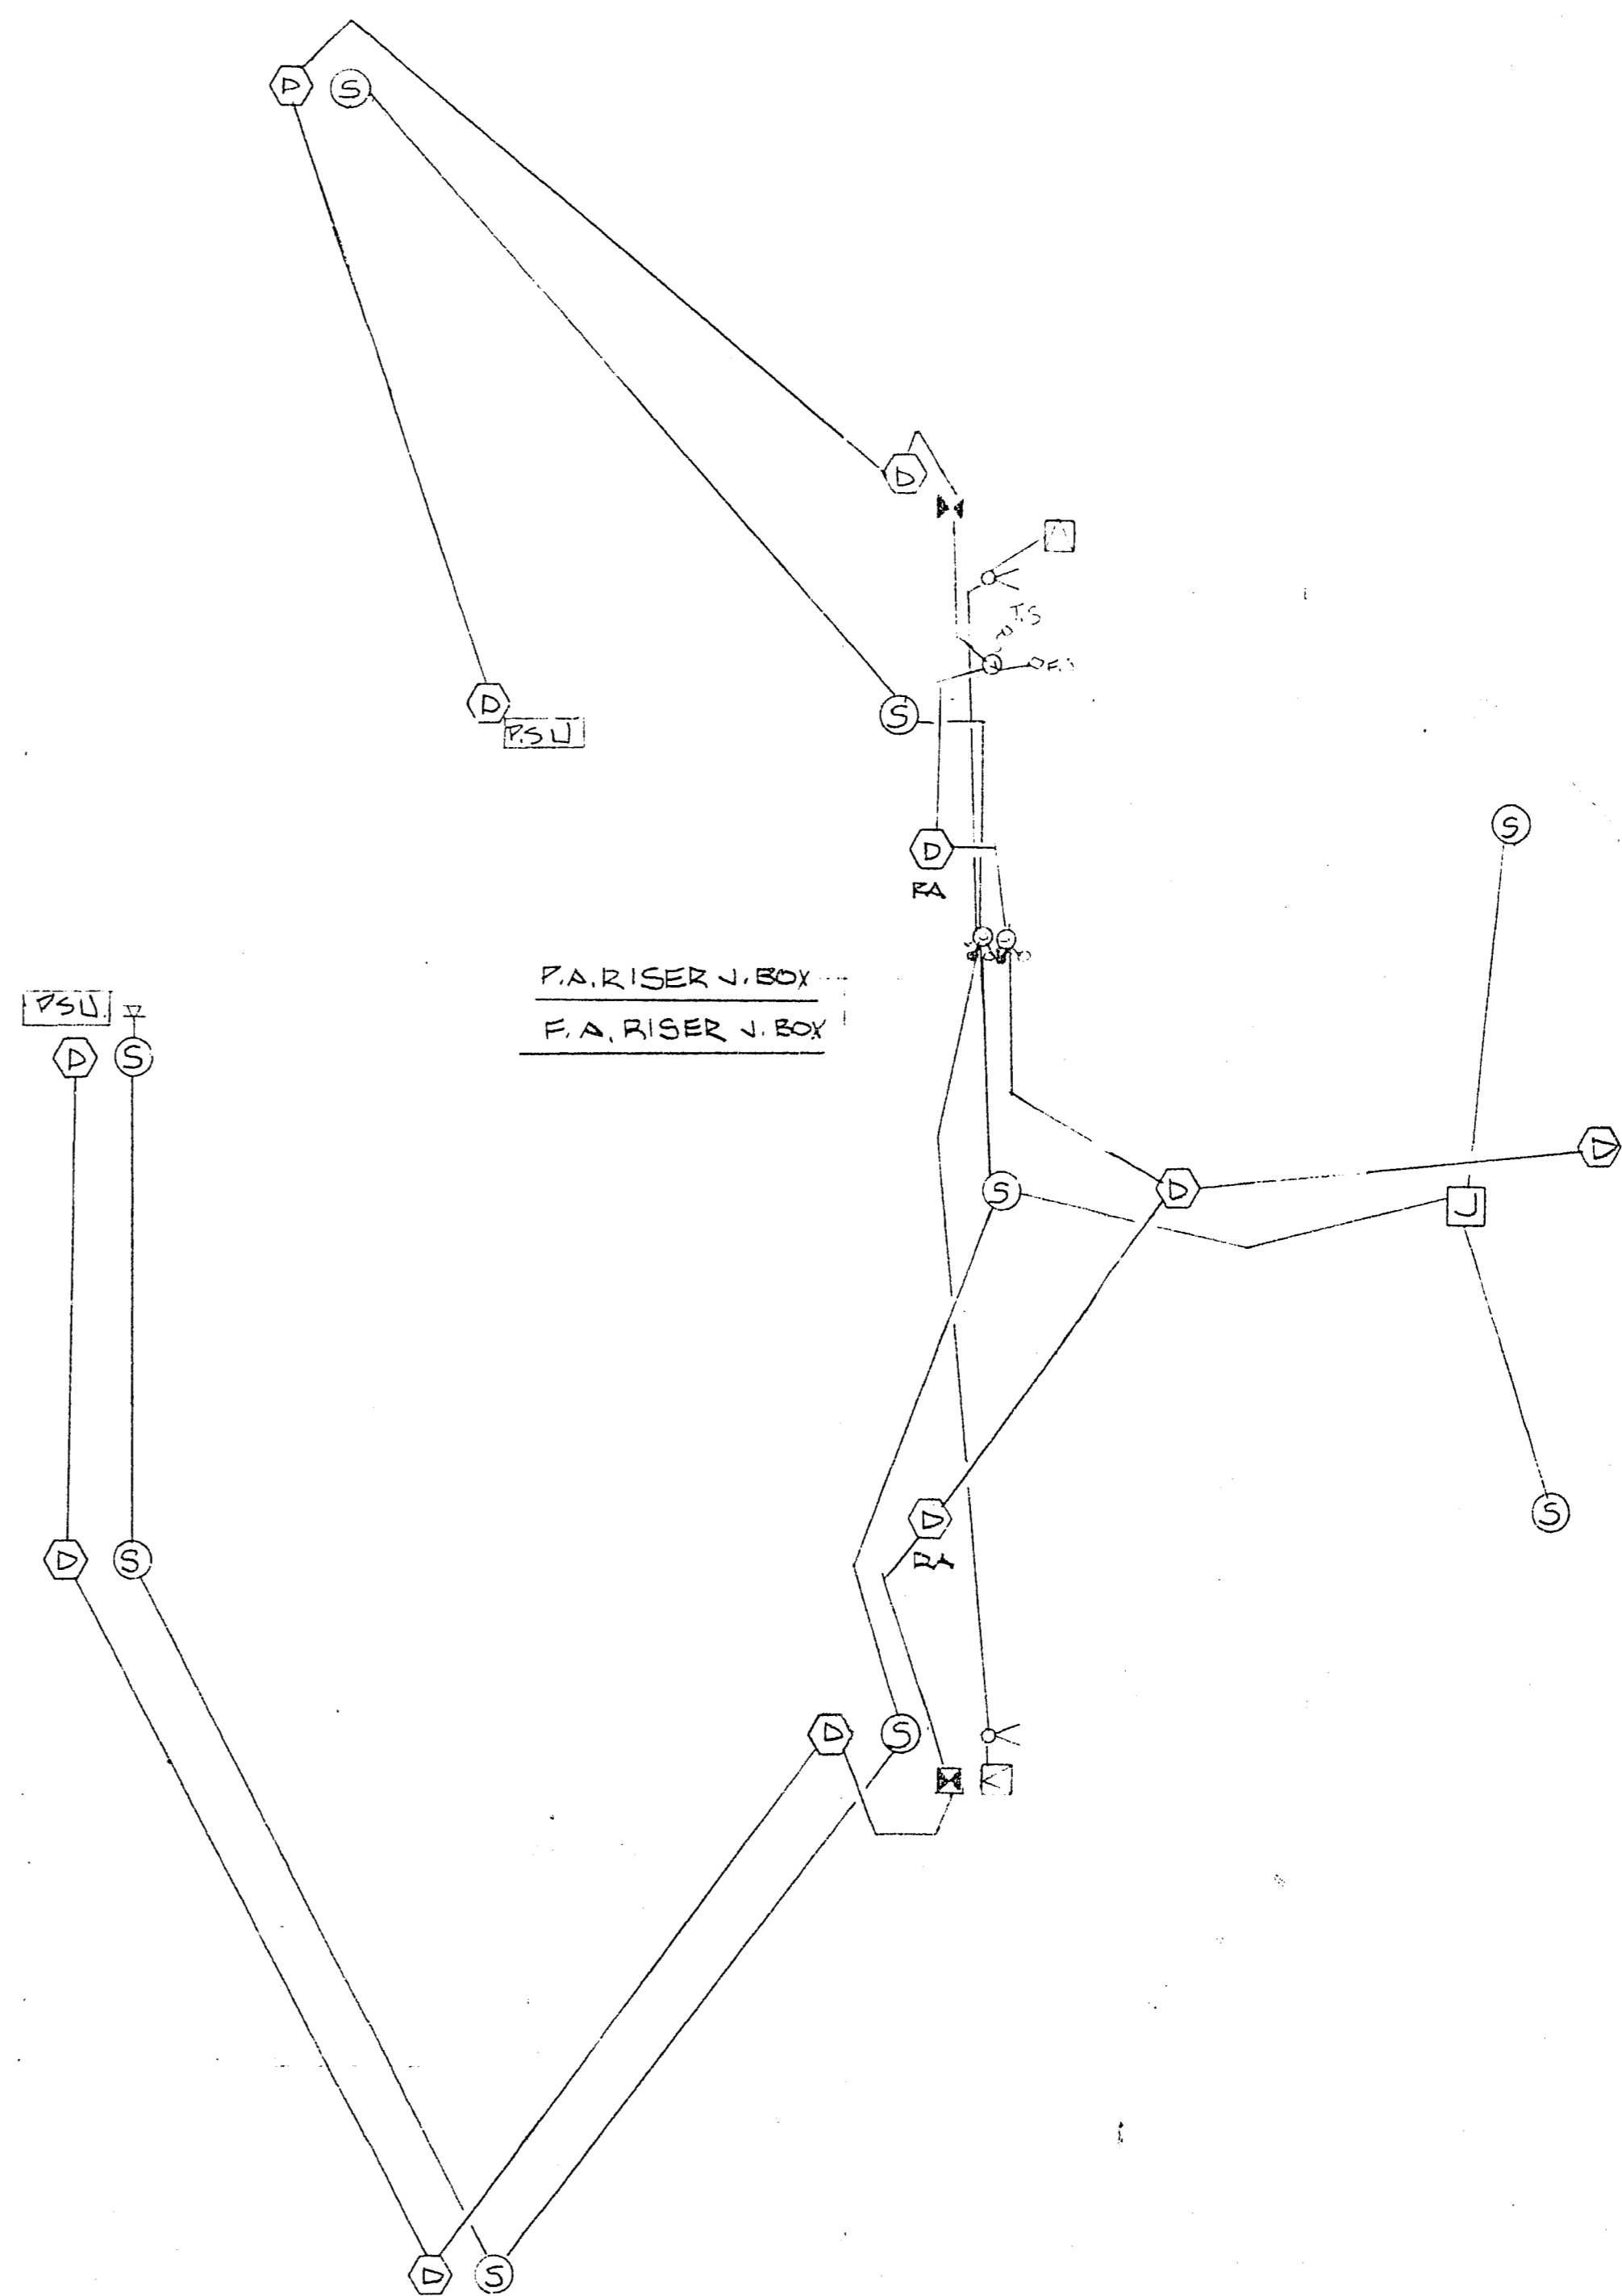

5TH FLOOR FIRE ALARM  
SCALE: 1/8" = 1'-0"

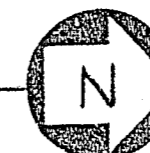

CITY HALL RETROFIT  
5TH & 6TH FLOOR FIRE ALARM

AS BUILT 2/1/83

Drawing No.  
4084-007

521-163

**CHAMBERS**  
ELECTRONIC COMMUNICATIONS

Scale: 1/8" = 1'-0"  
Date: 10-10-83  
Drawn By: M. STUBBS

13-98