

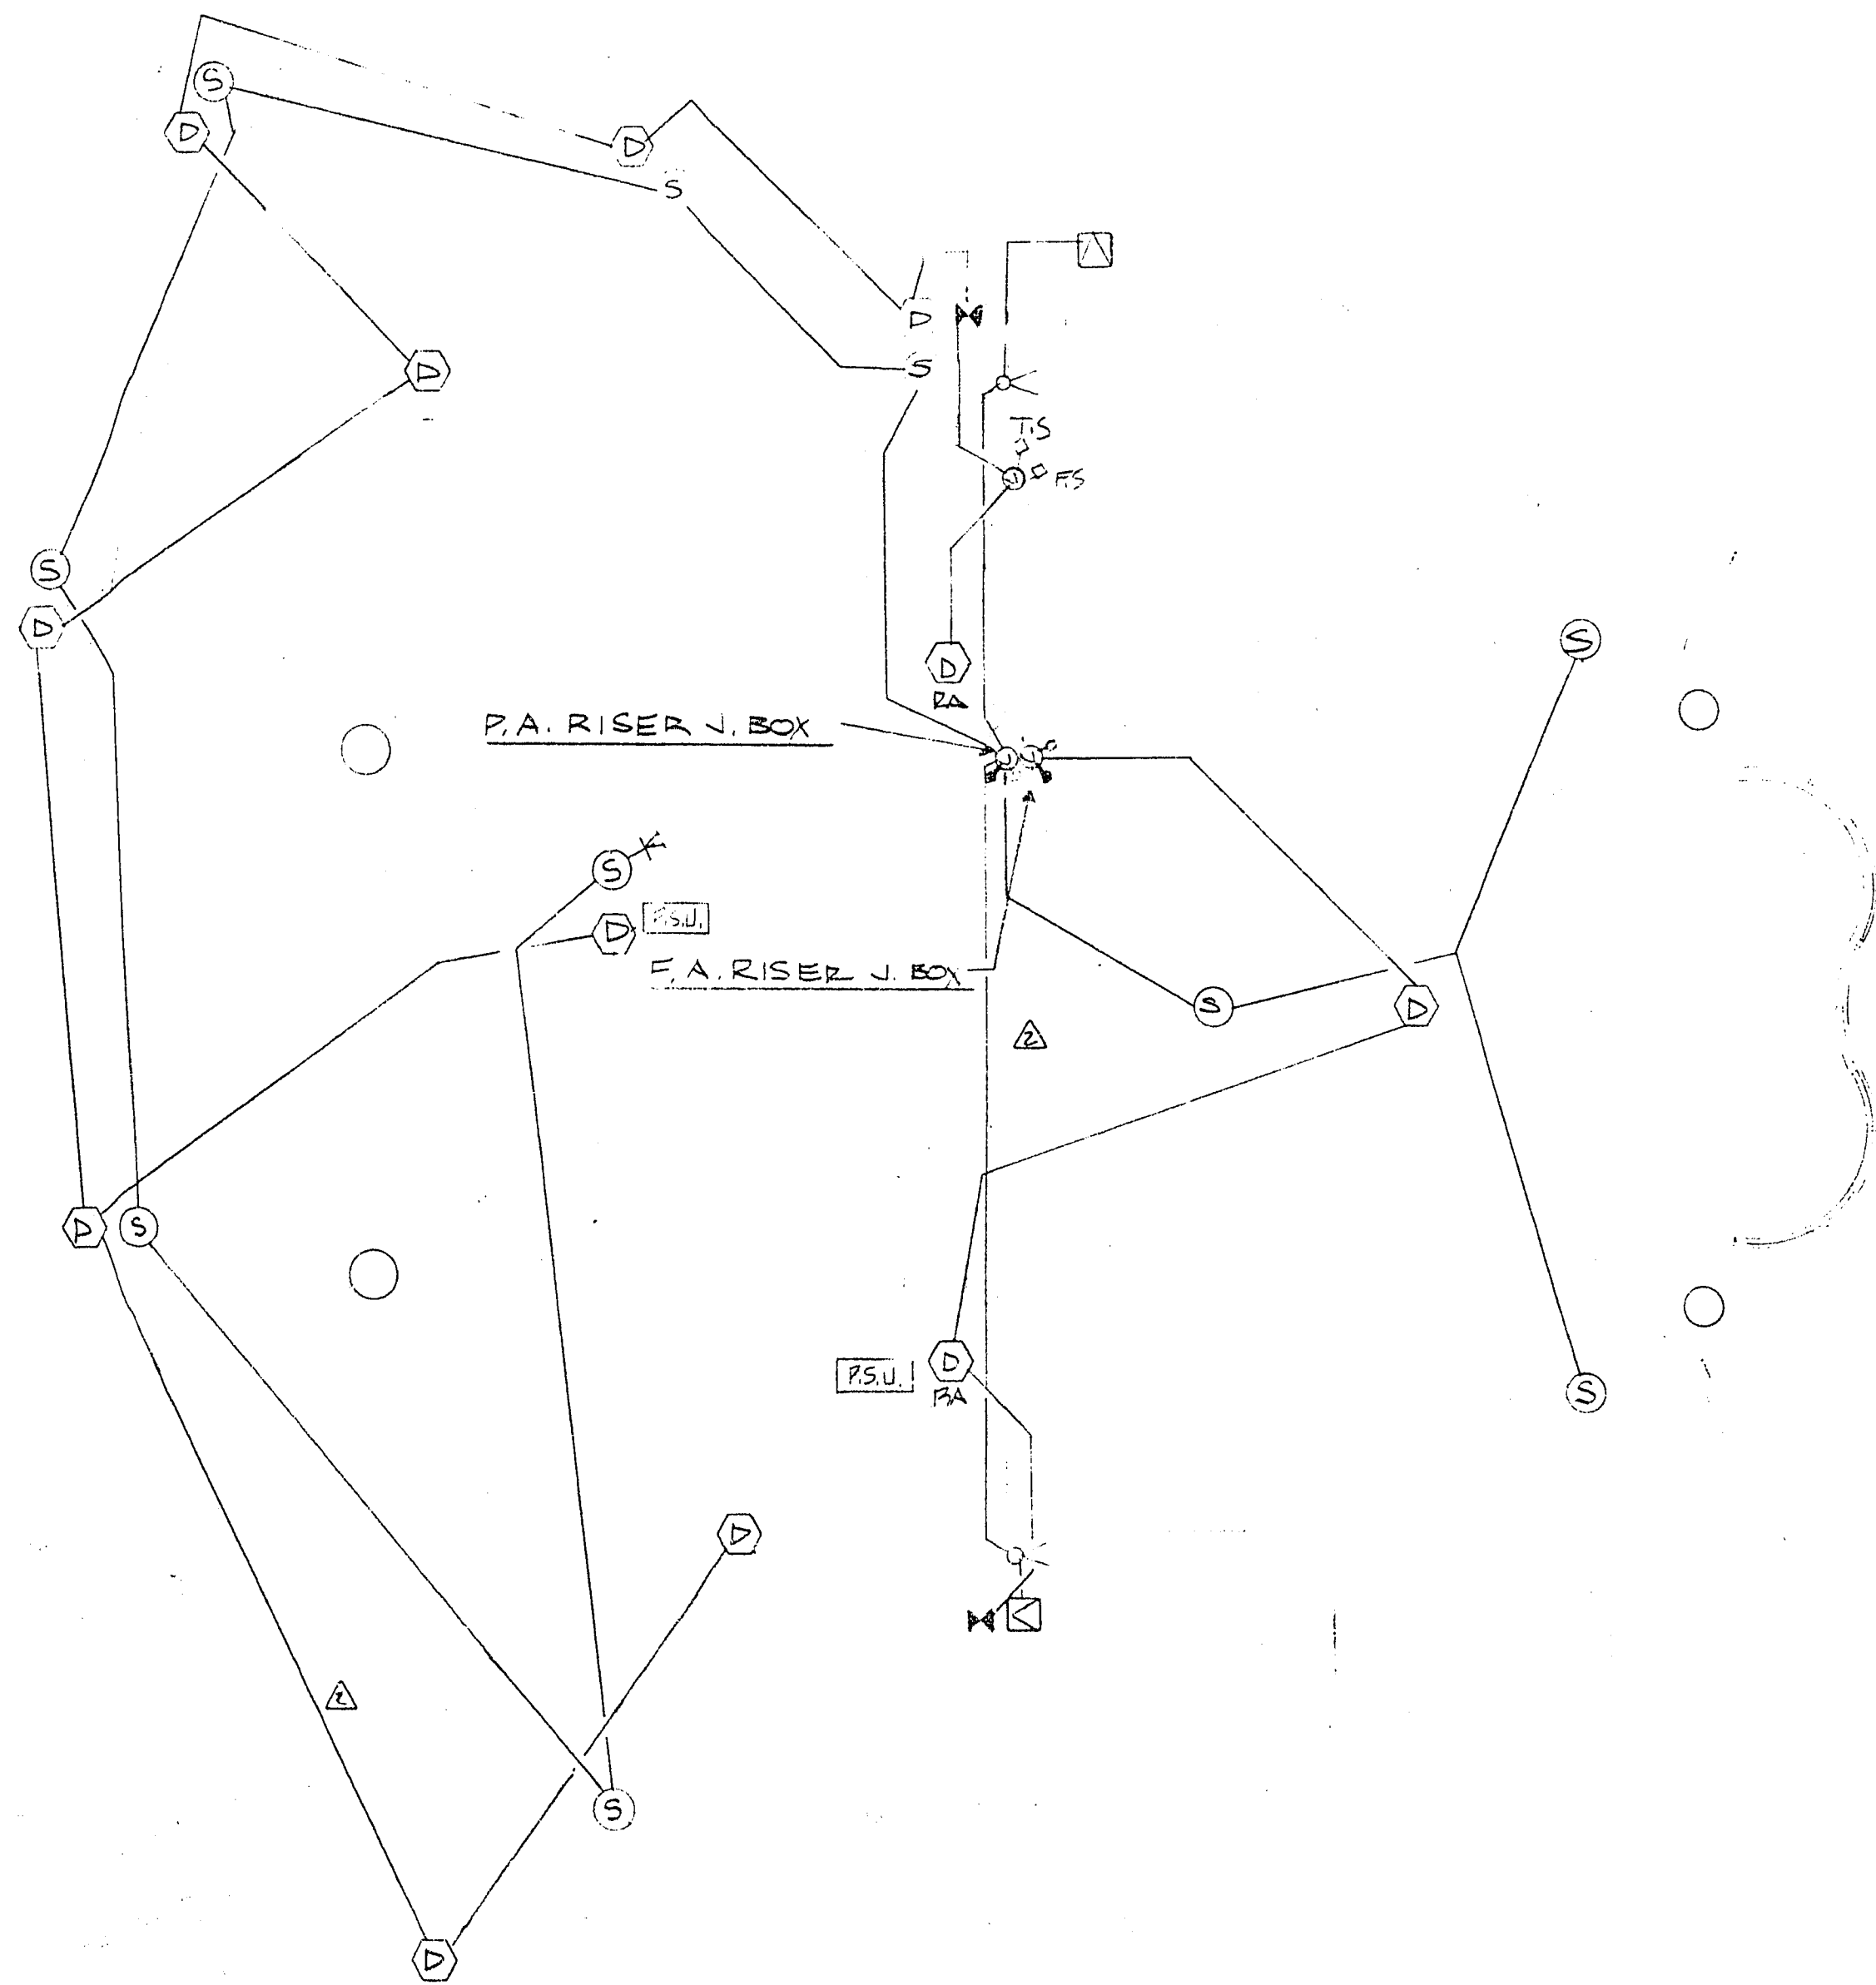
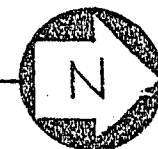


2ND FLOOR FIRE ALARM

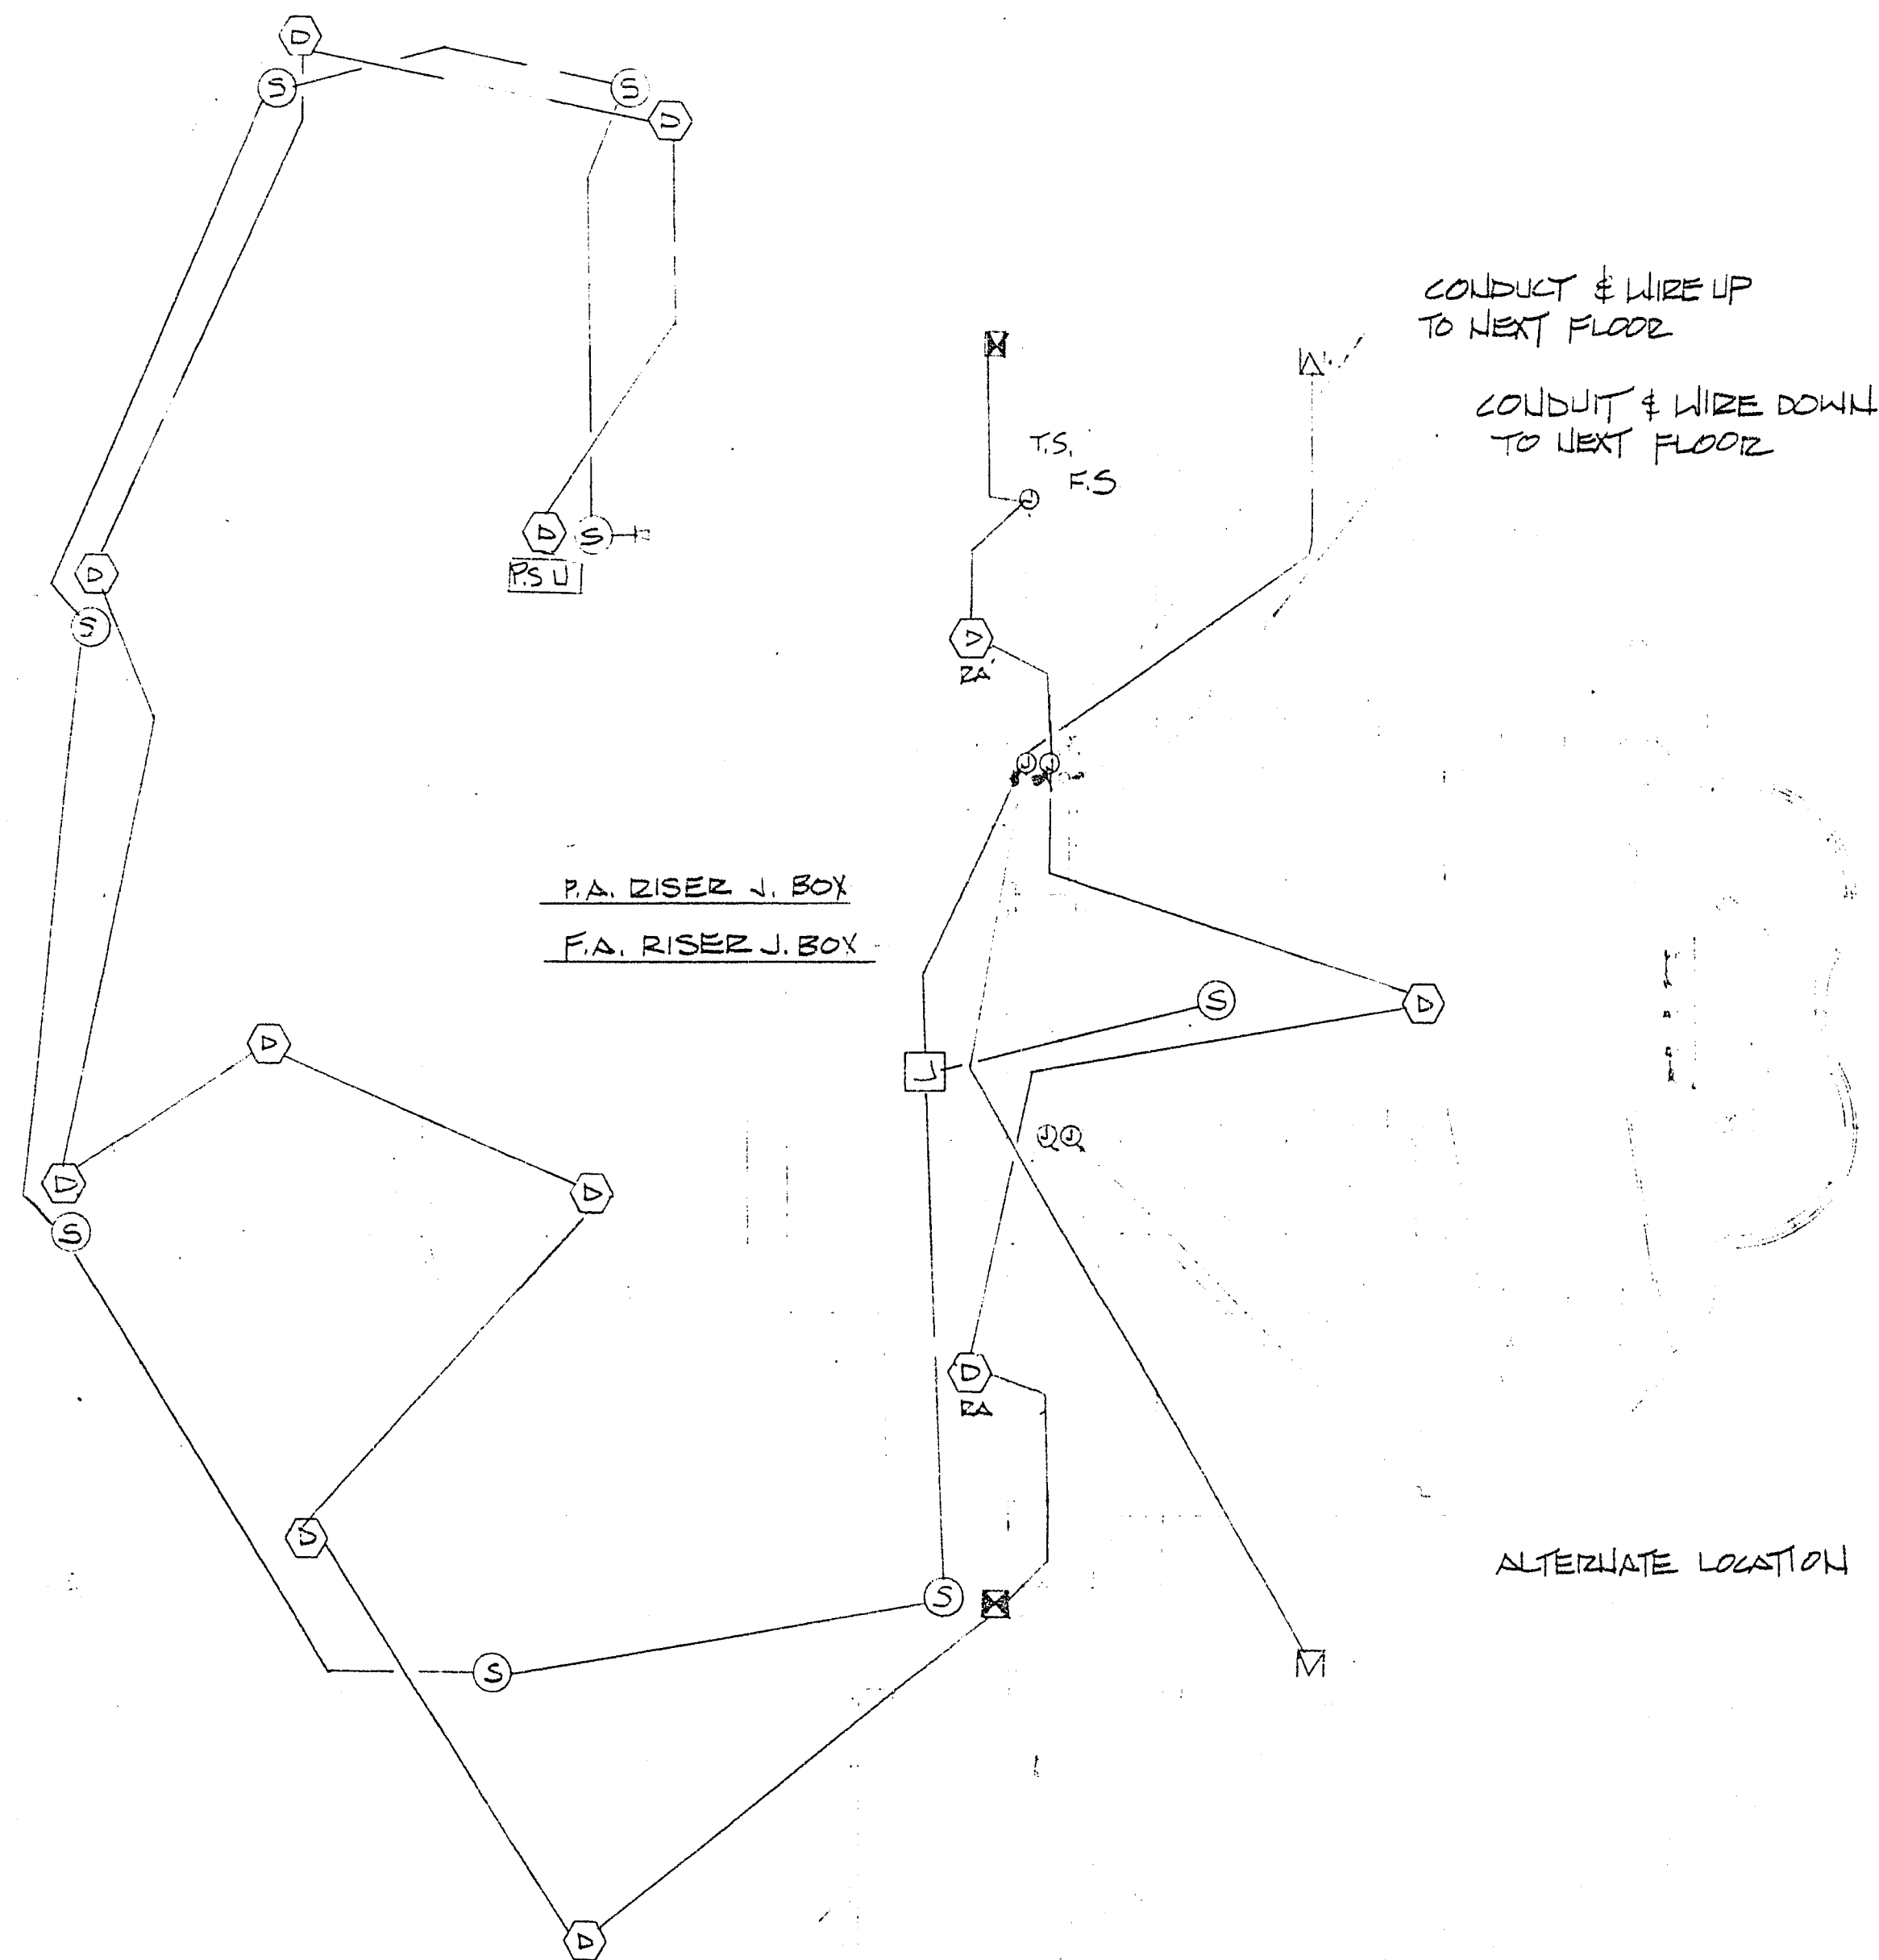

GROUND FLOOR FIRE ALARM

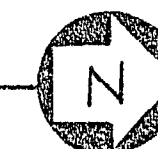


SCALE: 1/8" = 1'-0"

CITY HALL RETROFIT  
 GROUND & 2ND FLOOR FIRE ALARM  
 Scale: 1/8" = 1'-0"  
 Date: 10-10-82  
 Drawn By: M. STUBER

△ REVISED 3/3/83 VJS  
 △ REVISED 5/11/83 VJS  
 AS BUILT 8/11/87

Drawing No.  
 4084-005

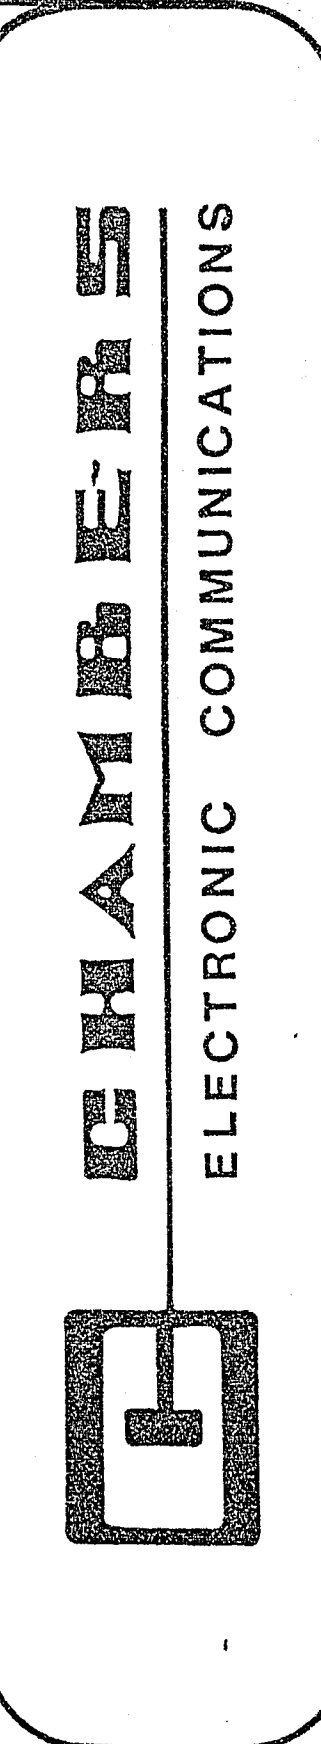

CHAMBERS  
 ELECTRONIC COMMUNICATIONS